


ADDITIONAL  
OPTIONAL  
PARKING SPACES

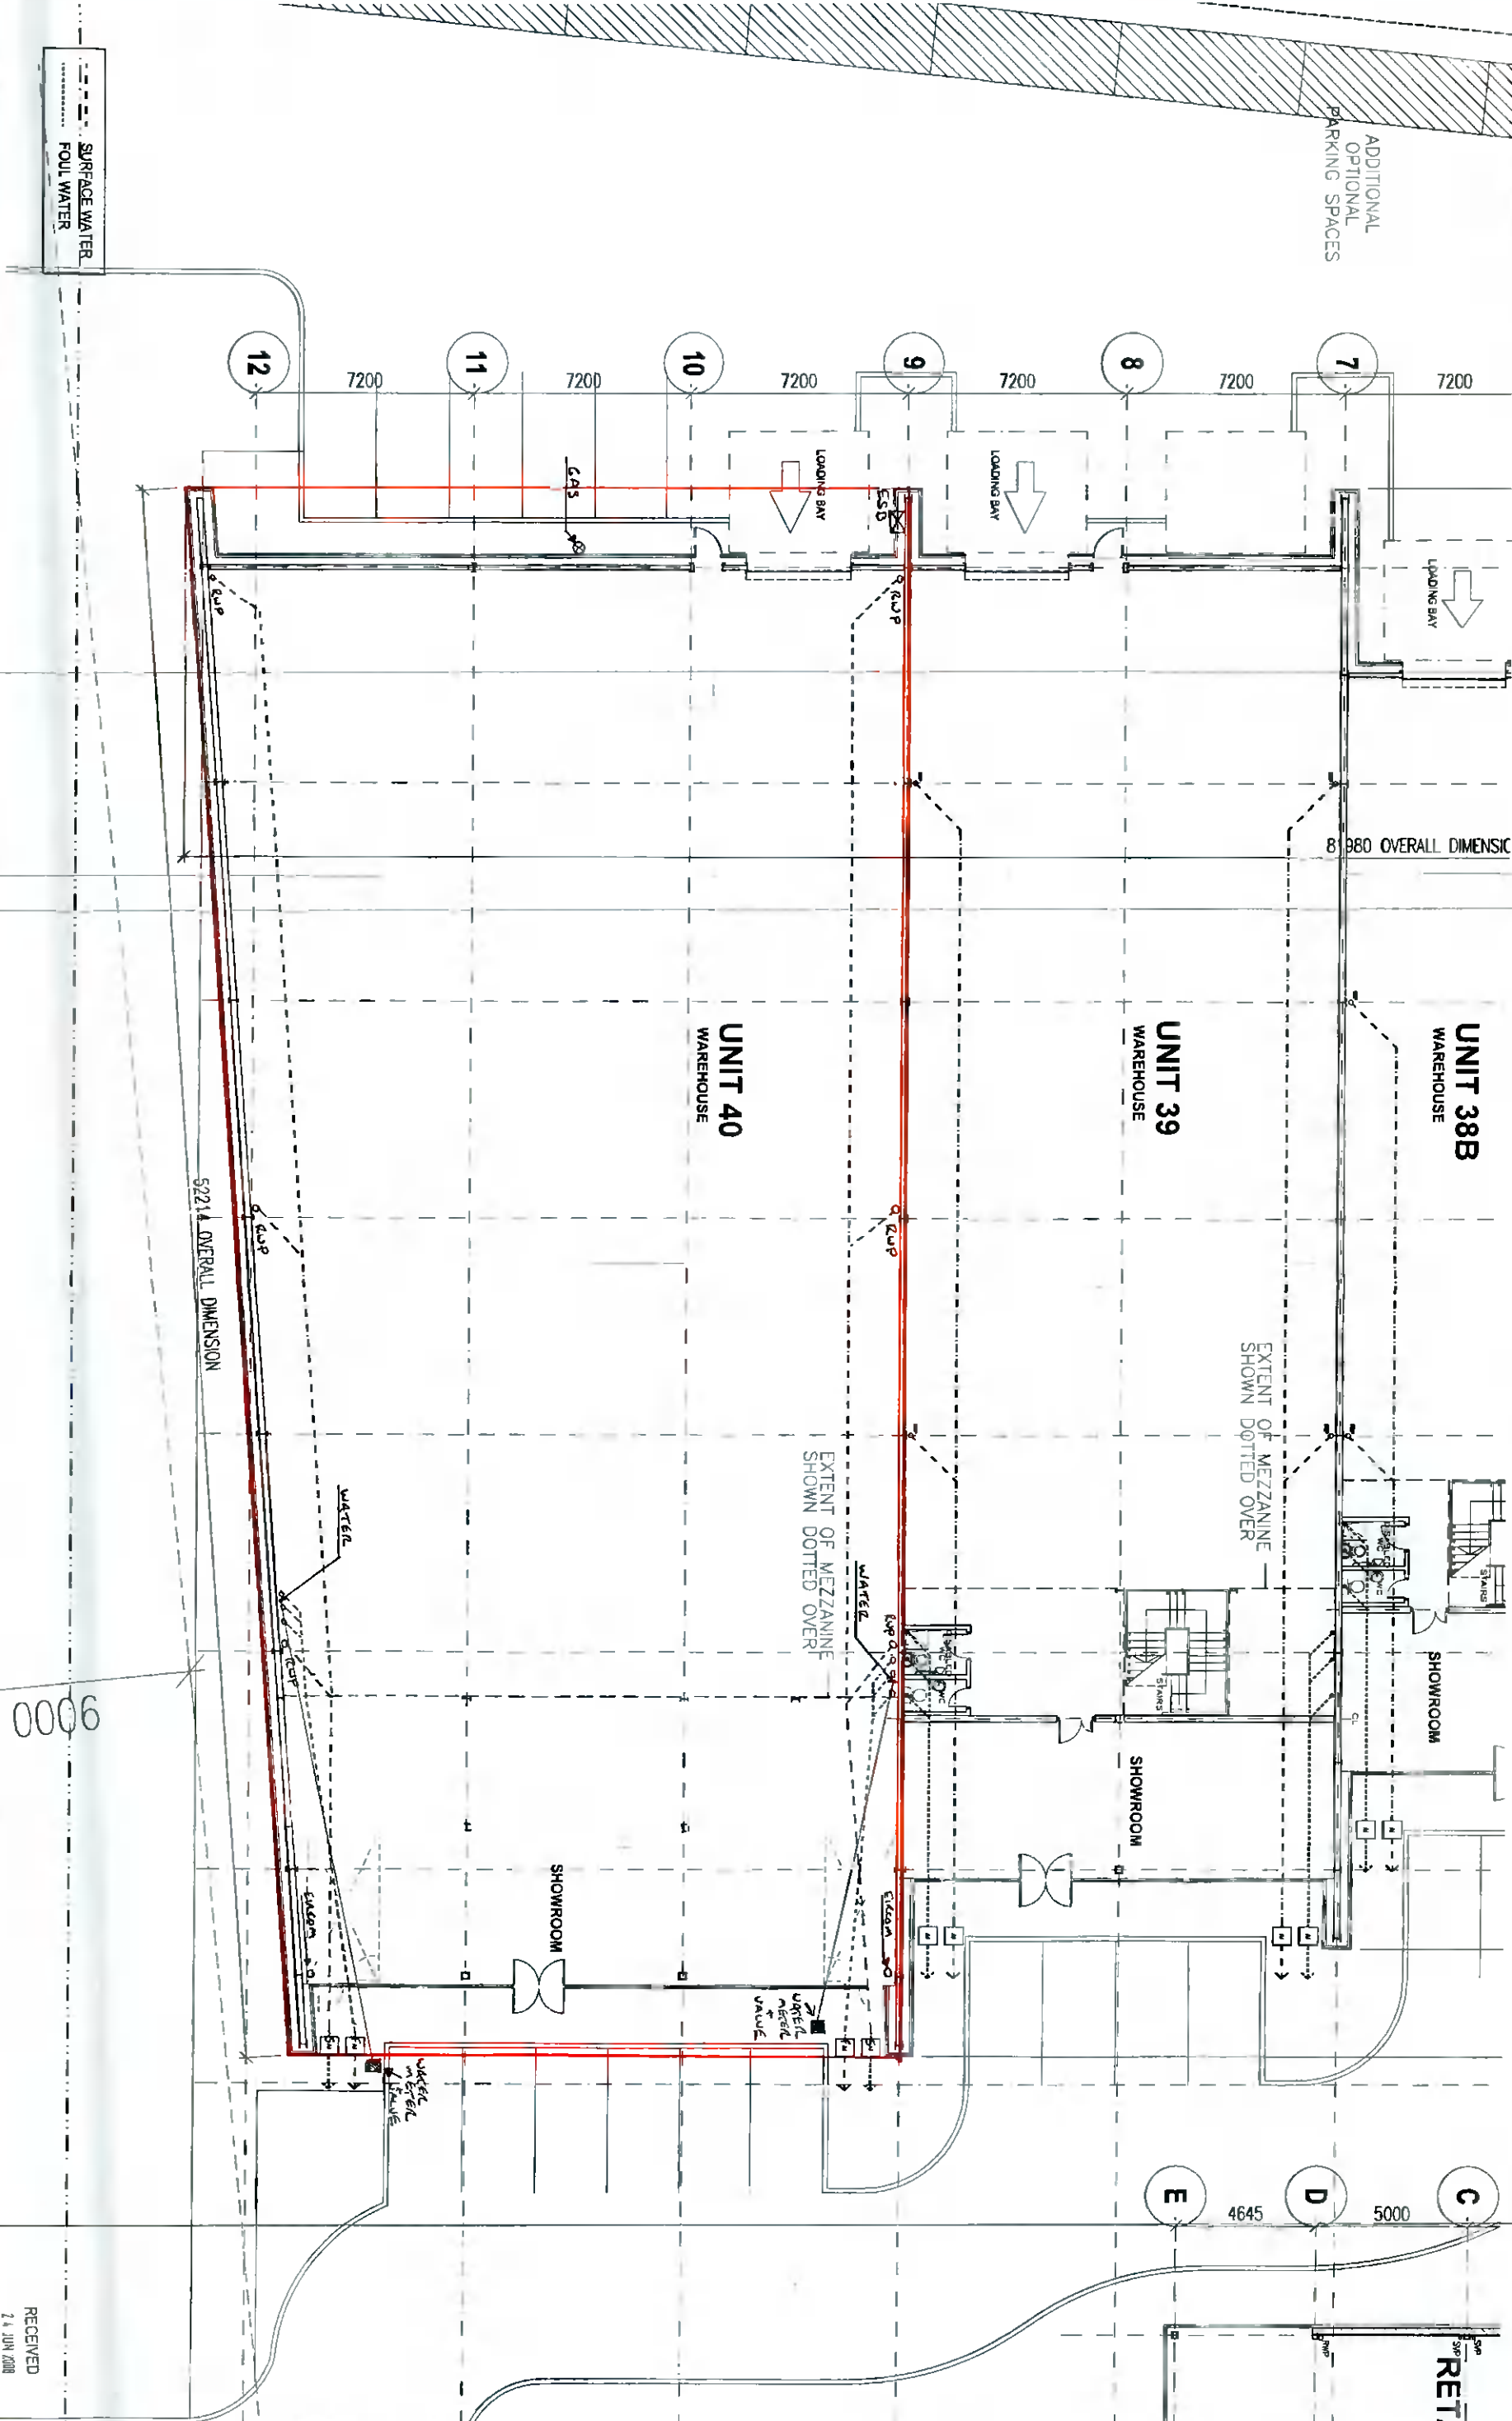

SURFACE WATER  
FOUL WATER

8980 OVERALL DIMENSIC

UNIT 38B  
WAREHOUSE

UNIT 39  
WAREHOUSE

UNIT 40  
WAREHOUSE

SHOWROOM

SHOWROOM

SHOWROOM

EXTENT OF MEZZANINE  
SHOWN DOTTED OVER

EXTENT OF MEZZANINE  
SHOWN DOTTED OVER

59214 OVERALL DIMENSION

9000

4645

5000

DO NOT SCALE FROM THIS DRAWING, WORK ONLY FROM FINISHED DIMENSIONS.  
 ALL ERRORS AND OMISSIONS TO BE REPORTED TO THE ARCHITECT.  
 THIS DRAWING TO BE READ IN CONJUNCTION WITH RELEVANT CONSULTANTS' DRAWINGS.

STANDARD: SEE SECTION DESIGN P.A. DRAWING. FOR THE SAFETY OF THE CONSTRUCTION SITE, THE ARCHITECT HAS OBTAINED THE NECESSARY PERMITS FROM THE LOCAL AUTHORITIES.  
 PROJECT NO.: 08/10/2004 03.07 MOD. BY: [Name] DATE: [Date]

NO.	DATE	ISSUE

NO.	DATE	ISSUE

**Scott Tallon Walker Architects** 19 Marston Square, Dublin 2, Ireland

CLIENT: PARK DEVELOPMENTS  
 PROJECT: FASHION CITY PHASE 4  
 SITE: M50 BUSINESS PARK BALLYMOUNT

DRAWING: GROUND FLOOR PLAN  
 UNITS: 40  
 SERVICES: AS BUILT

DATE: 04/11/06  
 SCALE: 1:1000

PROJ. NO.: 02166-CON-102  
 SHEET NO.: 1  
 DATE: 21 JUN 2006

RECEIVED  
21 JUN 2006

RECEIVED  
30 JUN 2006

RETIA