


RETENTION 2021

slate roof tiles to match existing on 50mm x 25mm timber battens on
Roofshiels breather membrane on 44mm x 175mm C16 rafters, collars and
ceiling joists @ 400mm c/c with 150mm rigid insulation between rafters
with 100mm x 75mm timber wall plates on dpc strapped to new
structure. 5lb lead flashing

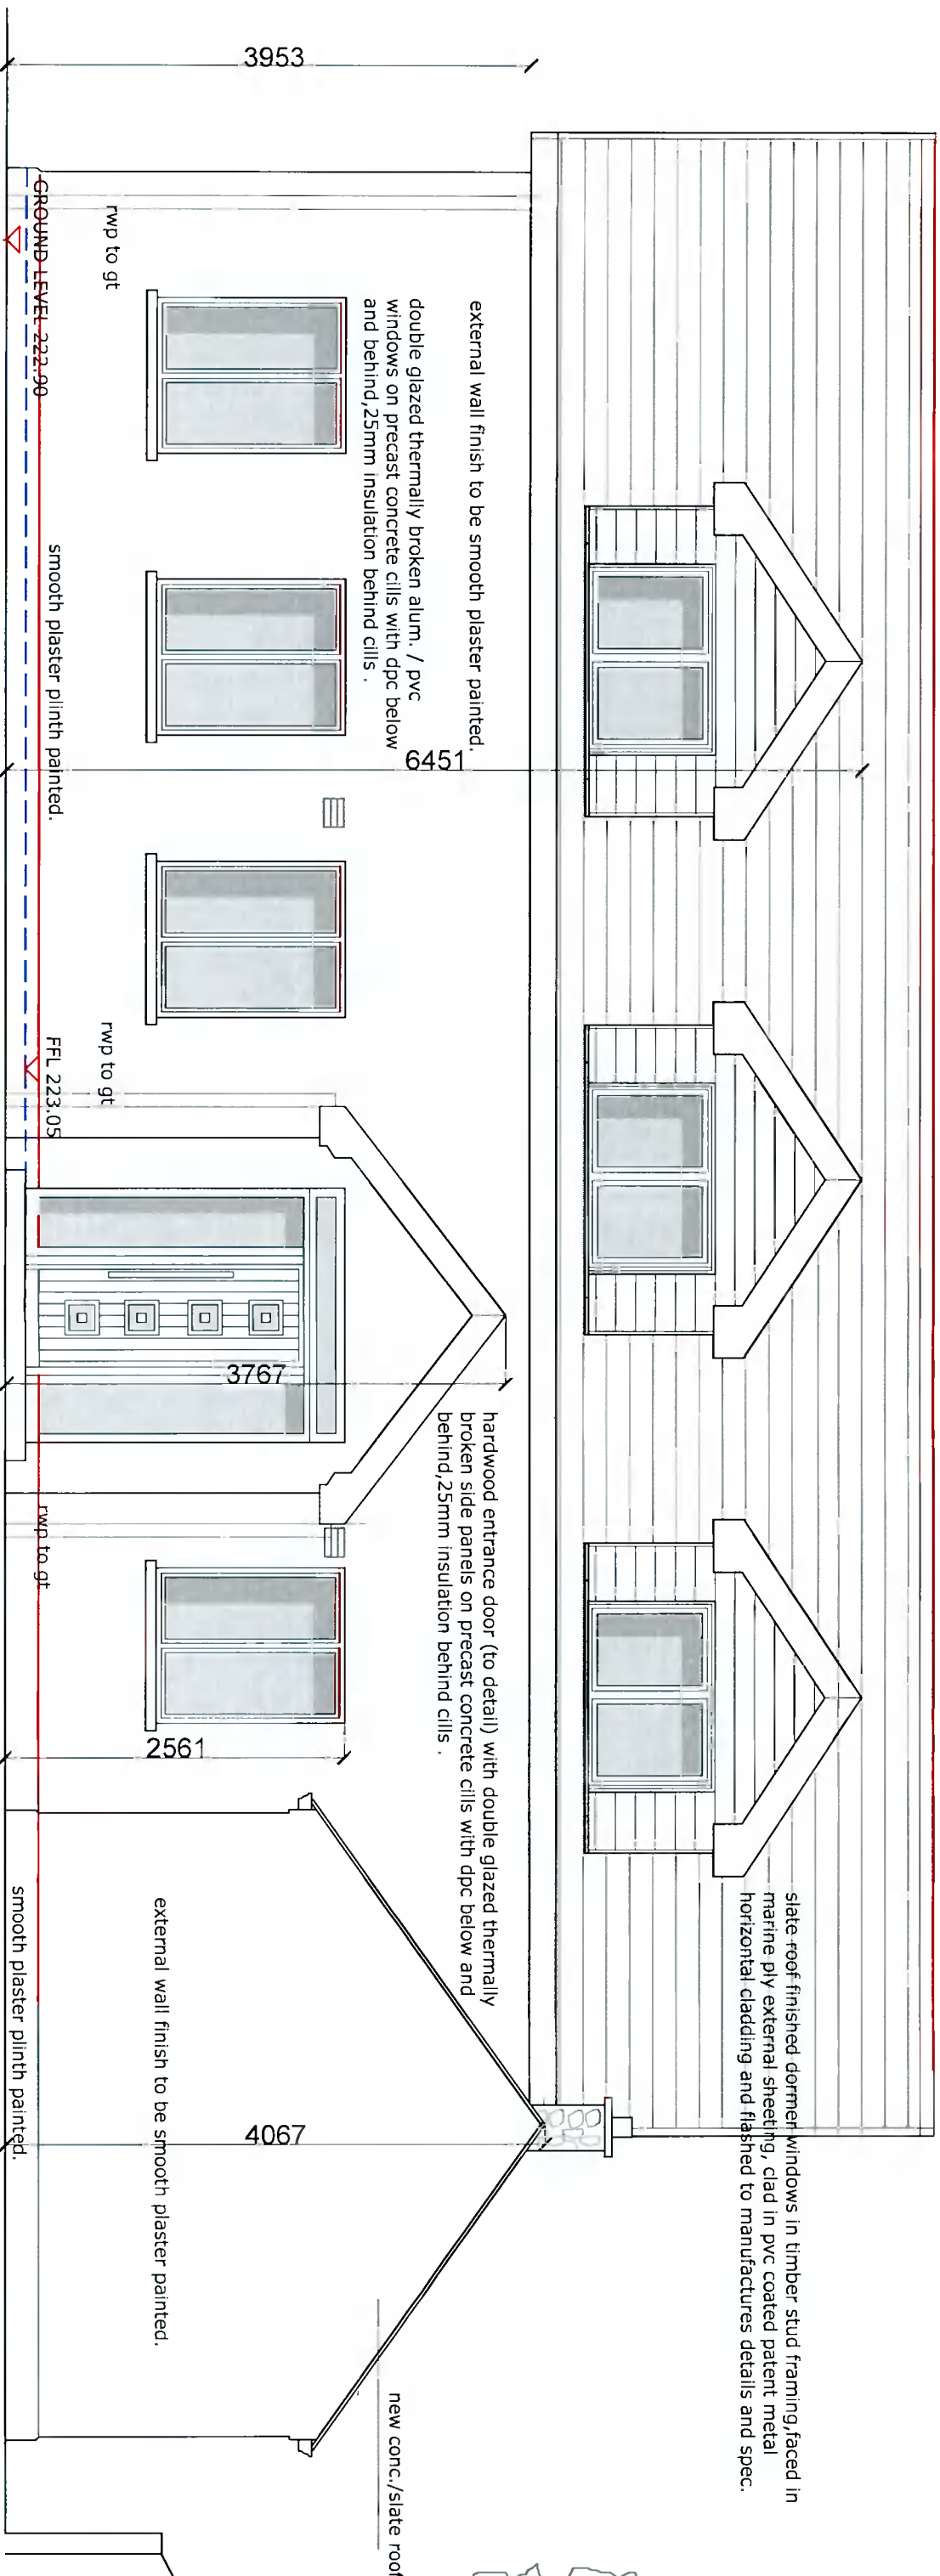

FRONT ELEVATION .


DESMOND J. HALPIN & ASSOCIATES
Planning & Building Design Consultants

15 Caviglea Drive, Fintona, Dublin 24 Phone: 01-4523710 Email: deshalpin15@gmail.com

Project:		Scale	Drawn
RETENTION OF AS BUILT EXTENSION AND RENOVATIONS TO CORNAON COTTAGE, MOUNTPELIER, BOHERNABRENA, DUBLIN 24		1:50 @ A3.	DJH
Drawing Title		Drawing No	Rev
FRONT ELEVATION.		06C-20-19	
Applicant:	Date	CHK	
DECLAN & JENNIFER WEBB	MAR. 2020.	JK	

RETENTION 2021

slate roof tiles to match existing on 50mm x 25mm timber battens on Roofshields breather membrane on 44mm x 175mm C16 rafters, collars and ceiling joists @ 400mm c/c with 150mm rigid insulation between rafters with 100mm x 75mm timber wall plates on dpc strapped to new structure. 5lb lead flashing

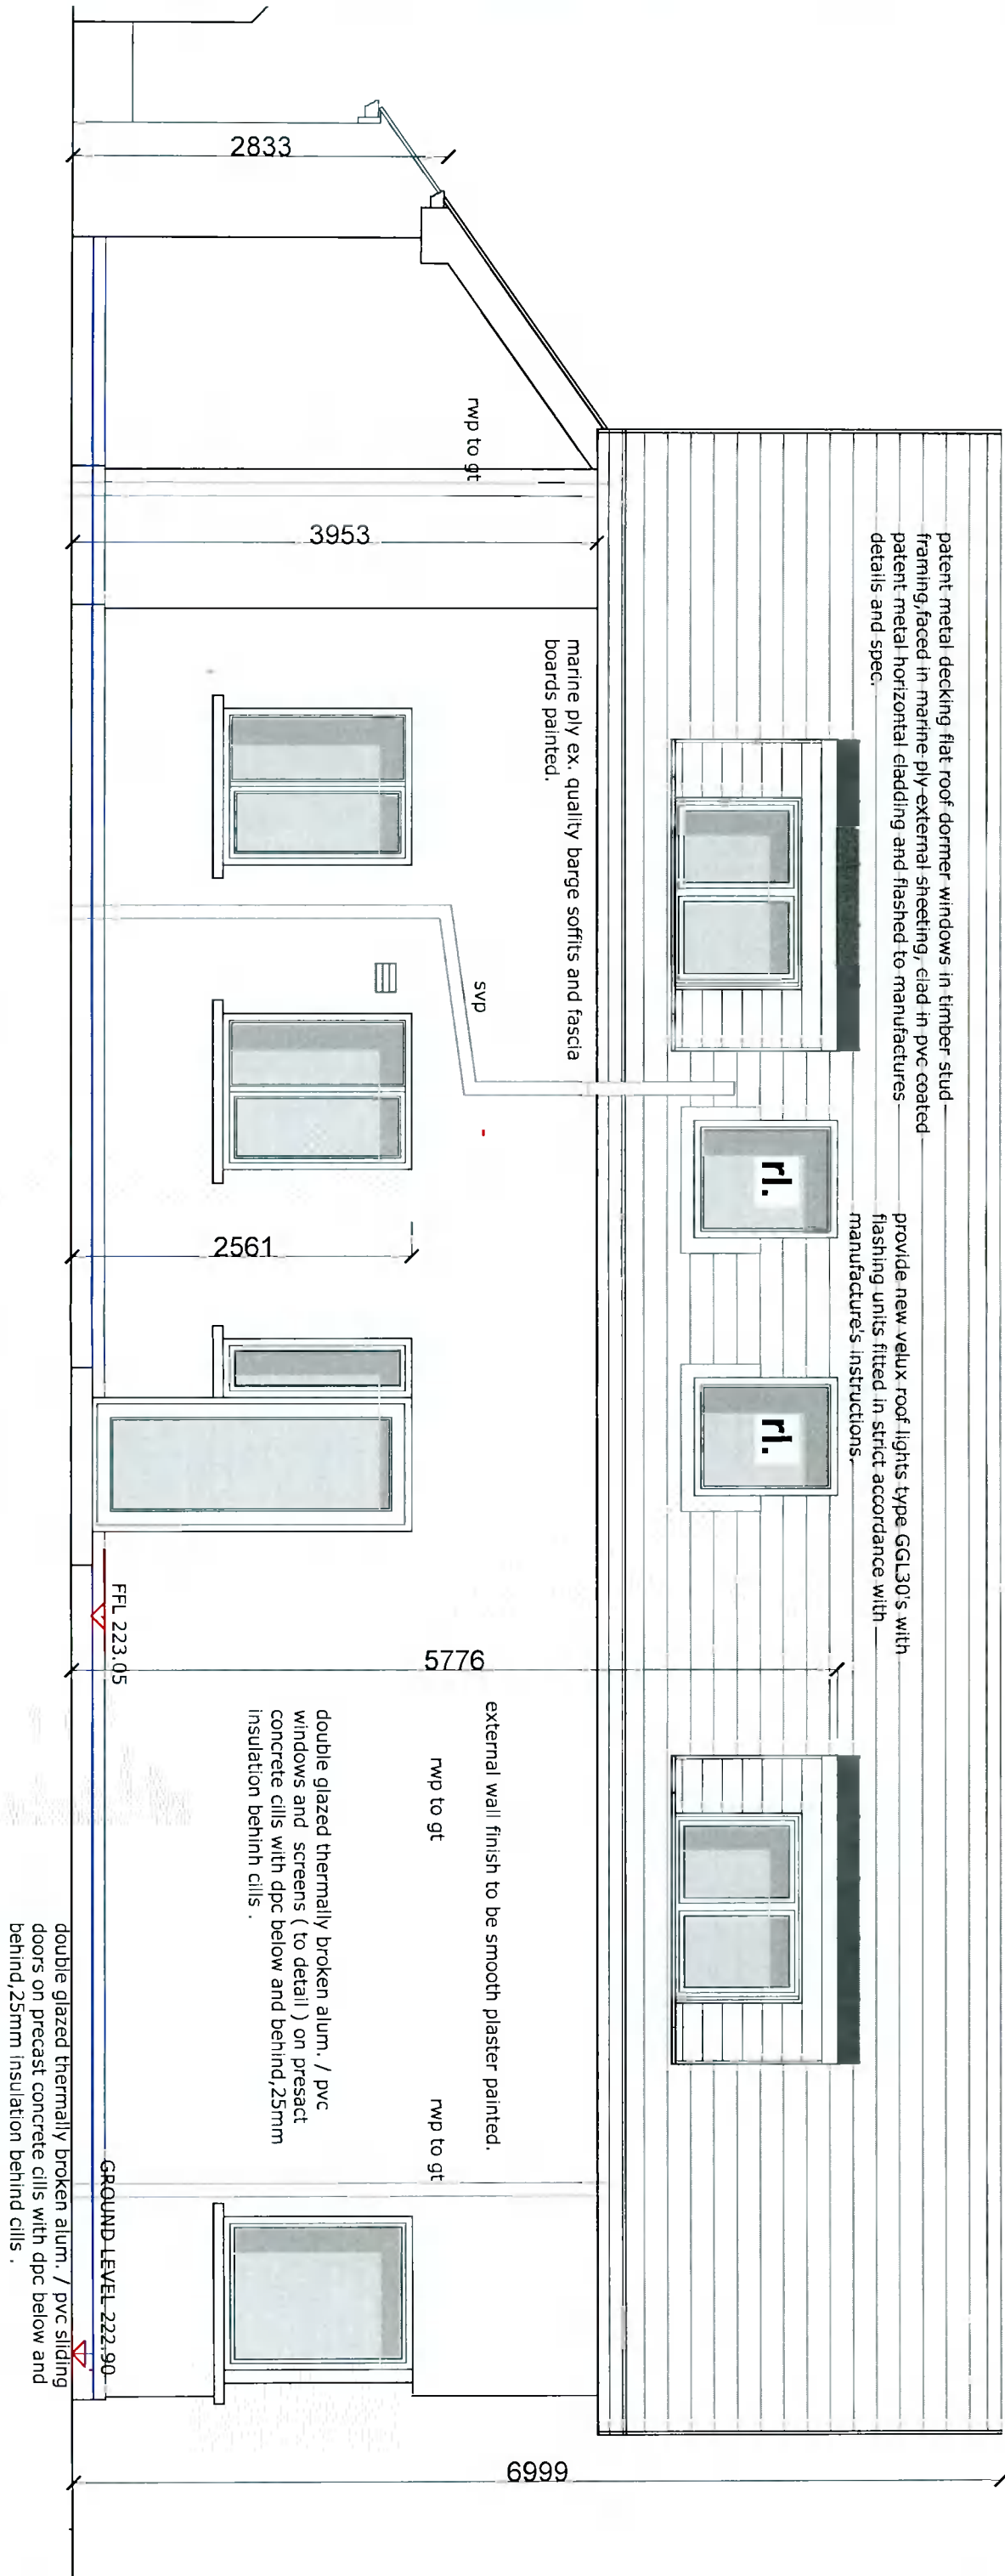


REAR ELEVATION .

DESMOND J. HALPIN & ASSOCIATES
Planning & Building Design Consultants

15 Camogie Drive, Fintona, Dublin 24 Phone: 01-4523710 Email: deshalpin15@gmail.com

Project:	RETENTION OF AS BUILT EXTENSION AND RENOVATIONS TO CORNAON COTTAGE, MOUNTPELIER BOHERNABRENA, DUBLIN 24.	Scale:	1:50 @ A3.	Drawn:	DJH
Drawing Title:	REAR ELEVATION	Drawing No:	07C-20-19	Rev:	
Applicant:	DECLAN & JENNIFER WEBB.	Date:	SEPT 2021	CHK:	JK

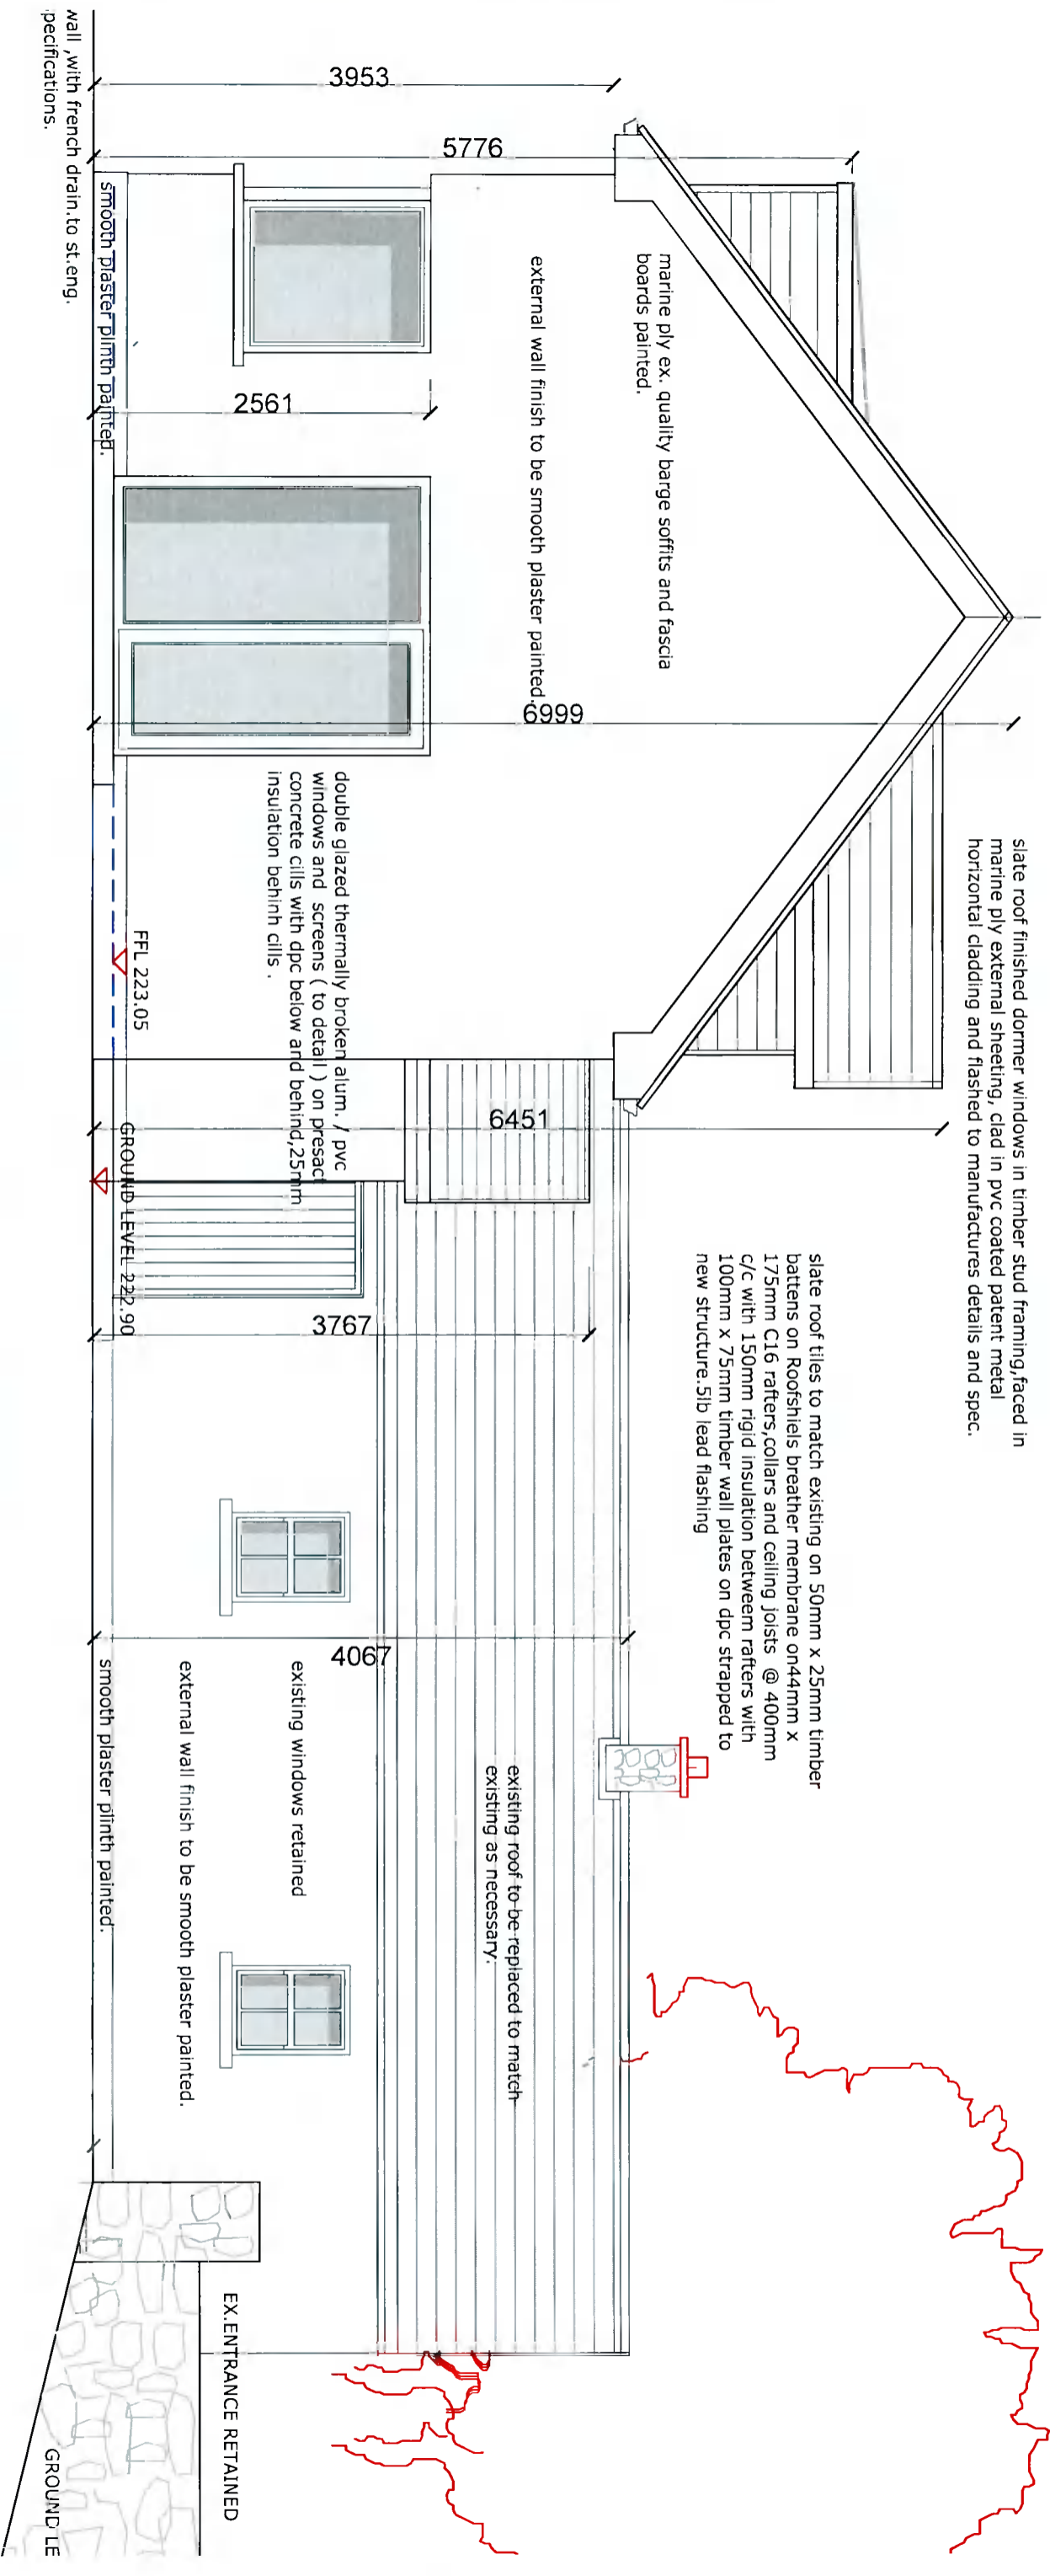


NORTH GABLE ELEVATION .

DESMOND J. HALPIN & ASSOCIATES
Planning & Building Design Consultants

15 Camogie Drive, Finhouse, Dublin 24 Phone 01 4523710 Email: deshalpin15@gmail.com

Project:		Scale	Drawn
RETENTION OF AS BUILT EXTENSION AND RENOVATIONS TO CORNAKON COTTAGE, MOUNTPELIER BOHERNABRENA, DUBLIN 24.		1:50 @ A3.	DJH
Drawing Title	NORTH GABLE ELEVATION.	Drawing No	Rev
Applicant:	DECLAV & JENNIFER WEBB.	08C-20-19	
Date	SEPT 2021	CHK	JK

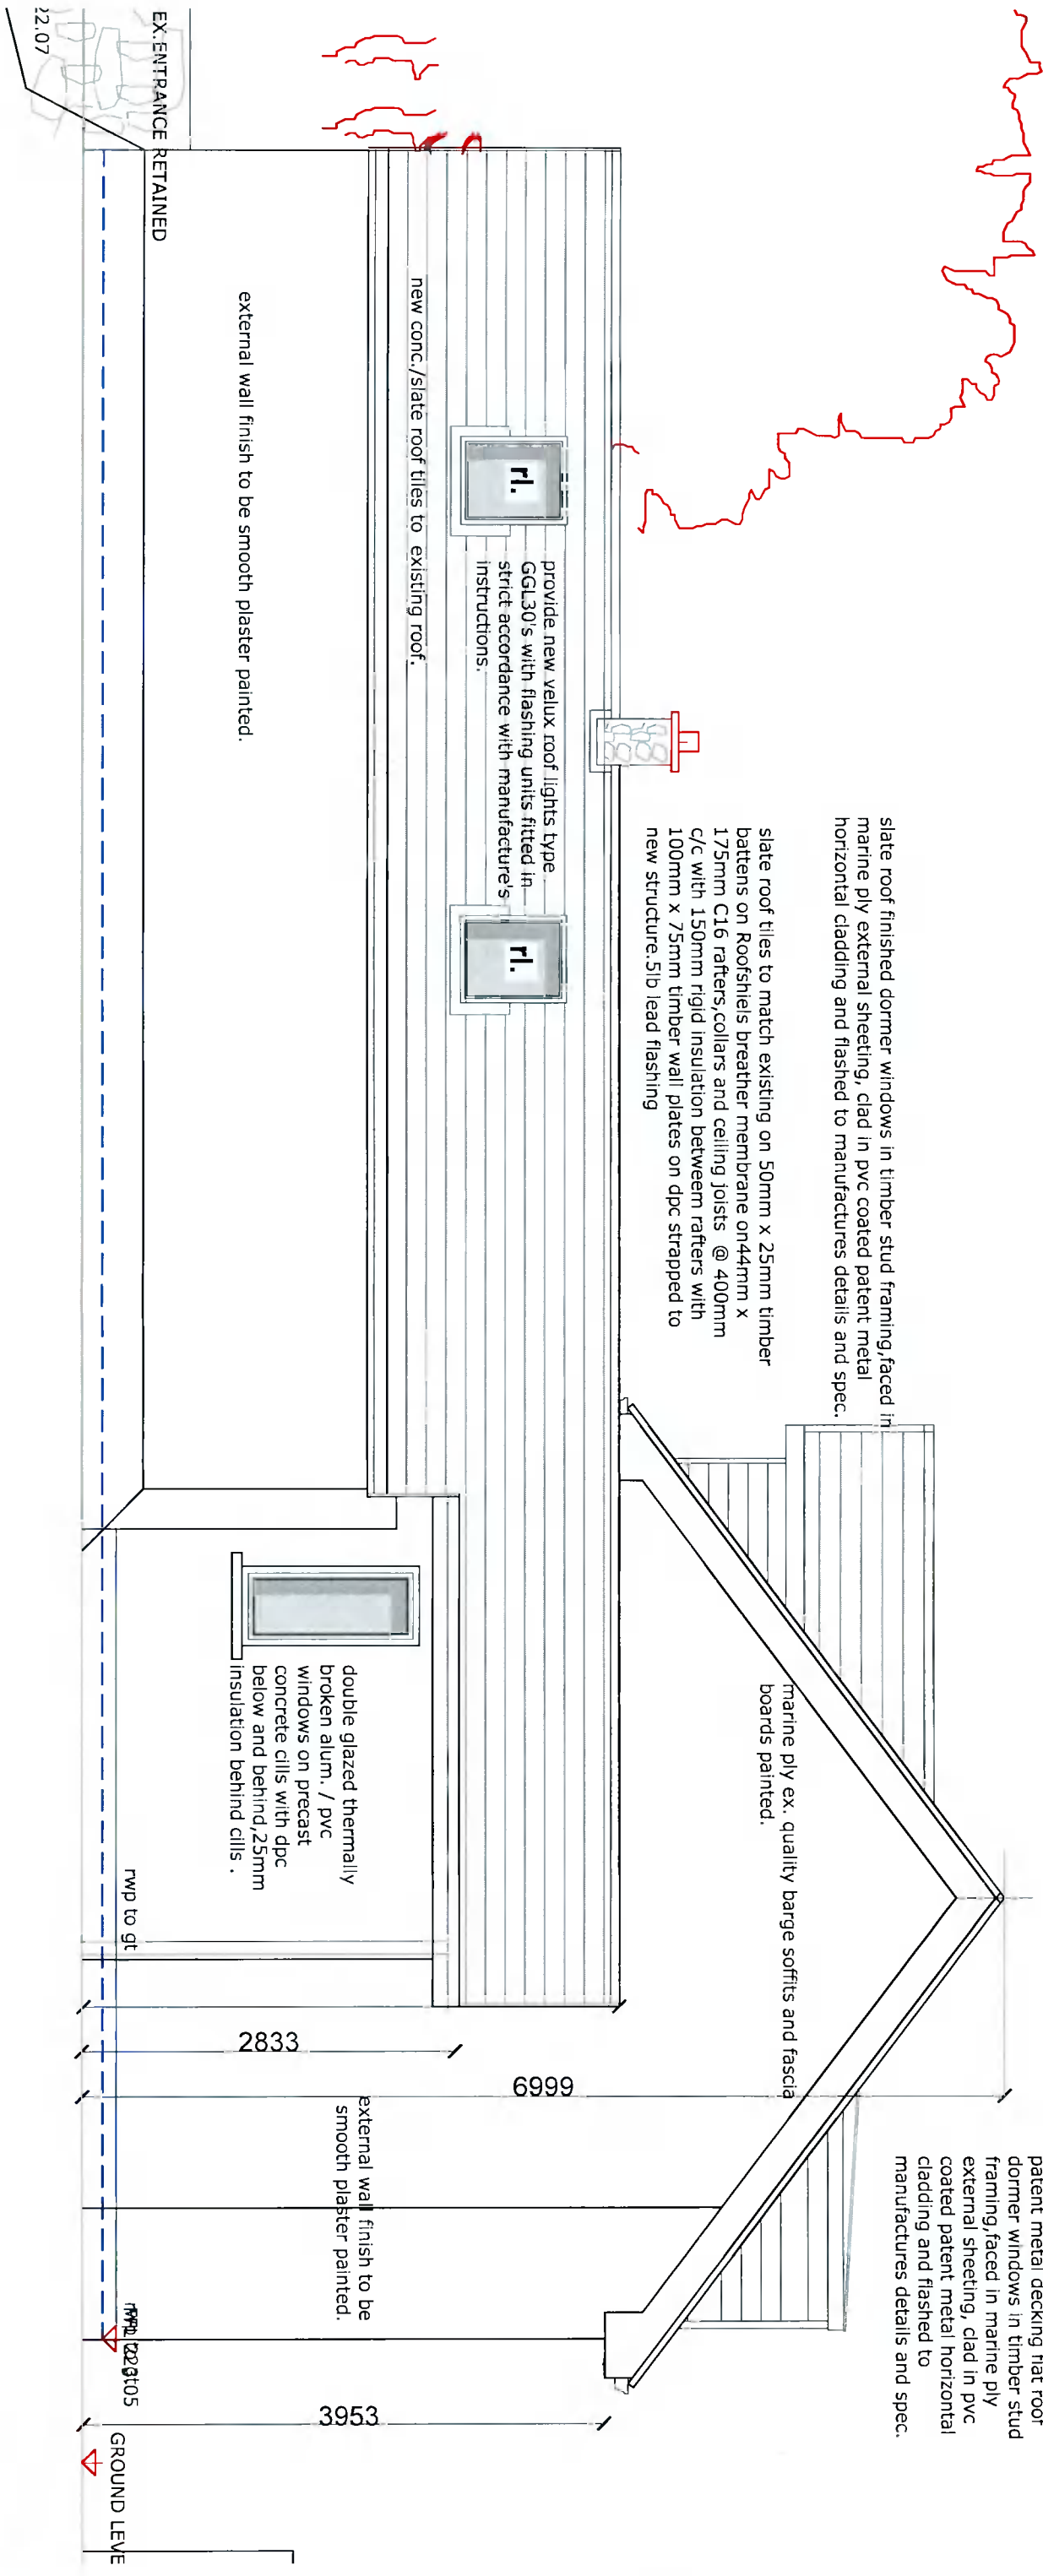

SOUTH GABLE ELEVATION .

DESMOND J. HALPIN & ASSOCIATES
Planning & Building Design Consultants

Project: RETENTION OF AS BUILT EXTENSION AND RENOVATIONS TO CORNAKON COTTAGE, MOUNTPELIER BOHERNABREINA, DUBLIN 24.
 15 Carrigee Drive, Fintona, Dublin 24 Phone: 01 4523710 Email: dshalpin15@gmail.com

Drawing Title	Scale	Drawn
SOUTH GABLE ELEVATION	1:50 @ A3.	DJH
	Drawing No	Rev
	09C 20- 19	

Applicant:	Date	CHK
DECLAN & JENNIFER WEBB.	SEPT 2021.	JK