




**PROPOSED SITE PLAN**  
SCALE 1:100

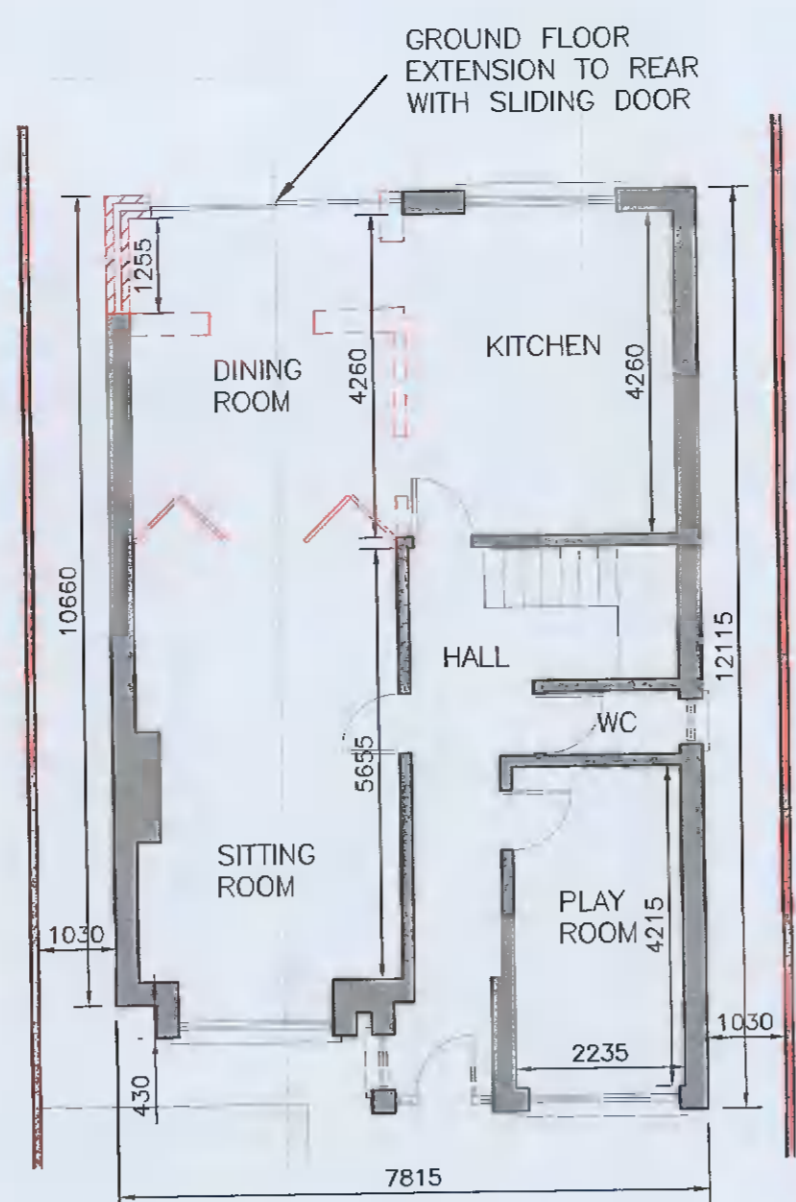


**PROPOSED GROUND FLOOR LAYOUT**  
SCALE 1:100

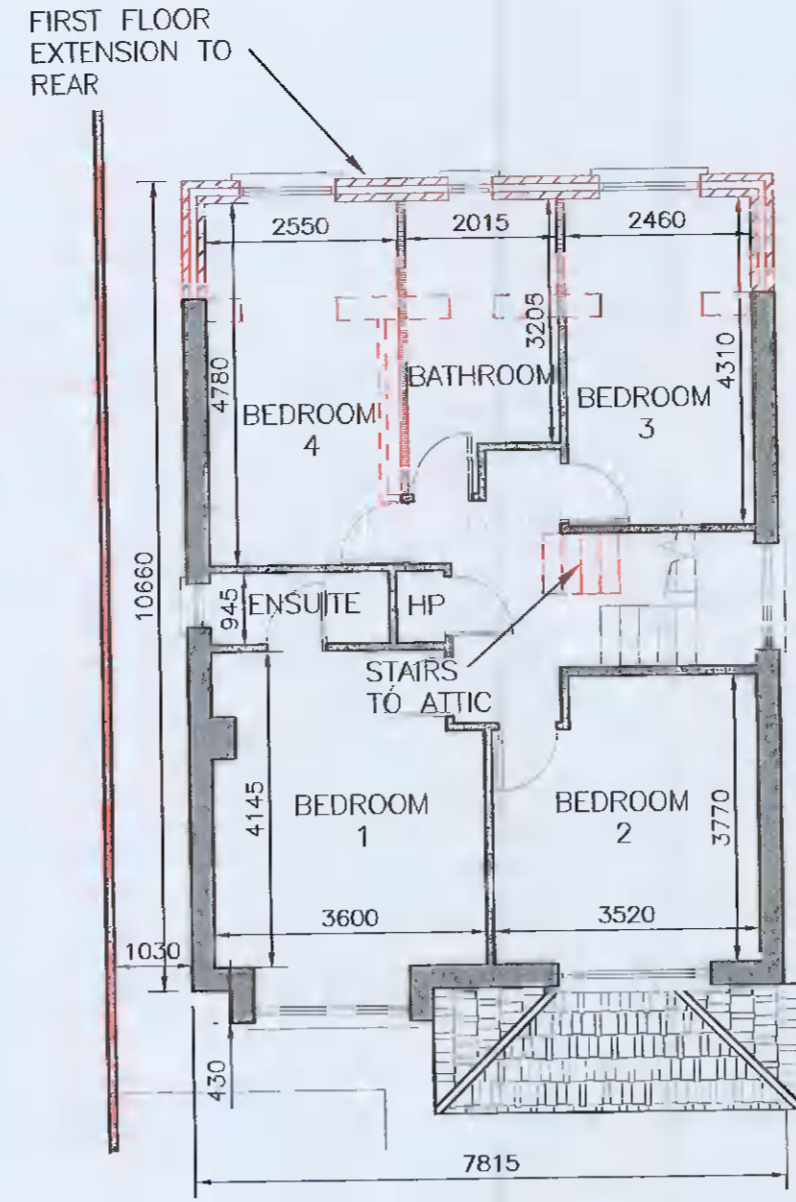


**PROPOSED FIRST FLOOR LAYOUT**  
SCALE 1:100

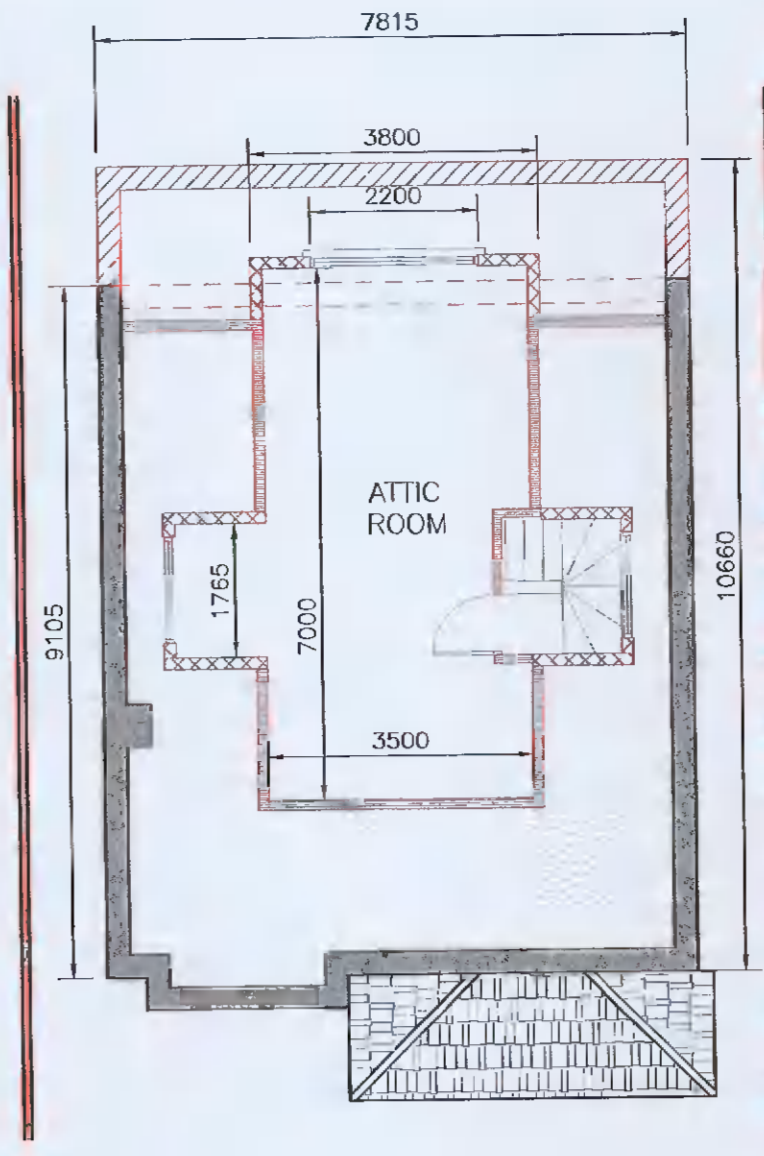


**PROPOSED ATTIC LAYOUT**  
SCALE 1:100

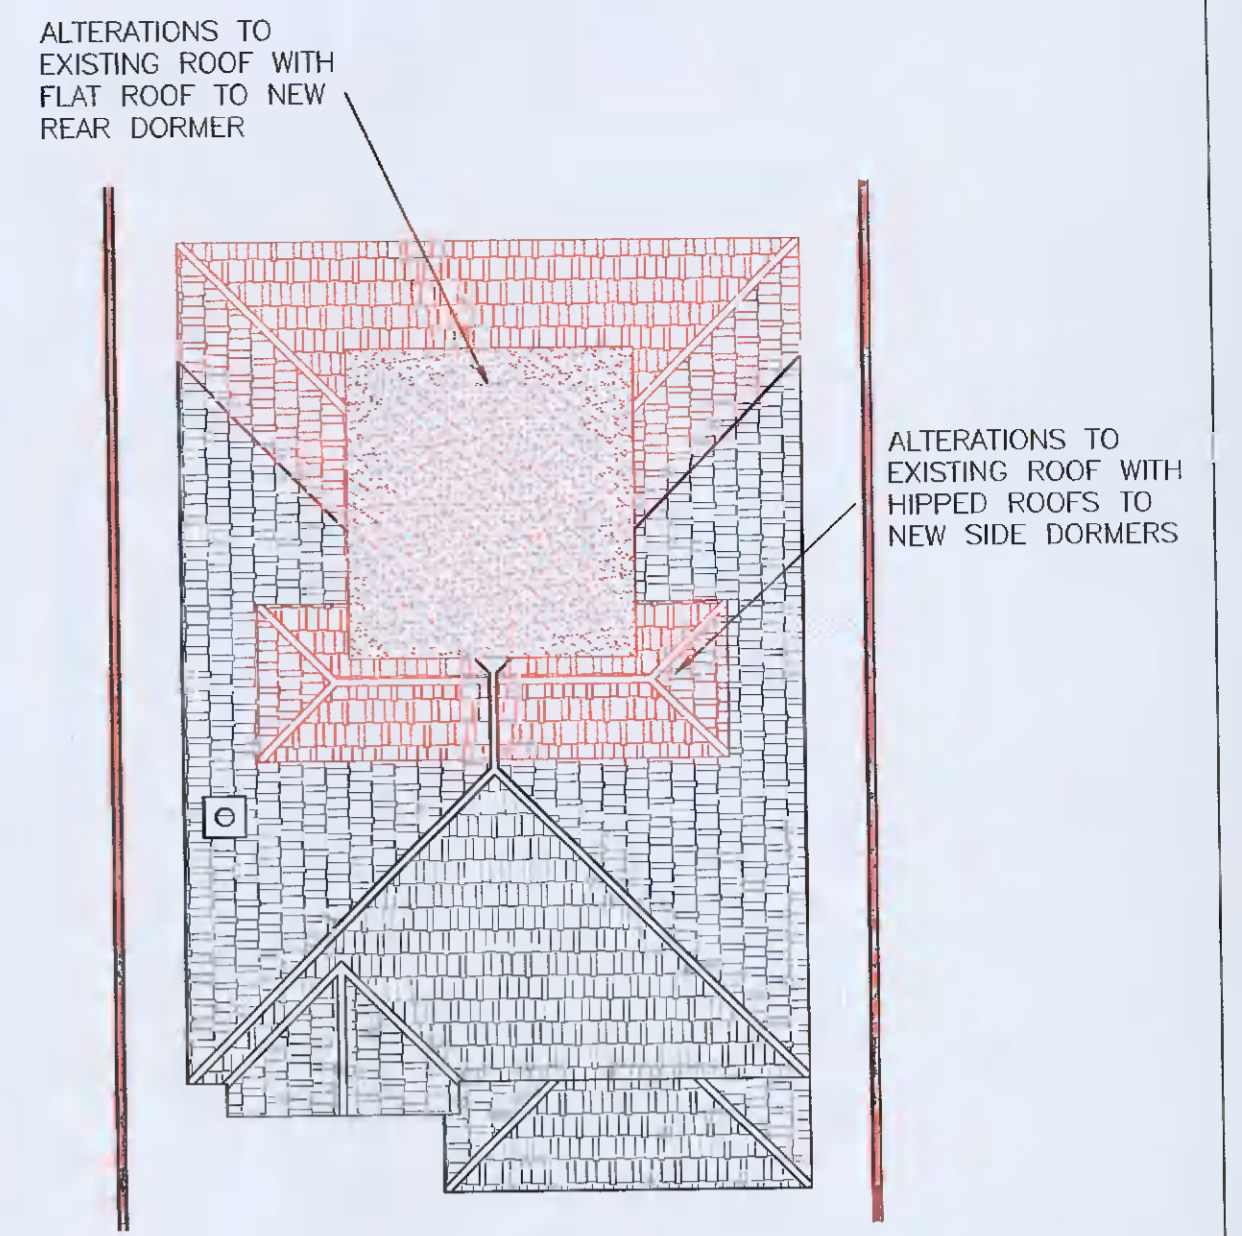


**PROPOSED ROOF LAYOUT**  
SCALE 1:100

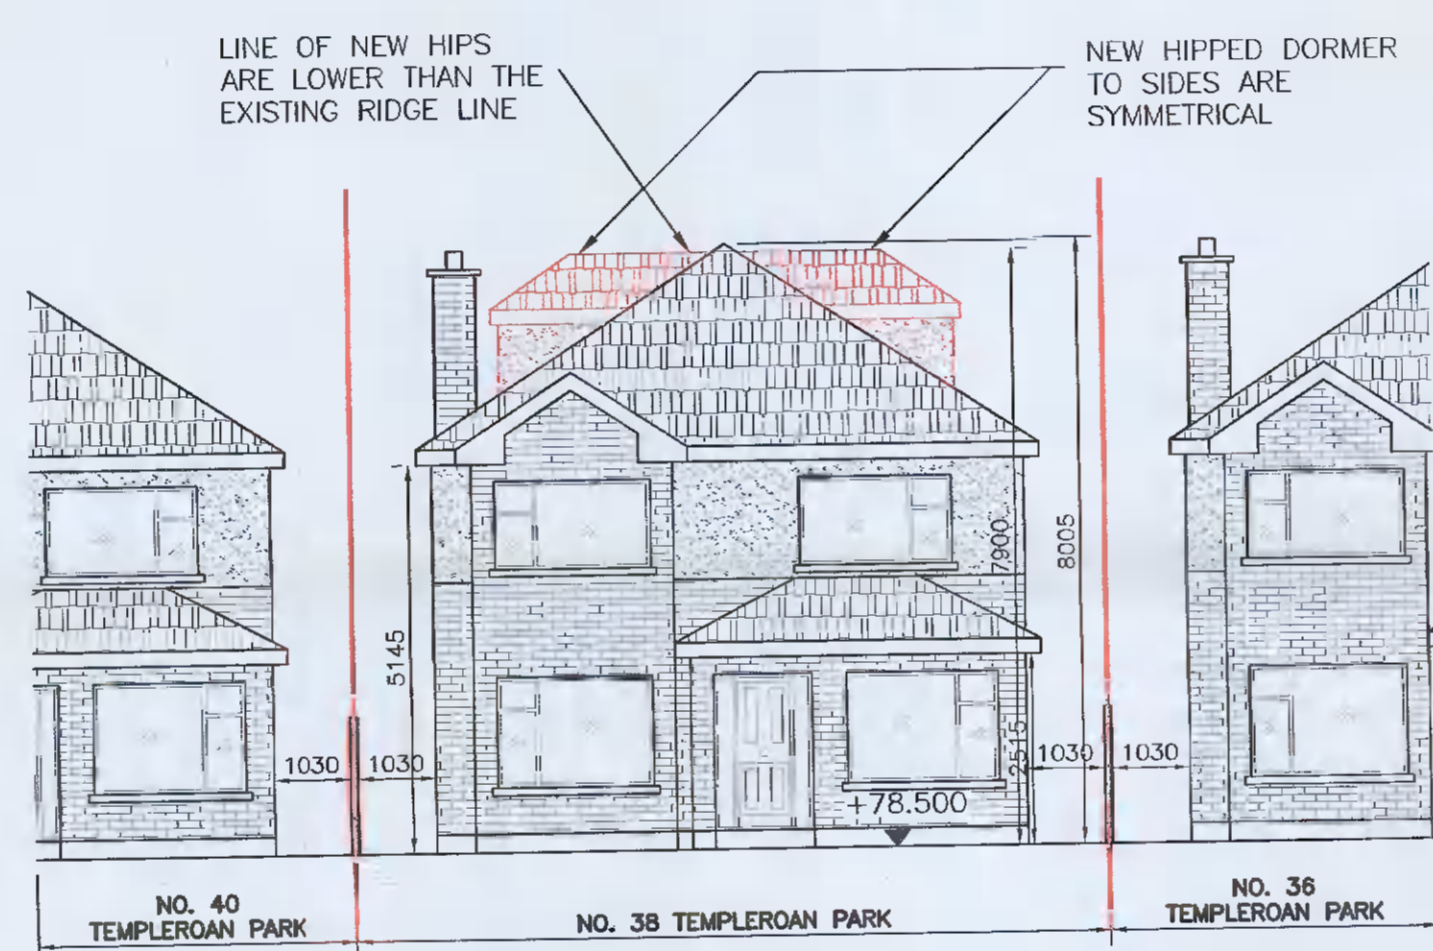


**PROPOSED FRONT ELEVATION**  
SCALE 1:100

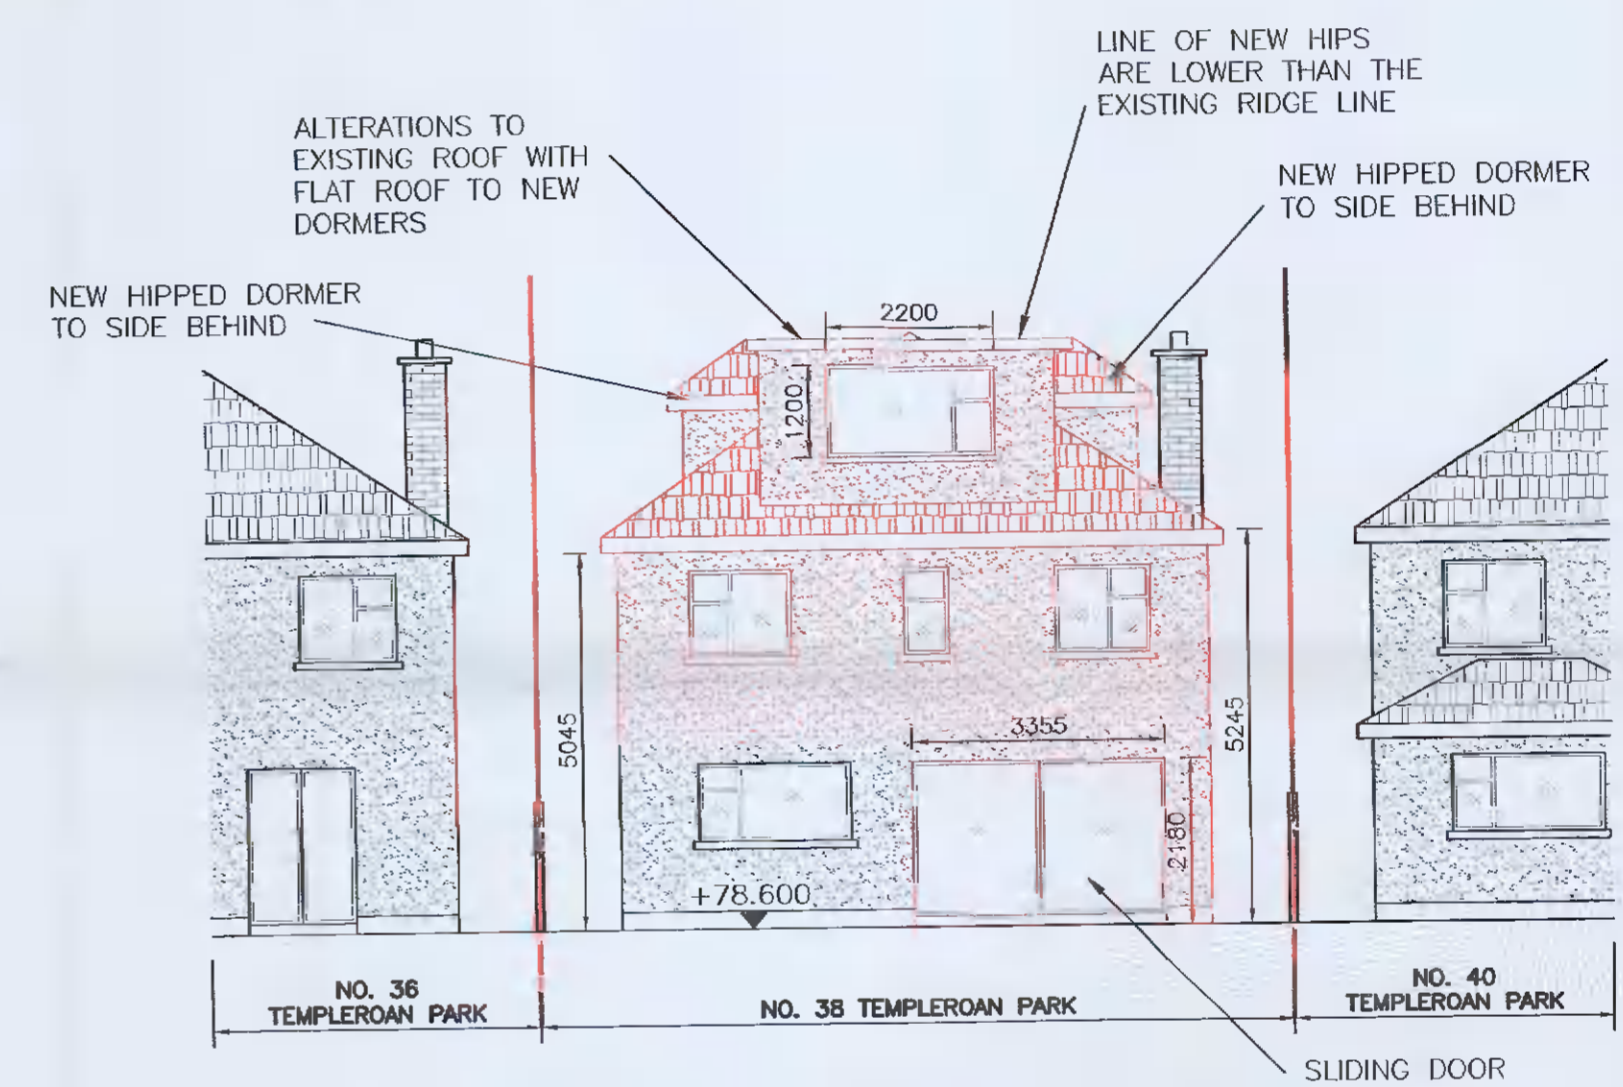


**PROPOSED REAR ELEVATION**  
SCALE 1:100

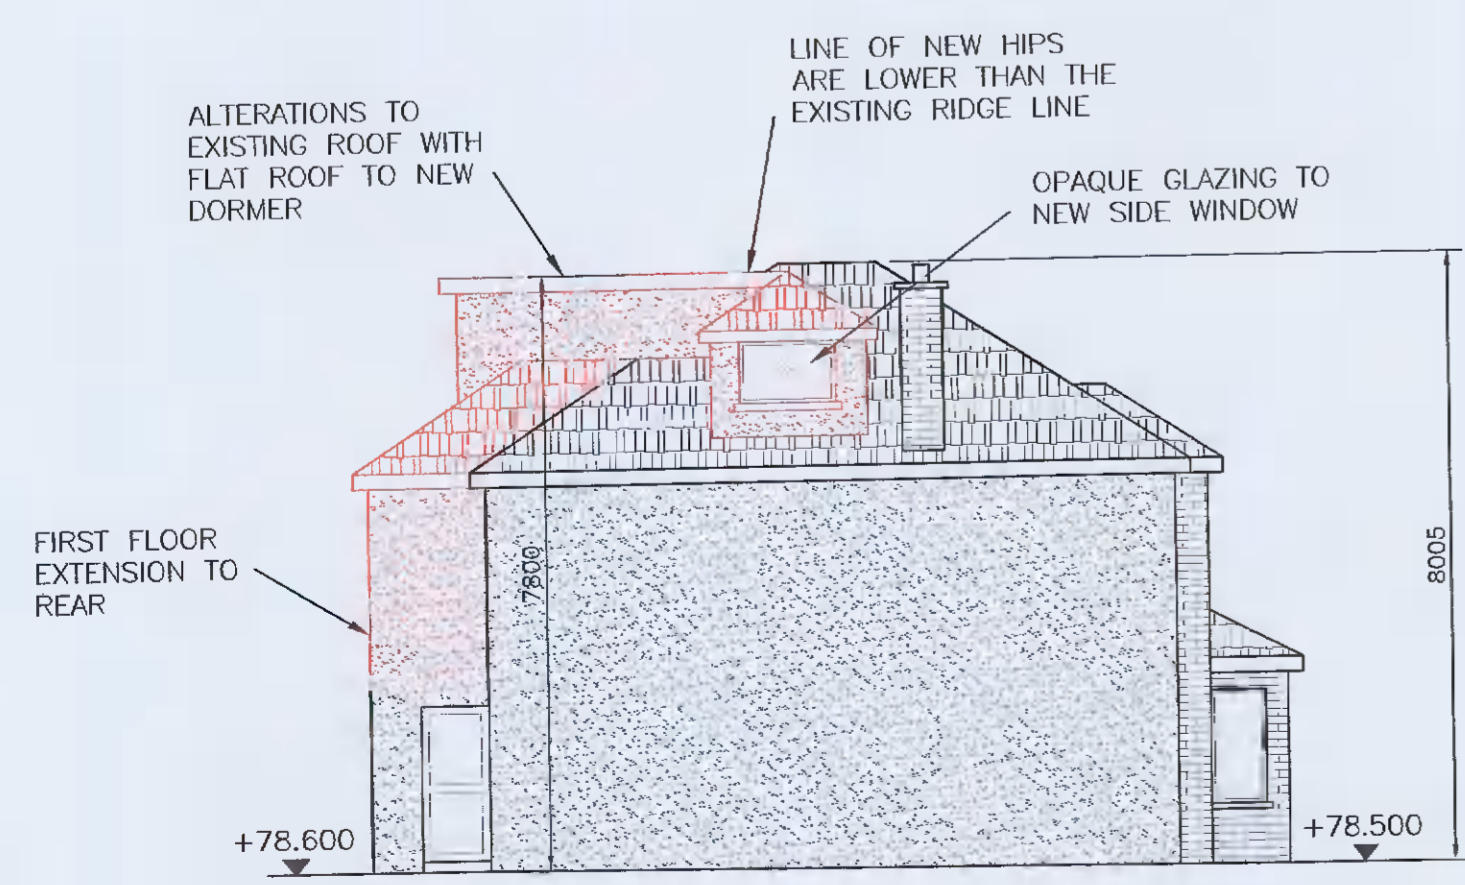


**PROPOSED SIDE ELEVATION - EAST**  
SCALE 1:100

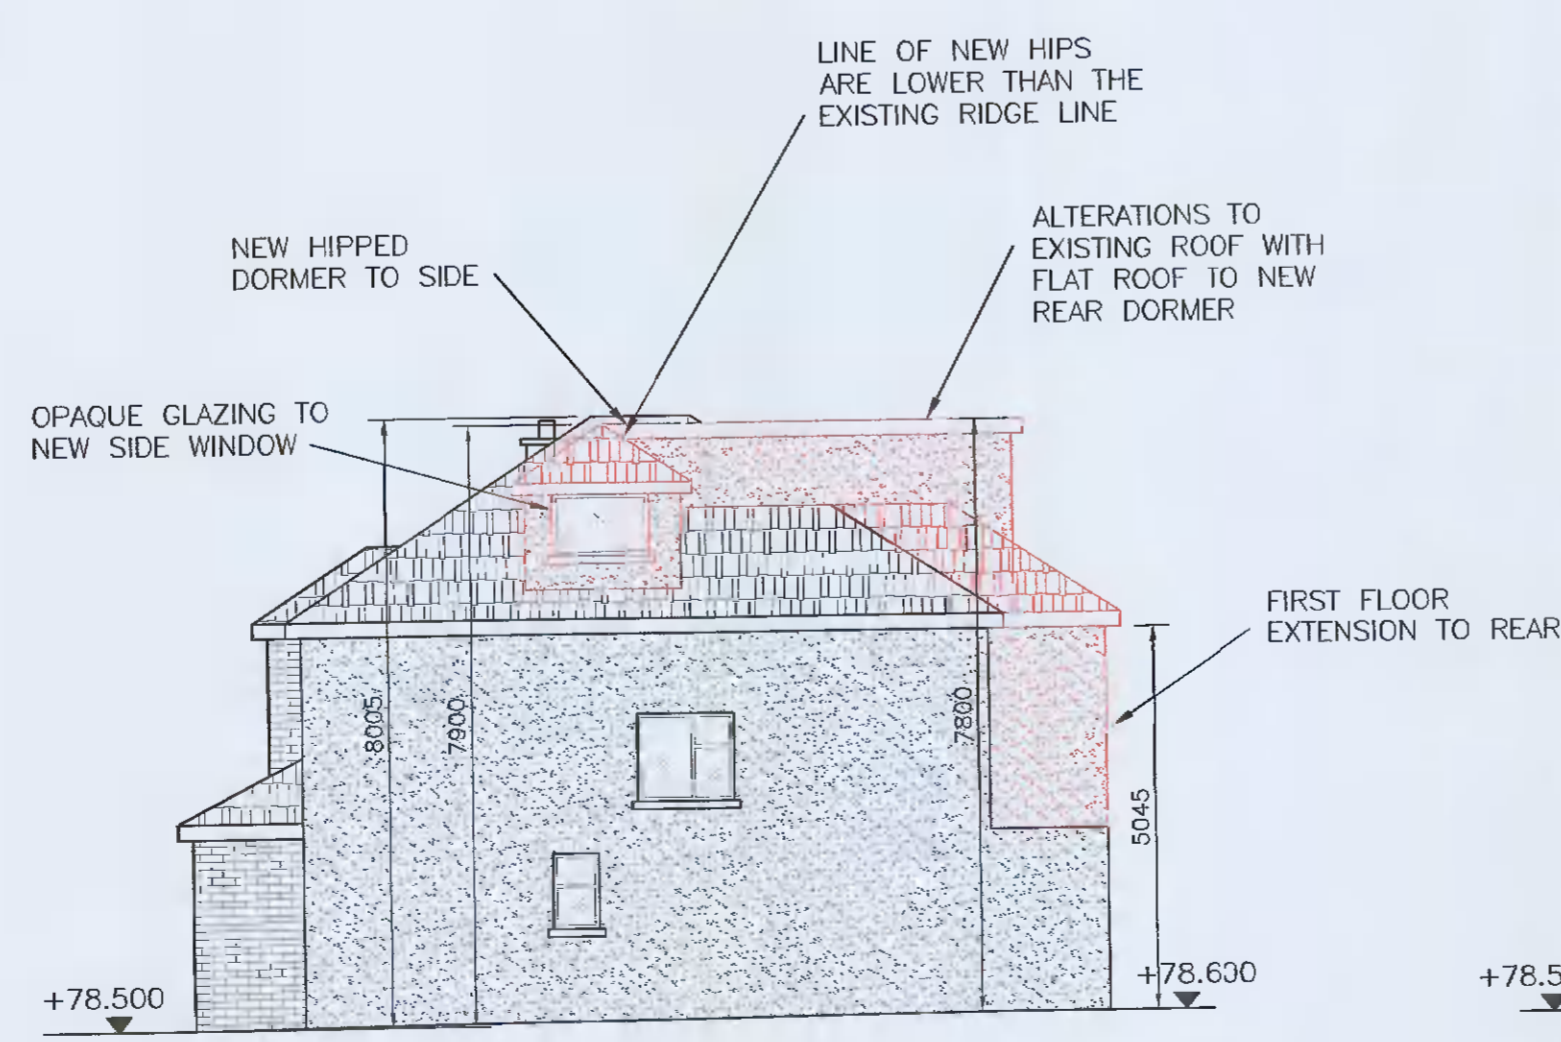

**PROPOSED SIDE ELEVATION - WEST**  
SCALE 1:100

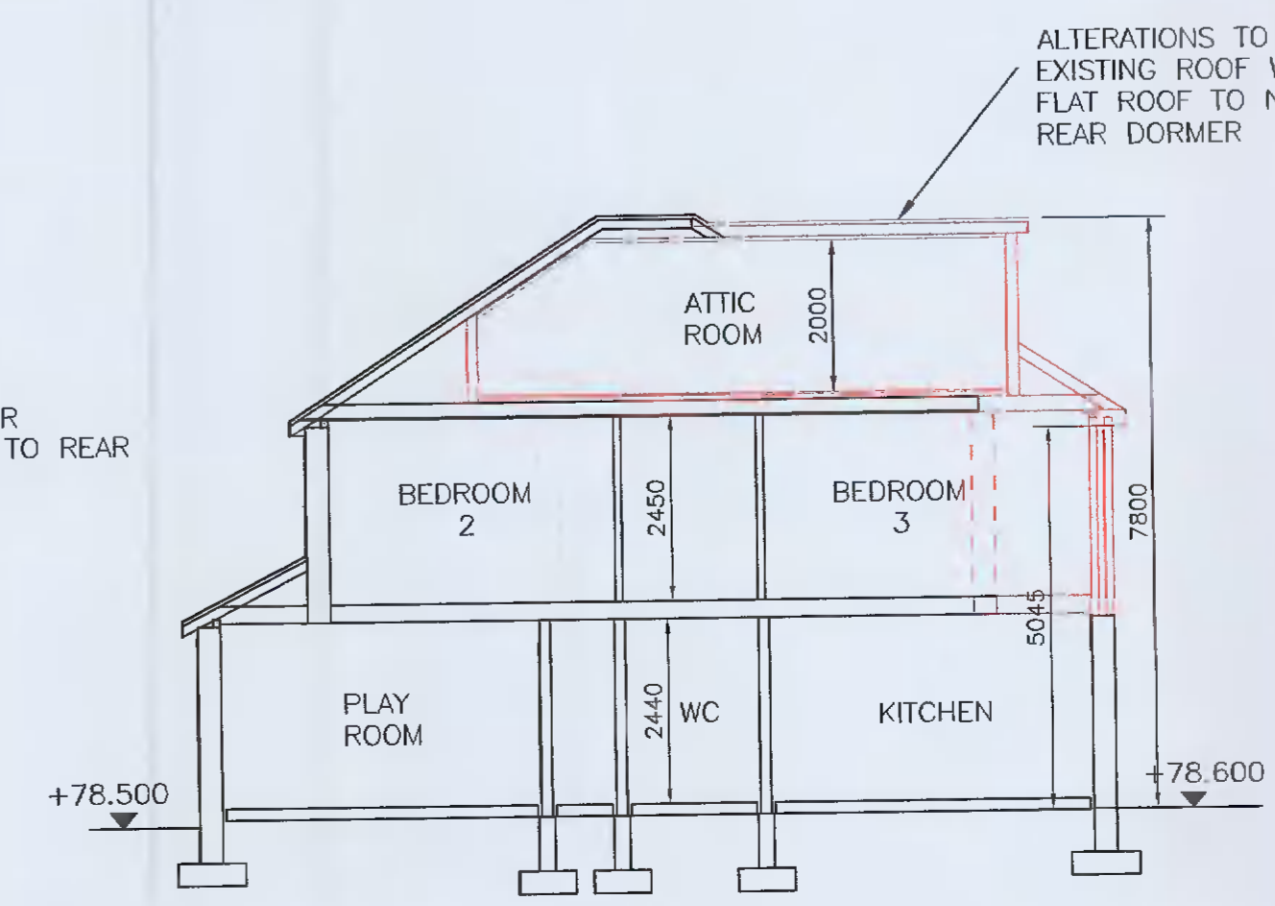

**PROPOSED CROSS SECTION**  
SCALE 1:100

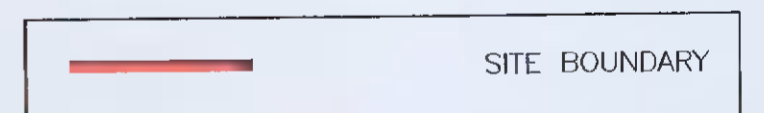

NOTES: - ALL NEW / PROPOSED WORKS ARE SHOWN IN RED

REV.	DATE	DESCRIPTION
PL2	18/10/21	ISSUED FOR ADDITIONAL INFORMATION
PL1	03/08/21	ISSUED FOR PLANNING
PL0	04/05/21	ISSUED FOR PRE PLANNING

CLIENT:  
RUTH BYRNE & DES CONDON

PROJECT:  
WORKS AT 38  
TEMPLEROAN PARK,  
KNOCKLYON,  
DUBLIN 16

DRAWING TITLE:  
PROPOSED LAYOUTS &  
ELEVATIONS

SCALE: 1:100 @ A1  
DATE: APRIL 2021  
DRAWING NUMBER: 21-104-002

CONSULTING ENGINEERS

26A MAYWOOD LAWN  
RAHENY  
DUBLIN 5  
tel: +353 87 901 73 25  
email: ross.somers@gmail.com

DWG STATUS: PLANNING  
DRAWN BY: RS  
REVISION: PL2