





PROPOSED DEVELOPMENT
RETENTION OF 'AS-CONSTRUCTED' DEVELOPMENT.

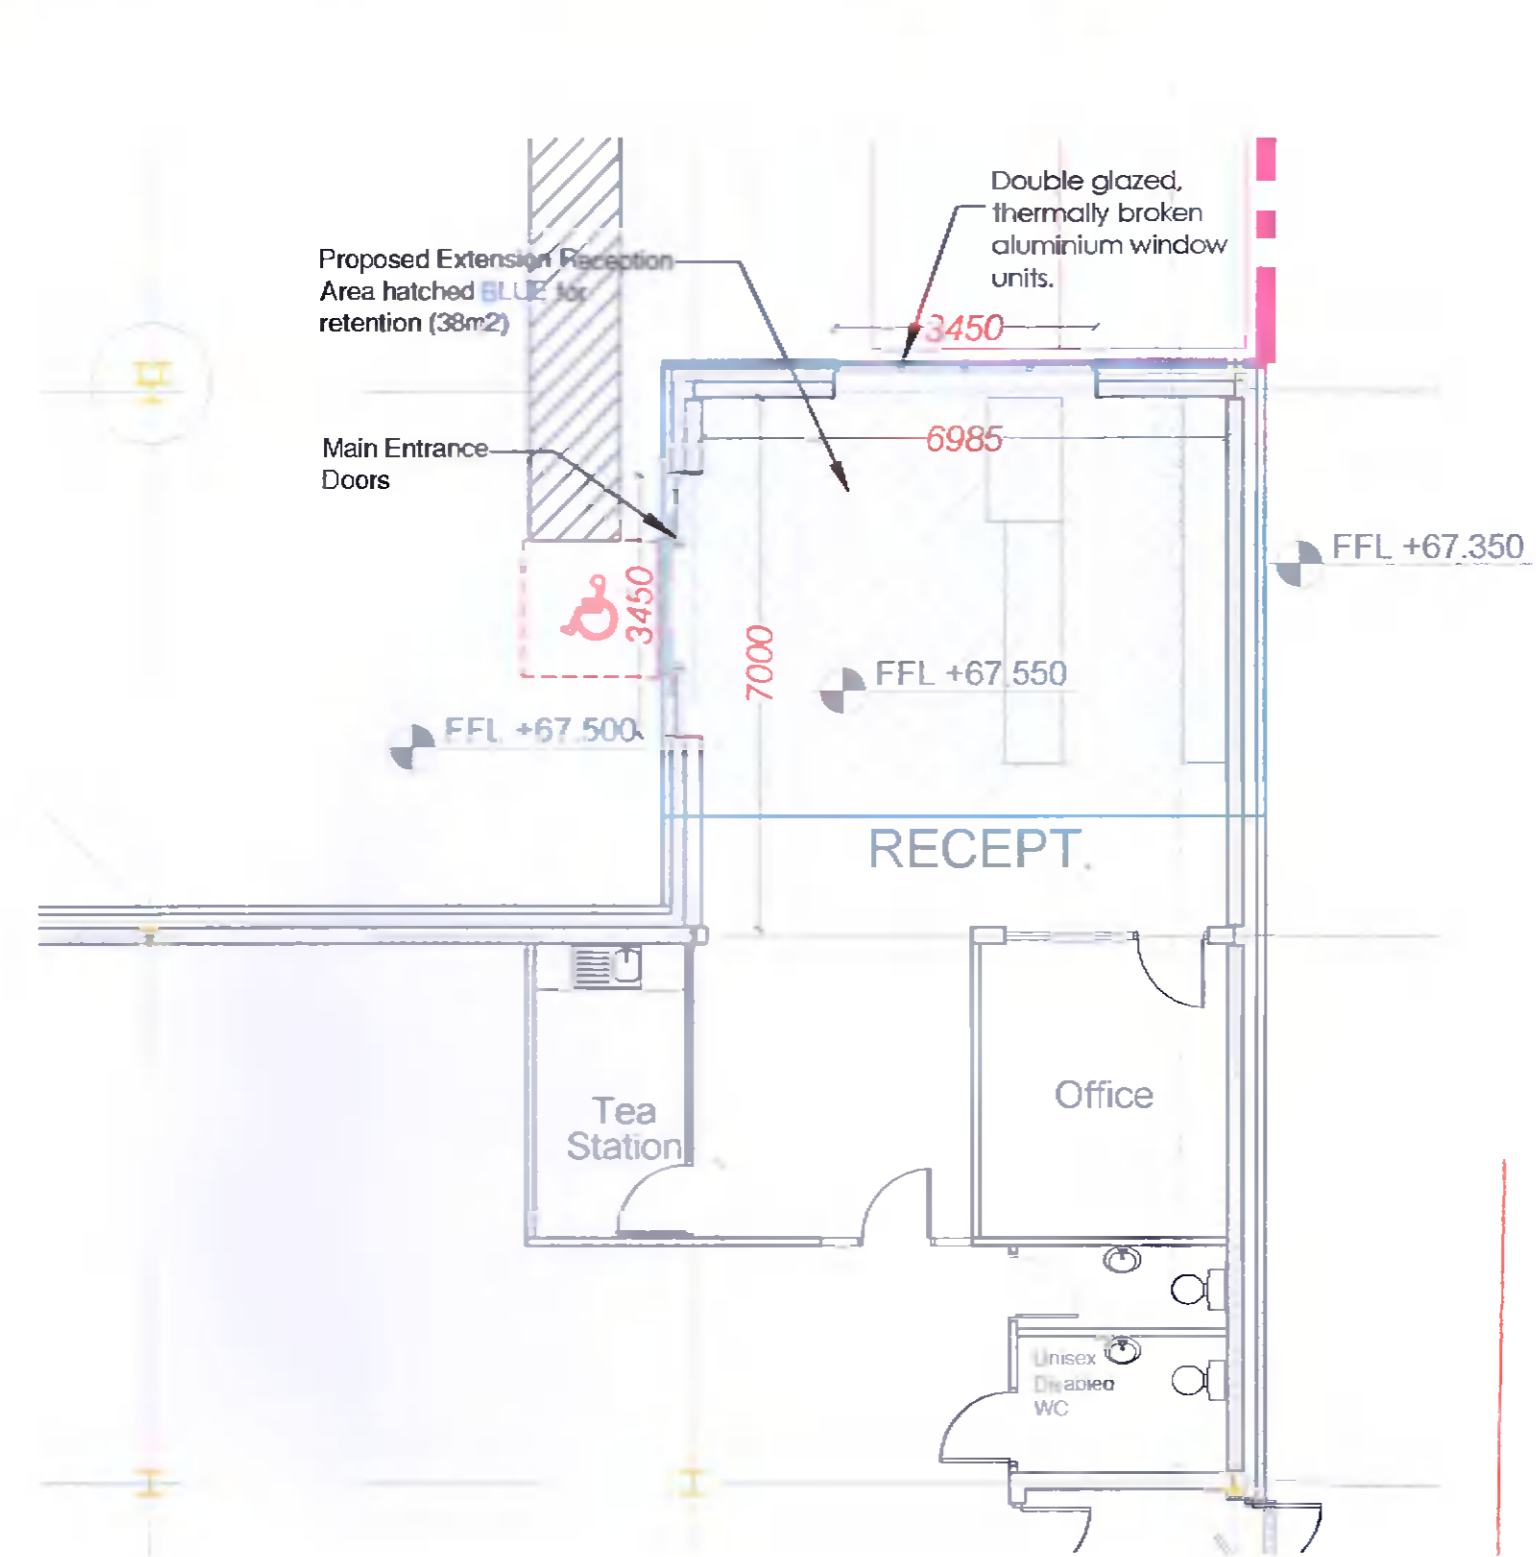

Ground Floor Plan (Scale 1:100).

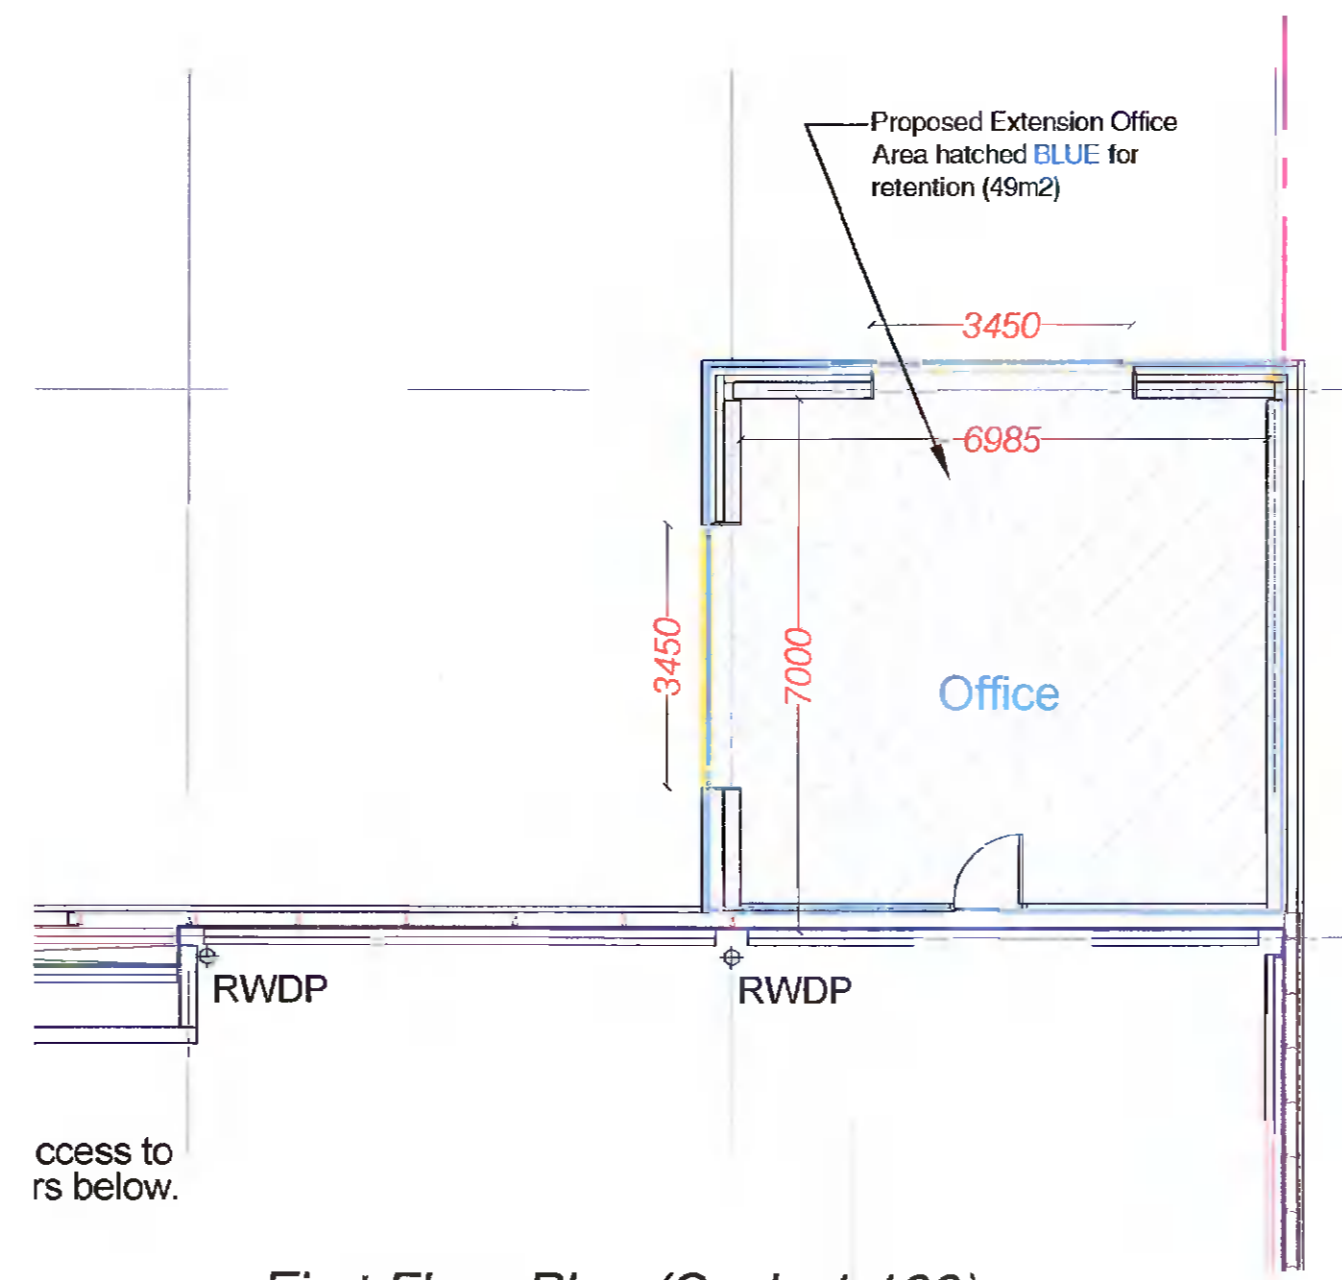


First Floor Plan (Scale 1:100).

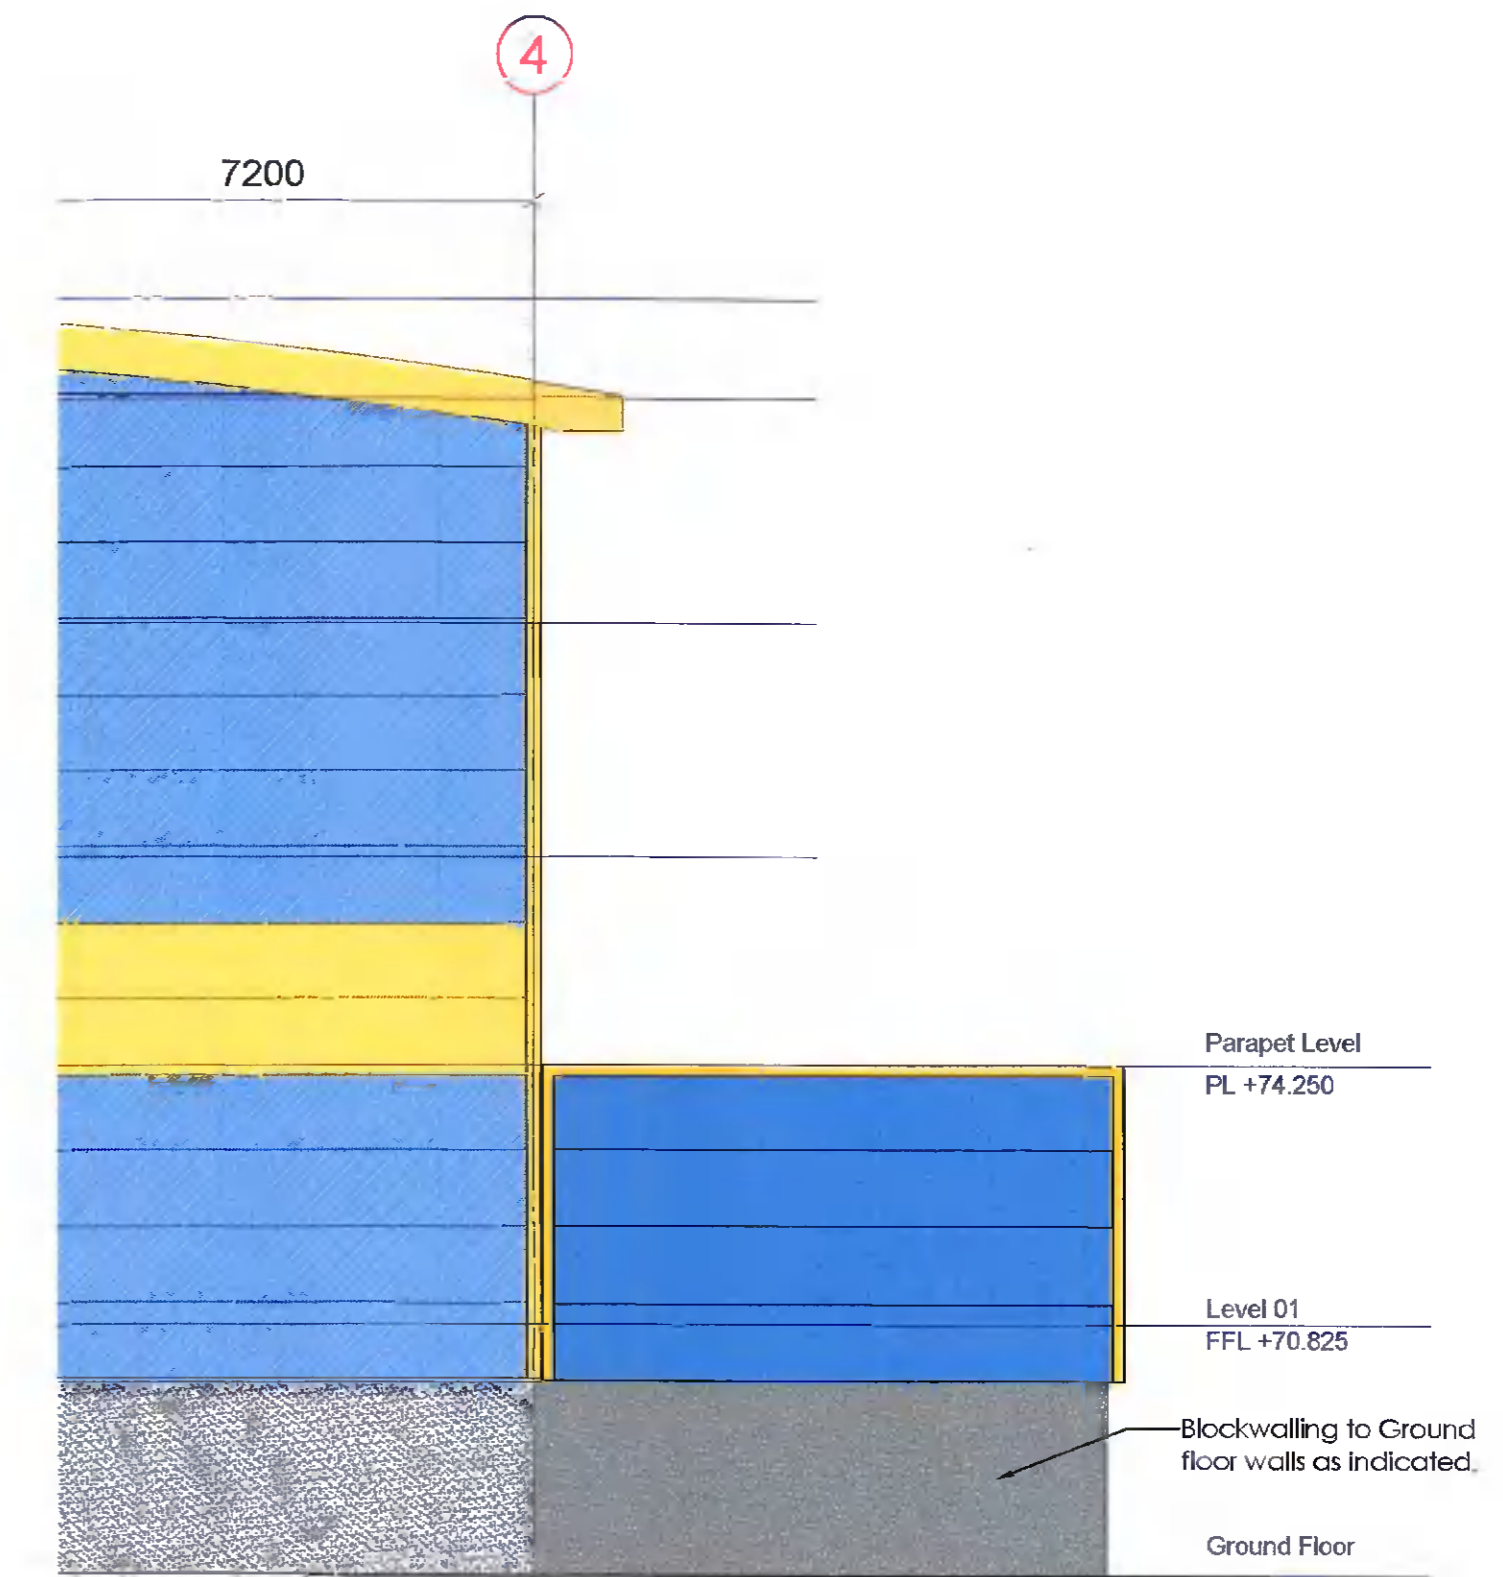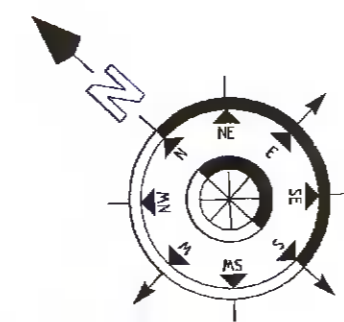


South-East Elevation (Scale 1:100).


PREVIOUSLY APPROVED DEVELOPMENT
(PLANNING REG. NO. SD16A/0456)

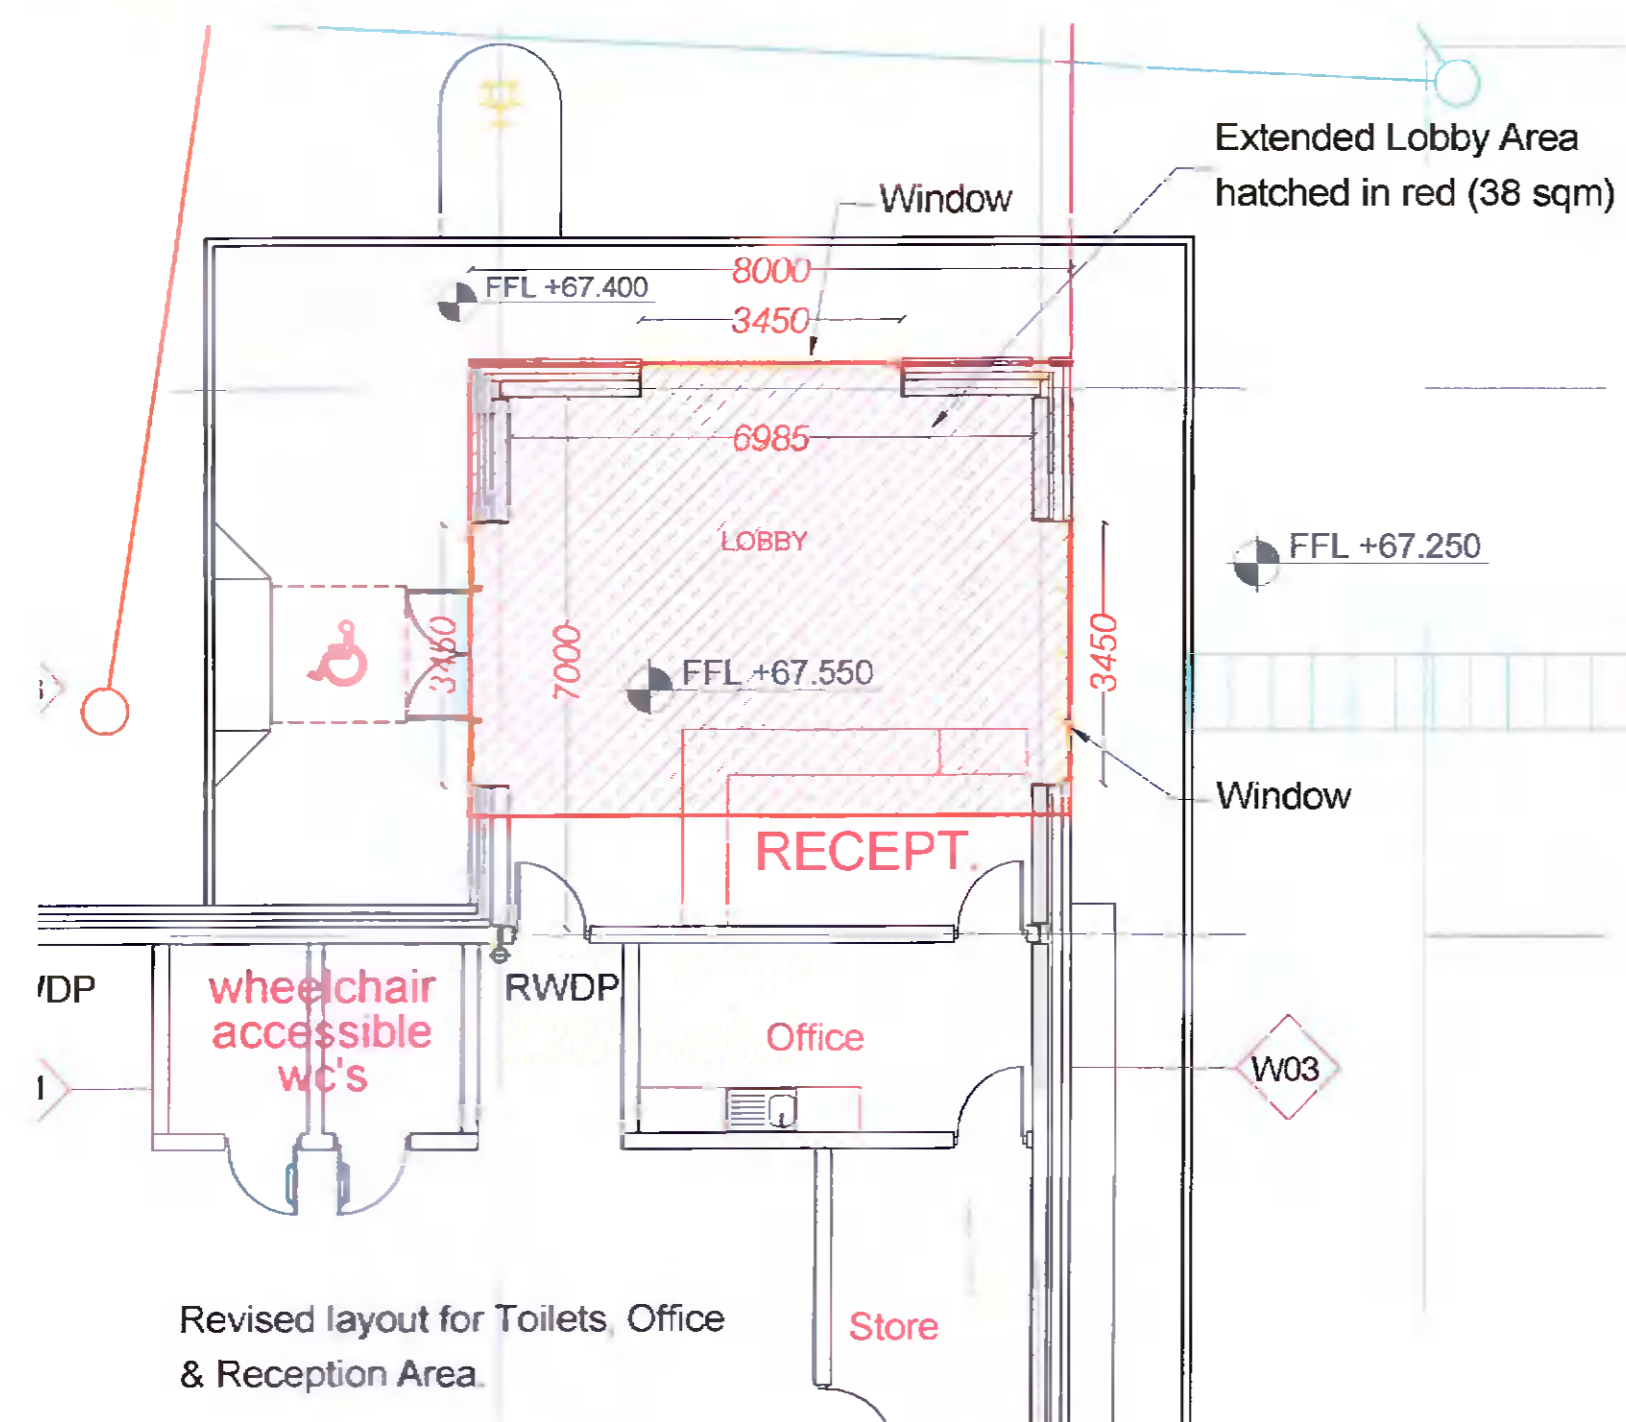

Ground Floor Plan (Scale 1:100).

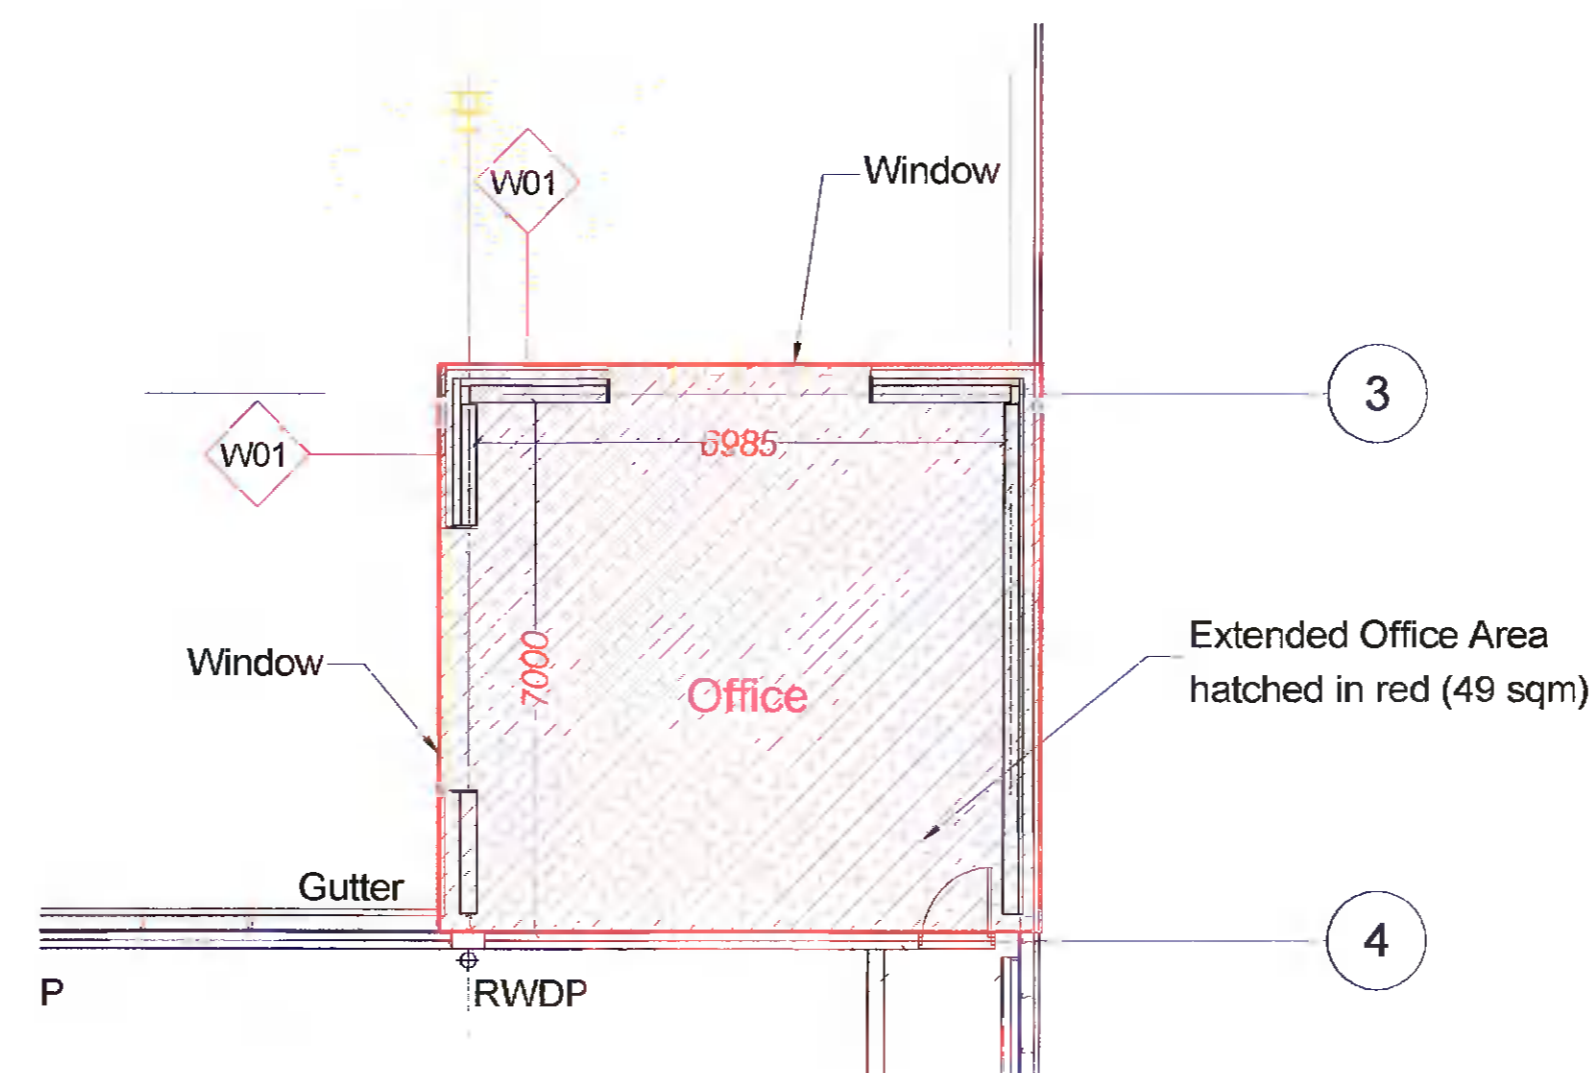

First Floor Plan (Scale 1:100).

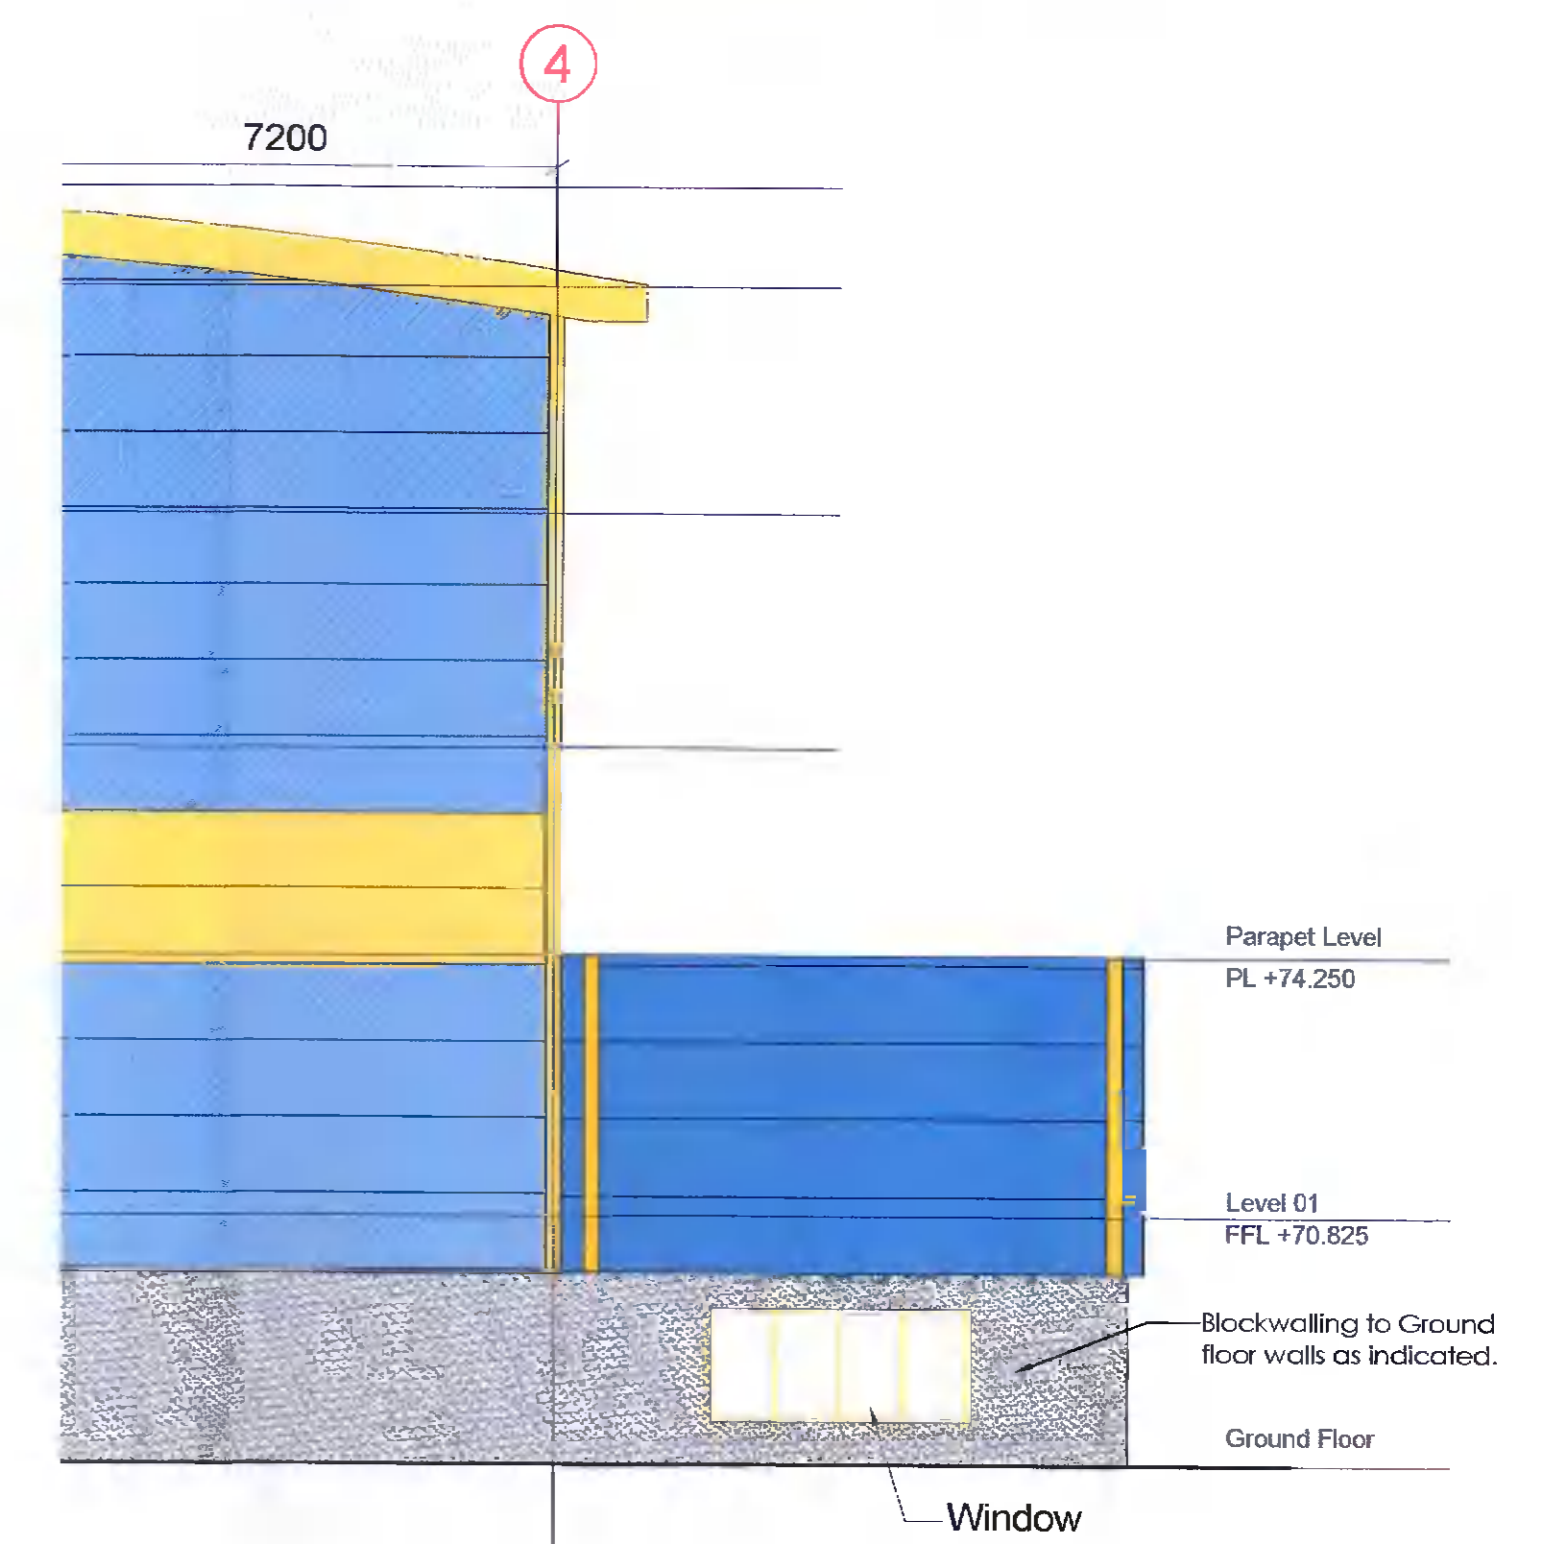

South-East Elevation (Scale 1:100).

PLANNING DRAWINGS ONLY

NOTES:	REV. DATE:	DETAILS:	INITIALS:	REV. DATE:	DETAILS:	INITIALS:	REV. DATE:	DETAILS:	INITIALS:	REV. DATE:	DETAILS:	INITIALS:	NORTH POINT:	KEY PLAN:	PROJECT NO.:	PROJECT DATE:	DATE:
													N		21_31	10-12-2021	10-12-2021
															2131_P-14		
															KS		1:50, 1:75,
															JJ		NTS

J.M. Johnston
 management & design

No. 53, Church Street, Cavan, Co Cavan. Tel: 049-4365462 E-mail: info@jmjconsultants.ie
 Fax: 049-4365467 Web: jmjconsultants.ie

PROJECT: EXTENSION TO SELF STORAGE UNIT AT BALLYMOUNT BUSINESS PARK PROJECT NO.: 21_31 DATE: 10-12-2021
 CLIENT: HSIL PROPERTIES DRAWING NO.: 2131_P-14 REVISION:
 TITLE: OVERLAY DRAWING - FLOOR PLANS & ELEVATIONS DRAWN BY: KS SCALE AT A1: 1:50, 1:75,
 ISSUE TYPE: PLANNING APPLICATION STAGE - FURTHER INFORMATION. CHECKED BY: JJ SCALE AT A3: NTS