




EXISTING ROOF LAYOUT
SCALE 1:100

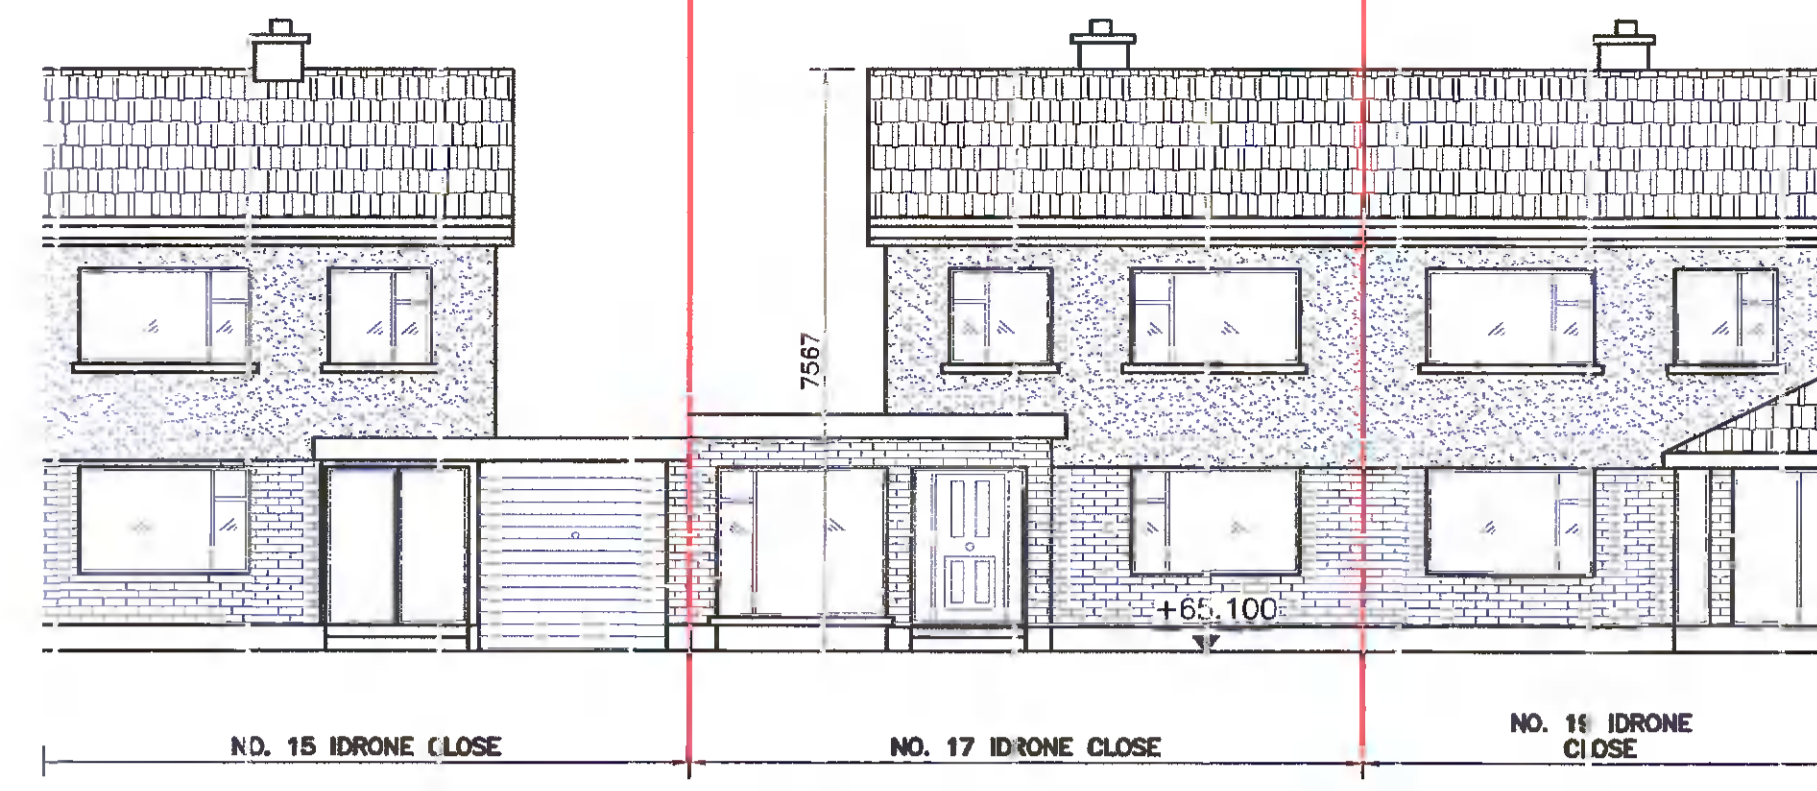


EXISTING FRONT ELEVATION
SCALE 1:100

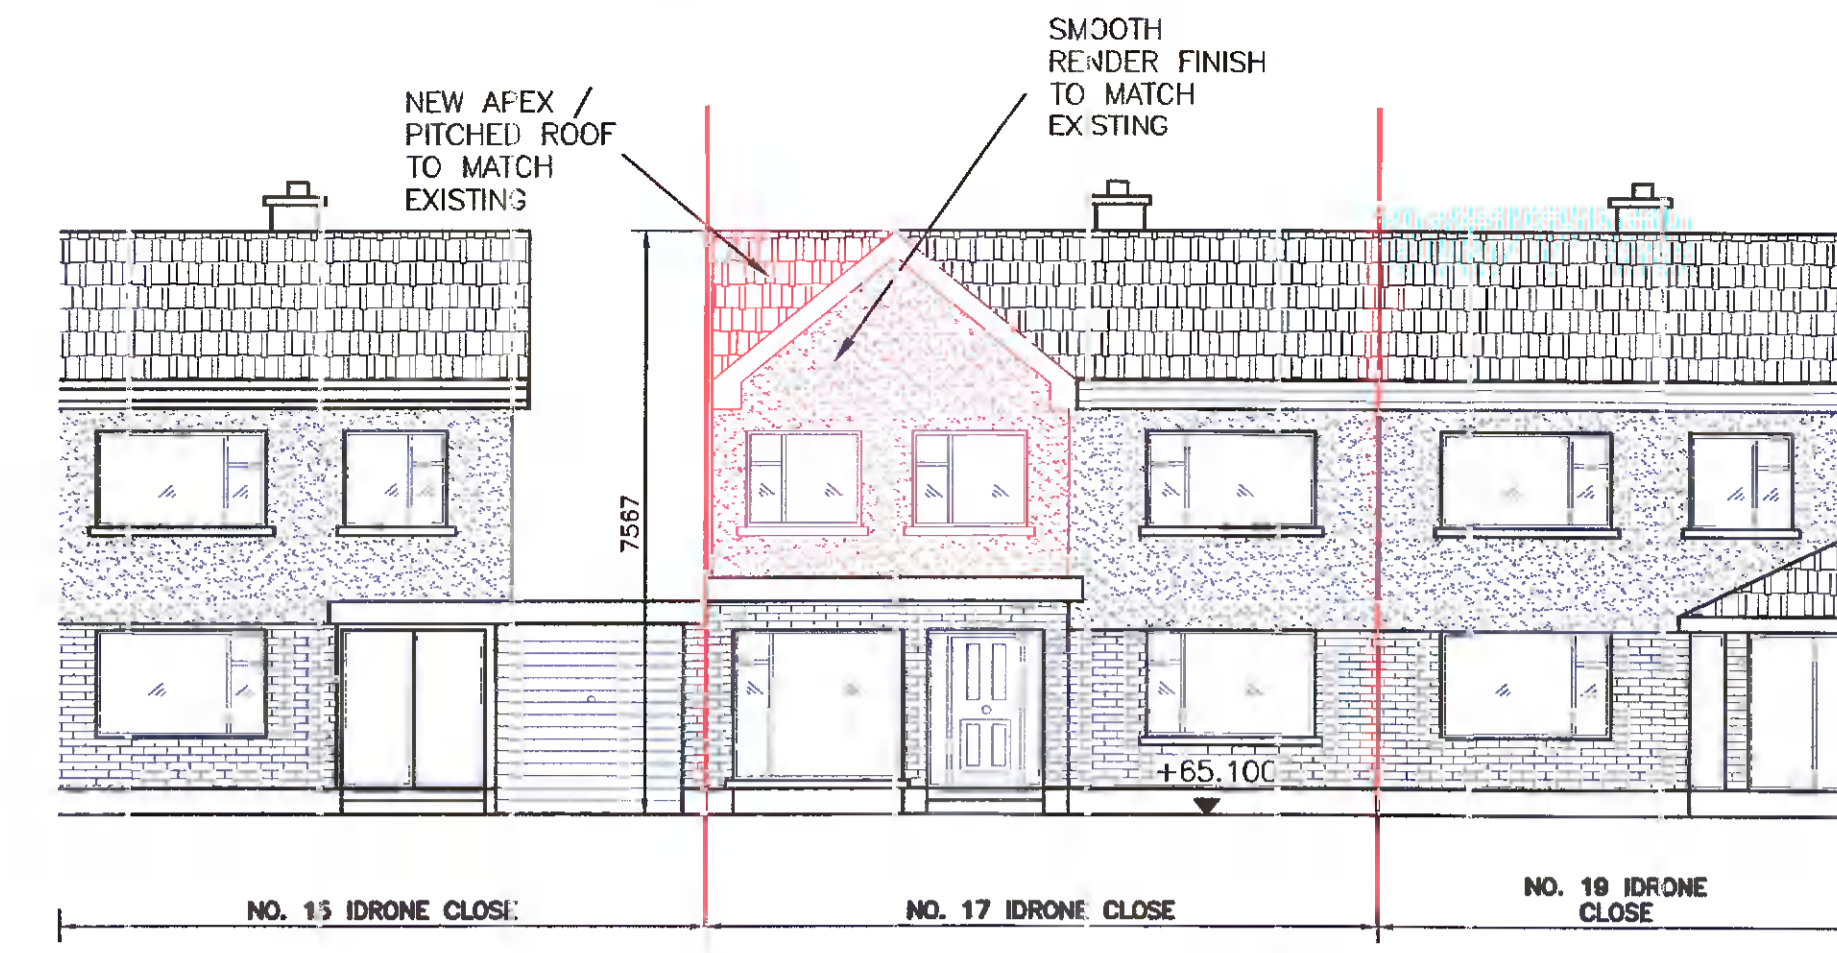


PROPOSED FRONT ELEVATION
SCALE 1:100

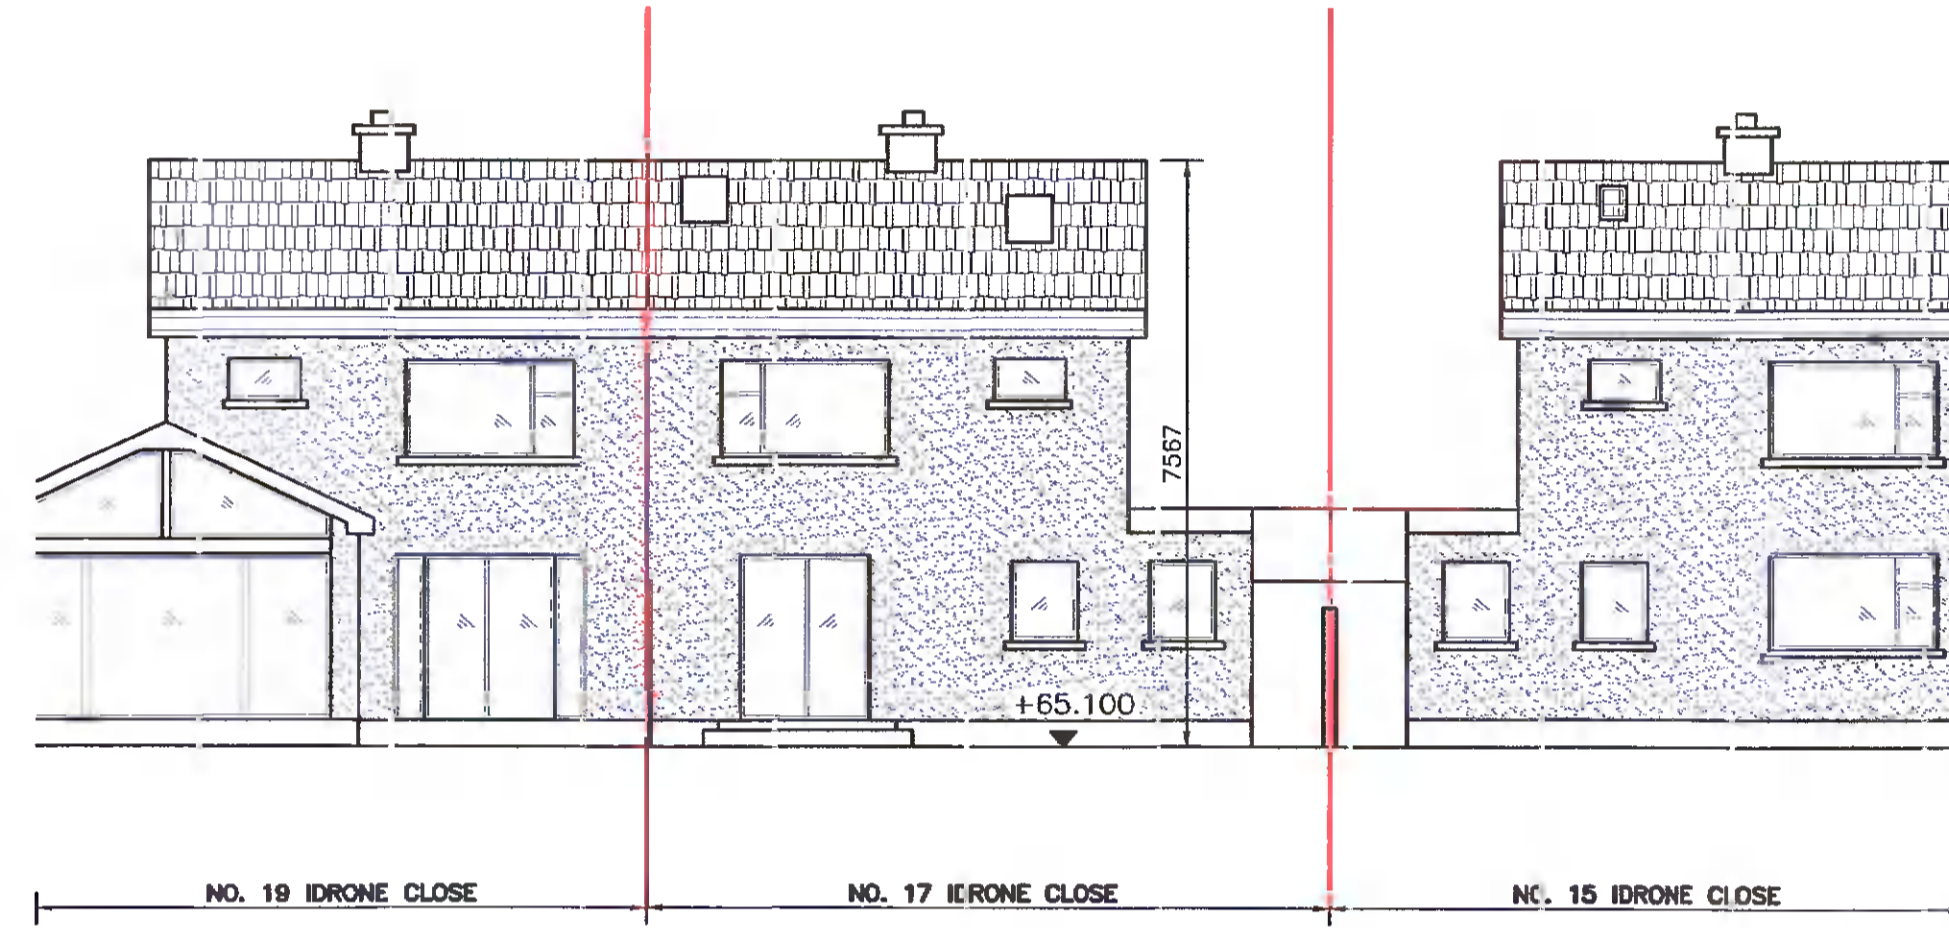


EXISTING REAR ELEVATION
SCALE 1:100

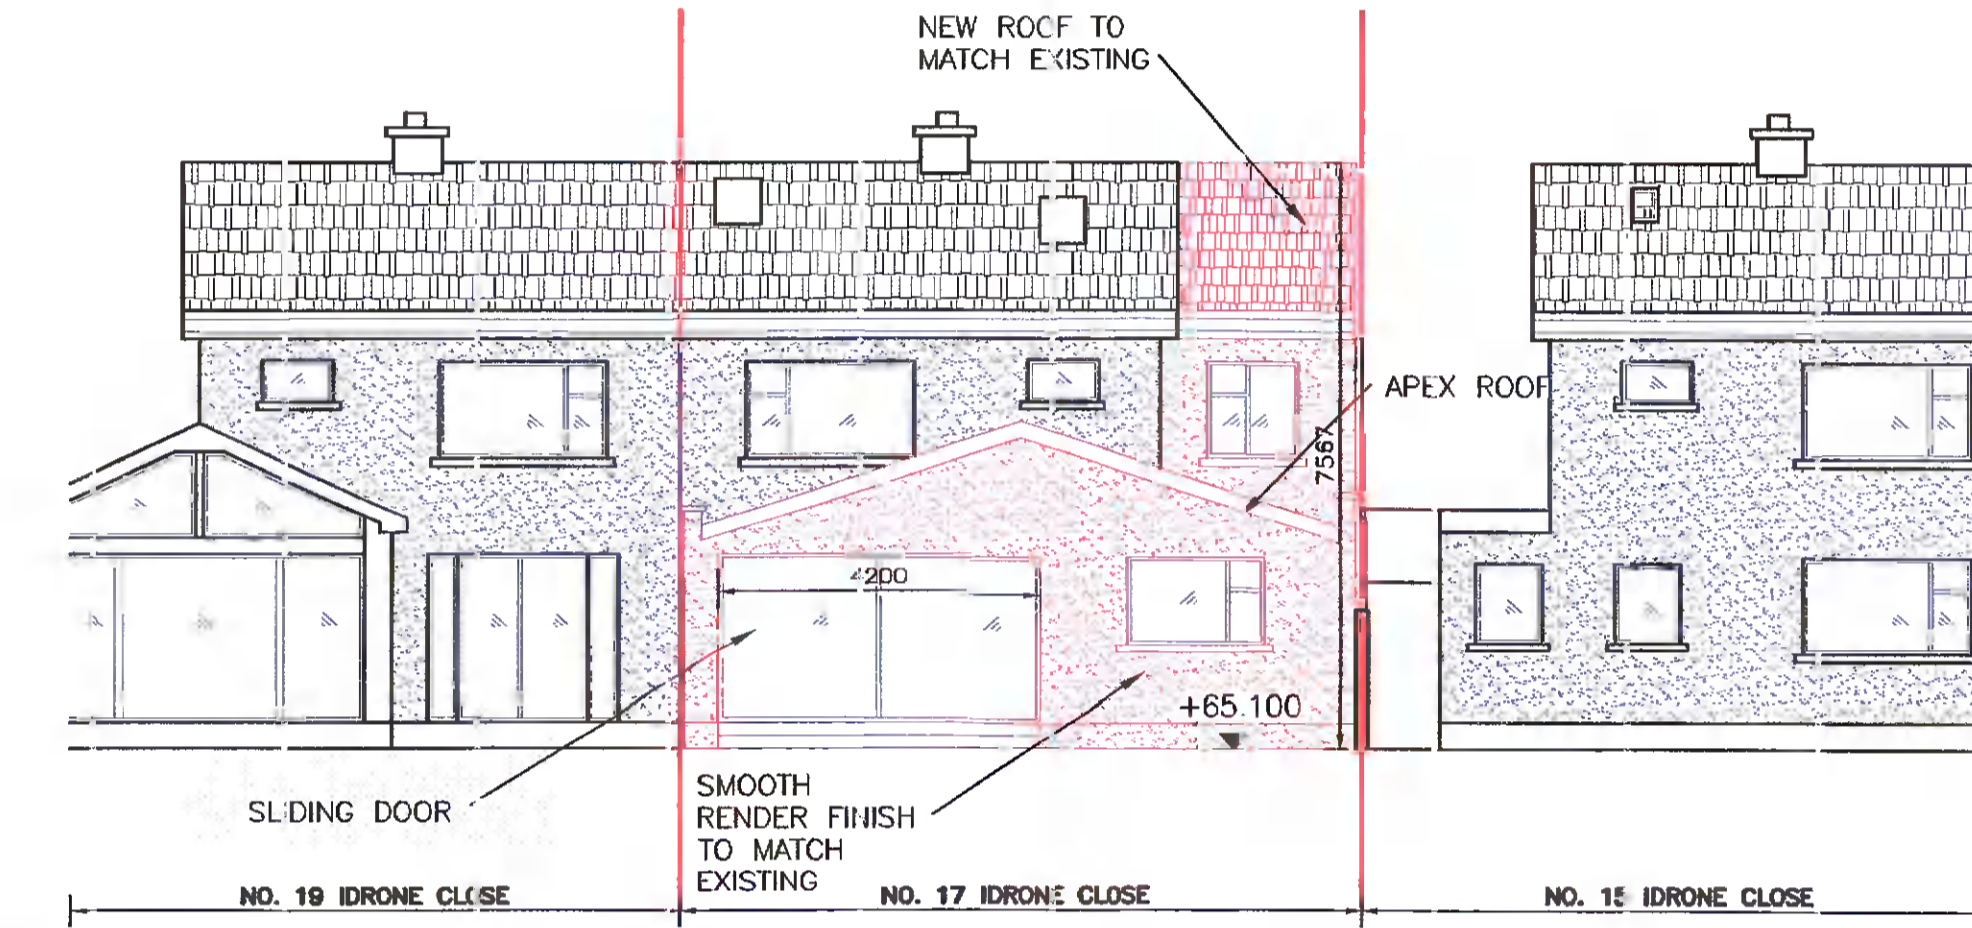


PROPOSED REAR ELEVATION
SCALE 1:100

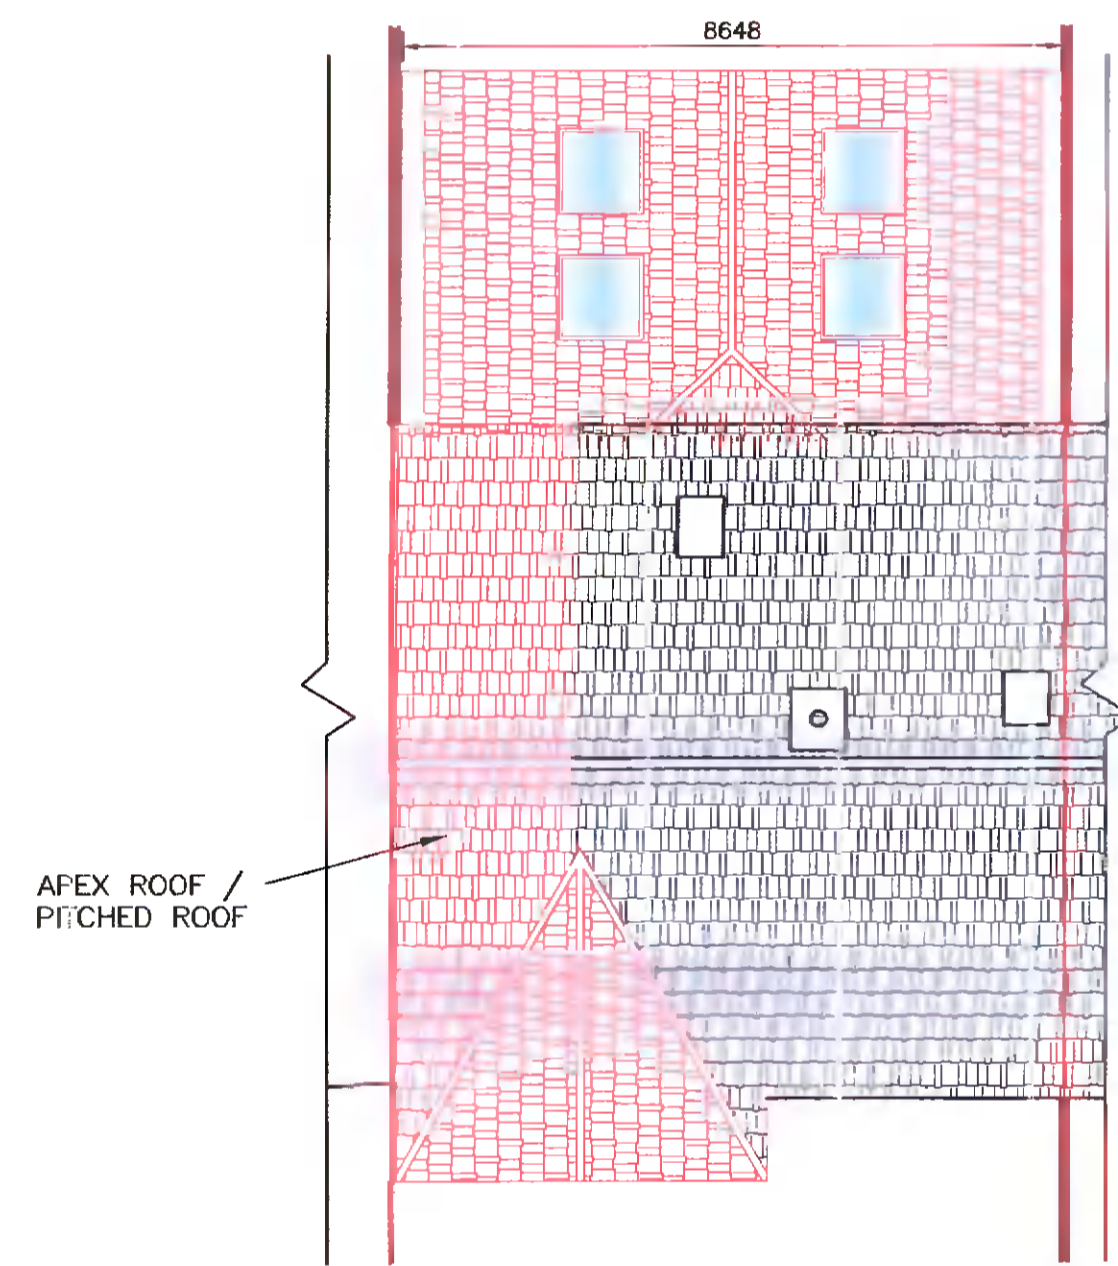


PROPOSED ROOF LAYOUT
SCALE 1:100

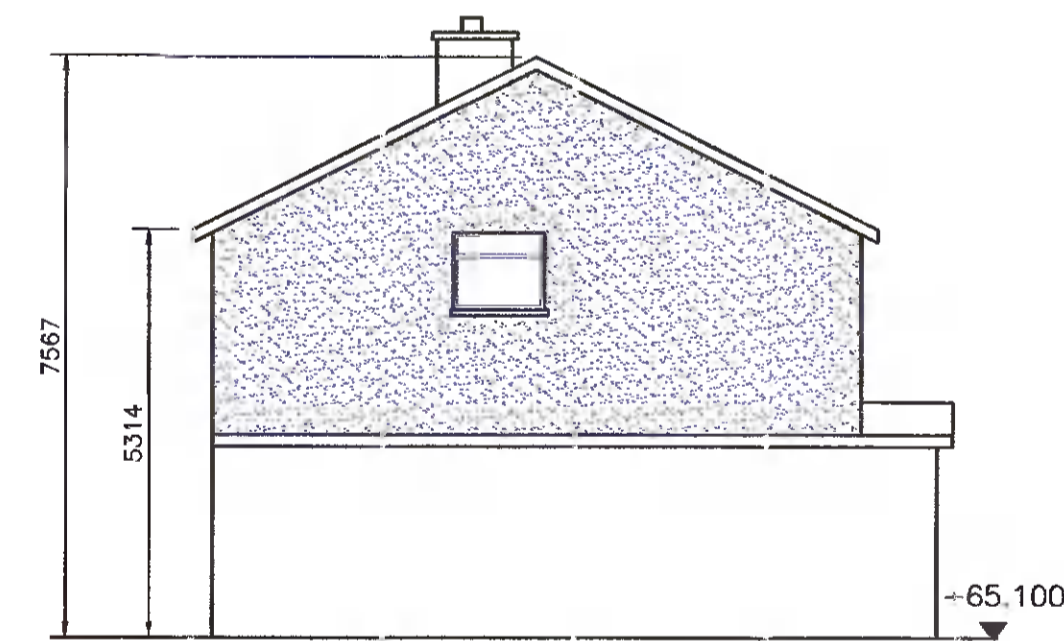


EXISTING SIDE ELEVATION
SCALE 1:100

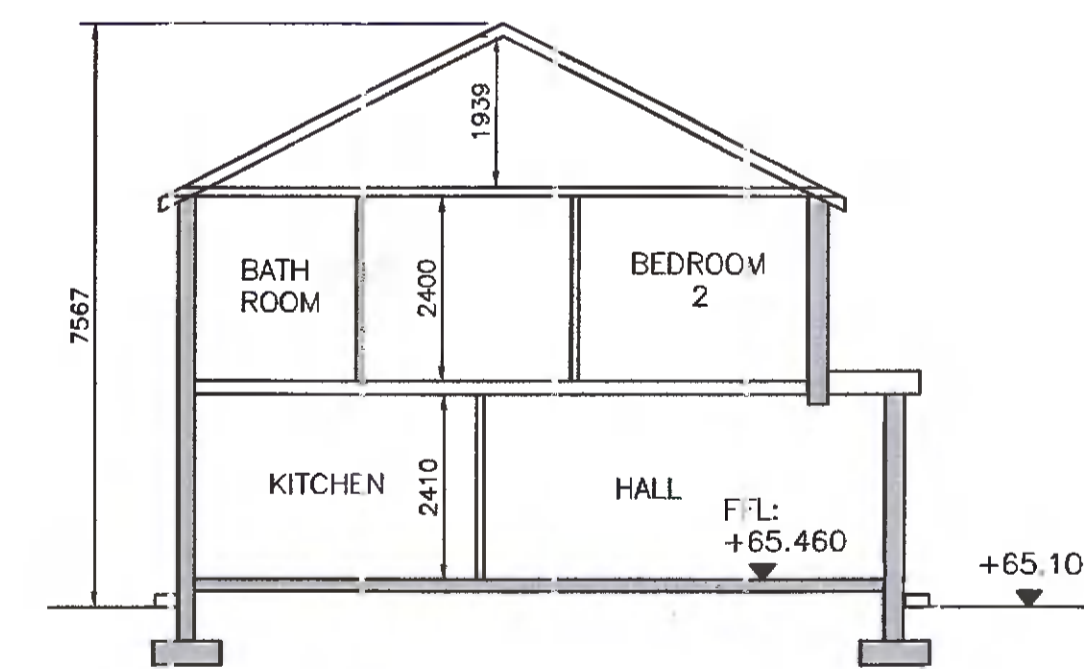

EXISTING CROSS SECTION
SCALE 1:100

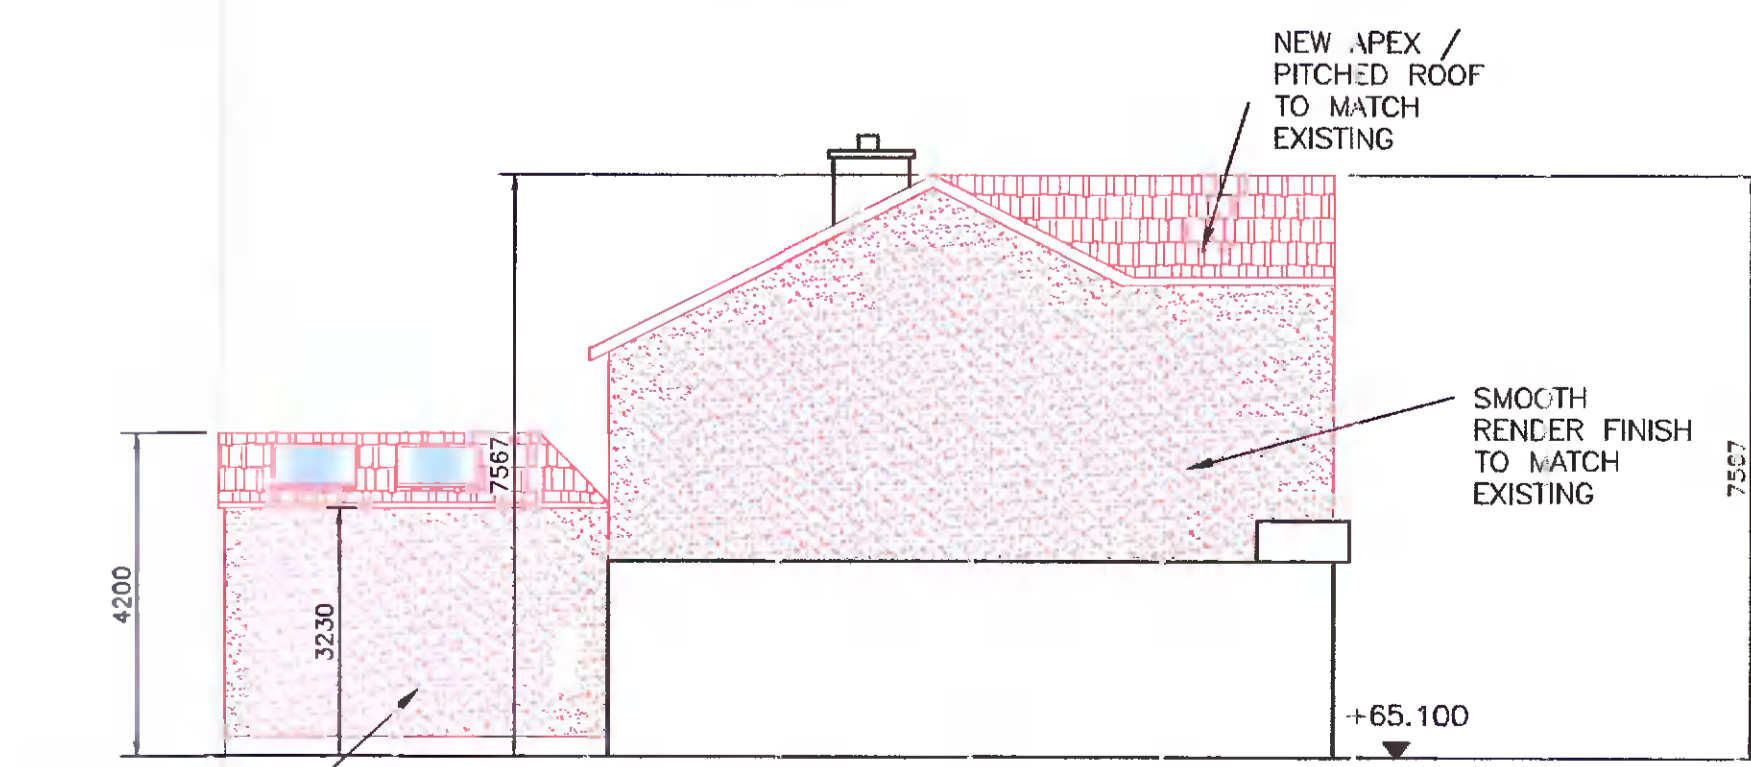

PROPOSED SIDE ELEVATION
SCALE 1:100

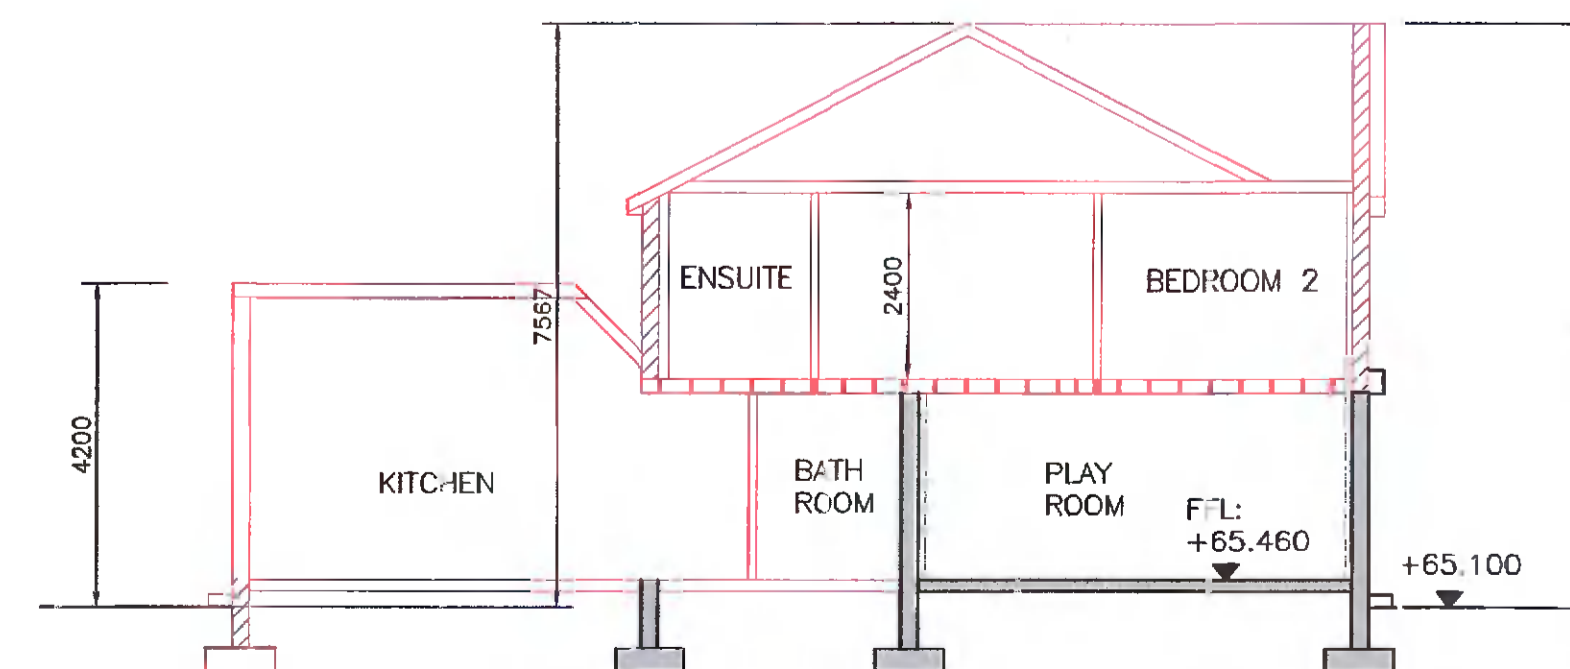

PROPOSED CROSS SECTION
SCALE 1:100

— SITE BOUNDARY

NOTES: - ALL NEW / PROPOSED WORKS ARE SHOWN IN RED

PL0	06/12/21	ISSUED FOR PLANNING
REV.	DATE	DESCRIPTION

CLIENT:
BARRY REYNOLDS



PROJECT:
WORKS AT 17 IDRONE
CLOSE, KNOCKLYON,
DUBLIN 16

26A MAYWOOD LAWN
RAHENY
DUBLIN 5
tel +353 87 901 73 25
email: ross.somers@gmail.com

DRAWING TITLE:
EXISTING & PROPOSED
LAYOUTS & ELEVATIONS

SCALE: 1:100 @ A1	DWG STATUS: PLANNING
DATE: SEPTEMBER 2021	DRAWN BY: RS
© DRAWING NUMBER: 21-194-0(2)	REVISION: P3