




EXISTING - GROUND FLOOR PLAN - 1:200

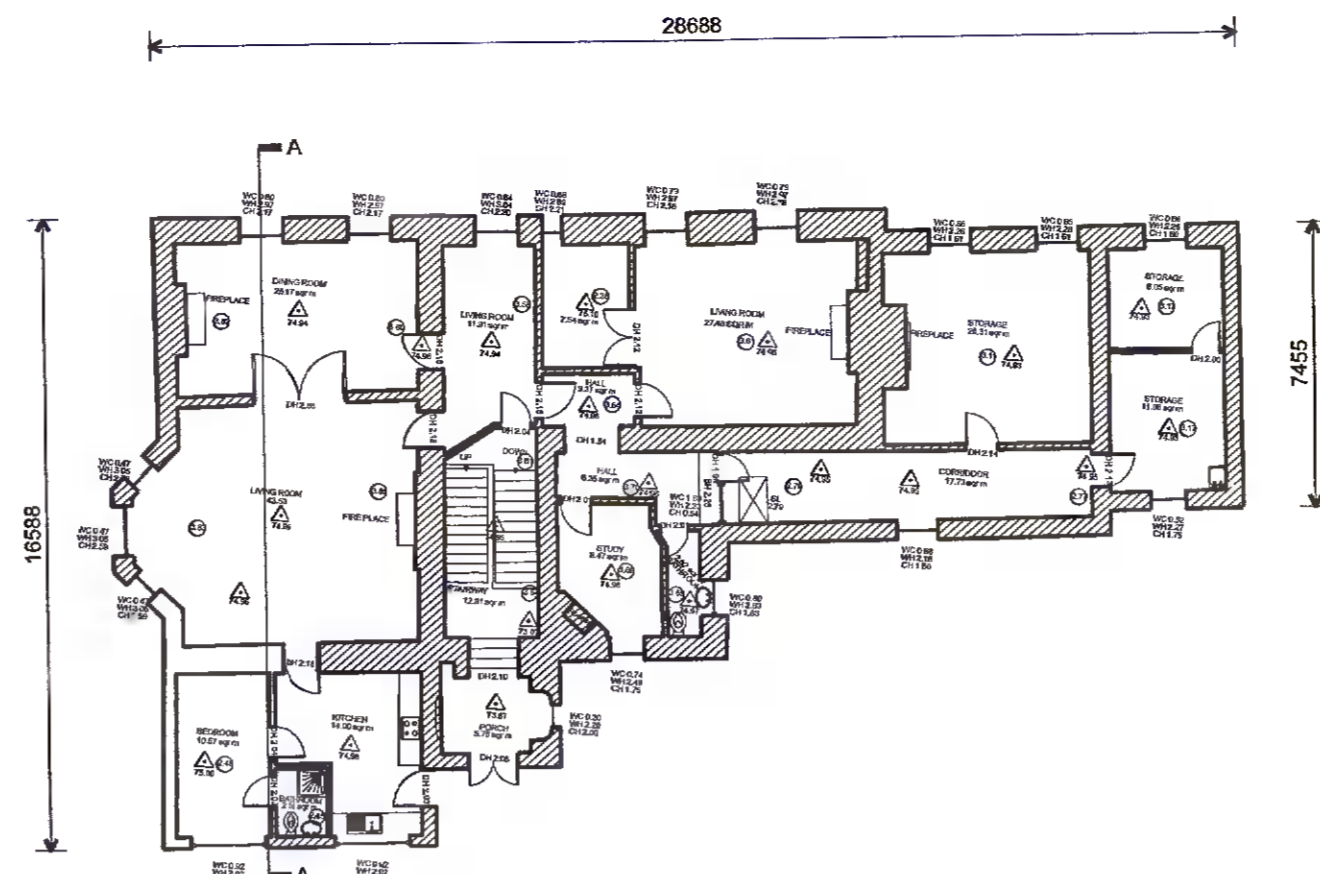

EXISTING - FIRST FLOOR PLAN - 1:200

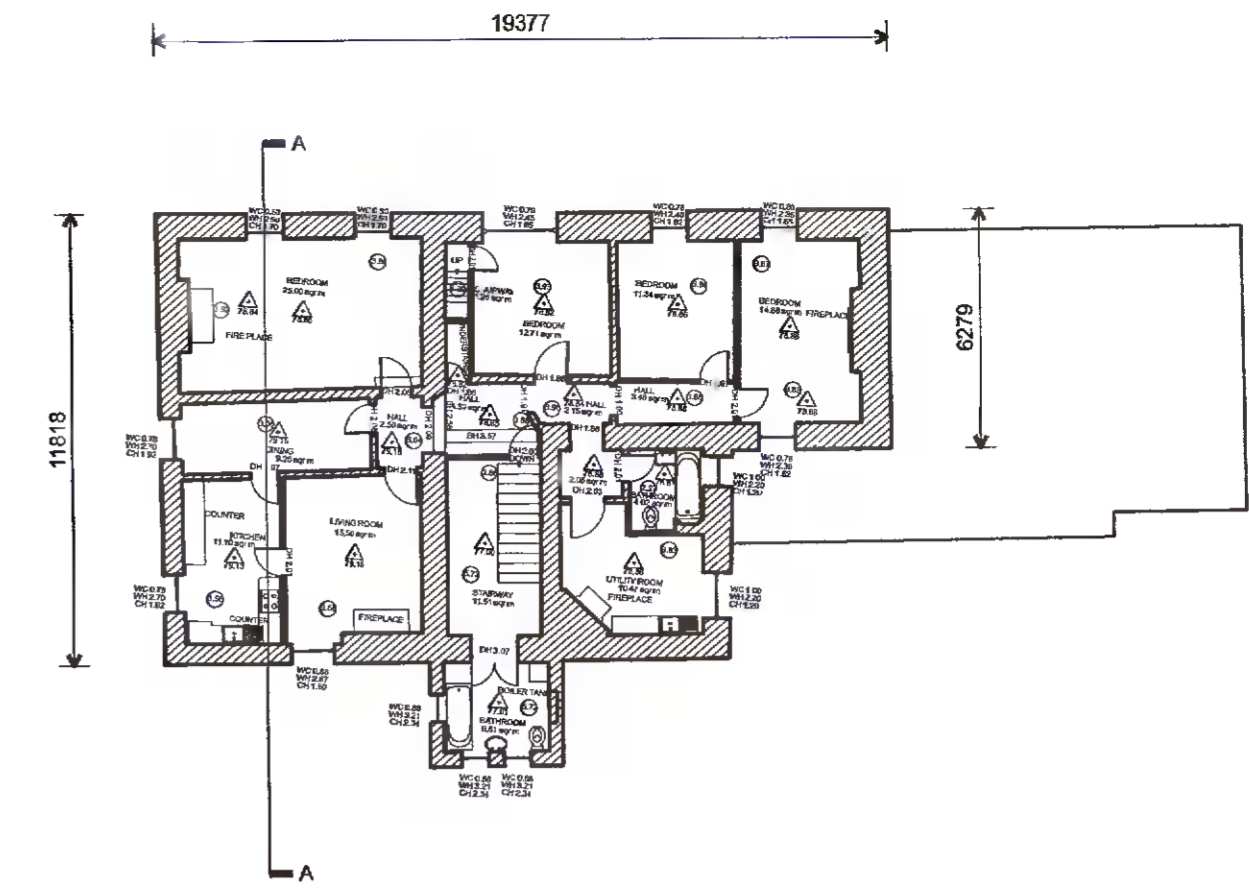


EXISTING - SECOND FLOOR PLAN - 1:200

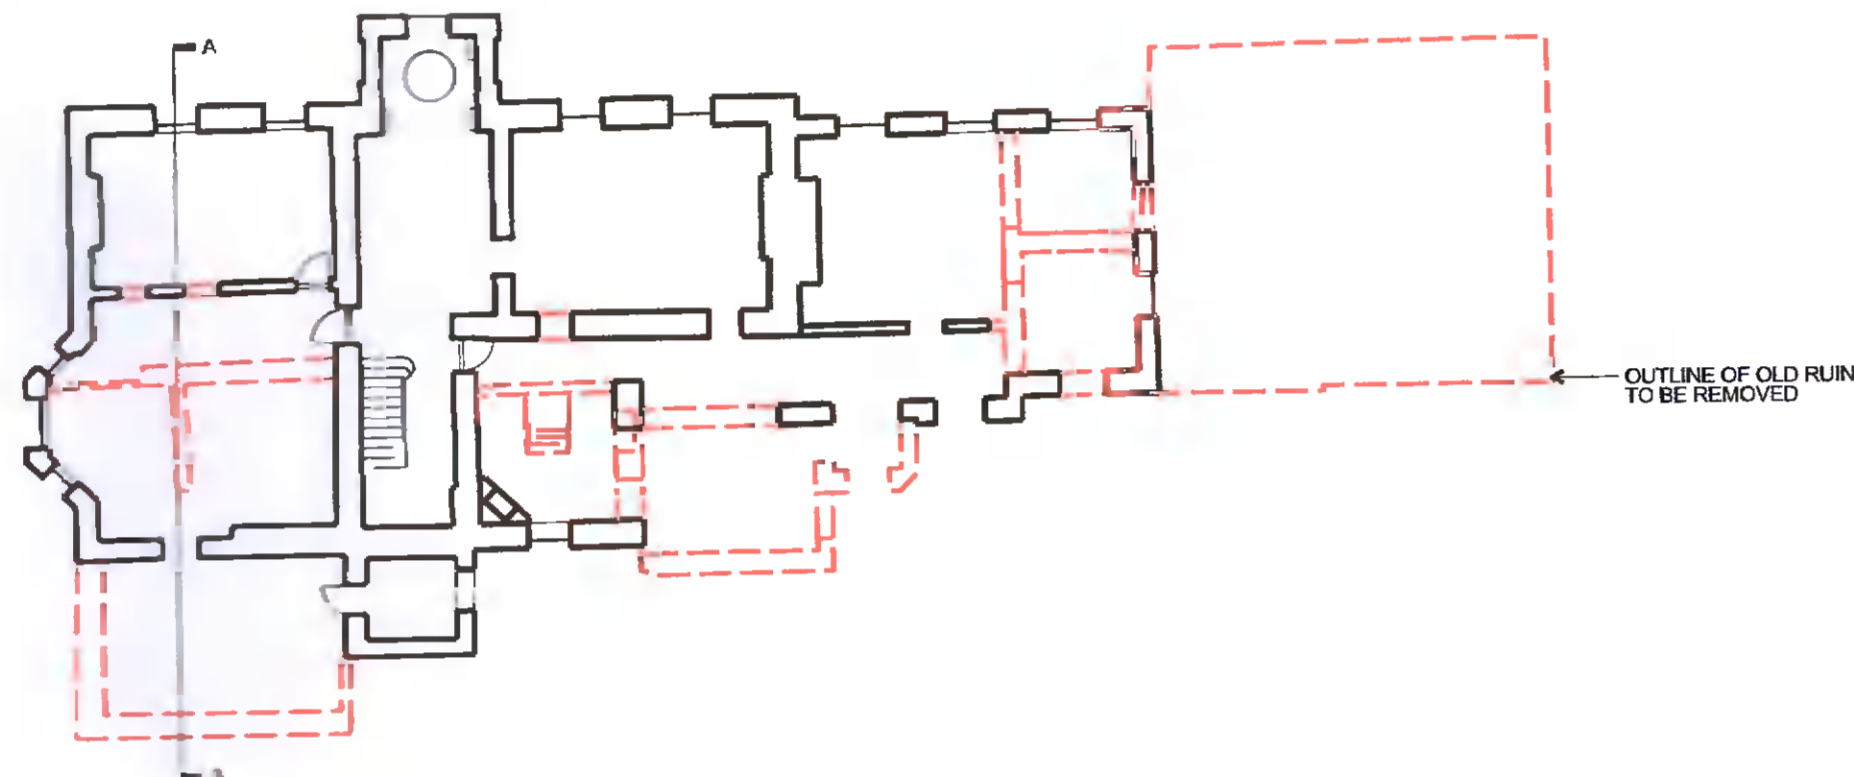


EXISTING - GROUND FLOOR PLAN - 1:200


NOTE - DOTTED RED LINE INDICATES ELEMENTS PROPOSED FOR REMOVAL OR AMENDMENT

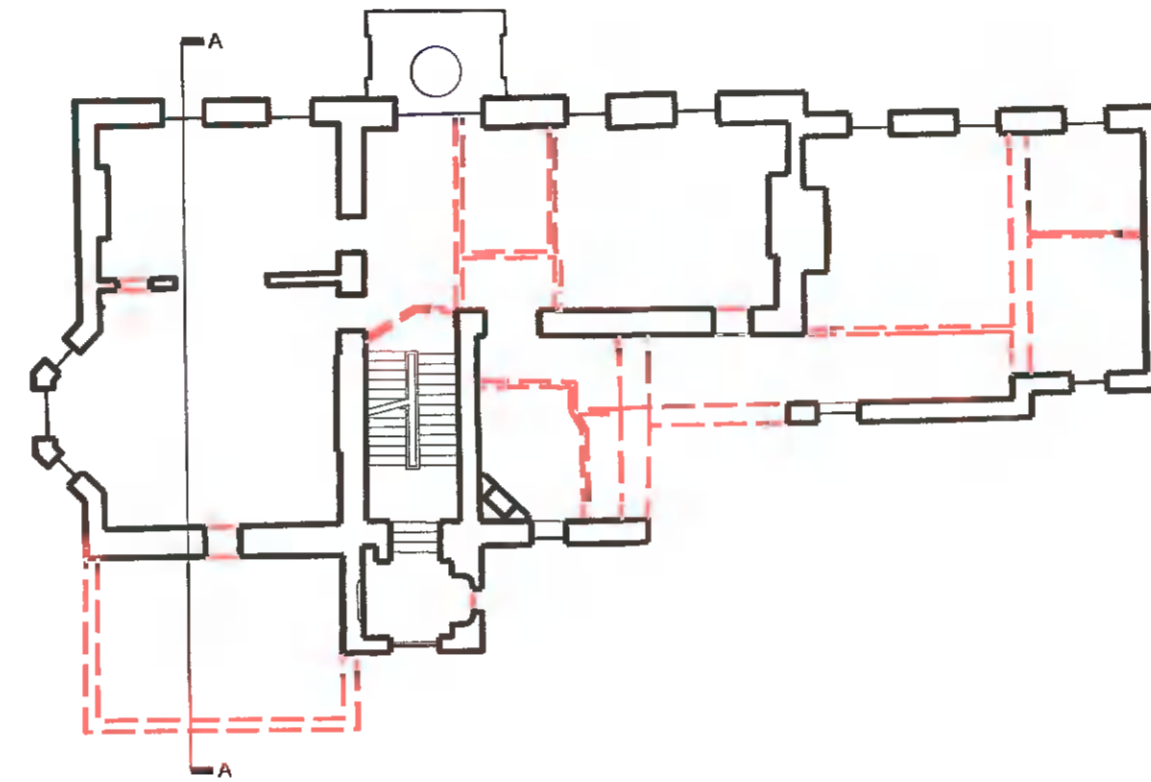


EXISTING - FIRST FLOOR PLAN - 1:200

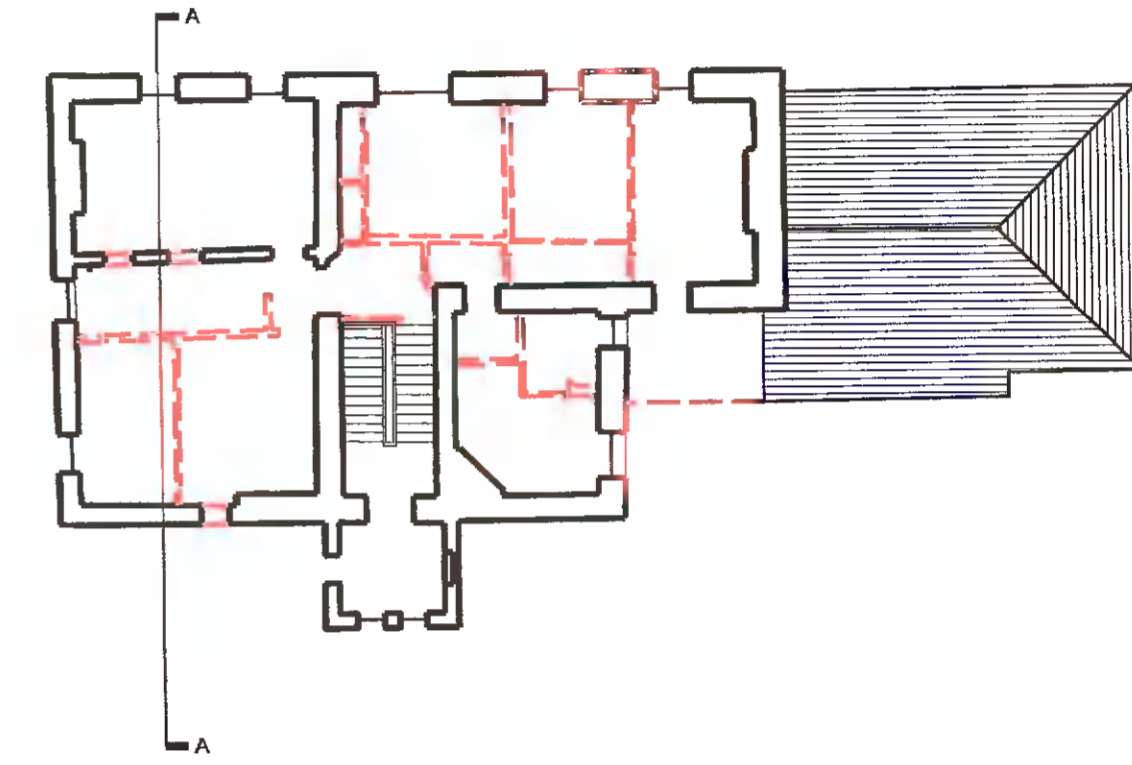


EXISTING - SECOND FLOOR PLAN - 1:200

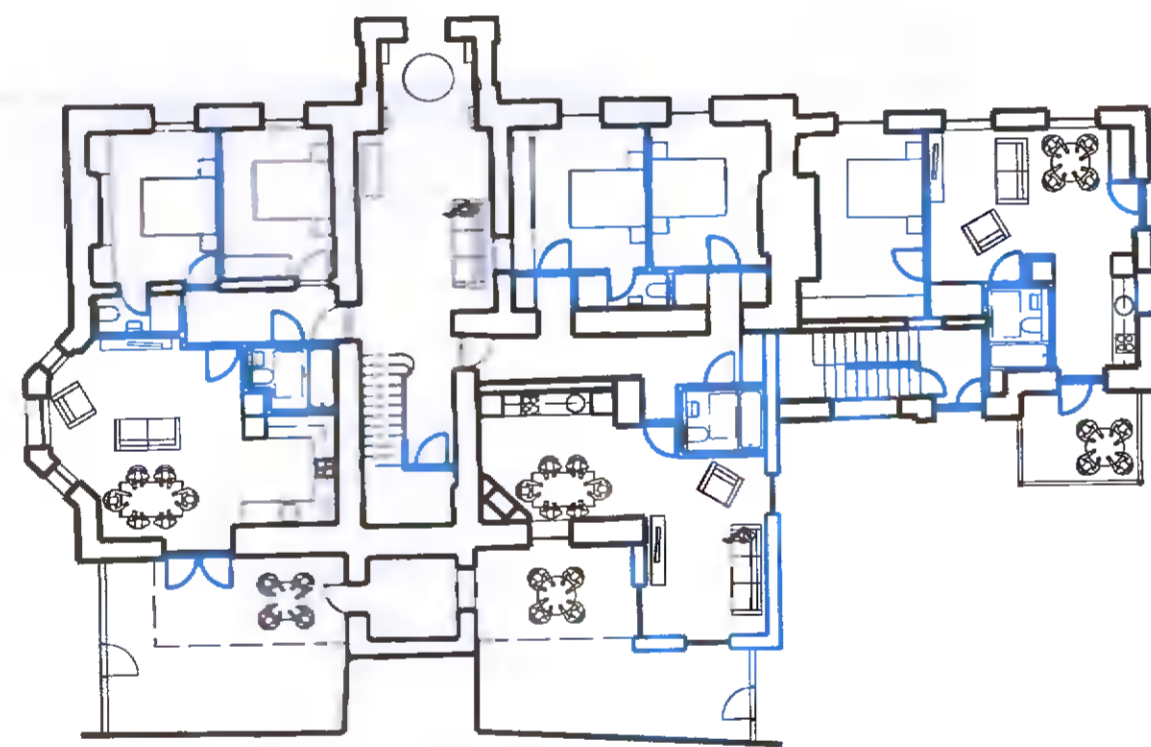


APPLICATION - GROUND FLOOR PLAN - 1:200

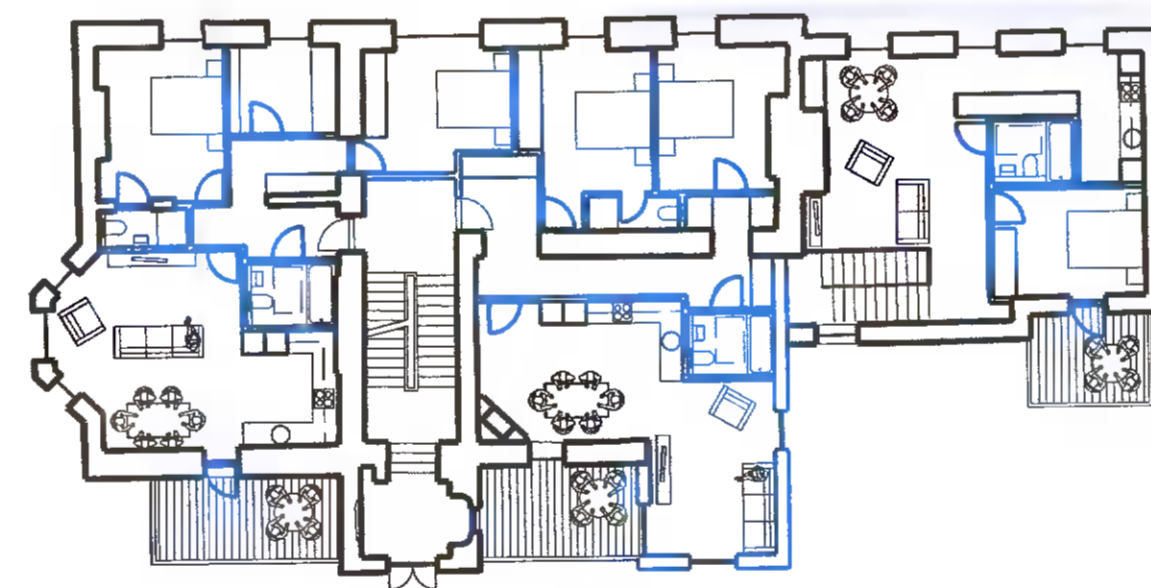

APPLICATION - FIRST FLOOR PLAN - 1:200

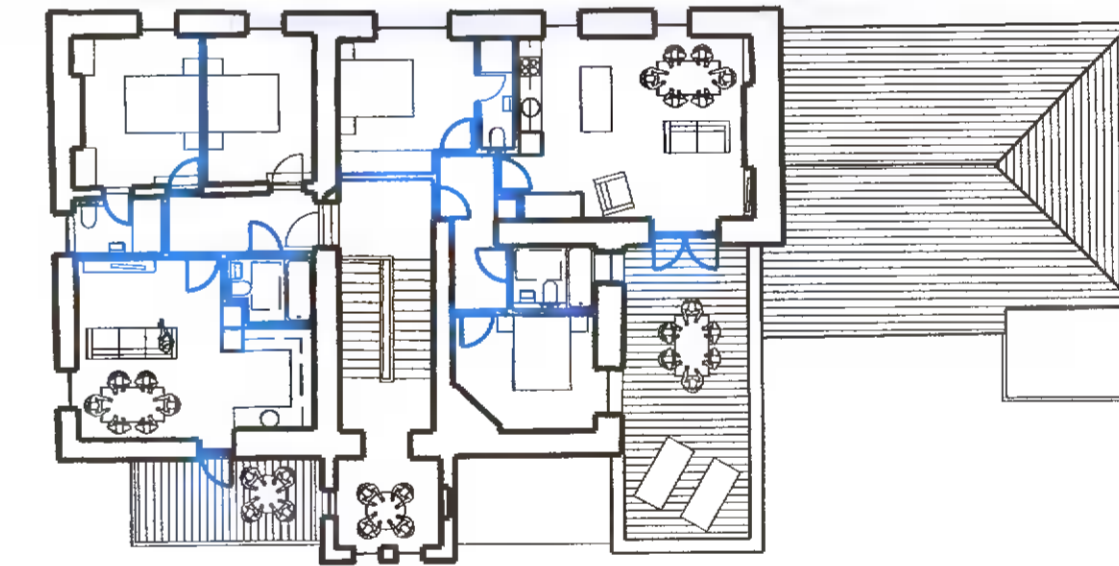


APPLICATION - SECOND FLOOR PLAN - 1:200

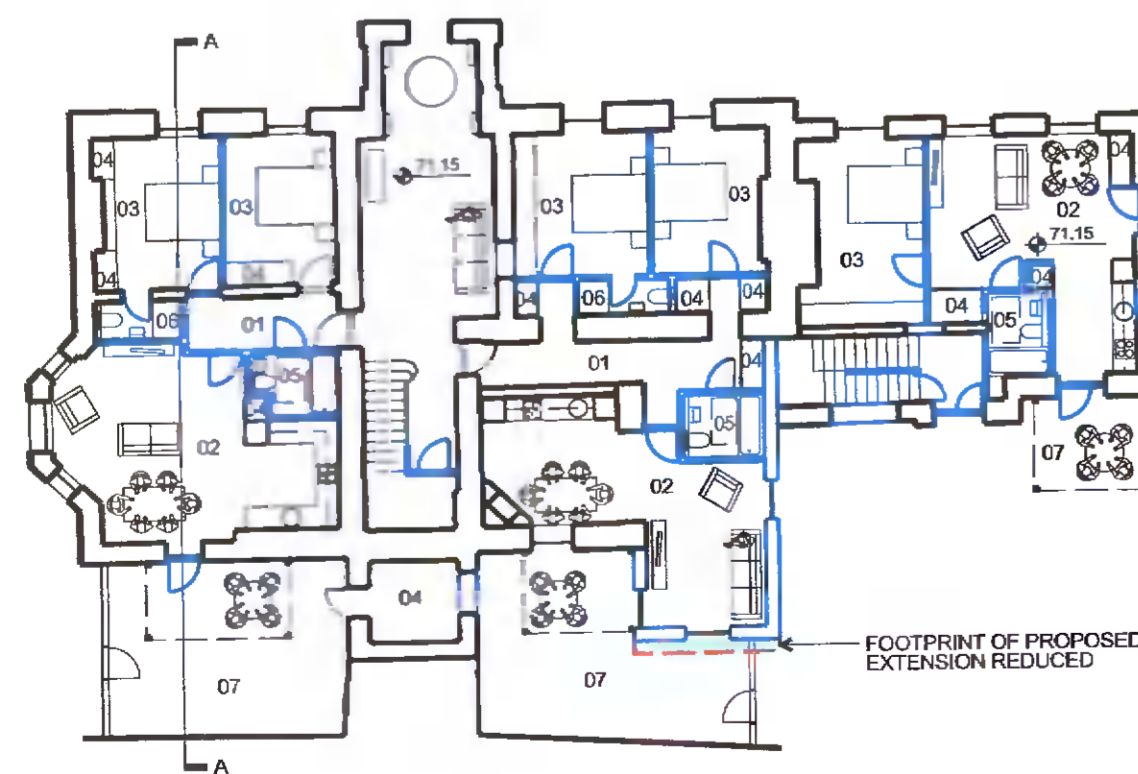


ADDITIONAL INFORMATION - GROUND FLOOR PLAN - 1:200


NOTE - BLUE LINE/HATCHING INDICATES NEW BUILD INTERVENTIONS

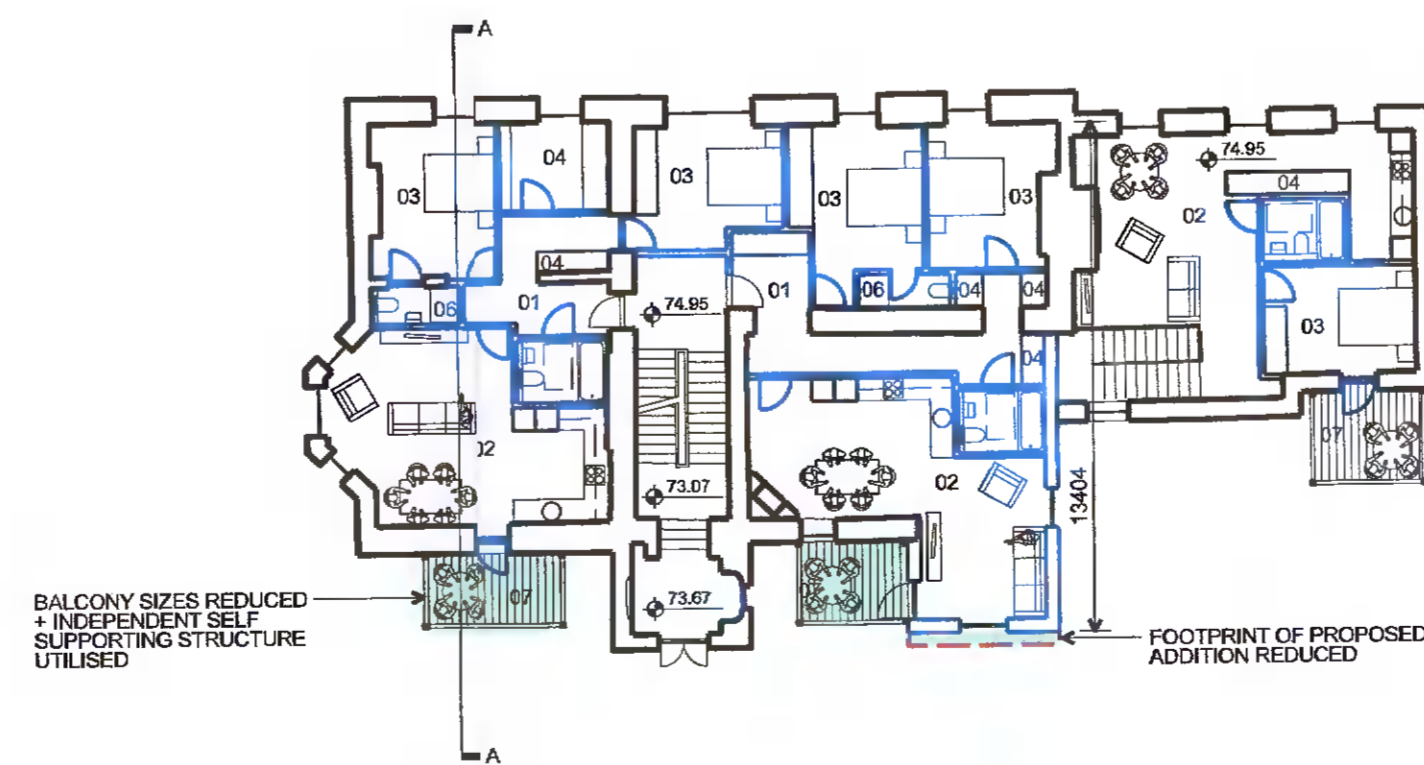

ADDITIONAL INFORMATION - FIRST FLOOR PLAN - 1:200

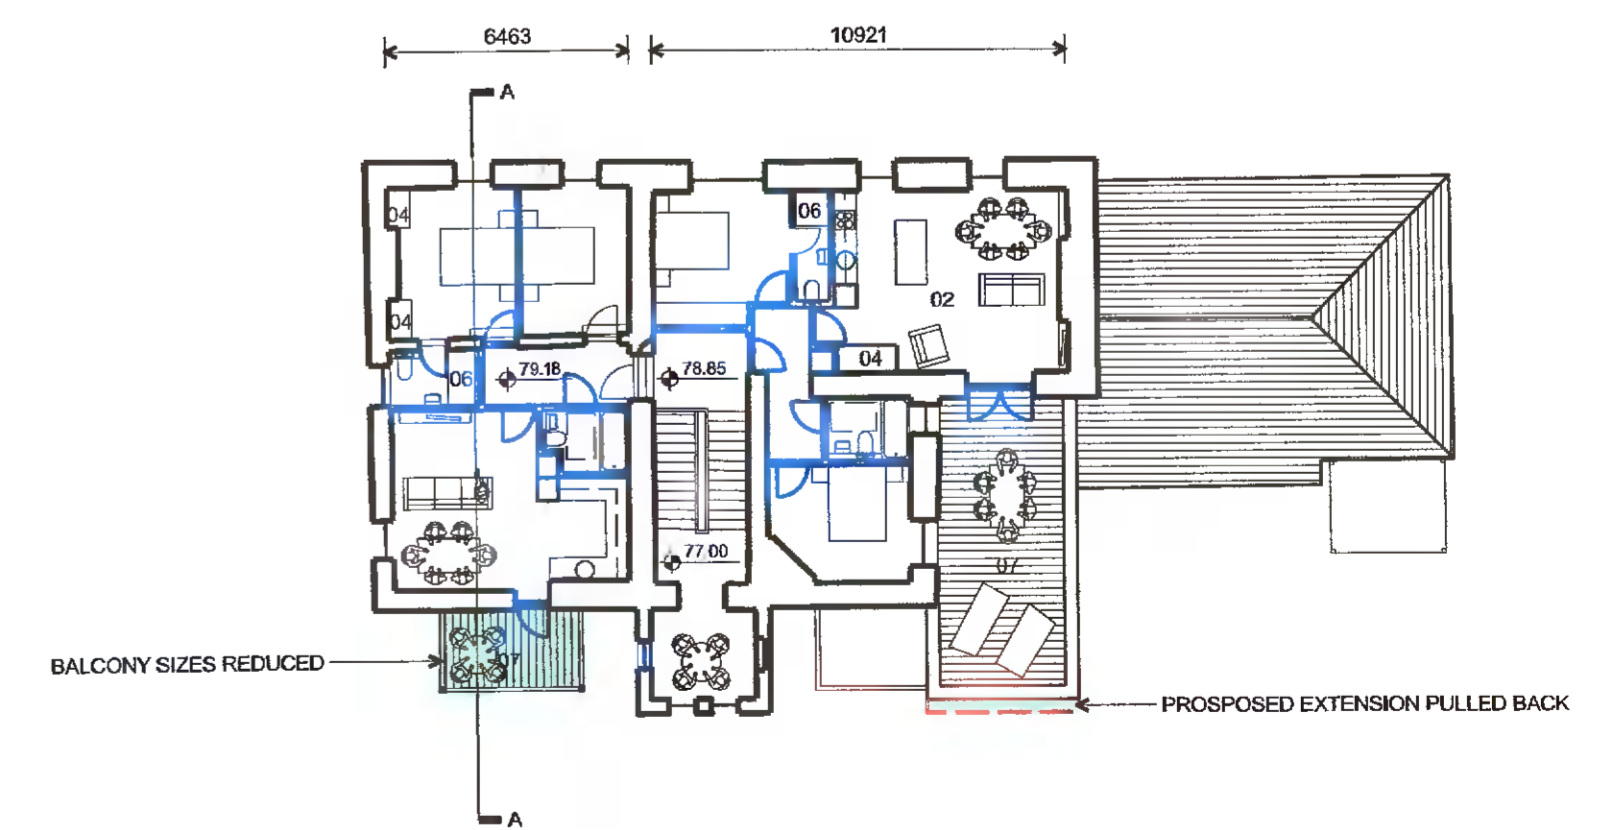

ADDITIONAL INFORMATION - SECOND FLOOR PLAN - 1:200

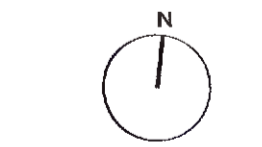

- LEGEND
- 01 HALL
 - 02 KITCHEN DINING LIVING
 - 03 BEDROOM
 - 04 STORE
 - 05 BATHROOM
 - 06 ENSUITE
 - 07 YARD/TERRACE/BALCONY

BLUE LINE/HATCHING INDICATES NEW BUILD INTERVENTIONS
COLOURED AREAS HIGHLIGHT PROPOSED CHANGES

ISSUE	DATE	FOR
01	09.06.20	COMMENT
02	19.06.21	VALUATION REVIEW
03	22.06.21	REVIEW
04	23.06.21	APPLICATION
05	18.12.21	RFI - INTERIM SUBMISSION

REVISIONS
01
01
TRUE NORTH	SCALE
	1:200 @ A1
	1:400 @ A3
GRAPHIC SCALE	
0	40
	100

DRAWING	
BALLYROAN HOUSE -	
FLOOR PLANS	
DRAWING NUMBER	ISSUE
B01	05