


Adjoining property No 9

Boundary line

Boundary line

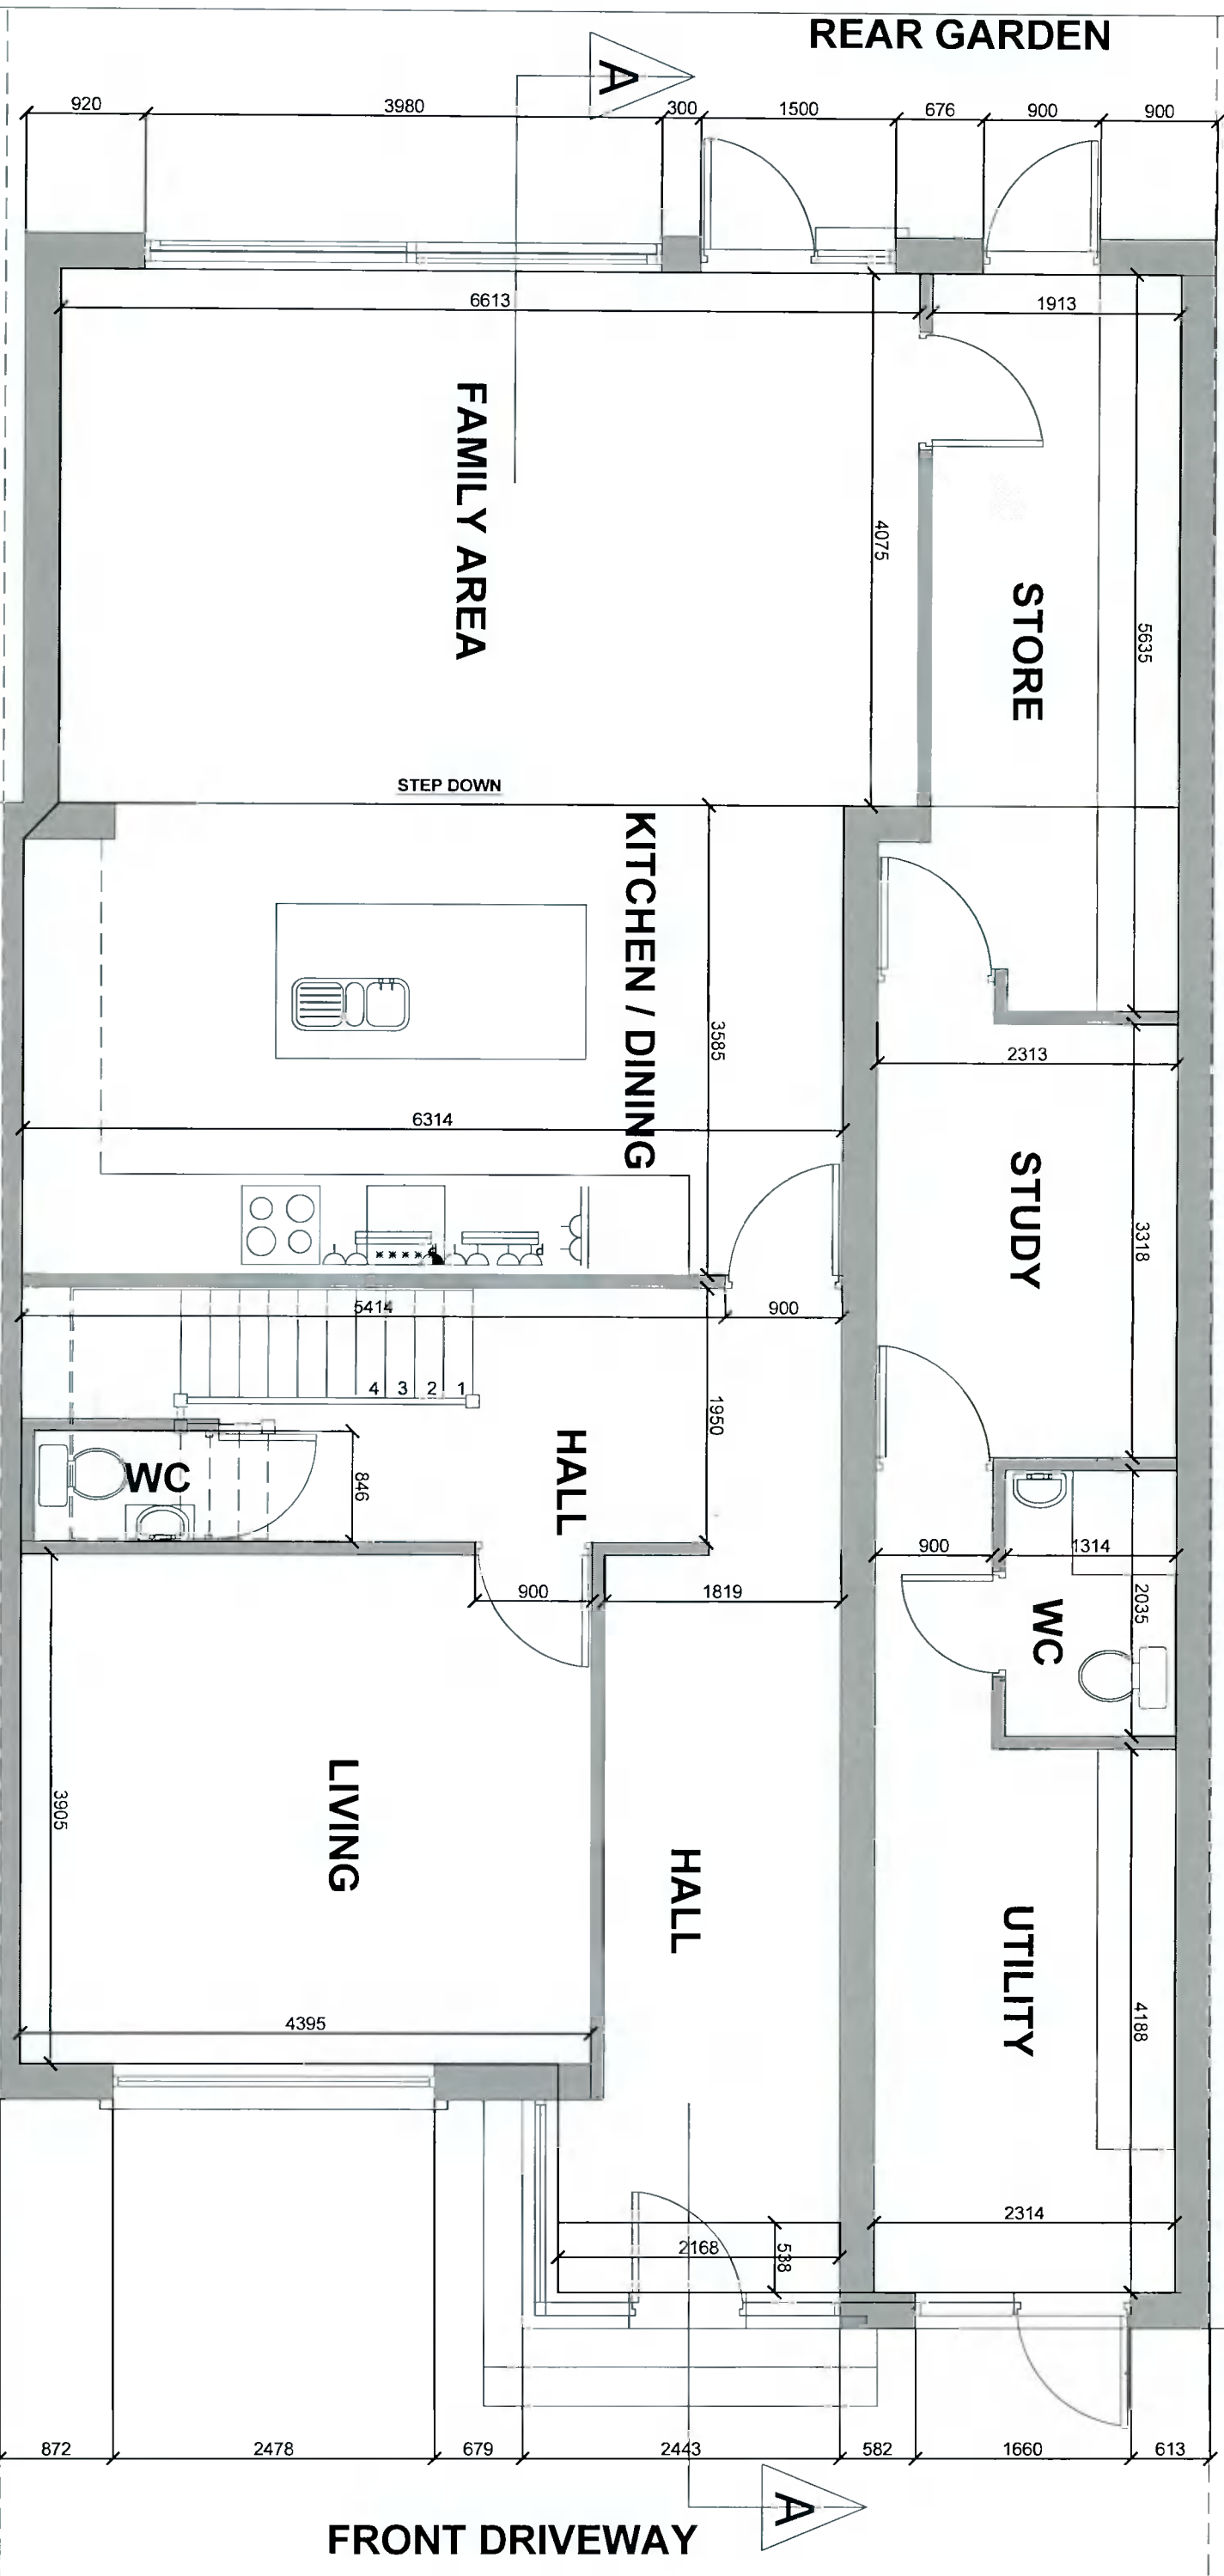


Boundary line

Adjoining property No 5

Boundary line

EXISTING GROUND FLOOR PLAN

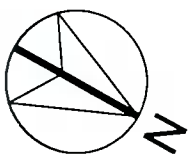

DESMOND J. HALPIN & ASSOCIATES
 Planning & Building Design Consultants
 15 Claugher Drive, Fintona, Dublin 24 Phone: 01 4523710 Email: dhalpin@desjha.com

Project: RETENTION OF AS BUILT DOMESTIC EXTENSION
 7 MOUNTDOWN PARK, DUBLIN 12 D12HX86

Drawing Title	Scale	Drawn
AS BUILT GROUND FLOOR PLAN.	1:50 @ A3.	DJH
	Drawing No	Rev
	03 10 22	
Applicant:	Date	Chk
MR. BILLY SHEEHAN.	APRIL 2022	JK