


Adjoining property No 9

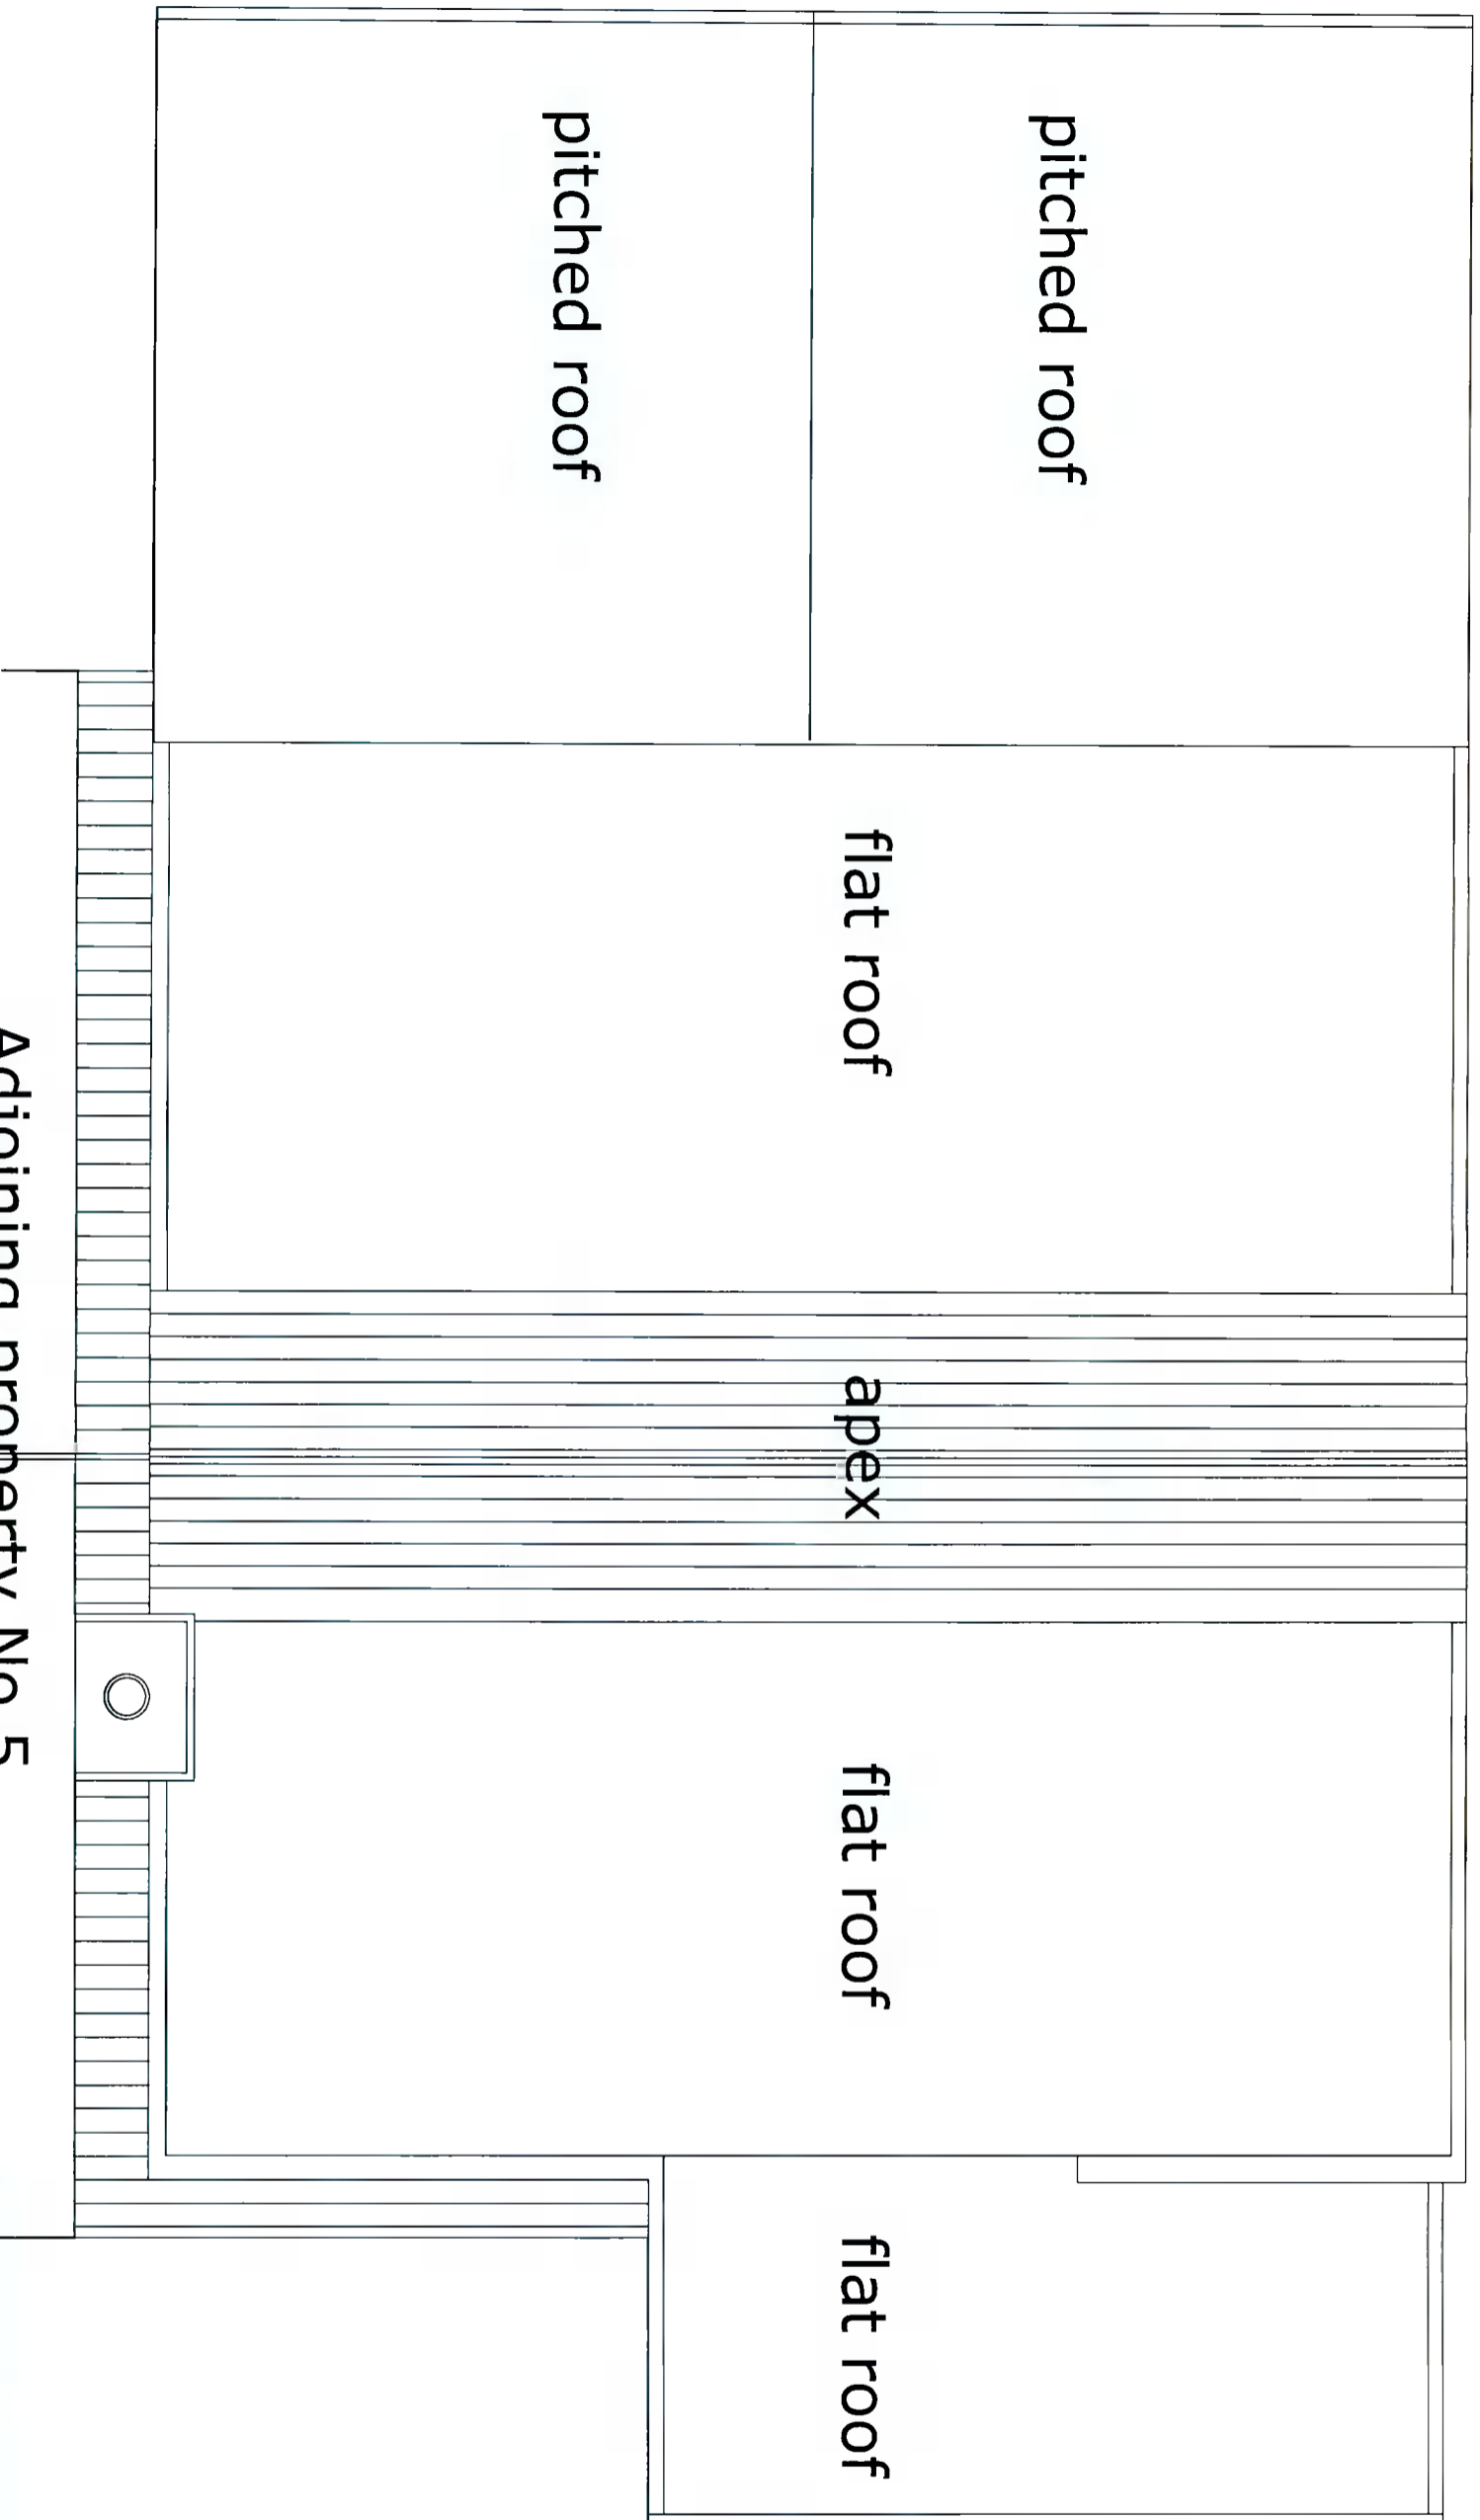

Adjoining property No 5

DESMOND J. HALPIN & ASSOCIATES
Planning & Building Design Consultants
 15 Carriglea Drive, Fingrave, Dublin 24 Phone: 01-4523710 Email: deshalpin15@gmail.com

Project:
 RETENTION OF AS BUILT DOMESTIC EXTENSION
 7 MOUNT DOWN PARK, MANOR ESTATE.

Drawing Title	Scale	Drawn
AS BUILT ROOF PLAN.	1:50 @ A3.	DJH
	Drawing No	Rev
	08 10 22	
Applicant:	Date	Chk
M. BILLY SHEEHAN	APRIL 2022	JK

