


EXISTING REAR ELEVATION

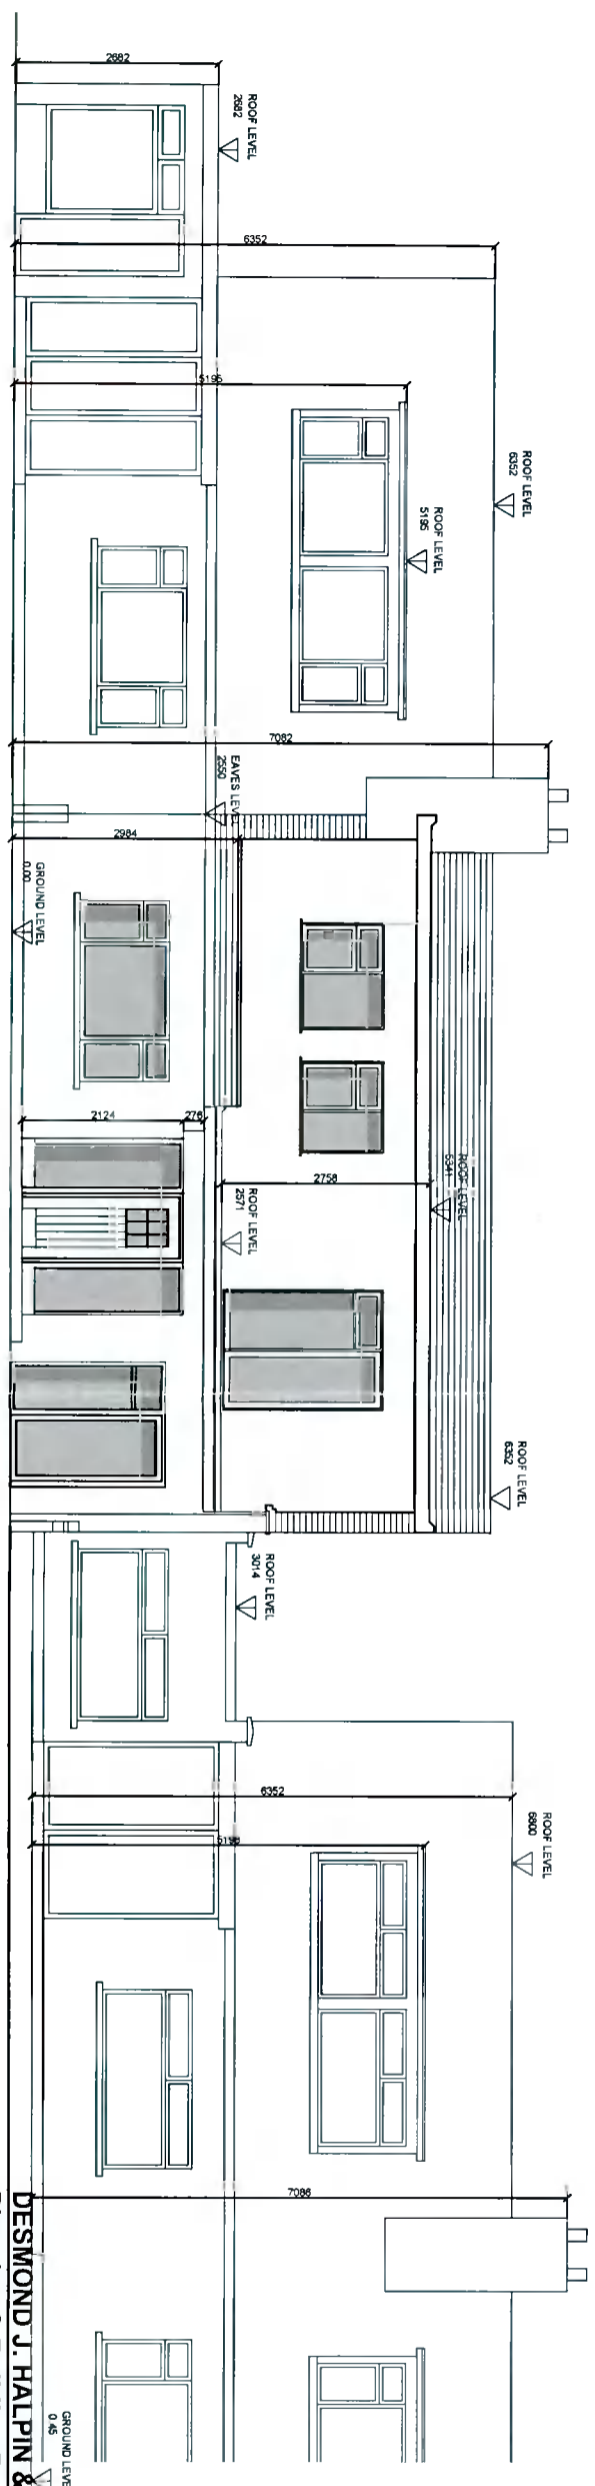

EXISTING FRONT ELEVATION

DESMOND J. HALPIN & ASSOCIATES
 Planning & Building Design Consultants
 15, Camogie Drive, Fintona, Dublin 24 Phone: 01-4523710 Email: deshalpin15@gmail.com

Project: RETENTION OF AS BUILT DOMESTIC EXTENSION 7 MOUNTDOWN PARK, DUBLIN 12, D12HX88		Scale: 1:100 @ A3.	Drawn: DJH
Drawing Title: AS BUILT CONTIGUOUS FRONT & REAR ELEVATIONS.		Drawing No: 09 10 22	Rev:
Applicant: MR. BILLY SHEEHAN	Date: APRIL 2022	CHK: JK	