


- 1. DRAWING APPROVED
- 2. CONTRACTOR SHALL BE RESPONSIBLE FOR OBTAINING ALL NECESSARY PERMITS
- 3. ALL DIMENSIONS TO BE SHOWN TO UNLESS OTHERWISE SPECIFIED
- 4. THE CONTRACTOR SHALL BE RESPONSIBLE FOR OBTAINING ALL NECESSARY PERMITS
- 5. ALL STRUCTURAL WORK TO BE DONE IN ACCORDANCE WITH THE SPECIFICATIONS
- 6. ALL MECHANICAL WORK TO BE DONE IN ACCORDANCE WITH THE SPECIFICATIONS
- 7. ALL ELECTRICAL WORK TO BE DONE IN ACCORDANCE WITH THE SPECIFICATIONS
- 8. CONTRACTOR SHALL BE RESPONSIBLE FOR THE PROTECTION OF EXISTING UTILITIES

REV	DATE	DESCRIPTION	BY


— Outline of proposed planning amendment  
— Land in ownership of the applicant



SCHOLARSTOWN ROAD AS CONSTRUCTED CONTEXTUAL ELEVATION A-A 1:500

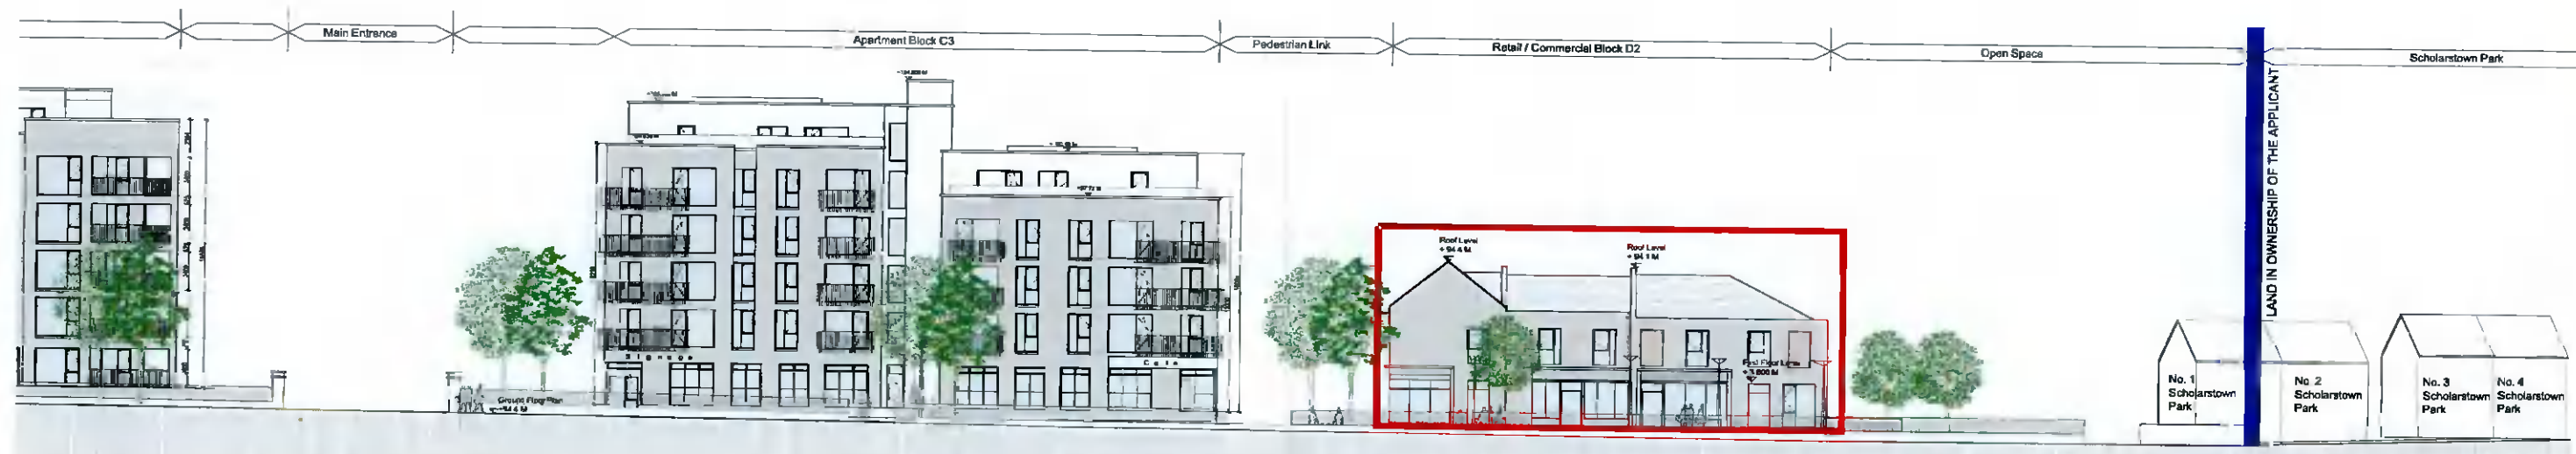

SCHOLARSTOWN ROAD AS CONSTRUCTED CONTEXTUAL ELEVATION A-A 1:200

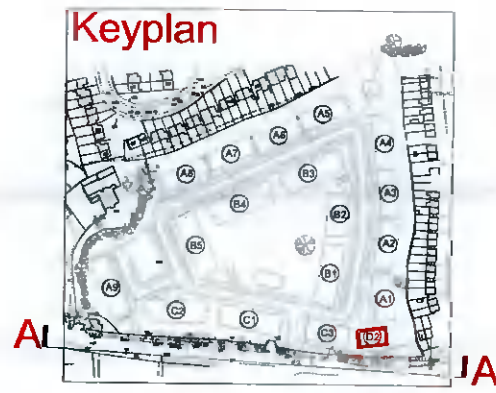

**JOHN FLEMING ARCHITECTS**

Client: Ardstone Homes Ltd

Project: Residential Development at Scholarstown Park

Drawing: Site Context As Constructed Elevations A-A

SCALE: 200 NO  
 Varies - As Indicated 1823  
 DRAWN BY: JFC  
 DATE: November 2018  
 DRAWING NUMBER: SCH-JFA-D2-ZZ-DR-A-1302

DRAWING STATUS: PLANNING AMENDMENT