


NTS

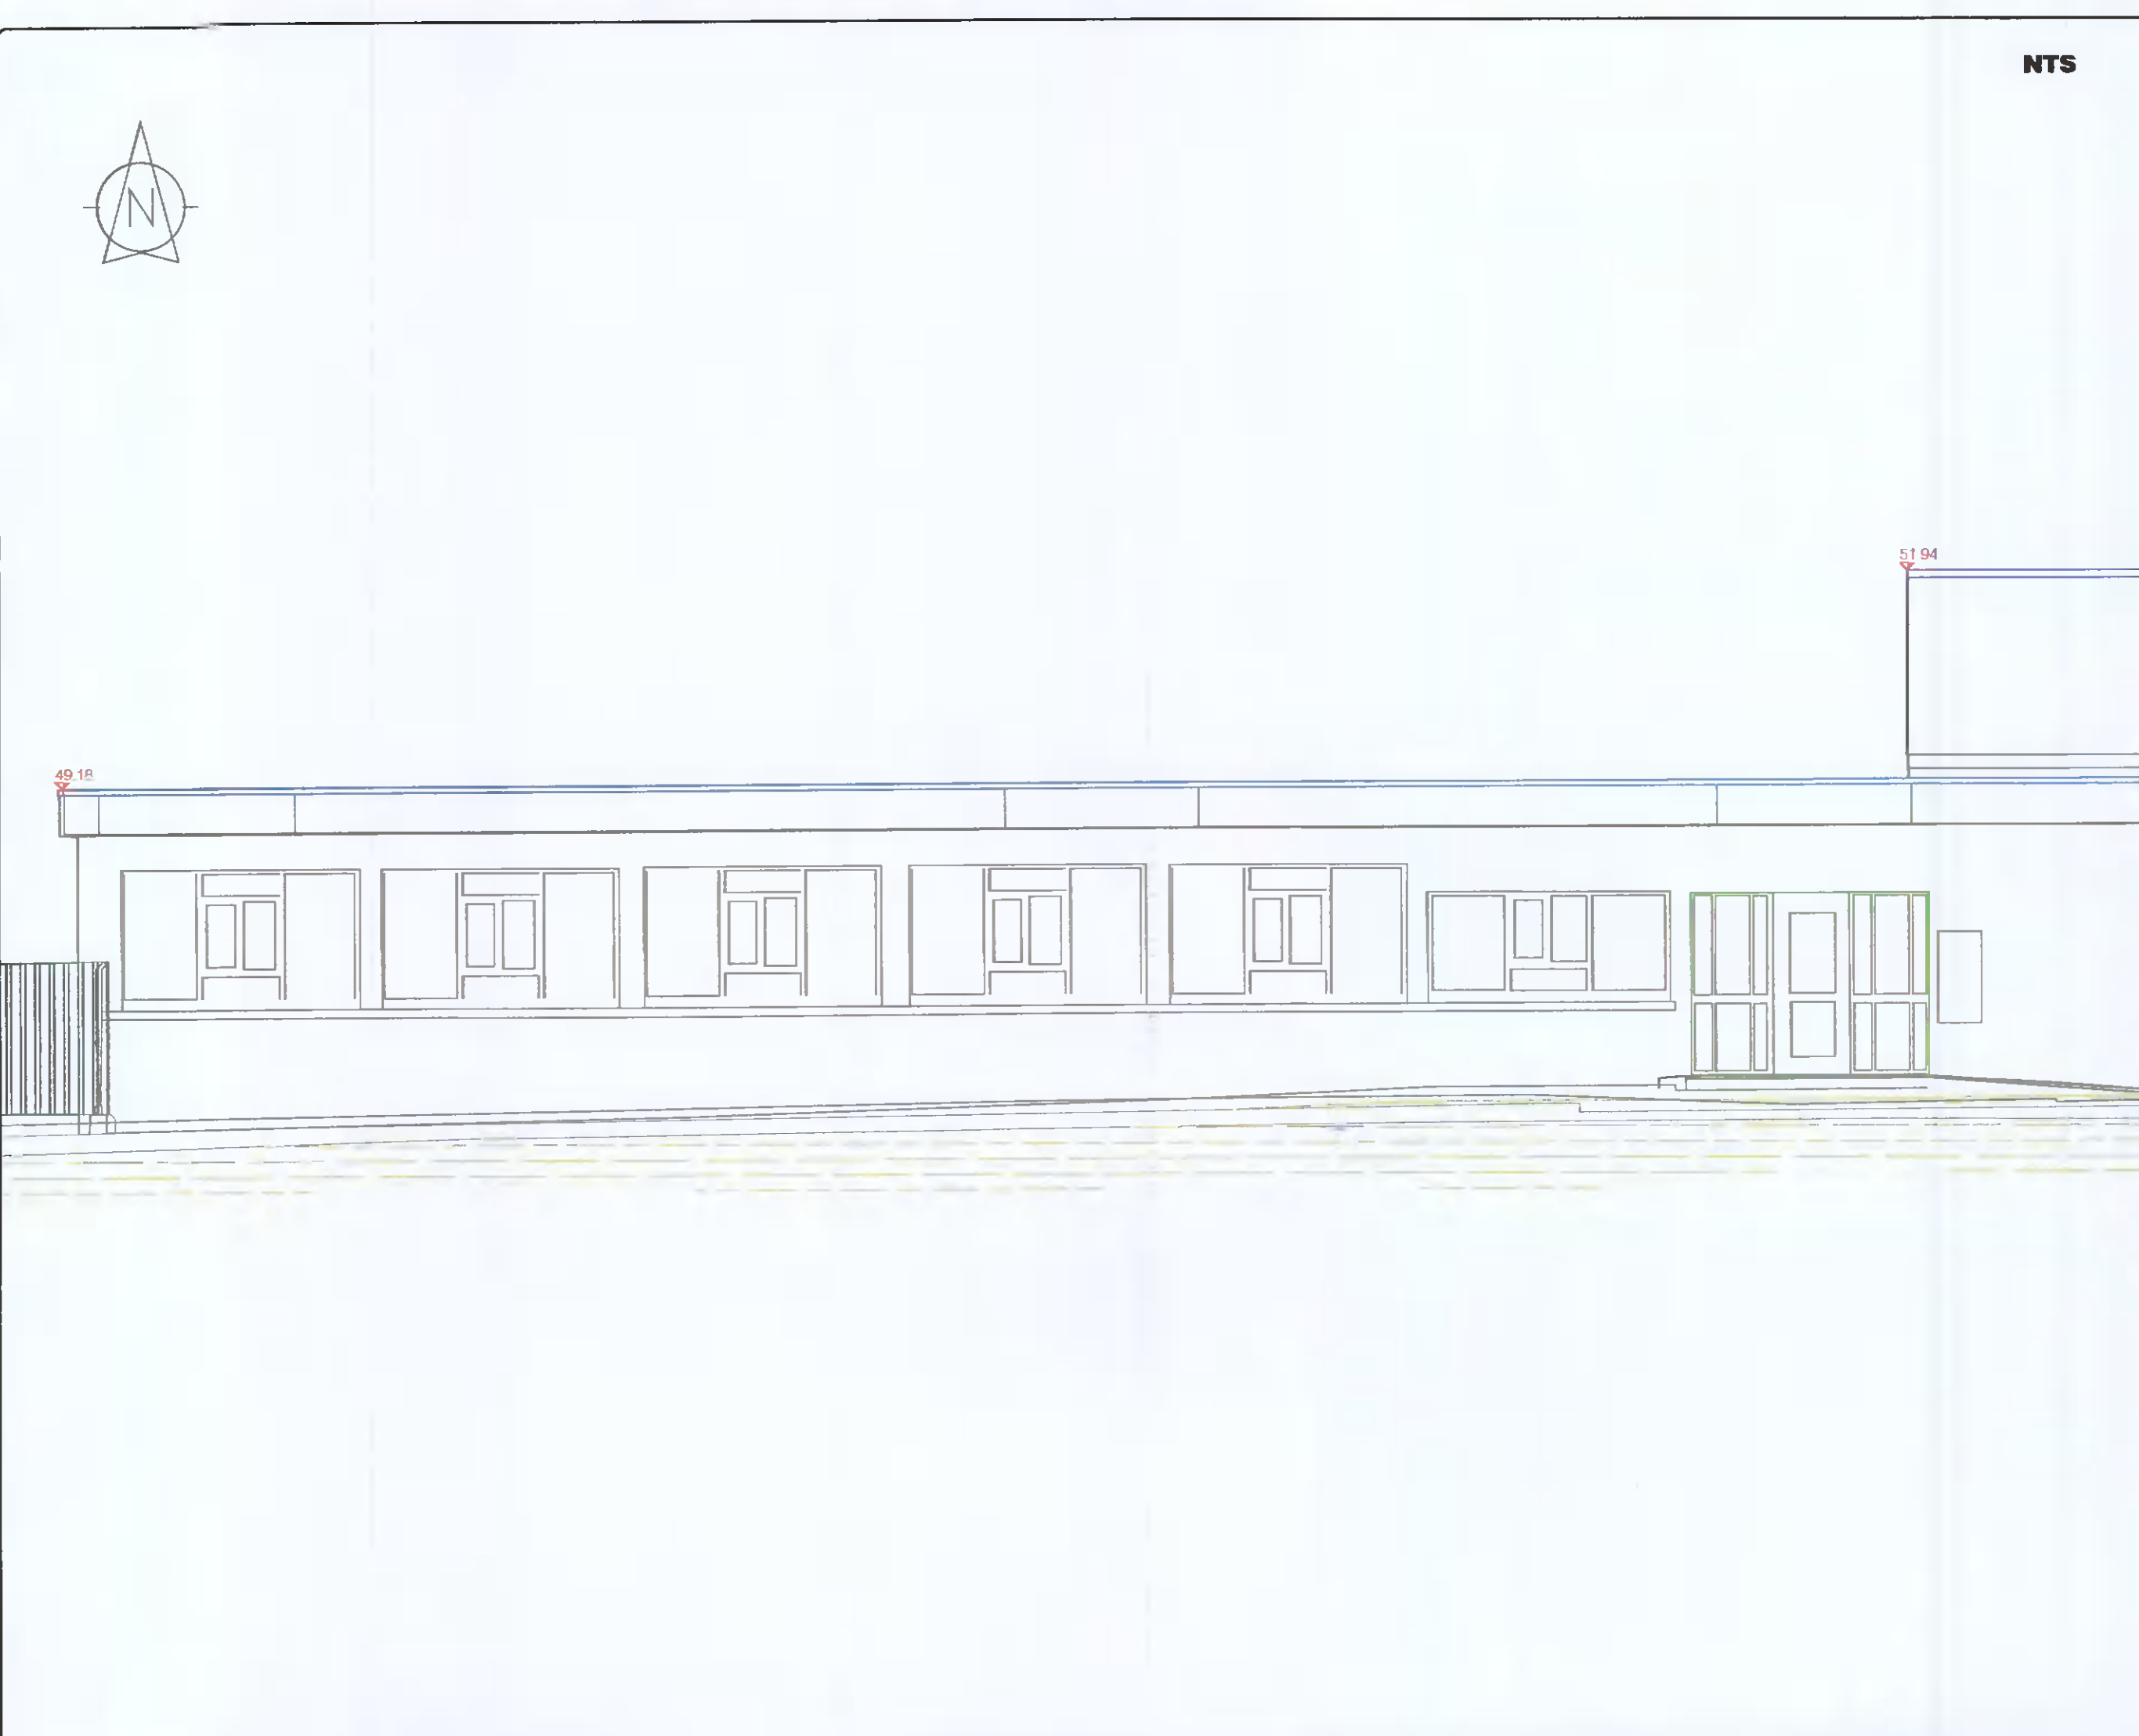

LEGEND
Street furniture & Services

Over Head Wires (LWS) - Pylon ESB	Bus Stop	Binch Seat	Phone Box
Pipe	Island	Bus Stop	Case Cover
La	Beacon	Gully	C/P Box
Banner	Crashbar Cover	Waste Bin	
Pump	Bore Hole	Hydrant	
Traffic Light	Electricity Pole	Fire Hydrant	
Day/Tram Shelter	Telegraph pole	ESB Box	
Postbox	OCSS Pole	ESB Inspection Cover	
Valve - General	CCTV Camera Pole	ESB Inspection Cover	
Water Valve	Lamp Post	Traffic Control Box	
Gas Valve	Foot Marker	LUAS Technical Guide	
Quon Valve	Surround Water M/H	Water Meter Cover	
Air Valve	Manholes	Water Meter Cover	
Stop Cock	Air Conditioning Vents	Telecom Inspection Cover	
C/P Post	Services Inspection Cover	Monument / Toilets	
Marker Post	Traffic Inspection Cover	Truck Storage	
Parking Meter	Cable TV Inspection Cover	Basement M/H Cover & Pipe	
Plane Area Mark	ESAT Inspection Cover	Dashed Aerial Mark	
Street Caster Indicator	NTL Inspection Cover	Stay for pole	
Unscreen Valve	Enorm Inspection Cover	Pipe Protection	
	Flooding Eye	Washout	

Natural Features

Surface Change	Water Level	Golf
Land Drain	Crown Level	Fair Way
Bottom of Slope	Invert Level	Green
Top of Slope	Bed Level	Tea Box
Ditch	Spotheight	Other
Water Edge / Lake / Pond		Survey Station
Hedge / Trees Drip Line / Vegetation		Photopoint
Tree Deciduous		Top of Tree

Built Features

Roads & Road Markings

Building	Fence	Floor Level
Edge of Road	Gate	Apex Height
Kerb Bottom	Road Cerelesis	Eaves Height
Kerb Top	Top of Wall	Parquet Height
Bridge Abutment	Hoarding	Scotts Elevation
Bridge Deck	Property Line	Step Level
Bridge Pier	Flood Scar	Concrete Plat
Building Facade	Top of Fence	Track
Footpath / Platform / Train & Tram		
Damp Proof Course / Weger		
Bridge Pier / Wall & Gate Pillar / LUAS Trackbed		
Cycleway / Private Landing Area		


Murphy Surveys Ltd Disclaimer

The user or recipient of this survey data understands and acknowledges this data may be inaccurate or contain errors or omissions and the user or recipient assumes full responsibility for any risks or damages resulting from, arising from, or in connection with any use of or reliance upon data displayed herein. Although significant care has been exercised to produce surveys that satisfy survey accuracy standards, these surveys are only as accurate as the source data from which they were compiled. Although all reasonable steps have been taken to locate all features visible at the time of the survey, there is no guarantee that all will be shown on the drawing, as some above ground features may have obstructed the survey. Wherever possible, areas unable to be surveyed will be labelled as "UTS".


The Company shall not be liable for any inaccuracy of the data provided beyond the specified scale or accuracy, or for any matters resulting from their use for purposes other than that stated in the Contract. No liability shall attach to the Surveyor in respect of any consequential loss or damages suffered by the Client.

The Client must promptly notify the Company of any errors in mapping of which it becomes aware. If misleading, inaccurate or otherwise inappropriate information is brought to the Company's attention or the Company itself identifies any such misrepresentation or error in a survey, it shall use its reasonable endeavours to fix or remove it and if necessary in certain instances, the Company being on notice of any such misleading, inaccurate or otherwise inappropriate information, it will re-conduct the survey and reproduce the data to within the specified scale or accuracy.

Existing Sign Post - Unused

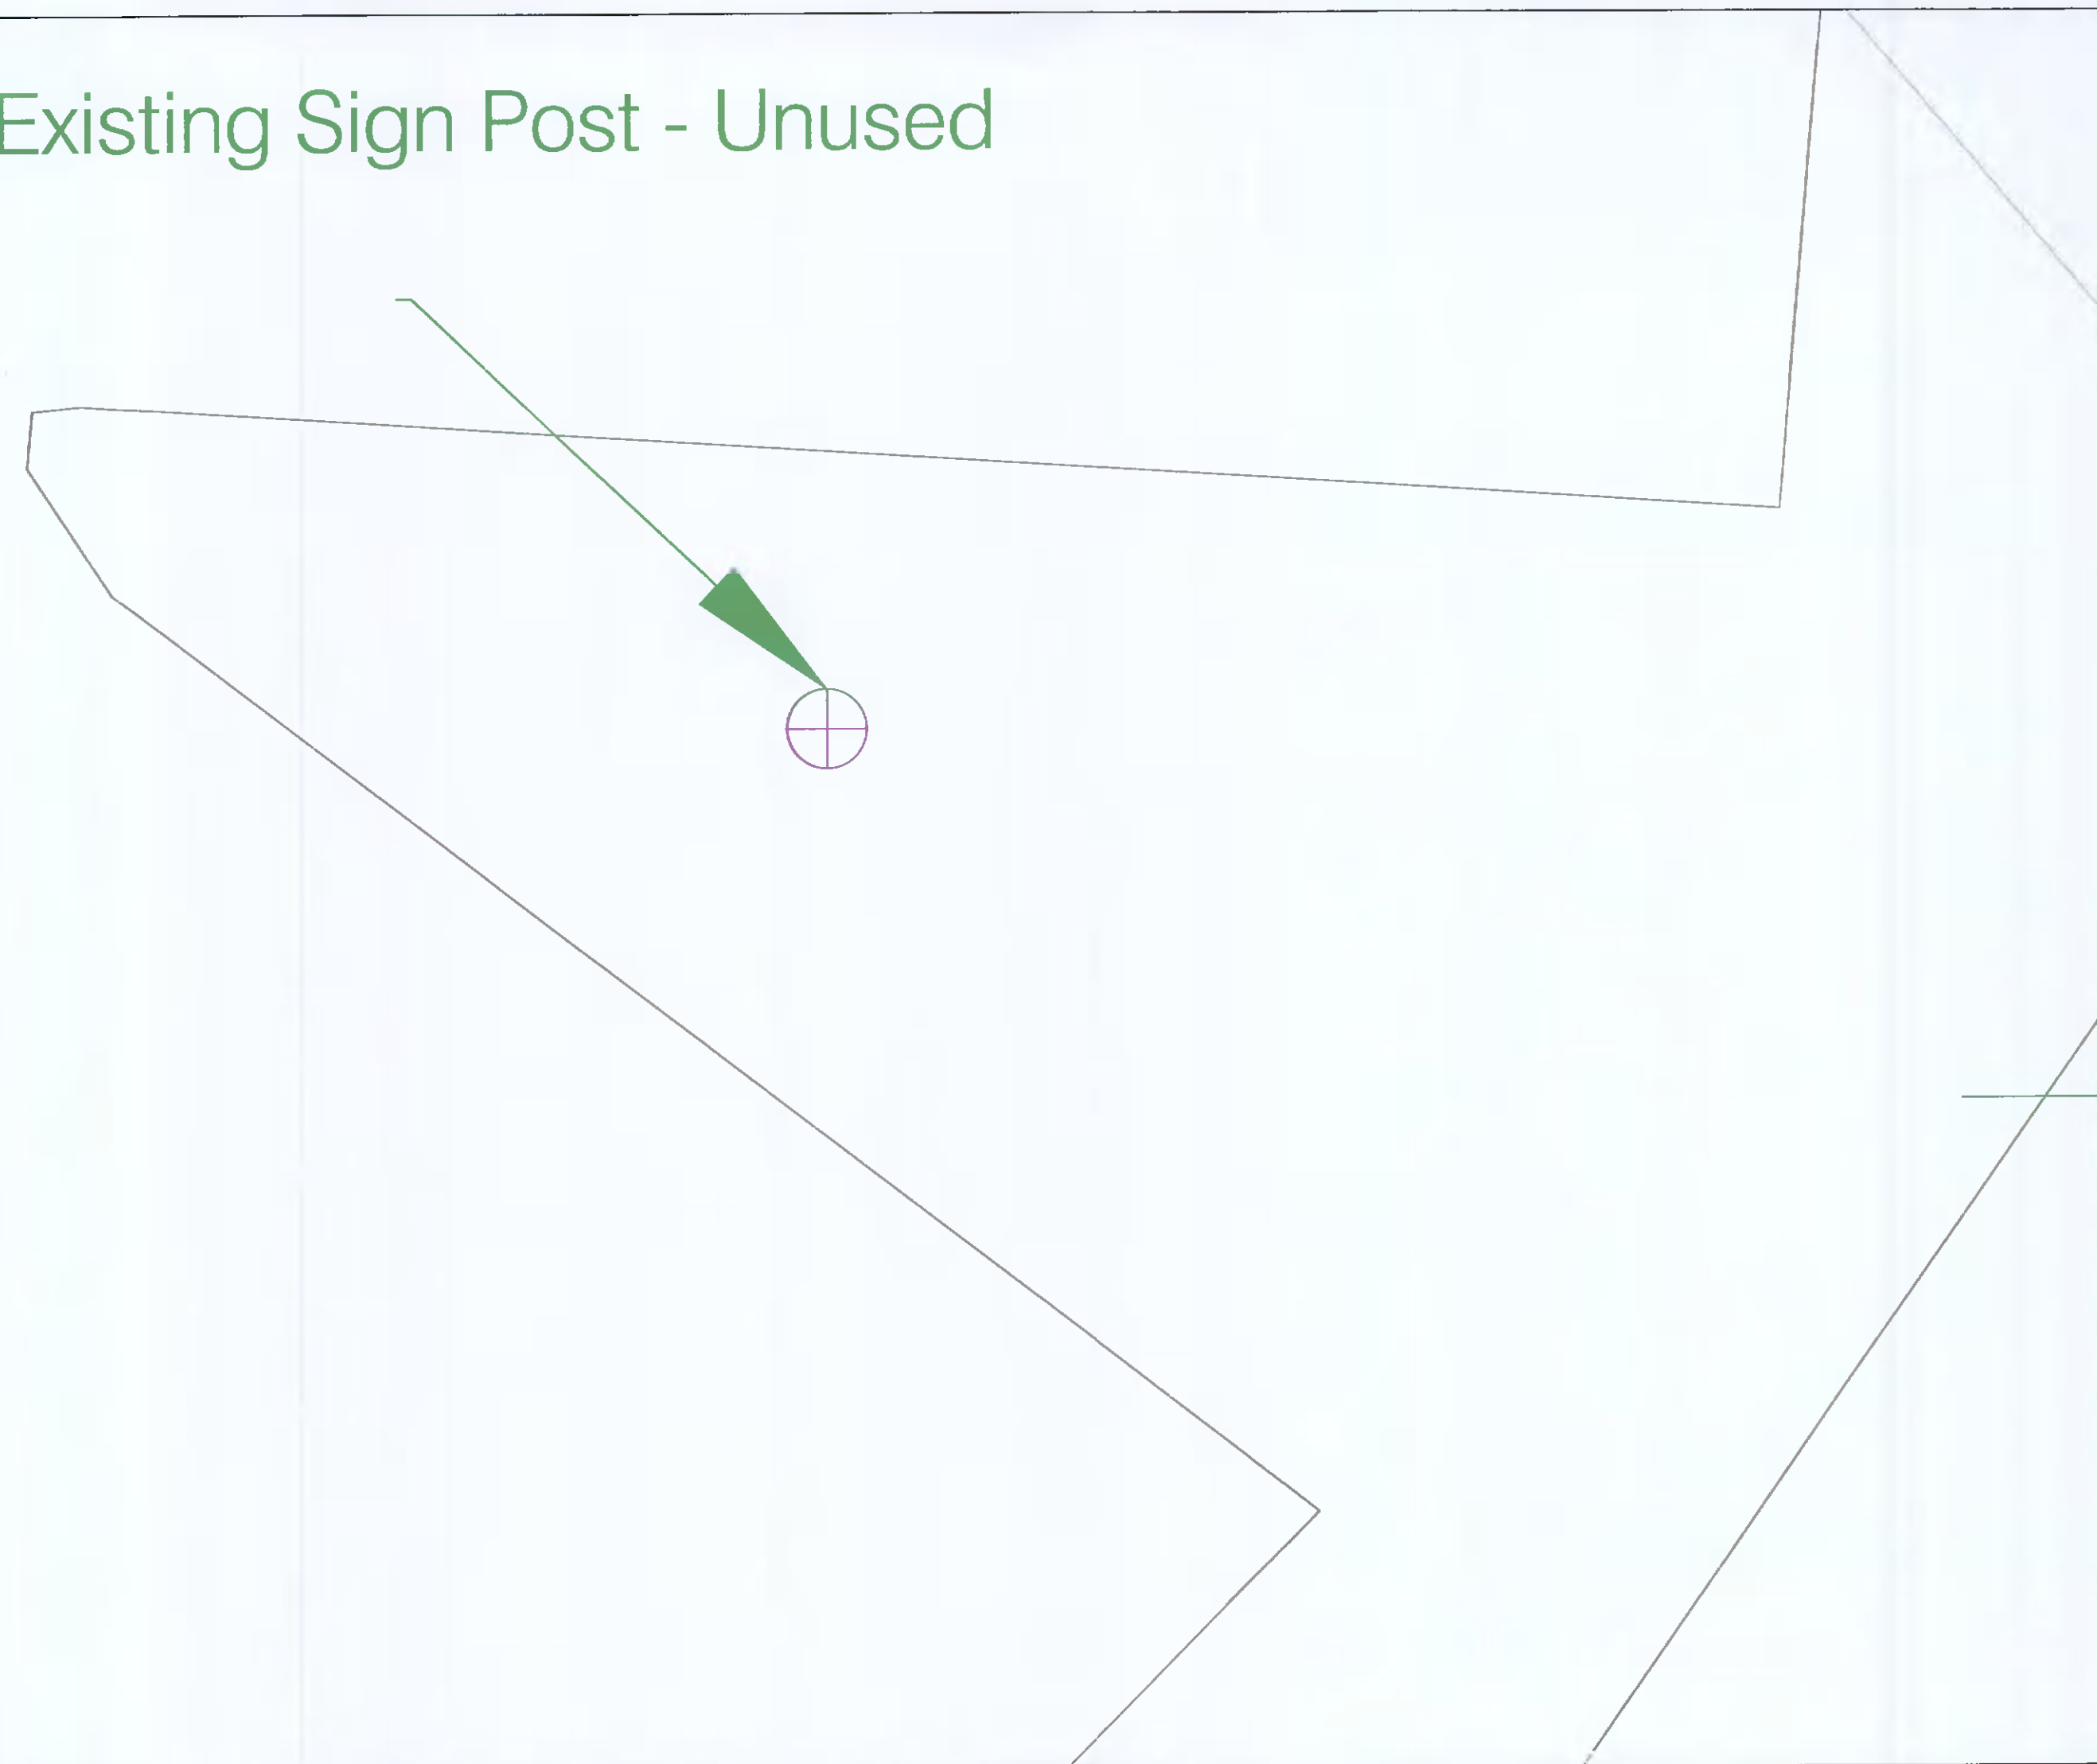

Existing Sign Post Unused - approx 2.5m-3m

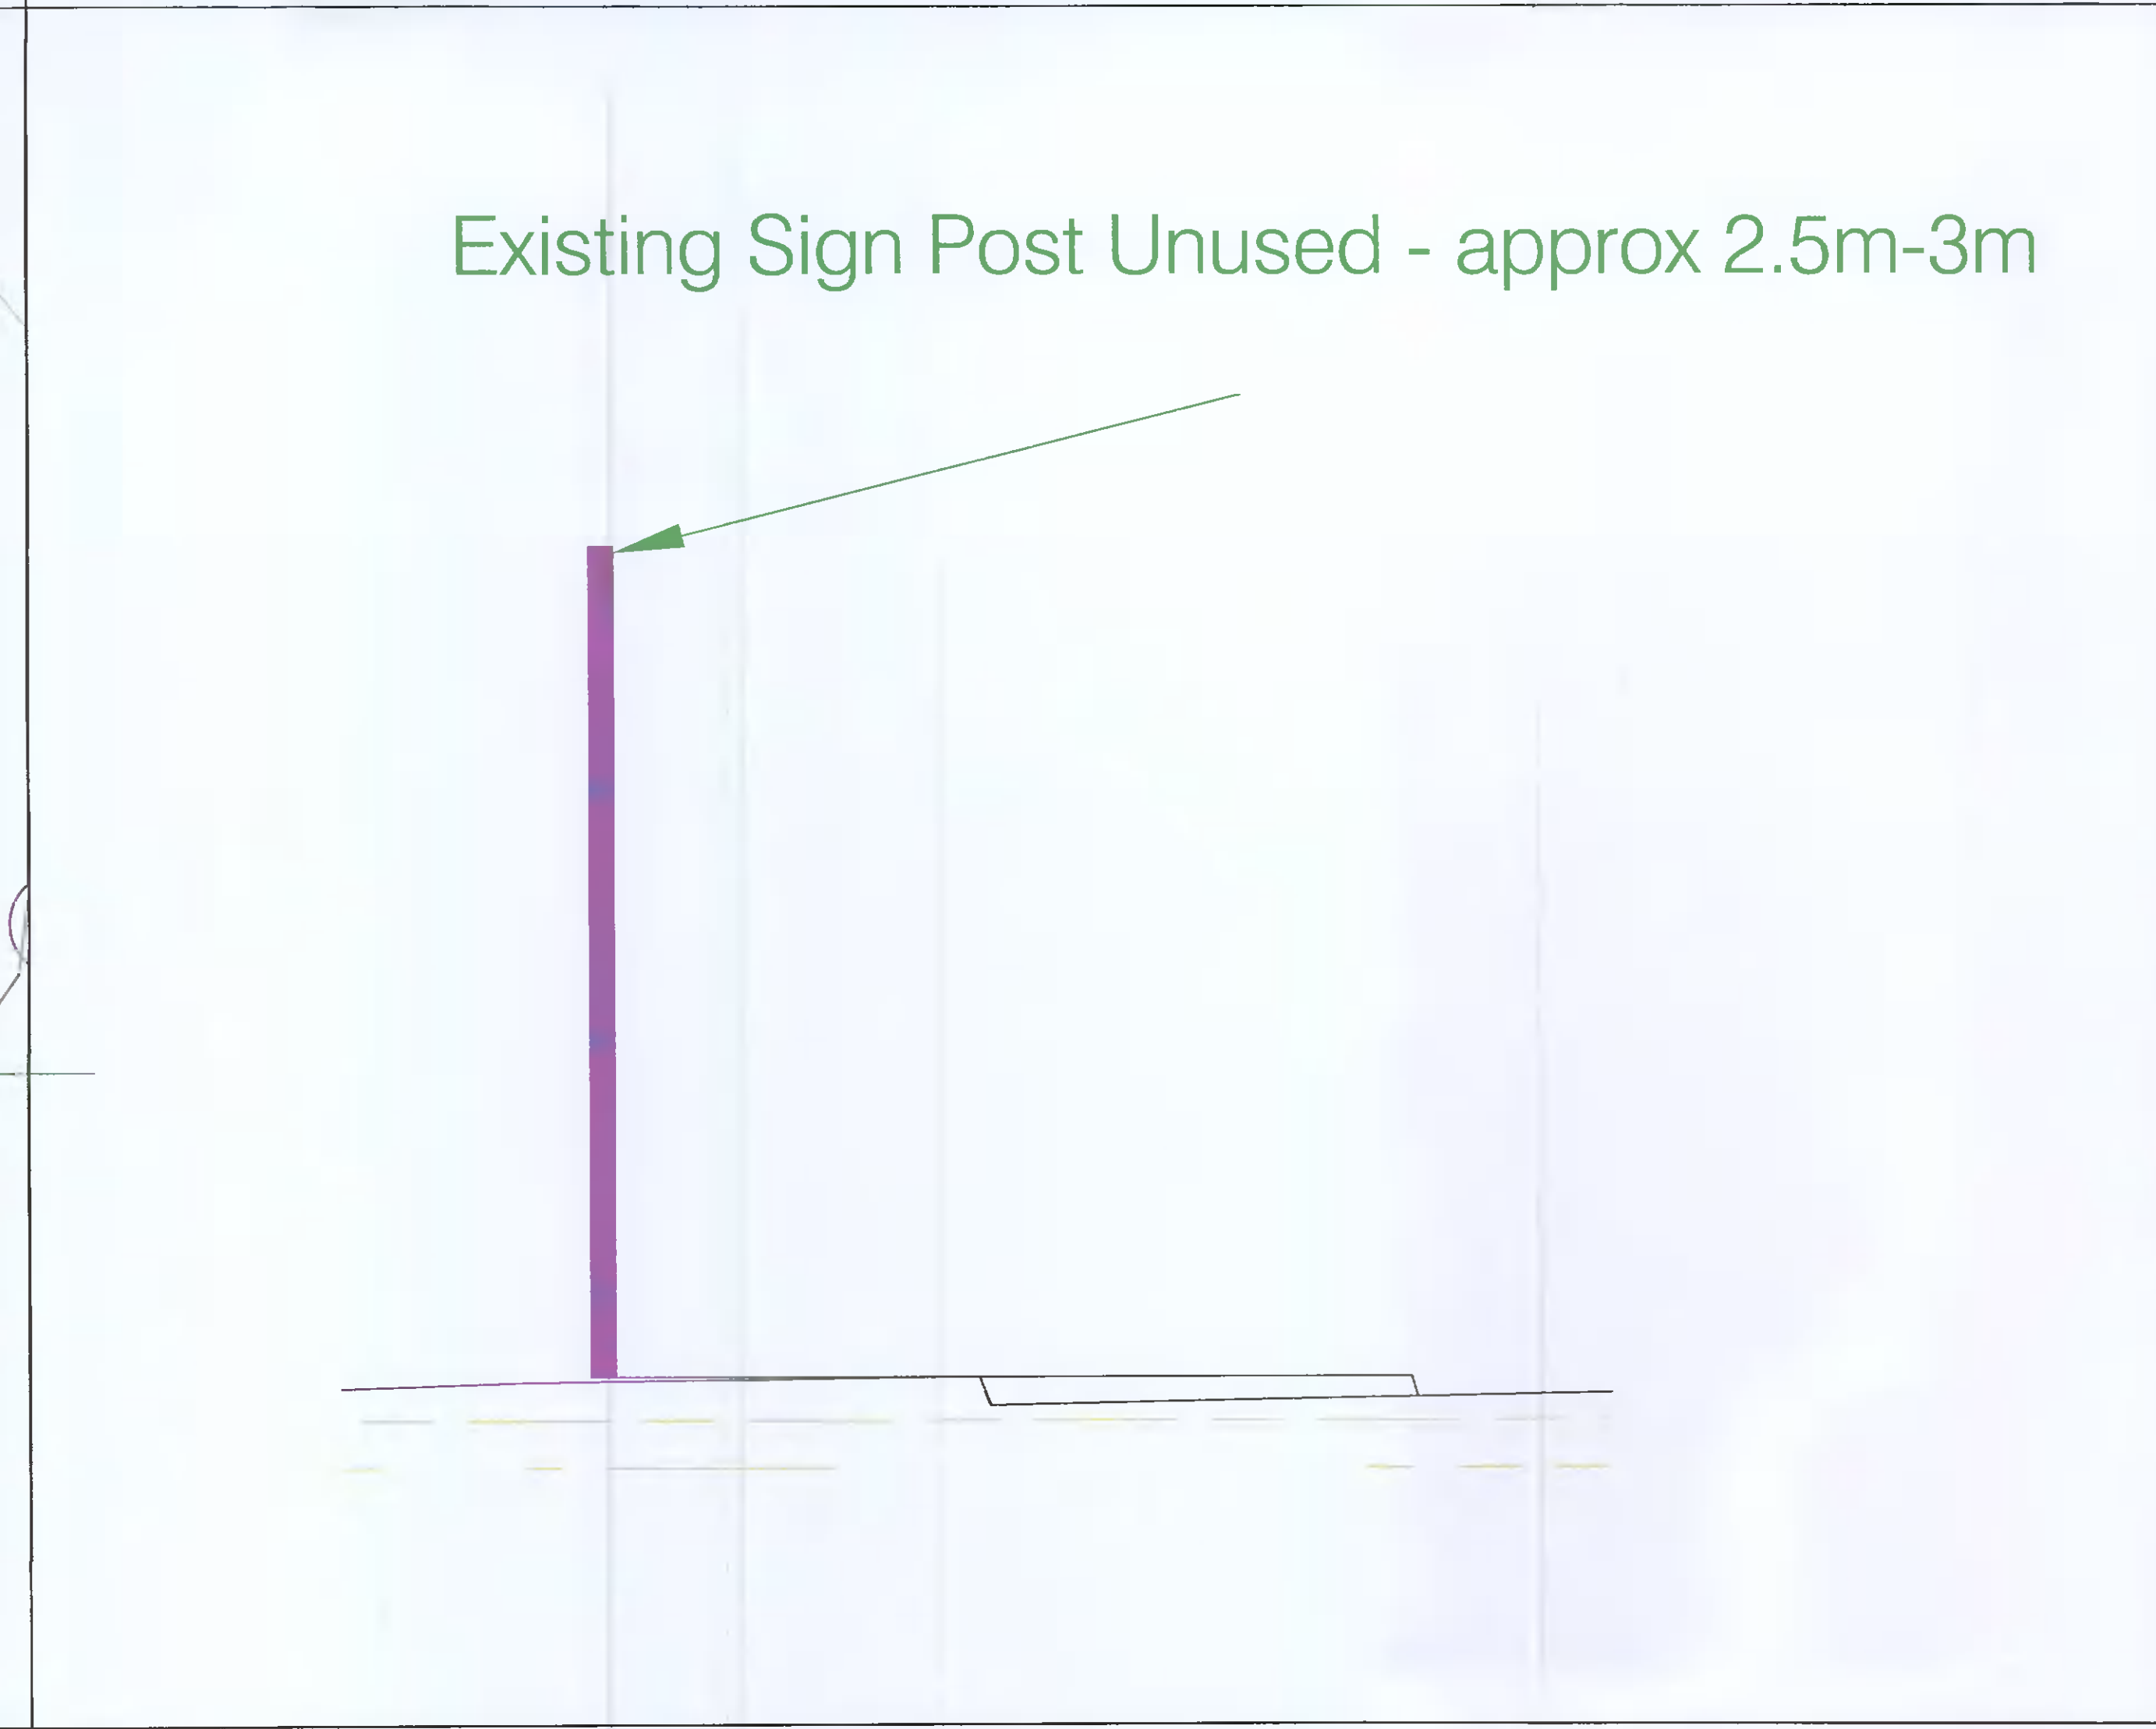

Map Sheet Layout:

Surveyed by: FM	Date: 24.06.2020	Drawn: Multi Head
Drawn by: CS	Date: 16.03.2022	Grid System: Irish National Grid
Checked by: PK	Date: 16.03.2022	Irish National Grid: 716415

No.	Date	Description	Revisions
0	06.2020	Final Drawing	
1	16.03.2022	Details added, Elevations added	

Murphy GEOSPATIAL

Topographic surveys, Measured Building Surveys, Setting Out, As-Built Surveys, Hydrographic Surveys, Legal Mapping, Planning Surveys, Boundary Location, General Practising Surveys, Laser Scanning, Drone Photogrammetry

Kildare Cork Dublin Belfast Glasgow Manchester London

Head Office
Global House
Kilcullen Business Campus
Kilcullen Co. Kildare
Ireland

Phone: (+353) 045 484040
Fax: (+353) 045 484004
Email: info@murphysurveys.ie

Client: BOC Gases Ireland

Project: BOC Gases Ireland at Unit 10 JFK Drive

Date: 16.03.2022 **Scale:** 1:50@A1

Description: Existing Elevations

Drawing Number: MGS39042_EL_Rev3_5

© Copyright 2022 MURPHY GEOSPATIAL LTD