




Site Layout - Original

Additional Information
 Item 1(a): Original site layout showing No. 6 Bettysford Terrace as a residential property, prior to carrying of the works which are the subject of the current application.

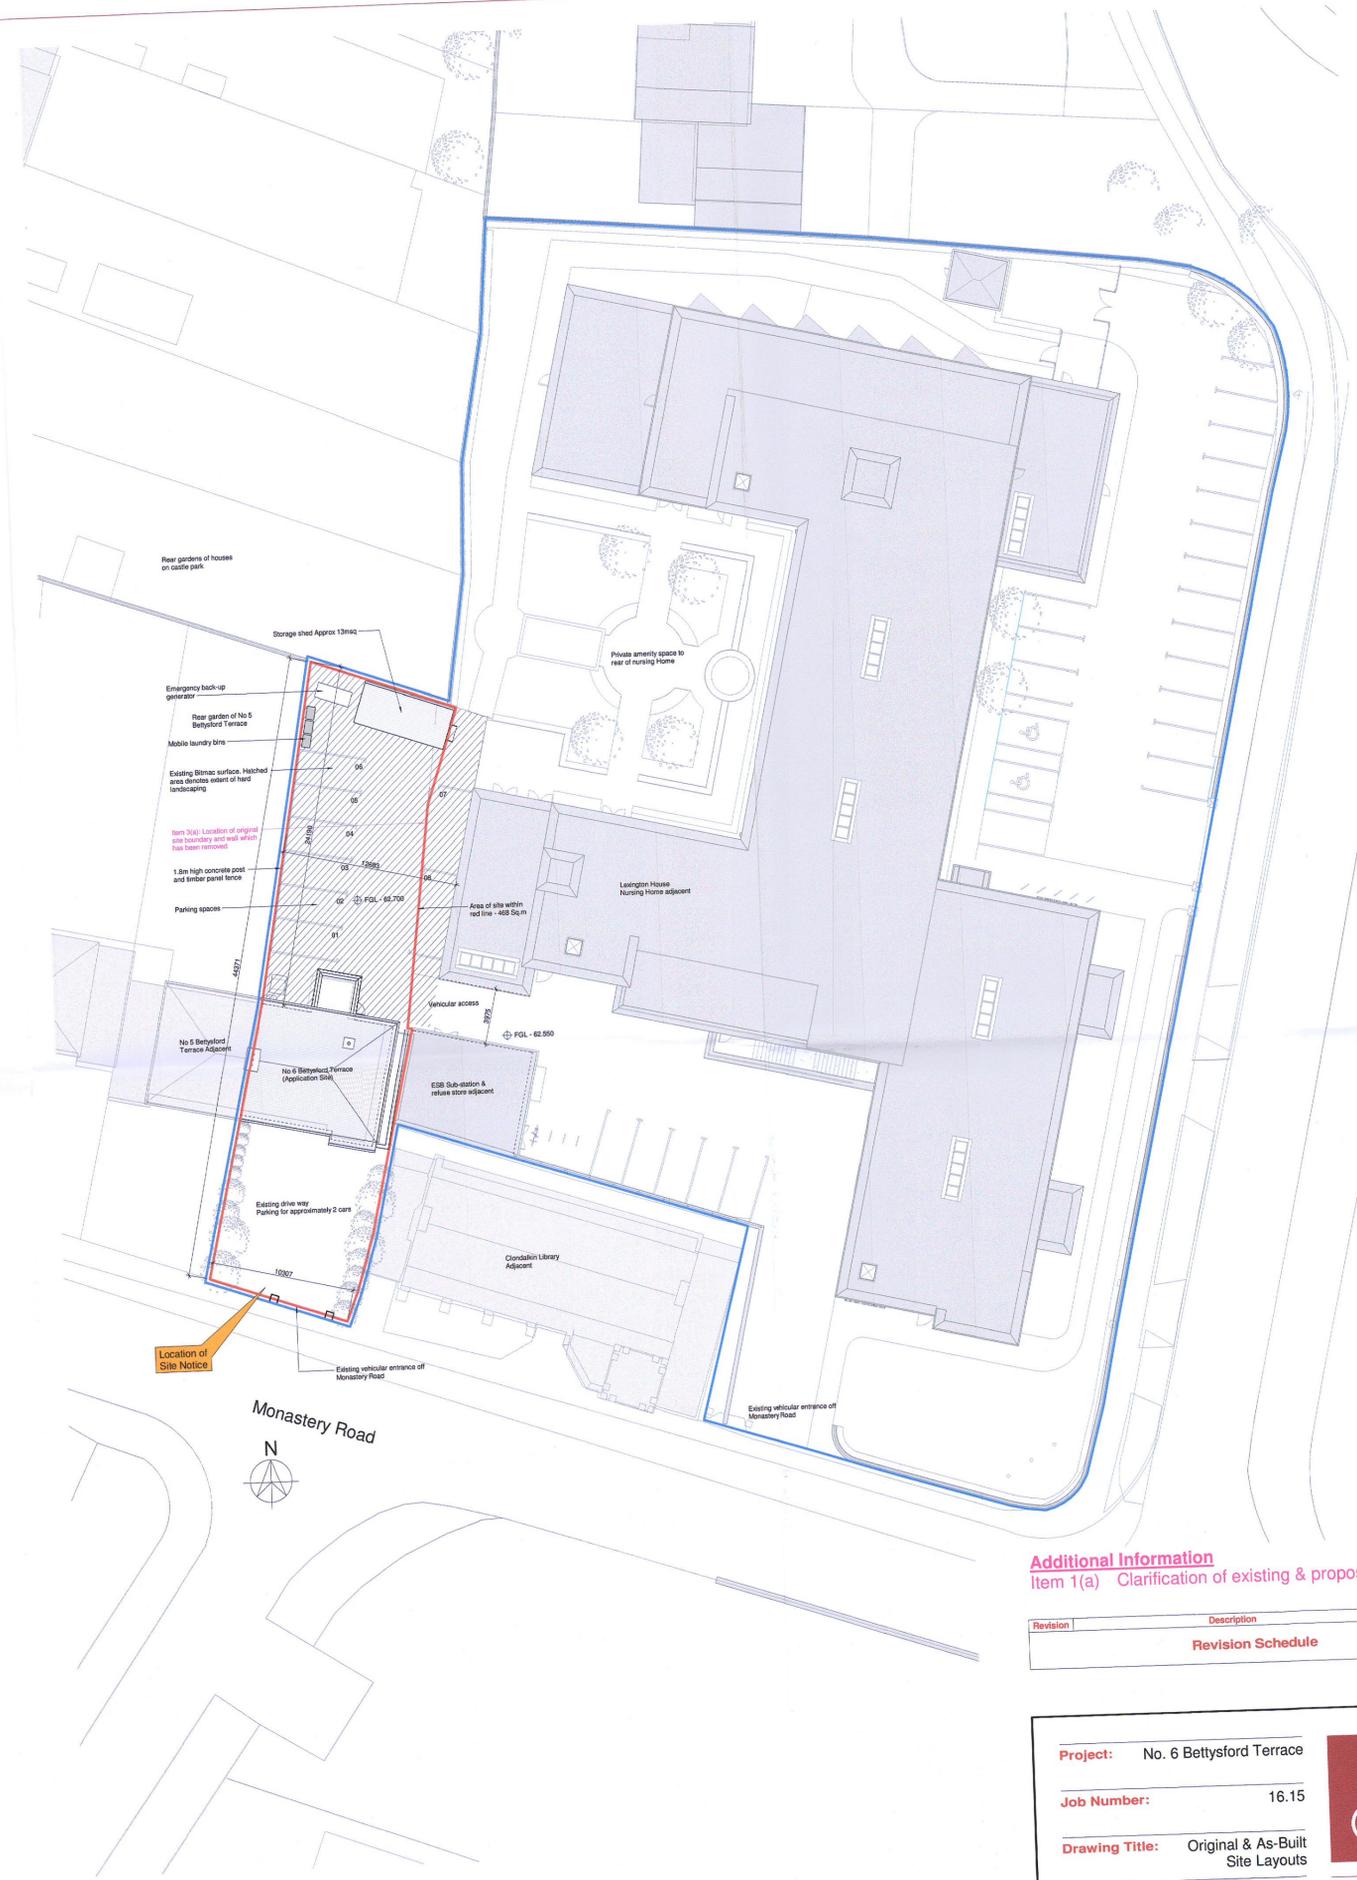

Site Layout - Existing
 1: 250

Additional Information
 Item 1(a): Site layout as it currently exists

Additional Information
 Item 1(a) Clarification of existing & proposed conditions

Revision	Description	Date	By
Revision Schedule			

Project:	No. 6 Bettysford Terrace	 CQA Design & Build Unit B4, Swords Enterprise Park, Feltrim Road, Swords, Co. Dublin T 01 8903080 E info@cqa.ie W www.cqa.ie
Job Number:	16.15	
Drawing Title:	Original & As-Built Site Layouts	
Drawing No.:	P402	
Date:	September 2022	
Scale:	As shown @ A1	