



©This drawing is copyright.  
Do not scale - Use figured dimensions only;  
Any discrepancies should immediately be brought to the attention of the architect.

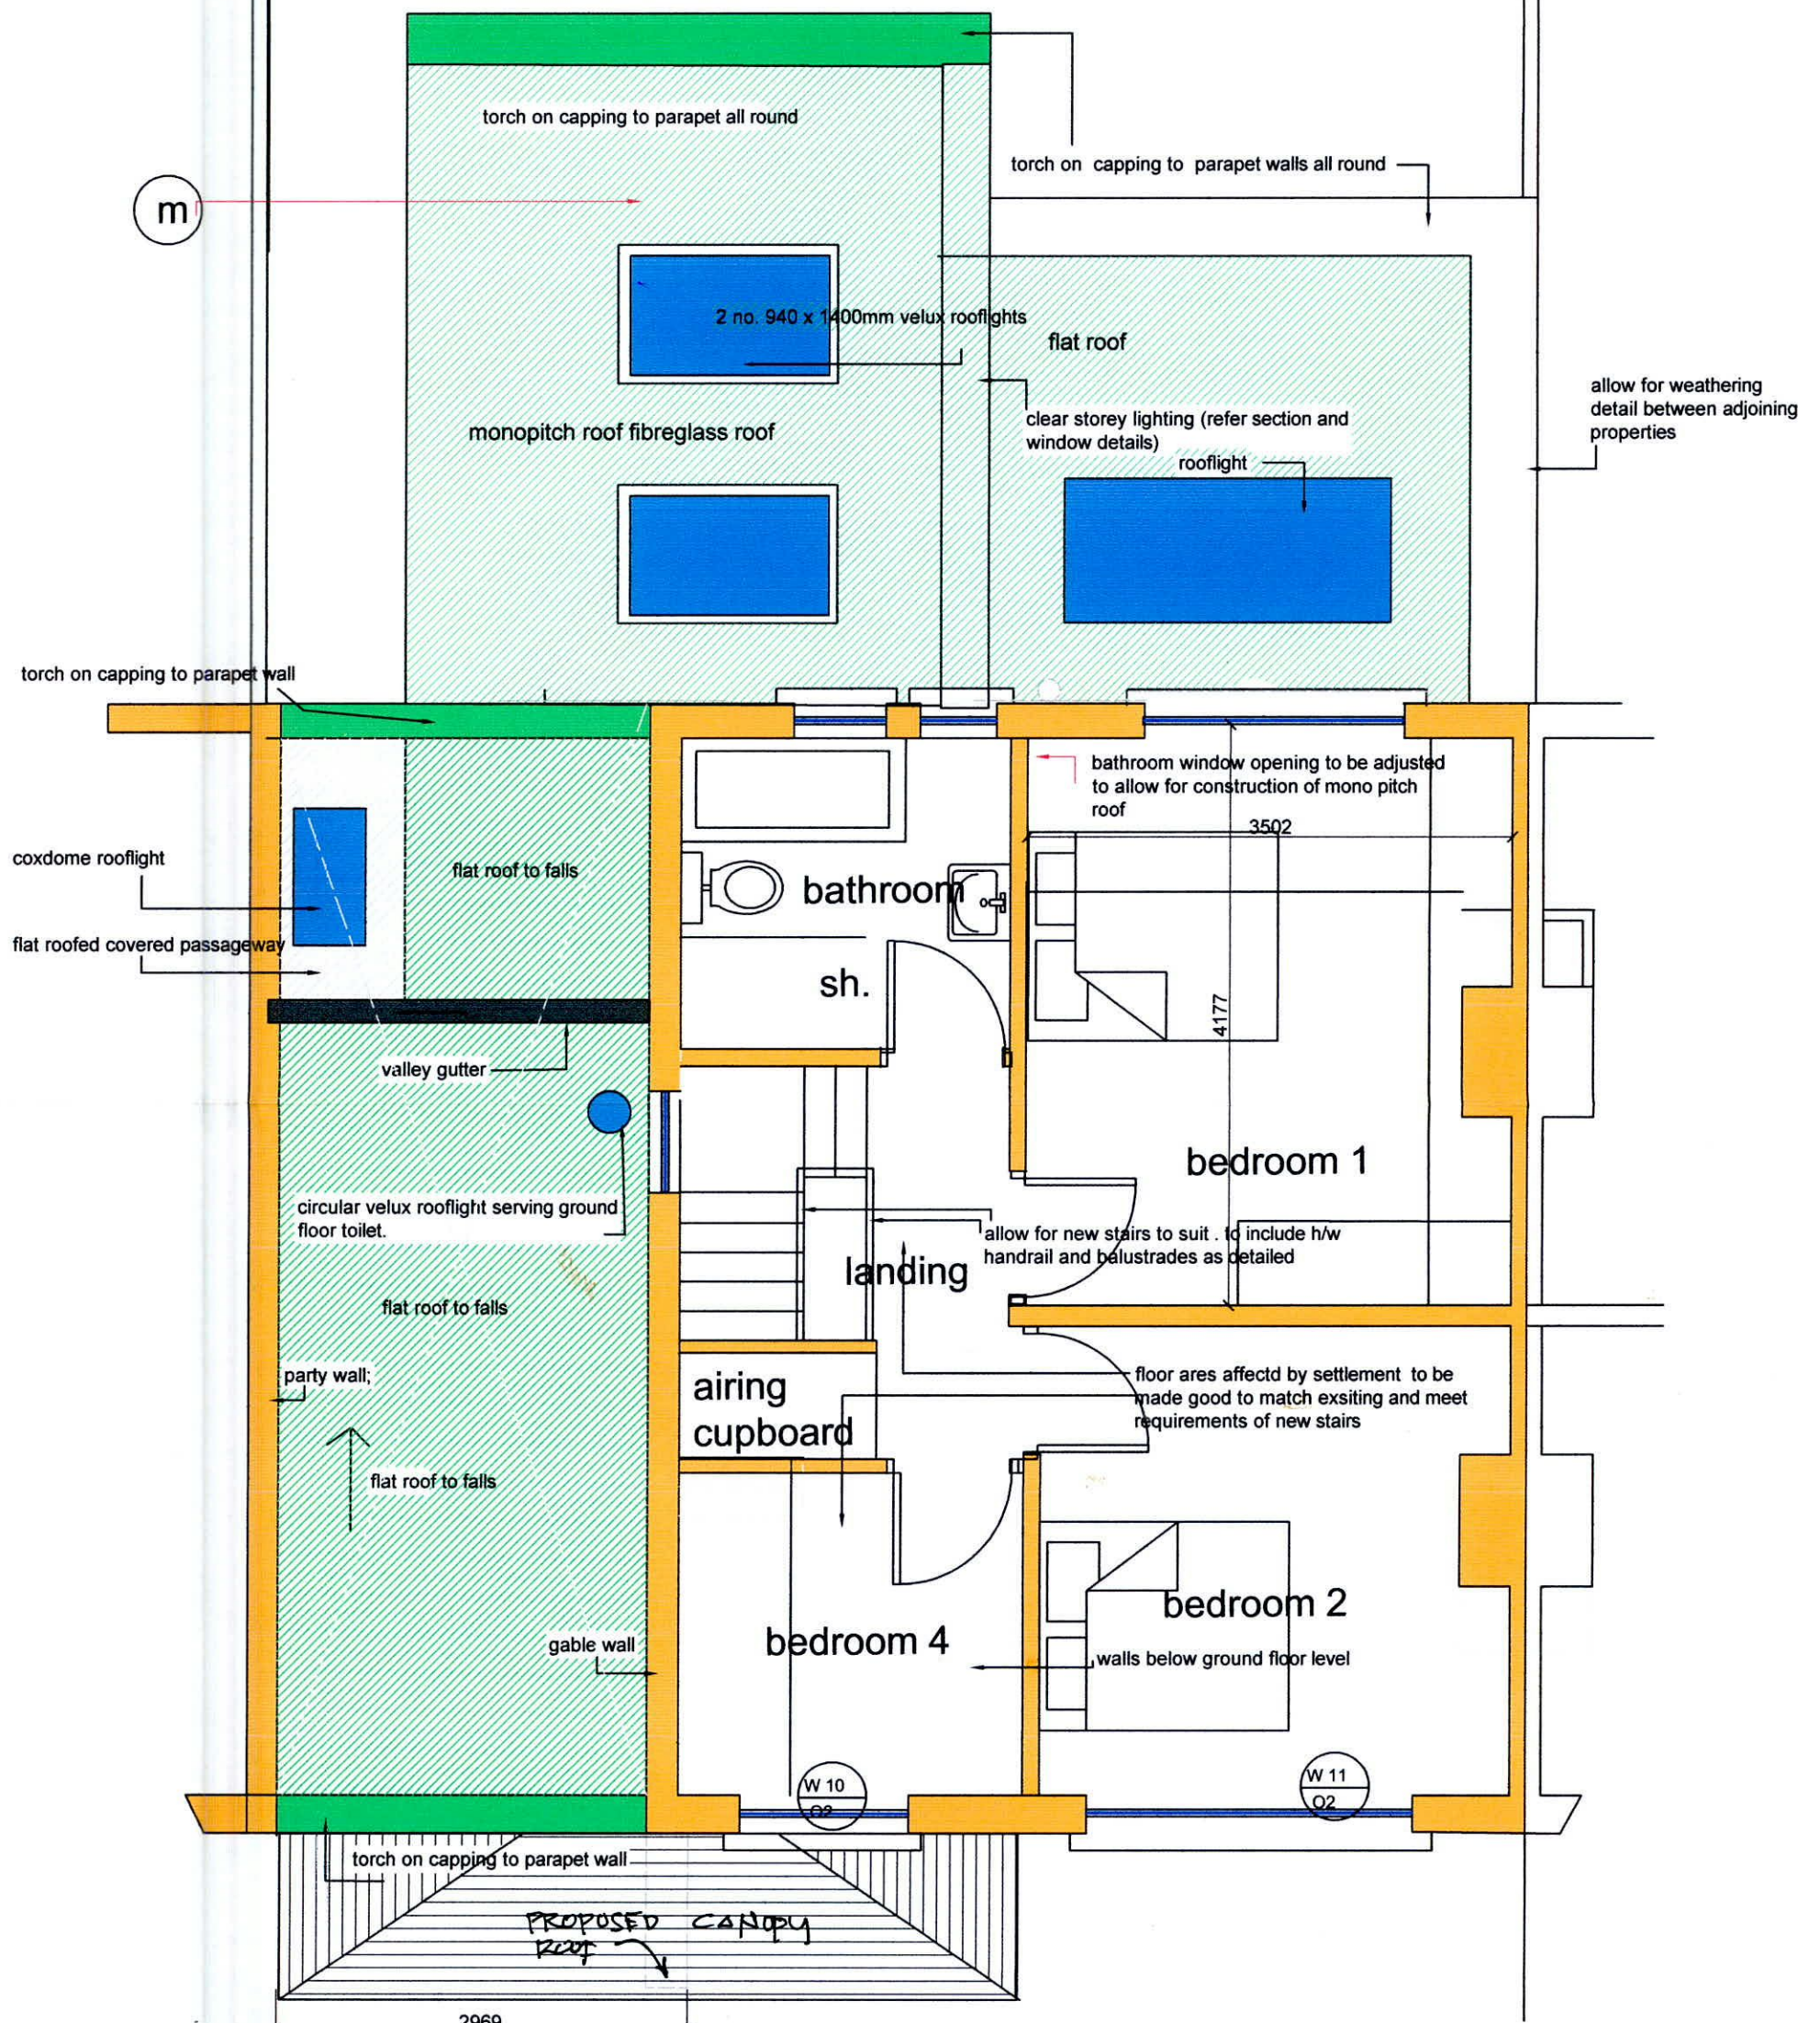

**FIRST FLOOR PLAN** 1: 50 AS BUILT

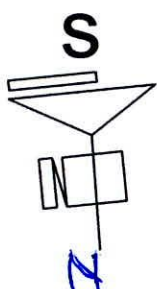

DO NOT SCALE - USE FIGURED DIMENSIONS ONLY

| REV. | DATE | DRAWN | DESCRIPTION |
|------|------|-------|-------------|
|      |      |       |             |
|      |      |       |             |
**CORMAC MURPHY**  
& ASSOCIATES | ARCHITECTS

PROJECT: 76 DODDER PARK ROAD  
RATHFARNHAM CO. DUBLIN

DRAWING: FIRST FLOOR PLAN  
As Built

cormac murphy + associates architects  
ARCHITECTS - M.R.I.A.I T.01-8335734 M.0872847418

|   |                              |               |
|---|------------------------------|---------------|
| SCALE: 1:50   | STATUS: PLANNING APPLICATION |               |
| DATE: JULY 2022   | DRAWN: A.F.                  | CHECKED: C.M. |
| JOB NO: CM.22.02  | DRAWING NO: 07               | REVISION:     |
| seaview studio, 162 hampton cove, skerries rd,<br>balbriggan, co.dublin cormacmurphy8@gmail.com |                              |               |