


©This drawing is copyright.
Do not scale - Use figured dimensions only;
Any discrepancies should immediately be
brought to the attention of the architect.

NOTE; ALL STRUCTURAL WORKS / TO
ENGINEERS SPECIFICATIONS


allow for 300mm fibreglass
insulation over attic space
with wrap around insulation to
water storage tanks and all
ancillary pipework

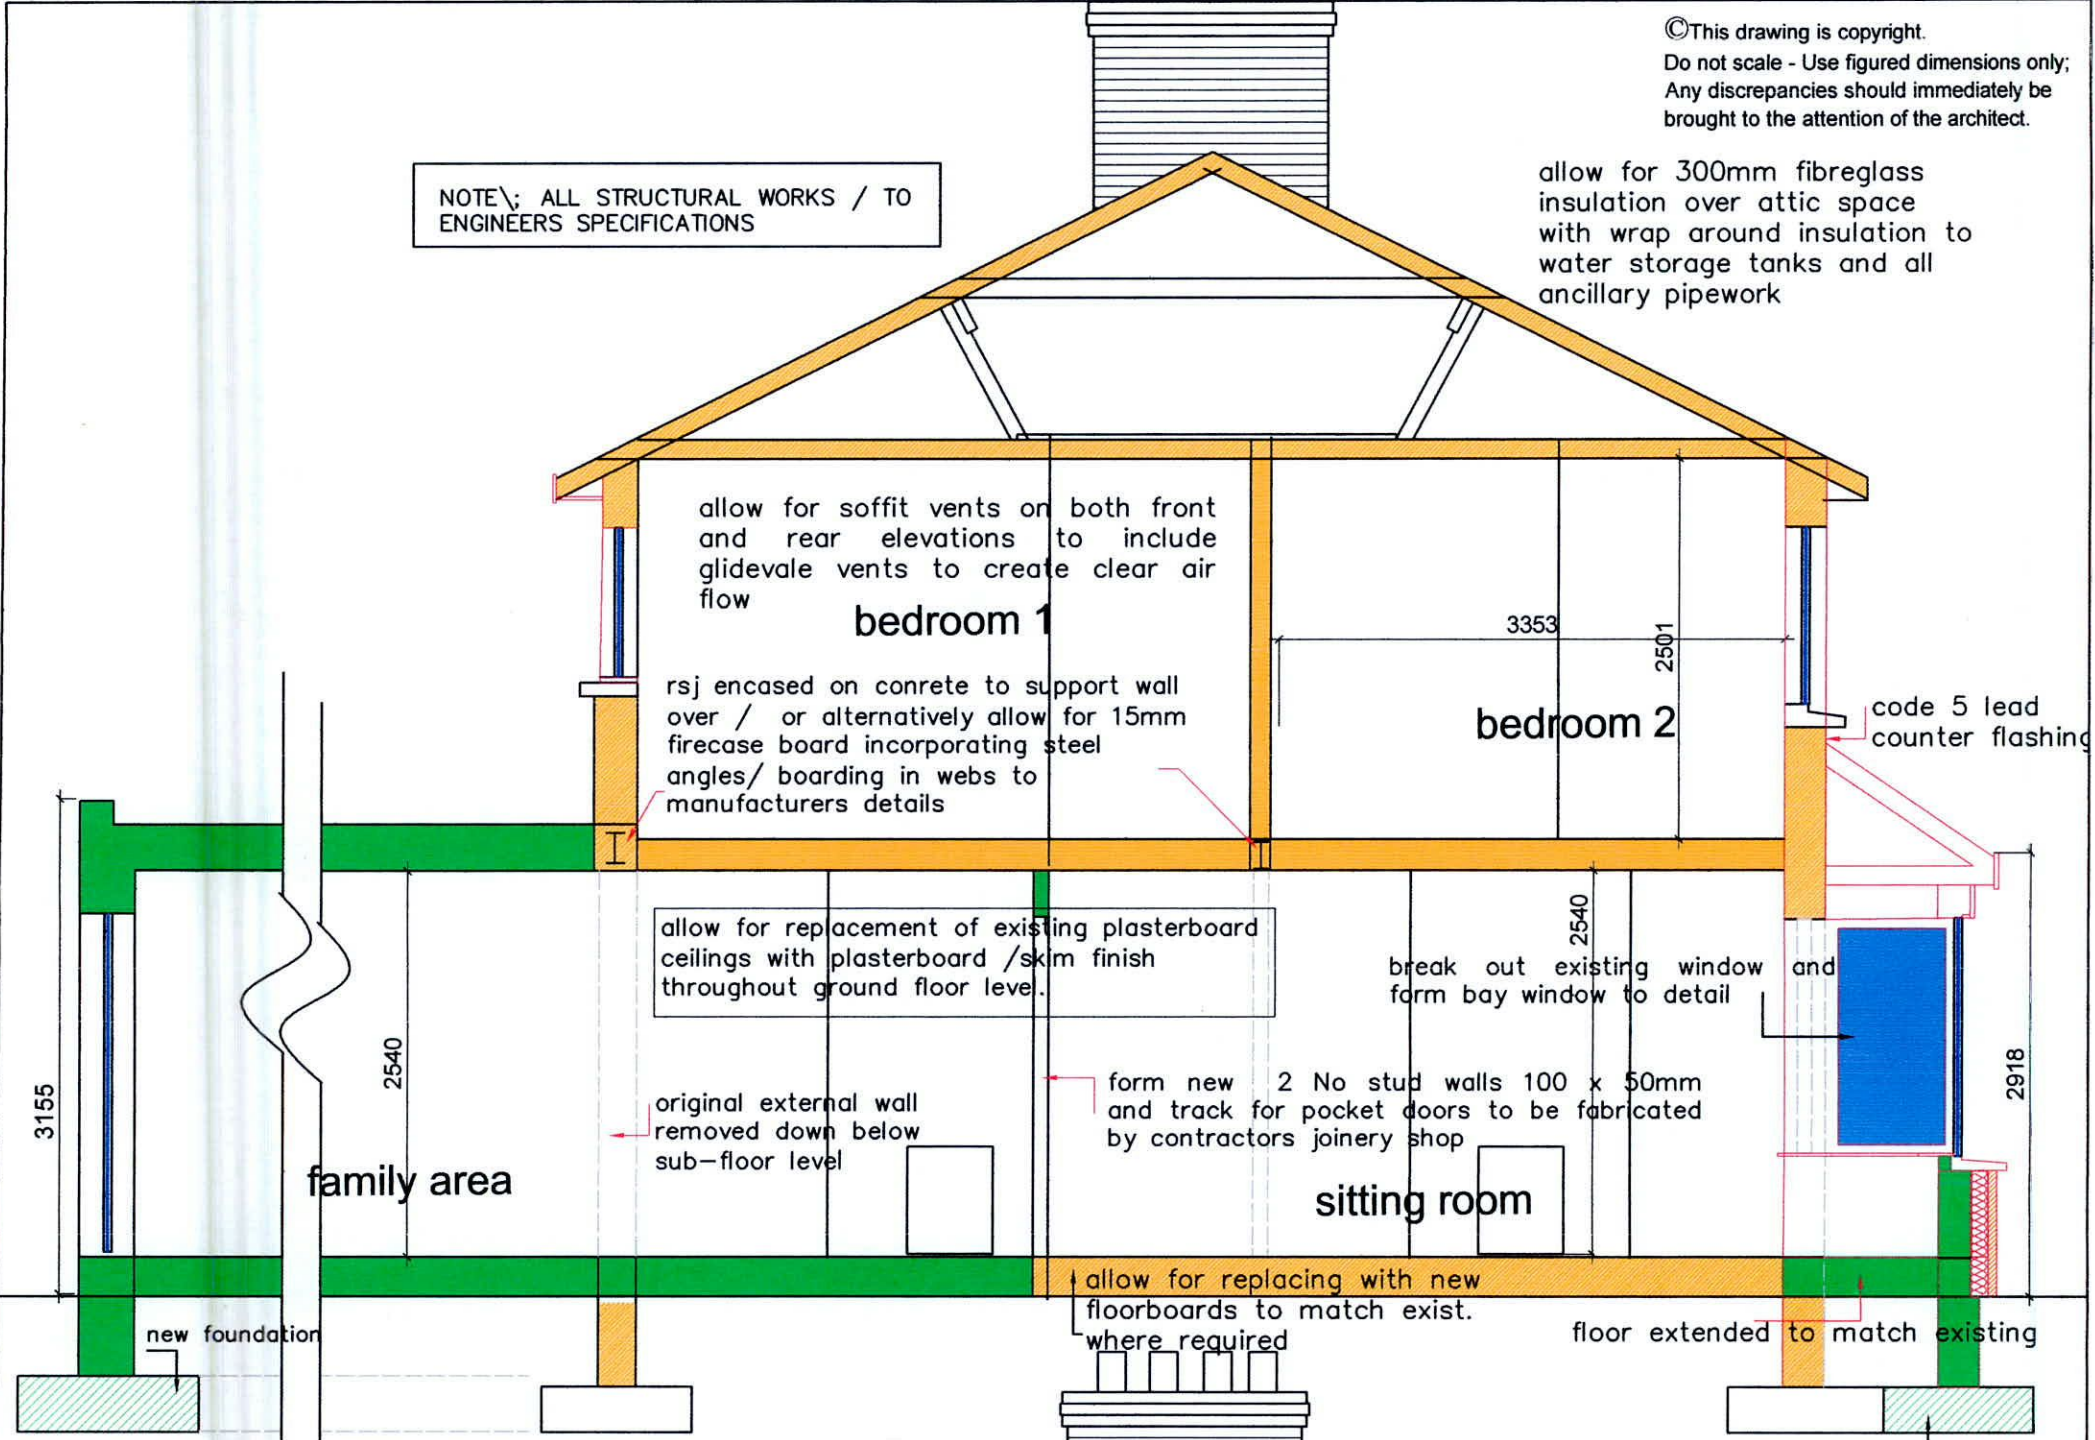

SECTION B-B 1:50 ORIGINAL APPLICATION

NOTE; ALL STRUCTURAL WORKS
/ TO ENGINEERS SPECIFICATIONS

allow for BER A1 standard insulation
over attic space with wrap around
insulation to water storage tanks
and all ancillary pipework

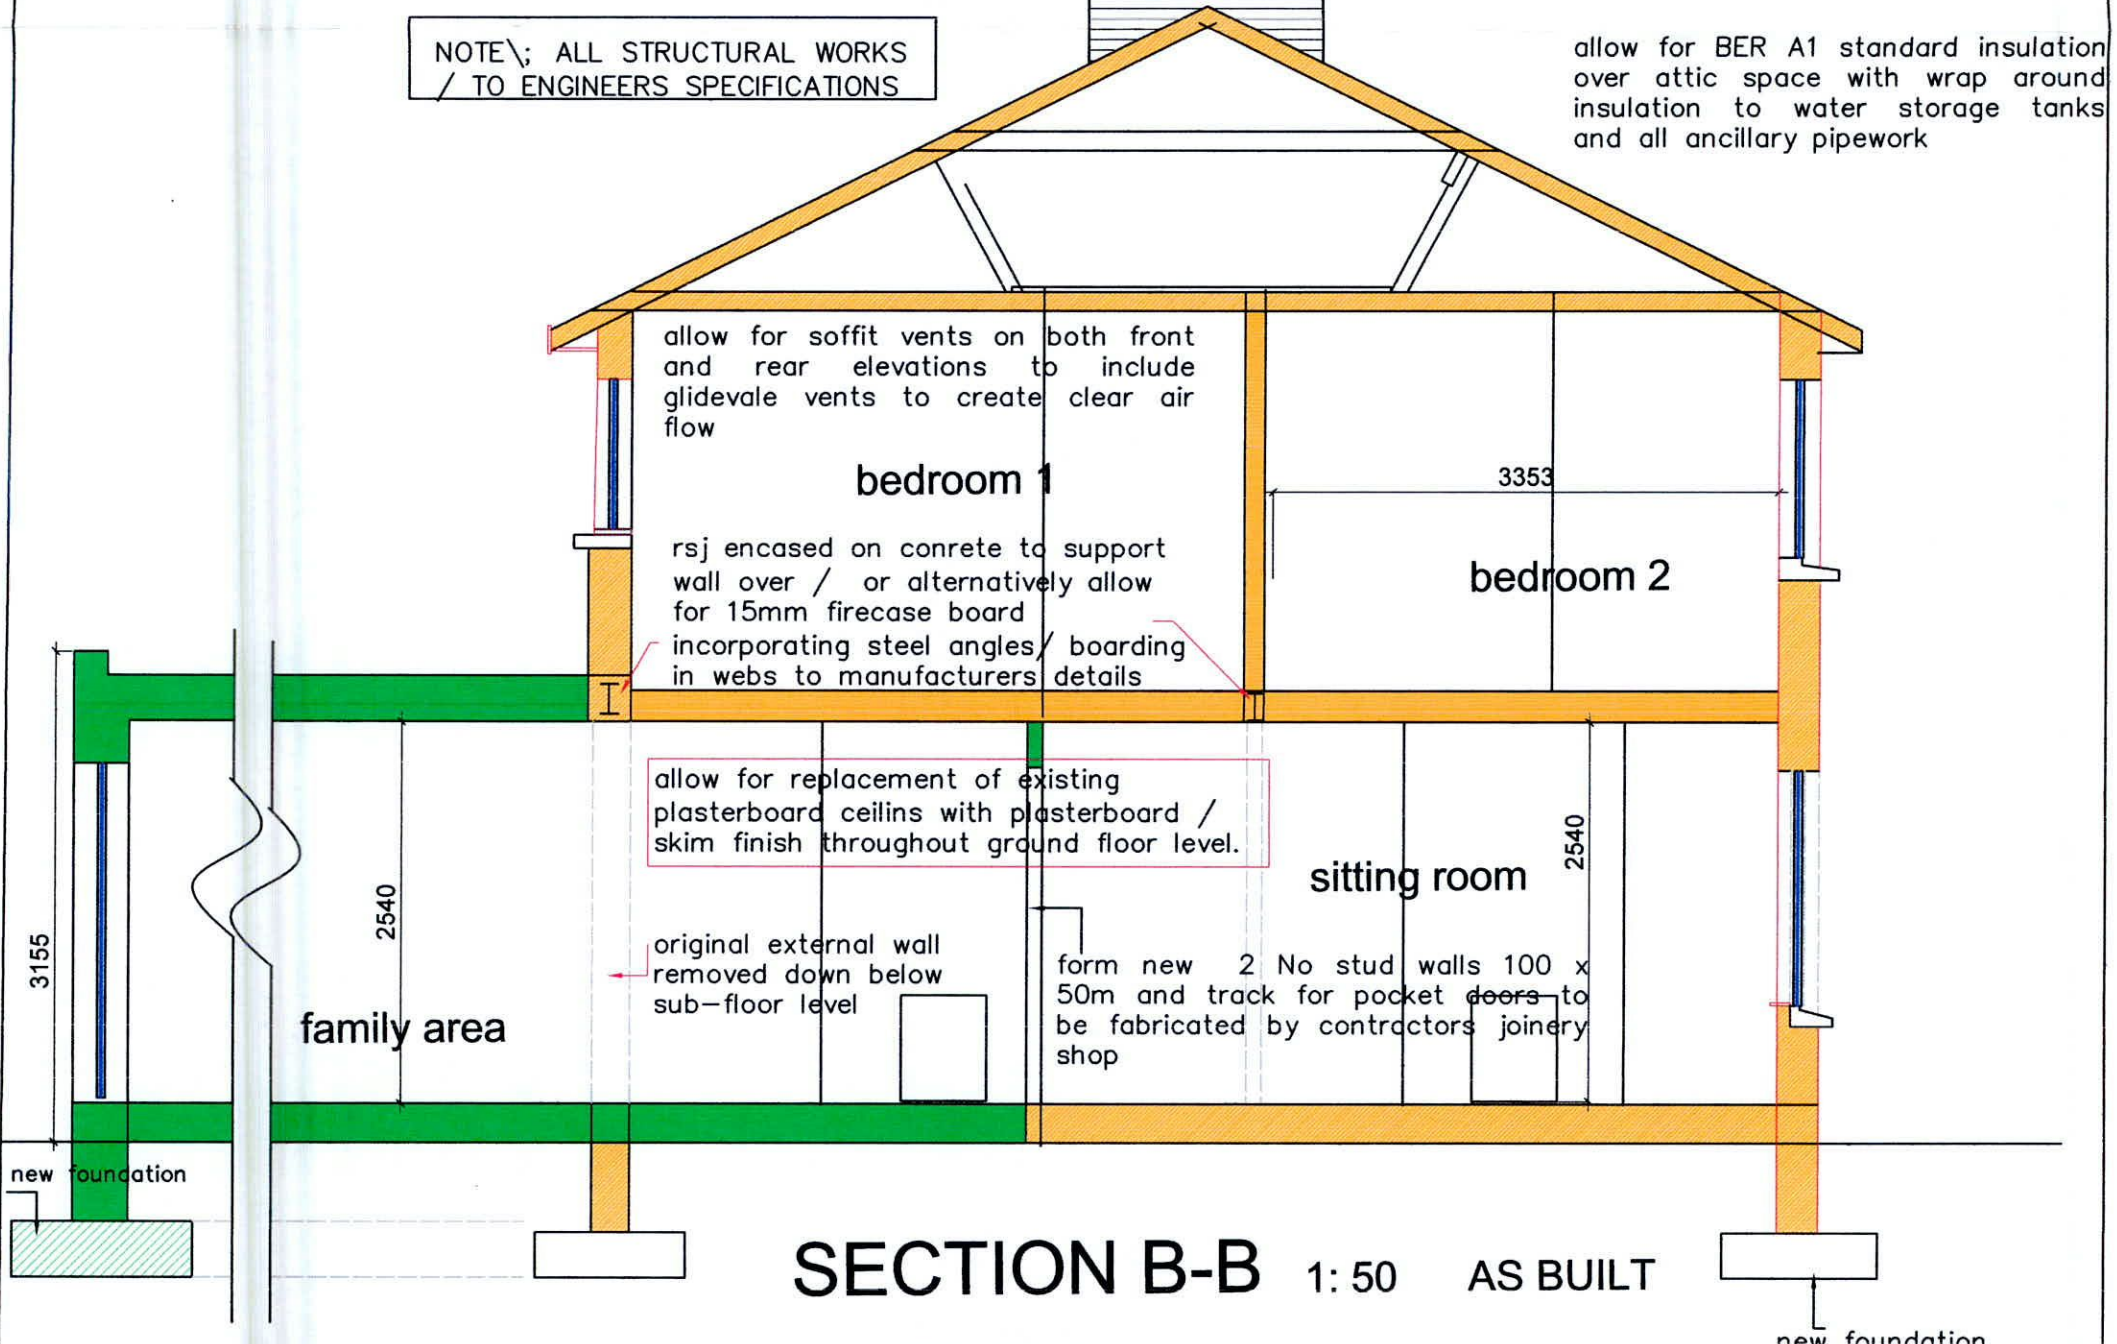

SECTION B-B 1:50 AS BUILT

DO NOT SCALE - USE FIGURED DIMENSIONS ONLY

REV.	DATE	DRAWN	DESCRIPTION

CORMAC MURPHY
S ASSOCIATES | ARCHITECTS

PROJECT: 76 DODDER PARK ROAD
RATHFARNHAM CO. DUBLIN
DRAWING: SECTION B-B
Original Application + As Built
cormac murphy + associates architects
ARCHITECTS - M.R.I.A.I T.01-8335734 M.0872847418

SCALE: 1:100
DATE: JULY 2022
JOB NO: CM.22.02
STATUS: PLANNING APPLICATION
DRAWN: A.F. CHECKED: C.M. PASSED:
DRAWING NO: 09 REVISION:
seaview studio, 162 hampton cove, skerries rd,
balbriggan, co.dublin cormacmurphy8@gmail.com