



©This drawing is copyright.
 Do not scale - Use figured dimensions only;
 Any discrepancies should immediately be
 brought to the attention of the architect.
 roof extended over first floor
 extension

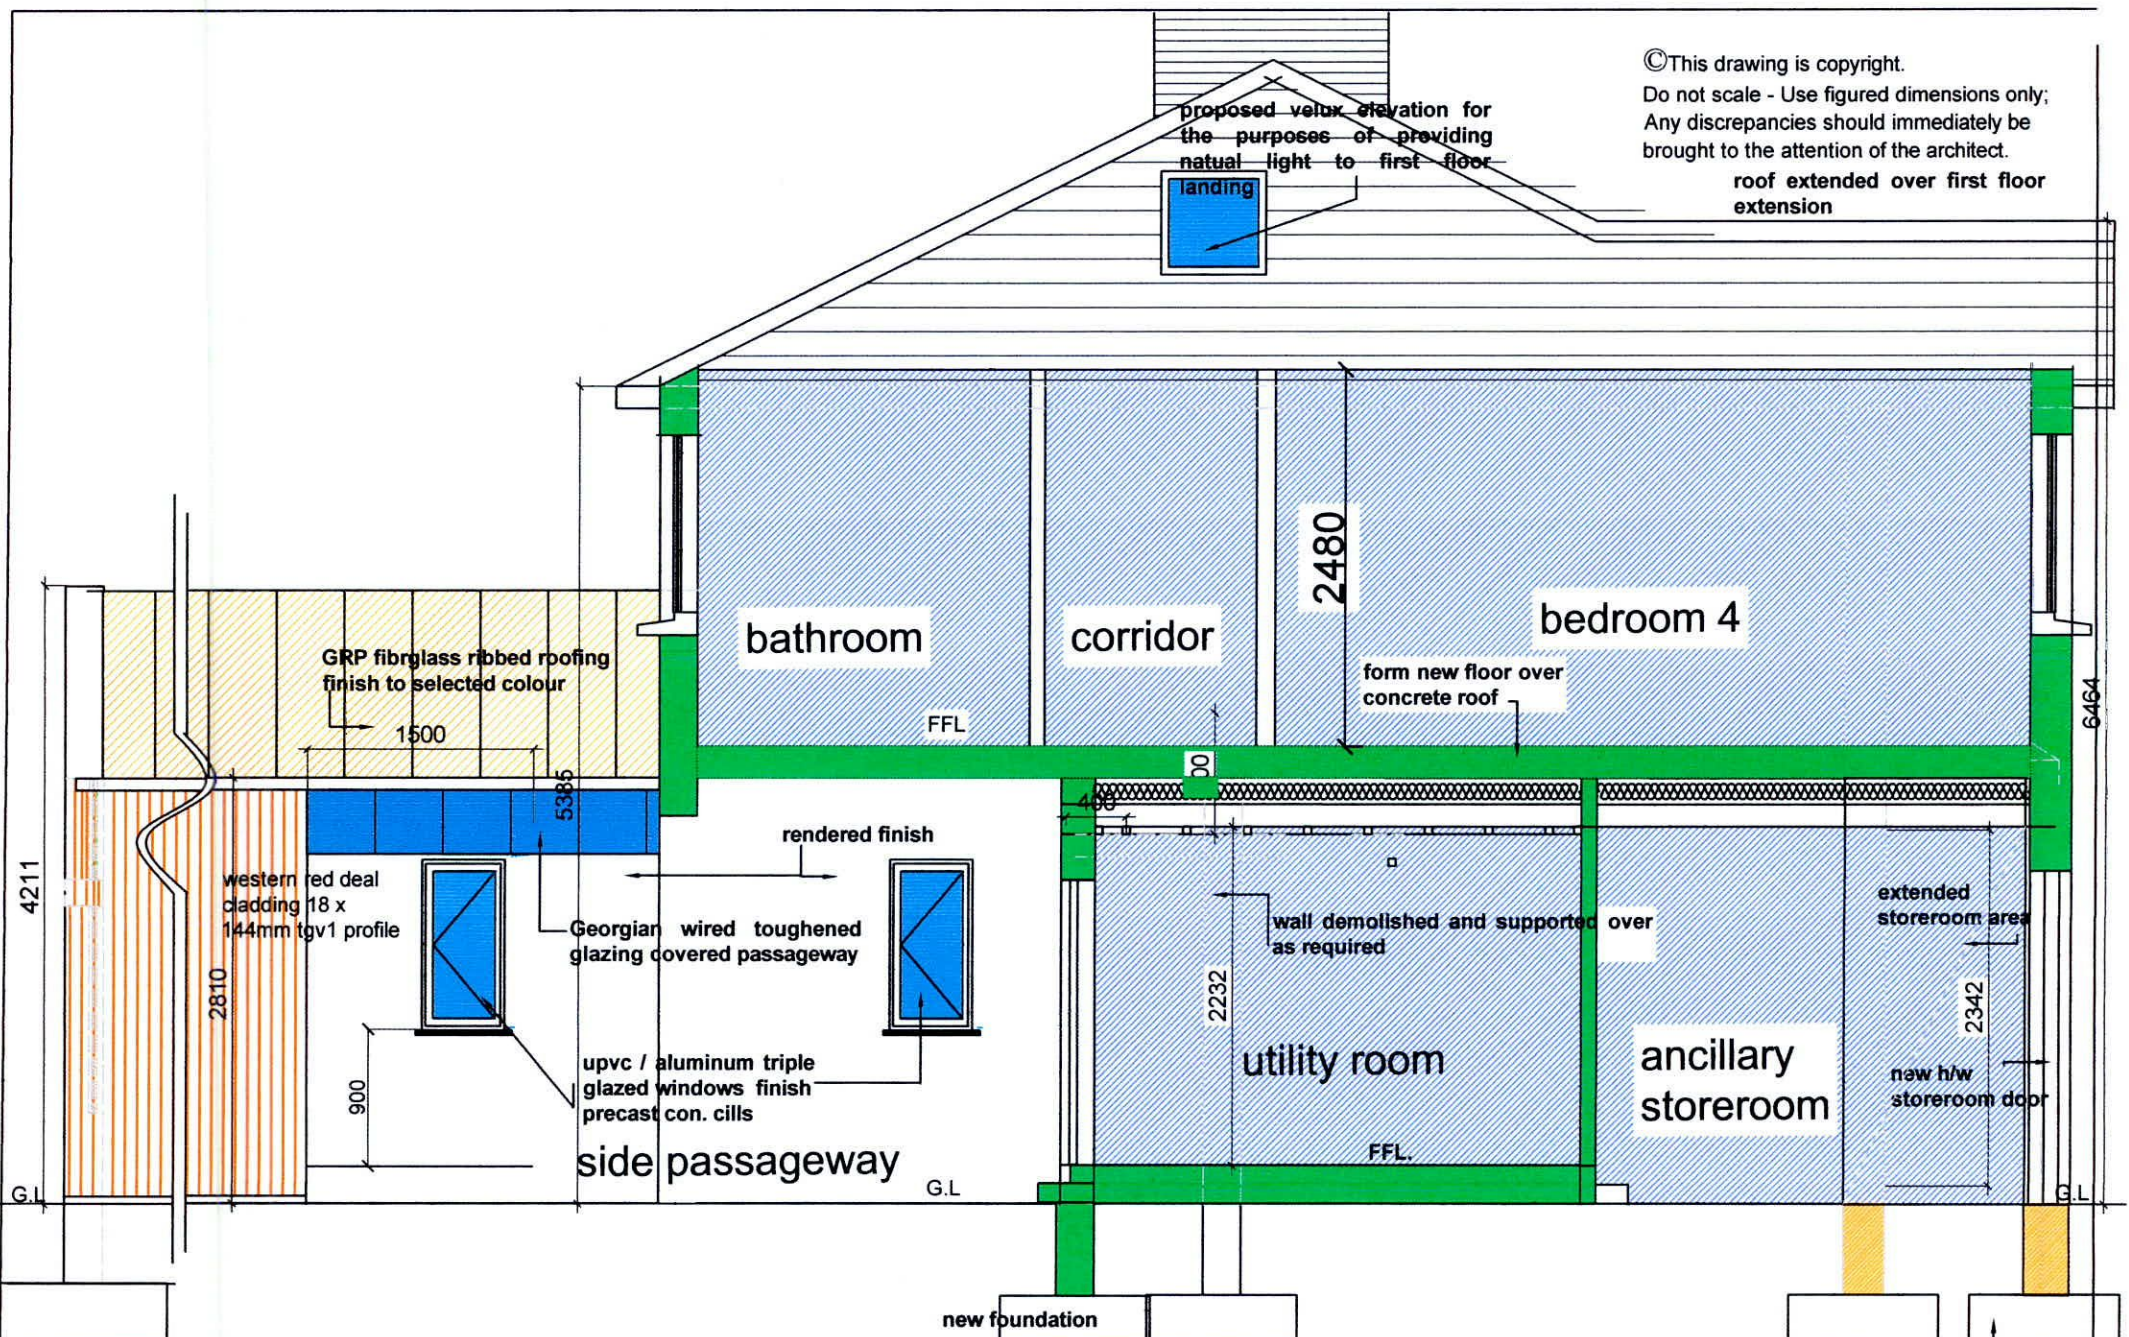

SECTION C-C 1: 50 ORIGINAL APPLICATION

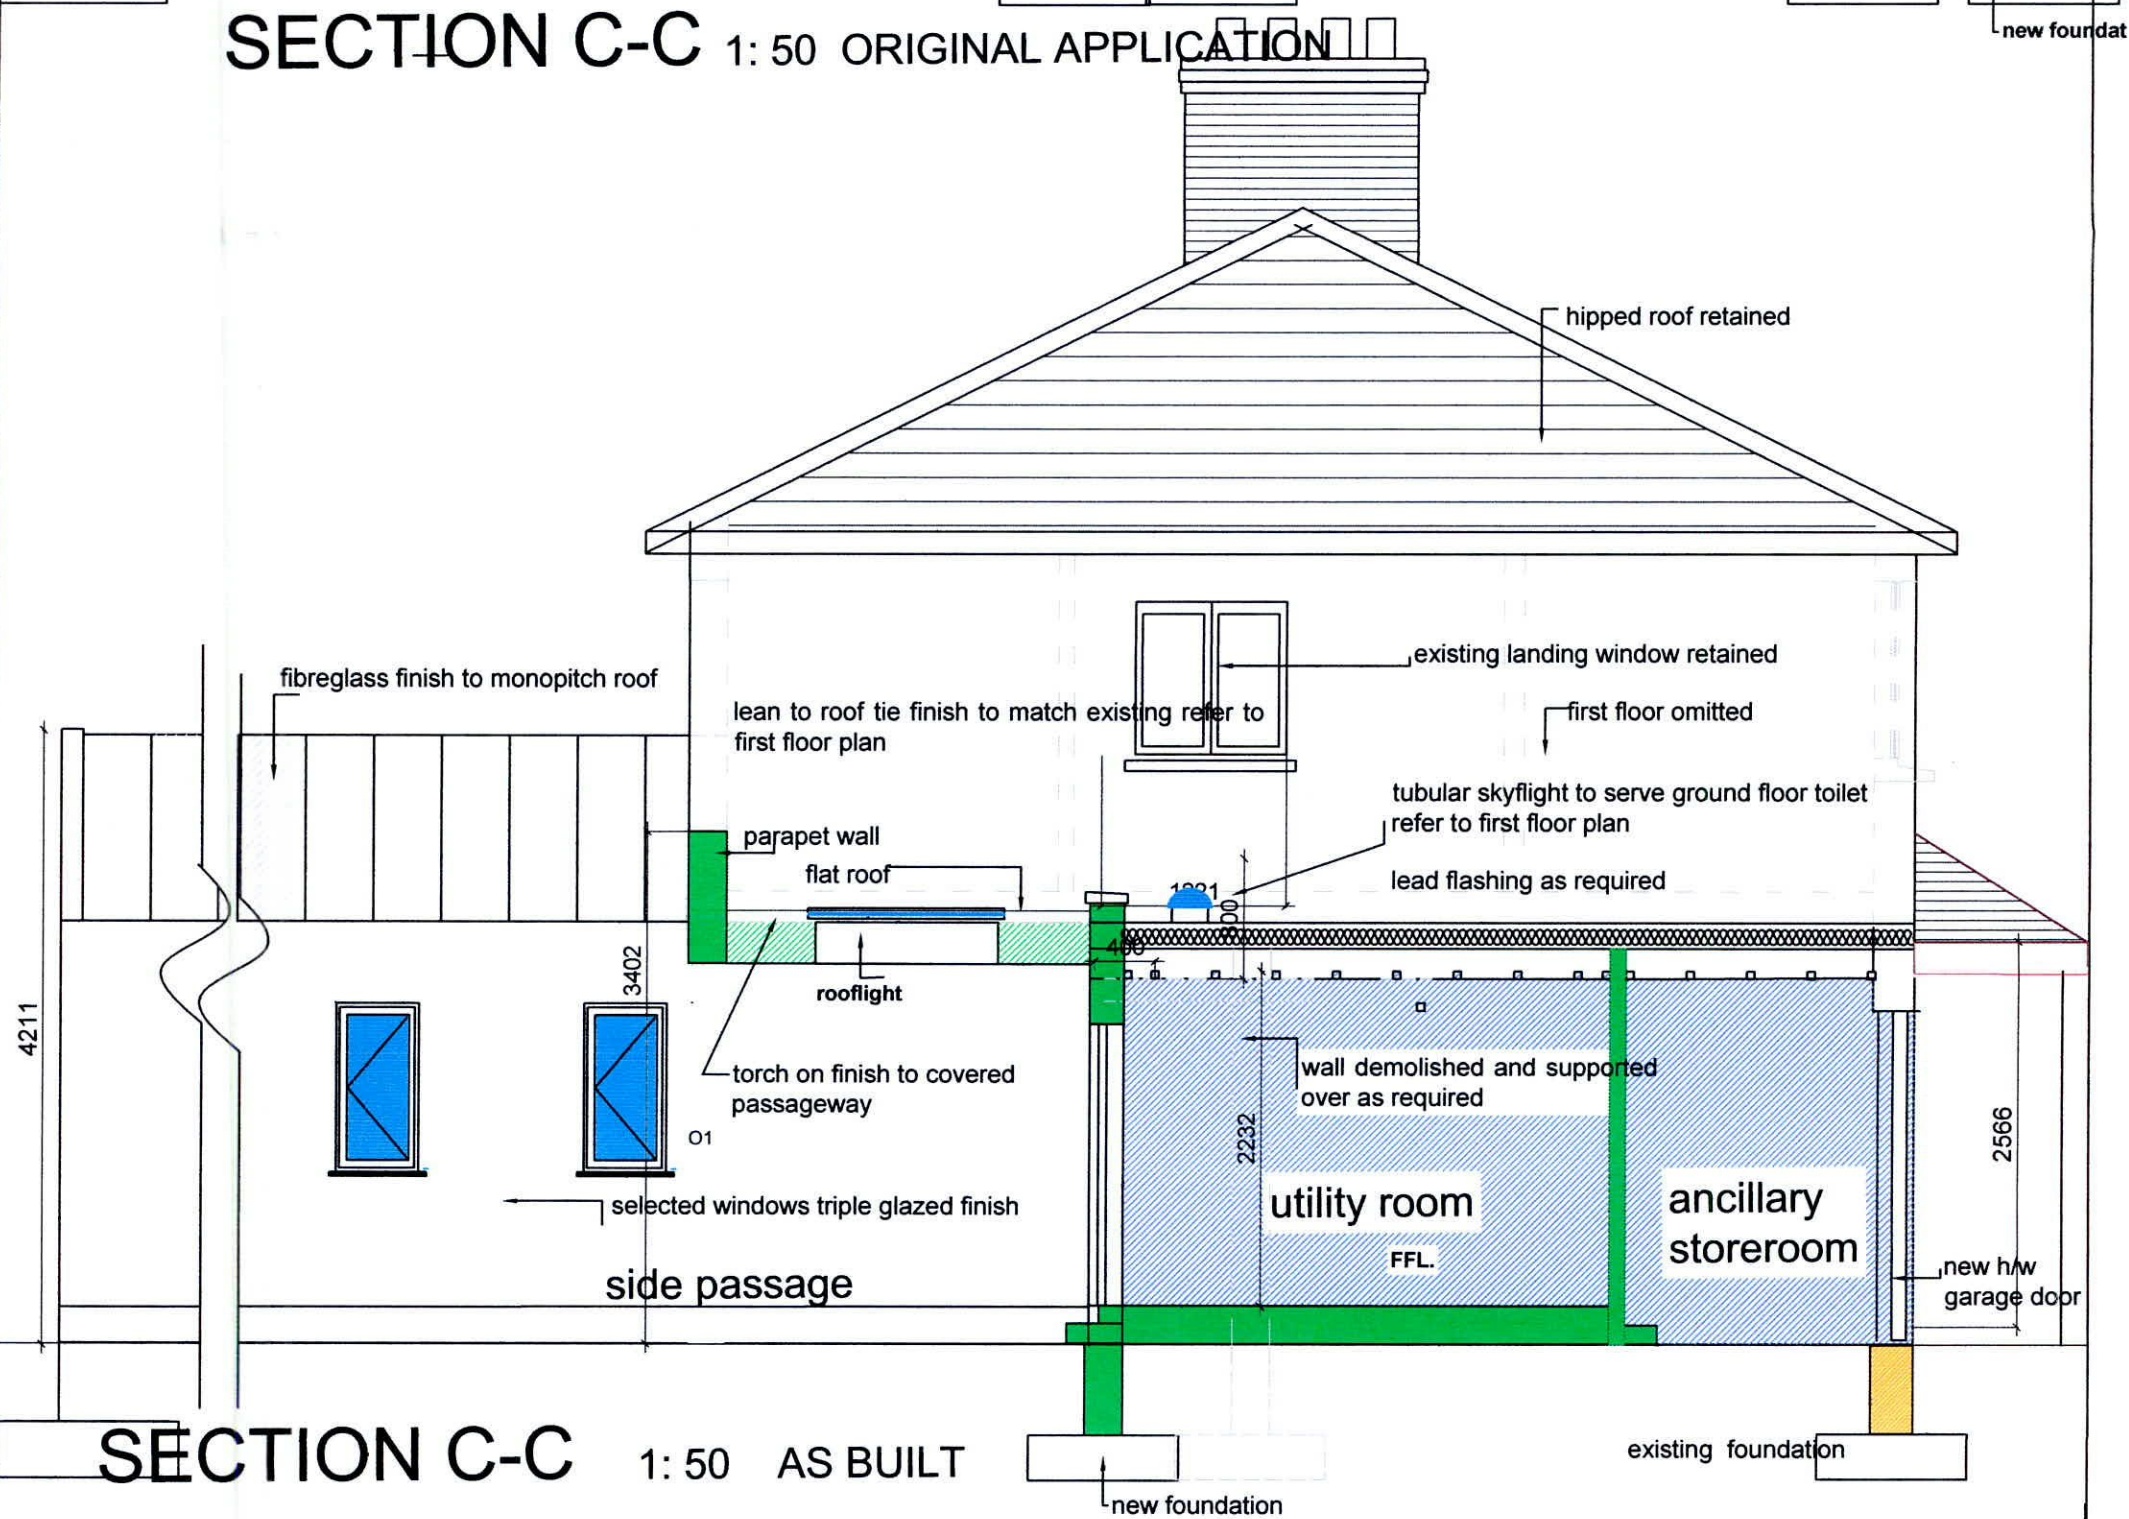

SECTION C-C 1: 50 AS BUILT

DO NOT SCALE - USE FIGURED DIMENSIONS ONLY

REV.	DATE	DRAWN	DESCRIPTION

CORMAC MURPHY
 & ASSOCIATES | ARCHITECTS

PROJECT: 76 DODDER PARK ROAD
 RATHFARNHAM. CO. DUBLIN

DRAWING: Section C-C
 Original Application + As Built

cormac murphy + associates architects
 ARCHITECTS - M.R.I.A.I T.01-8335734 M.0872847418

SCALE: 1:50

DATE: JULY 2022

JOB NO: CM.22.02

seaview studio, 162 hampton cove, skerries rd,
 balbriggan, co.dublin cormacmurphy8@gmail.com

STATUS: PLANNING APPLICATION

DRAWN: A.F. CHECKED: C.M. PASSED:

DRAWING NO: 10 REVISION: