


existing woods on hill at rear of site

existing boundary wall

©This drawing is copyright.  
Do not scale - Use figured dimensions only;  
Any discrepancies should immediately be brought to the attention of the architect.

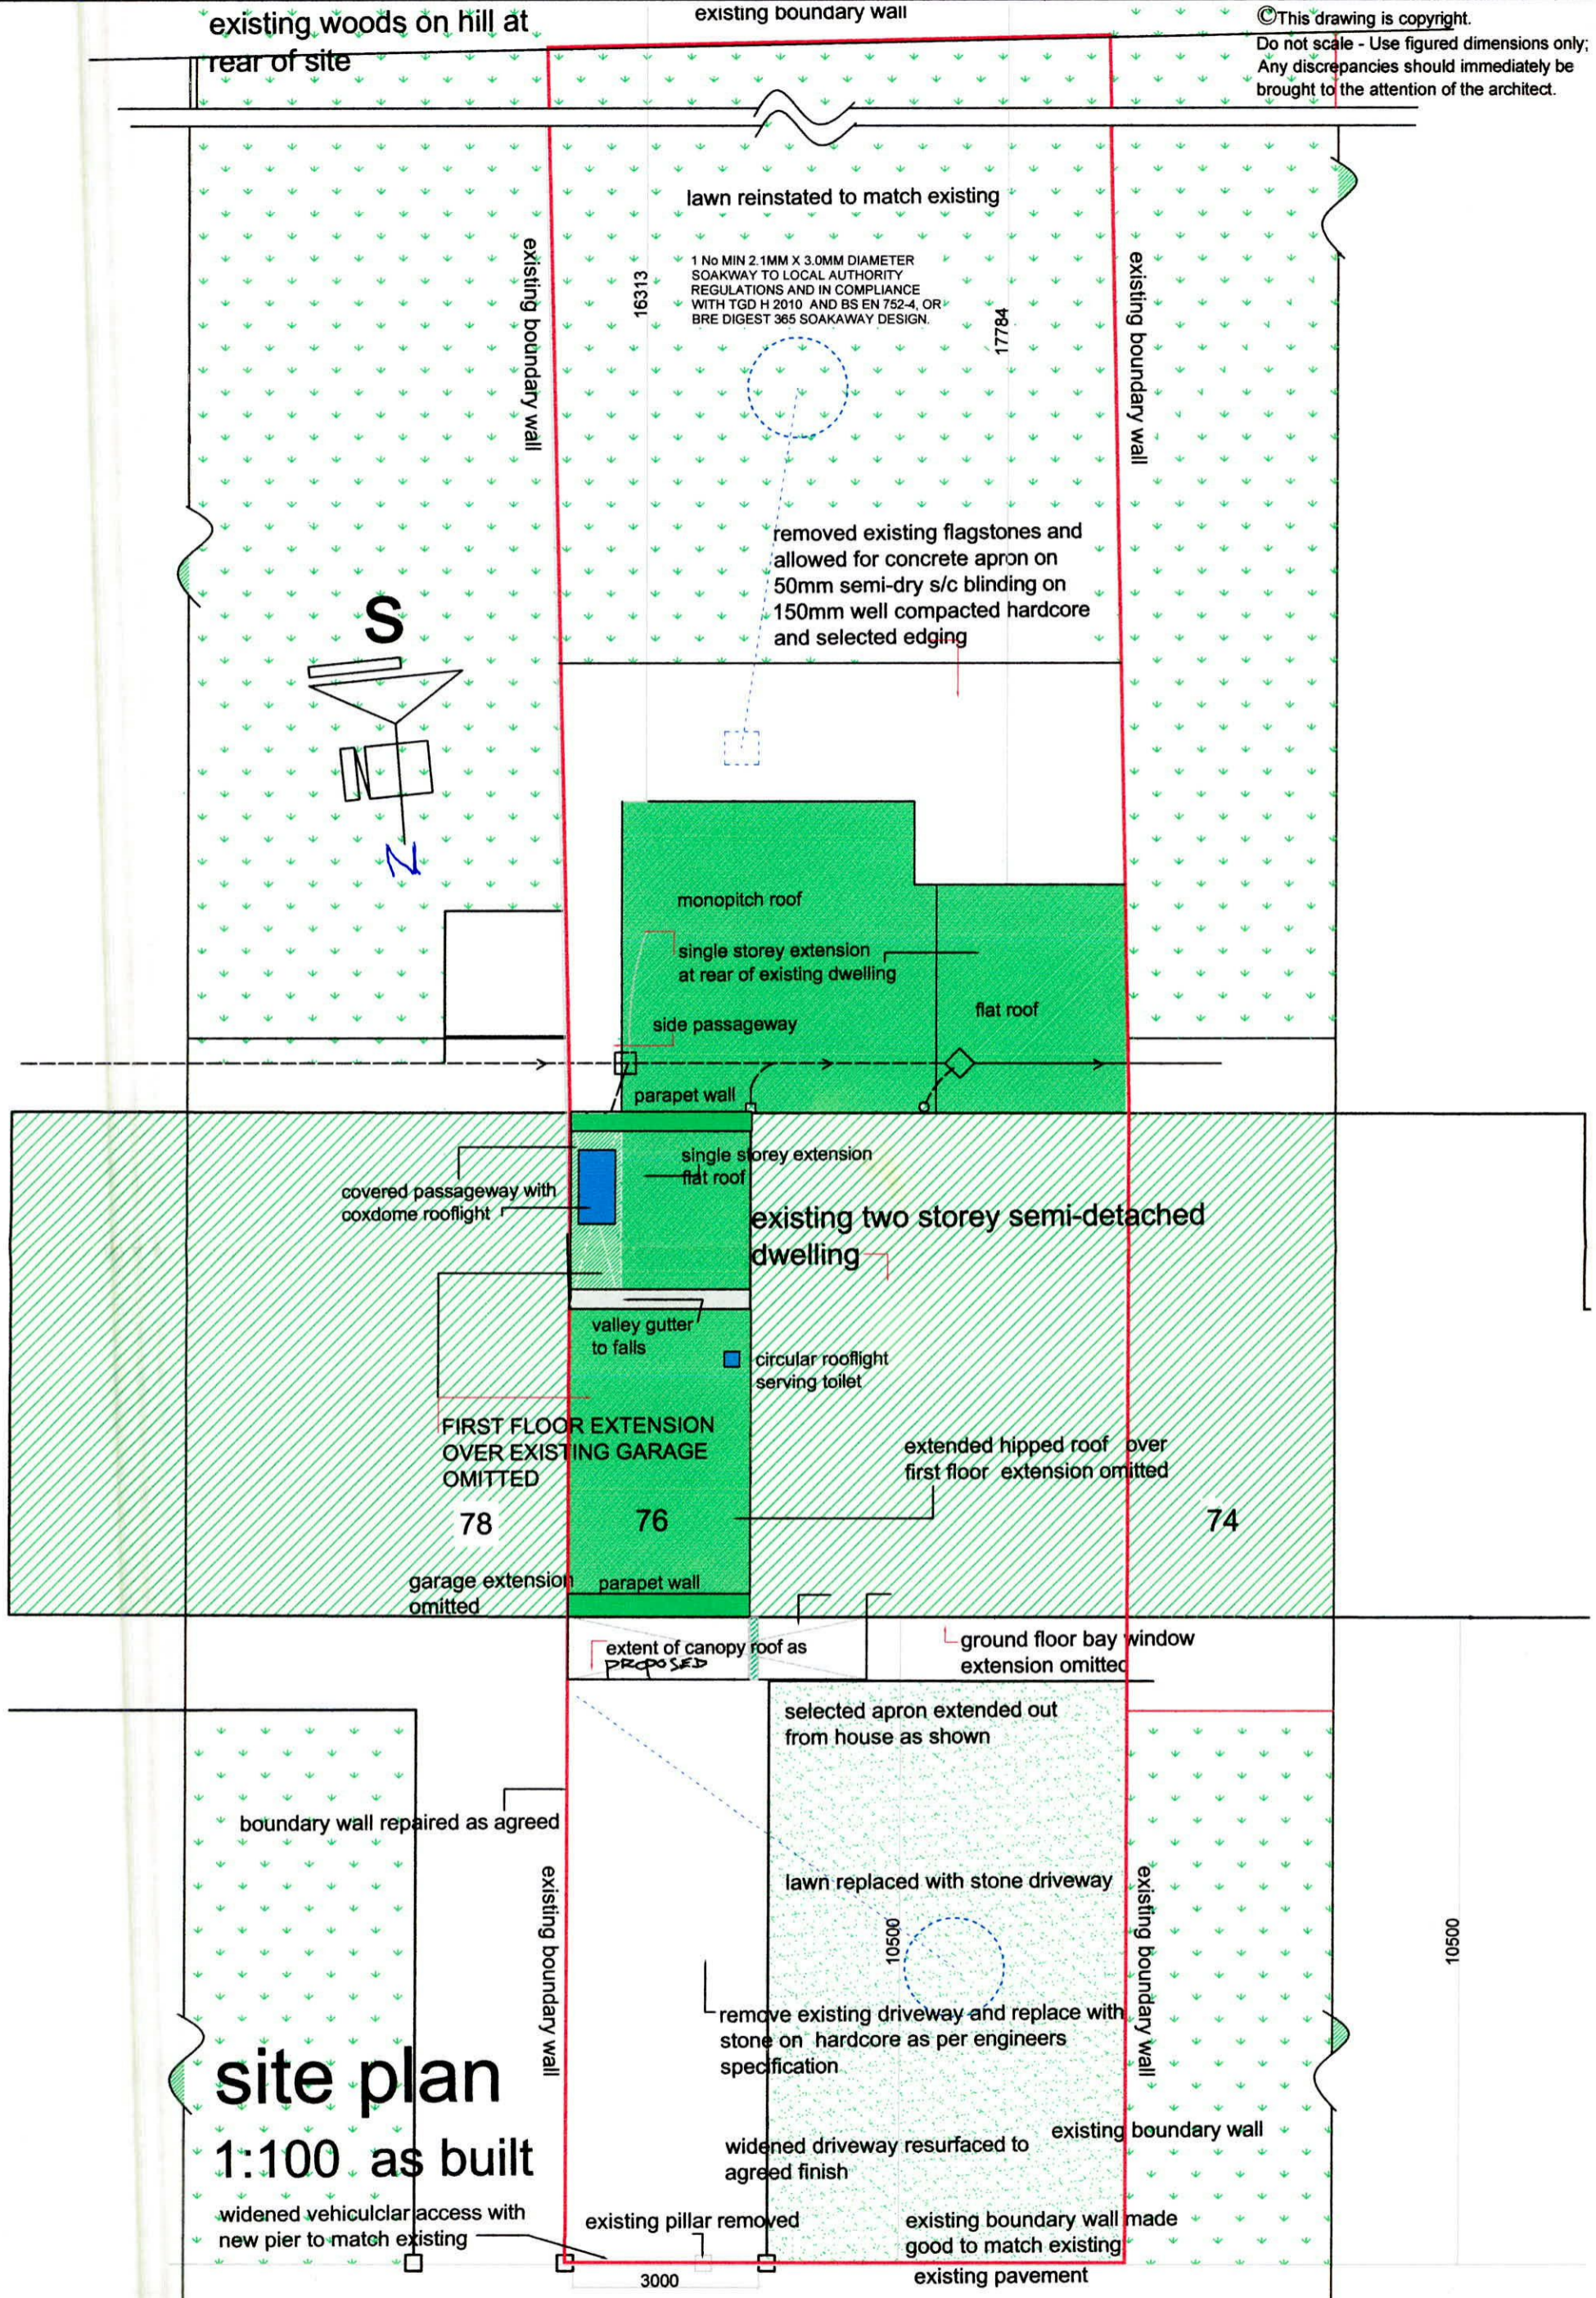

**site plan**  
1:100 as built

DO NOT SCALE - USE FIGURED DIMENSIONS ONLY

| REV. | DATE | DRAWN | DESCRIPTION |
|------|------|-------|-------------|
|      |      |       |             |
|      |      |       |             |
**CORMAC MURPHY & ASSOCIATES ARCHITECTS**

PROJECT: 76 DODDER PARK ROAD RATHFARNHAM . CO. DUBLIN

DRAWING: SITE PLAN As Built

cormac murphy + associates architects ARCHITECTS - M.R.I.A.I T.01-8335734 M.0872847418

|  |                                   |
|--|-----------------------------------|
| SCALE: 1:100   | STATUS: PLANNING APPLICATION      |
| DATE: JULY, 2022   | DRAWN: A.F. CHECKED: C.M. PASSED: |
| JOB NO: CM.22.02   | DRAWING NO: 03 REVISION:          |
| seaview studio, 162 hampton cove, skerries rd, balbriggan, co.dublin cormacmurphy8@gmail.com |                                   |