



1 SITE BLOCK PLAN
SCALE 1:500




3 EXISTING "AS BUILT" ELEVATIONS AND SECTIONS
SCALE 1:100

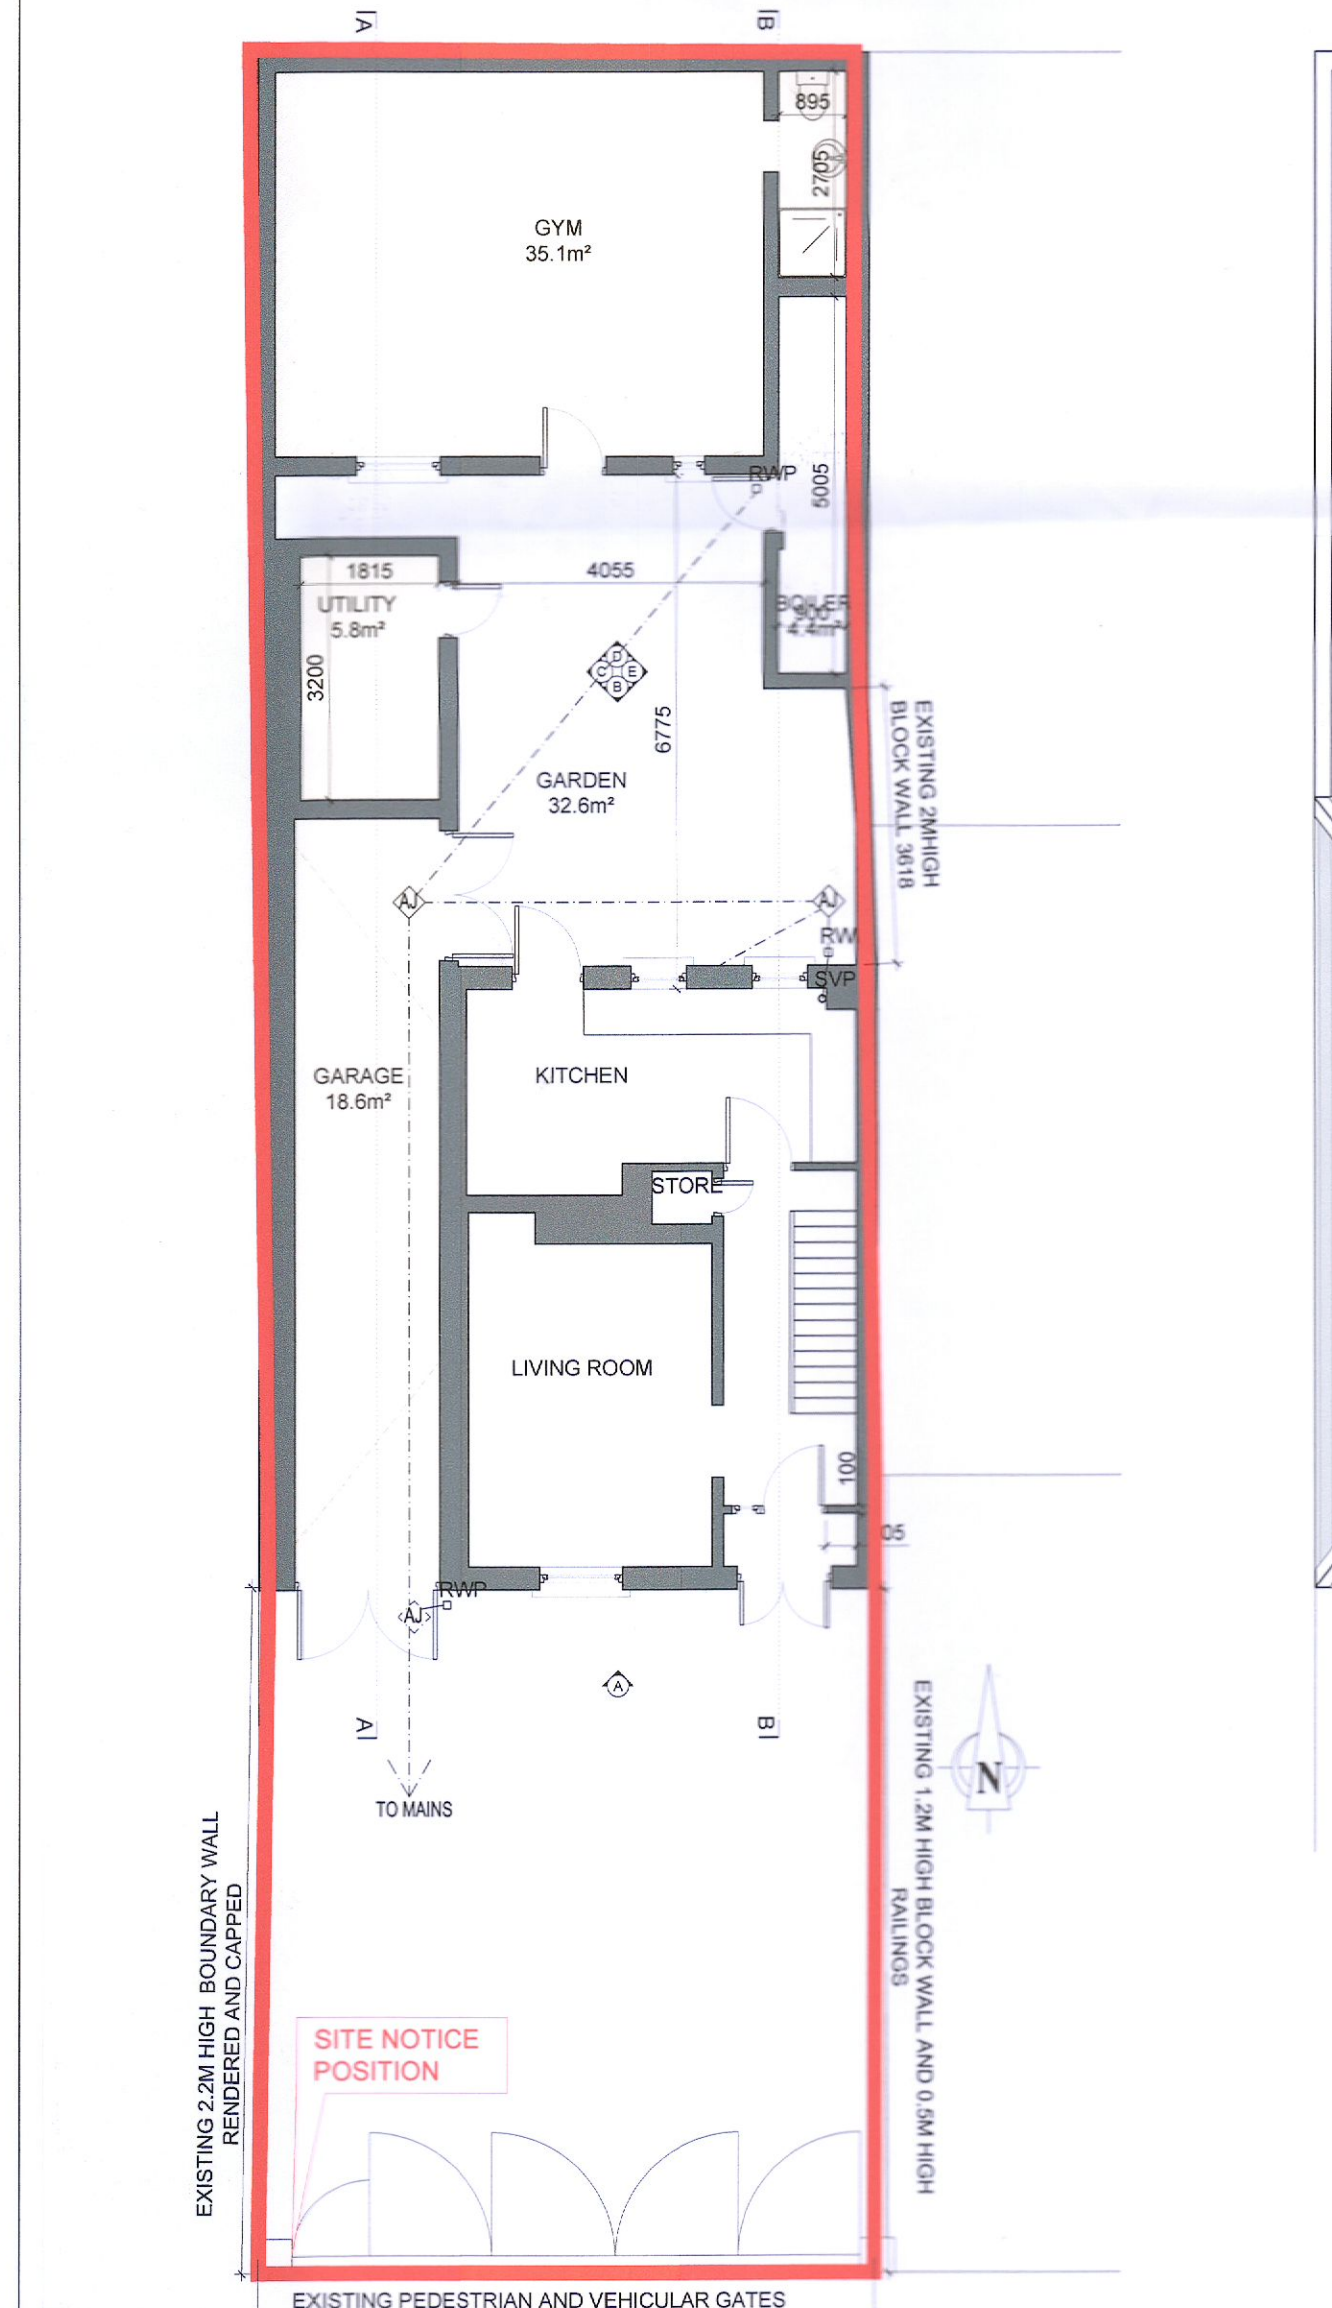

2 EXISTING "AS BUILT" FLOOR PLANS
SCALE 1:100

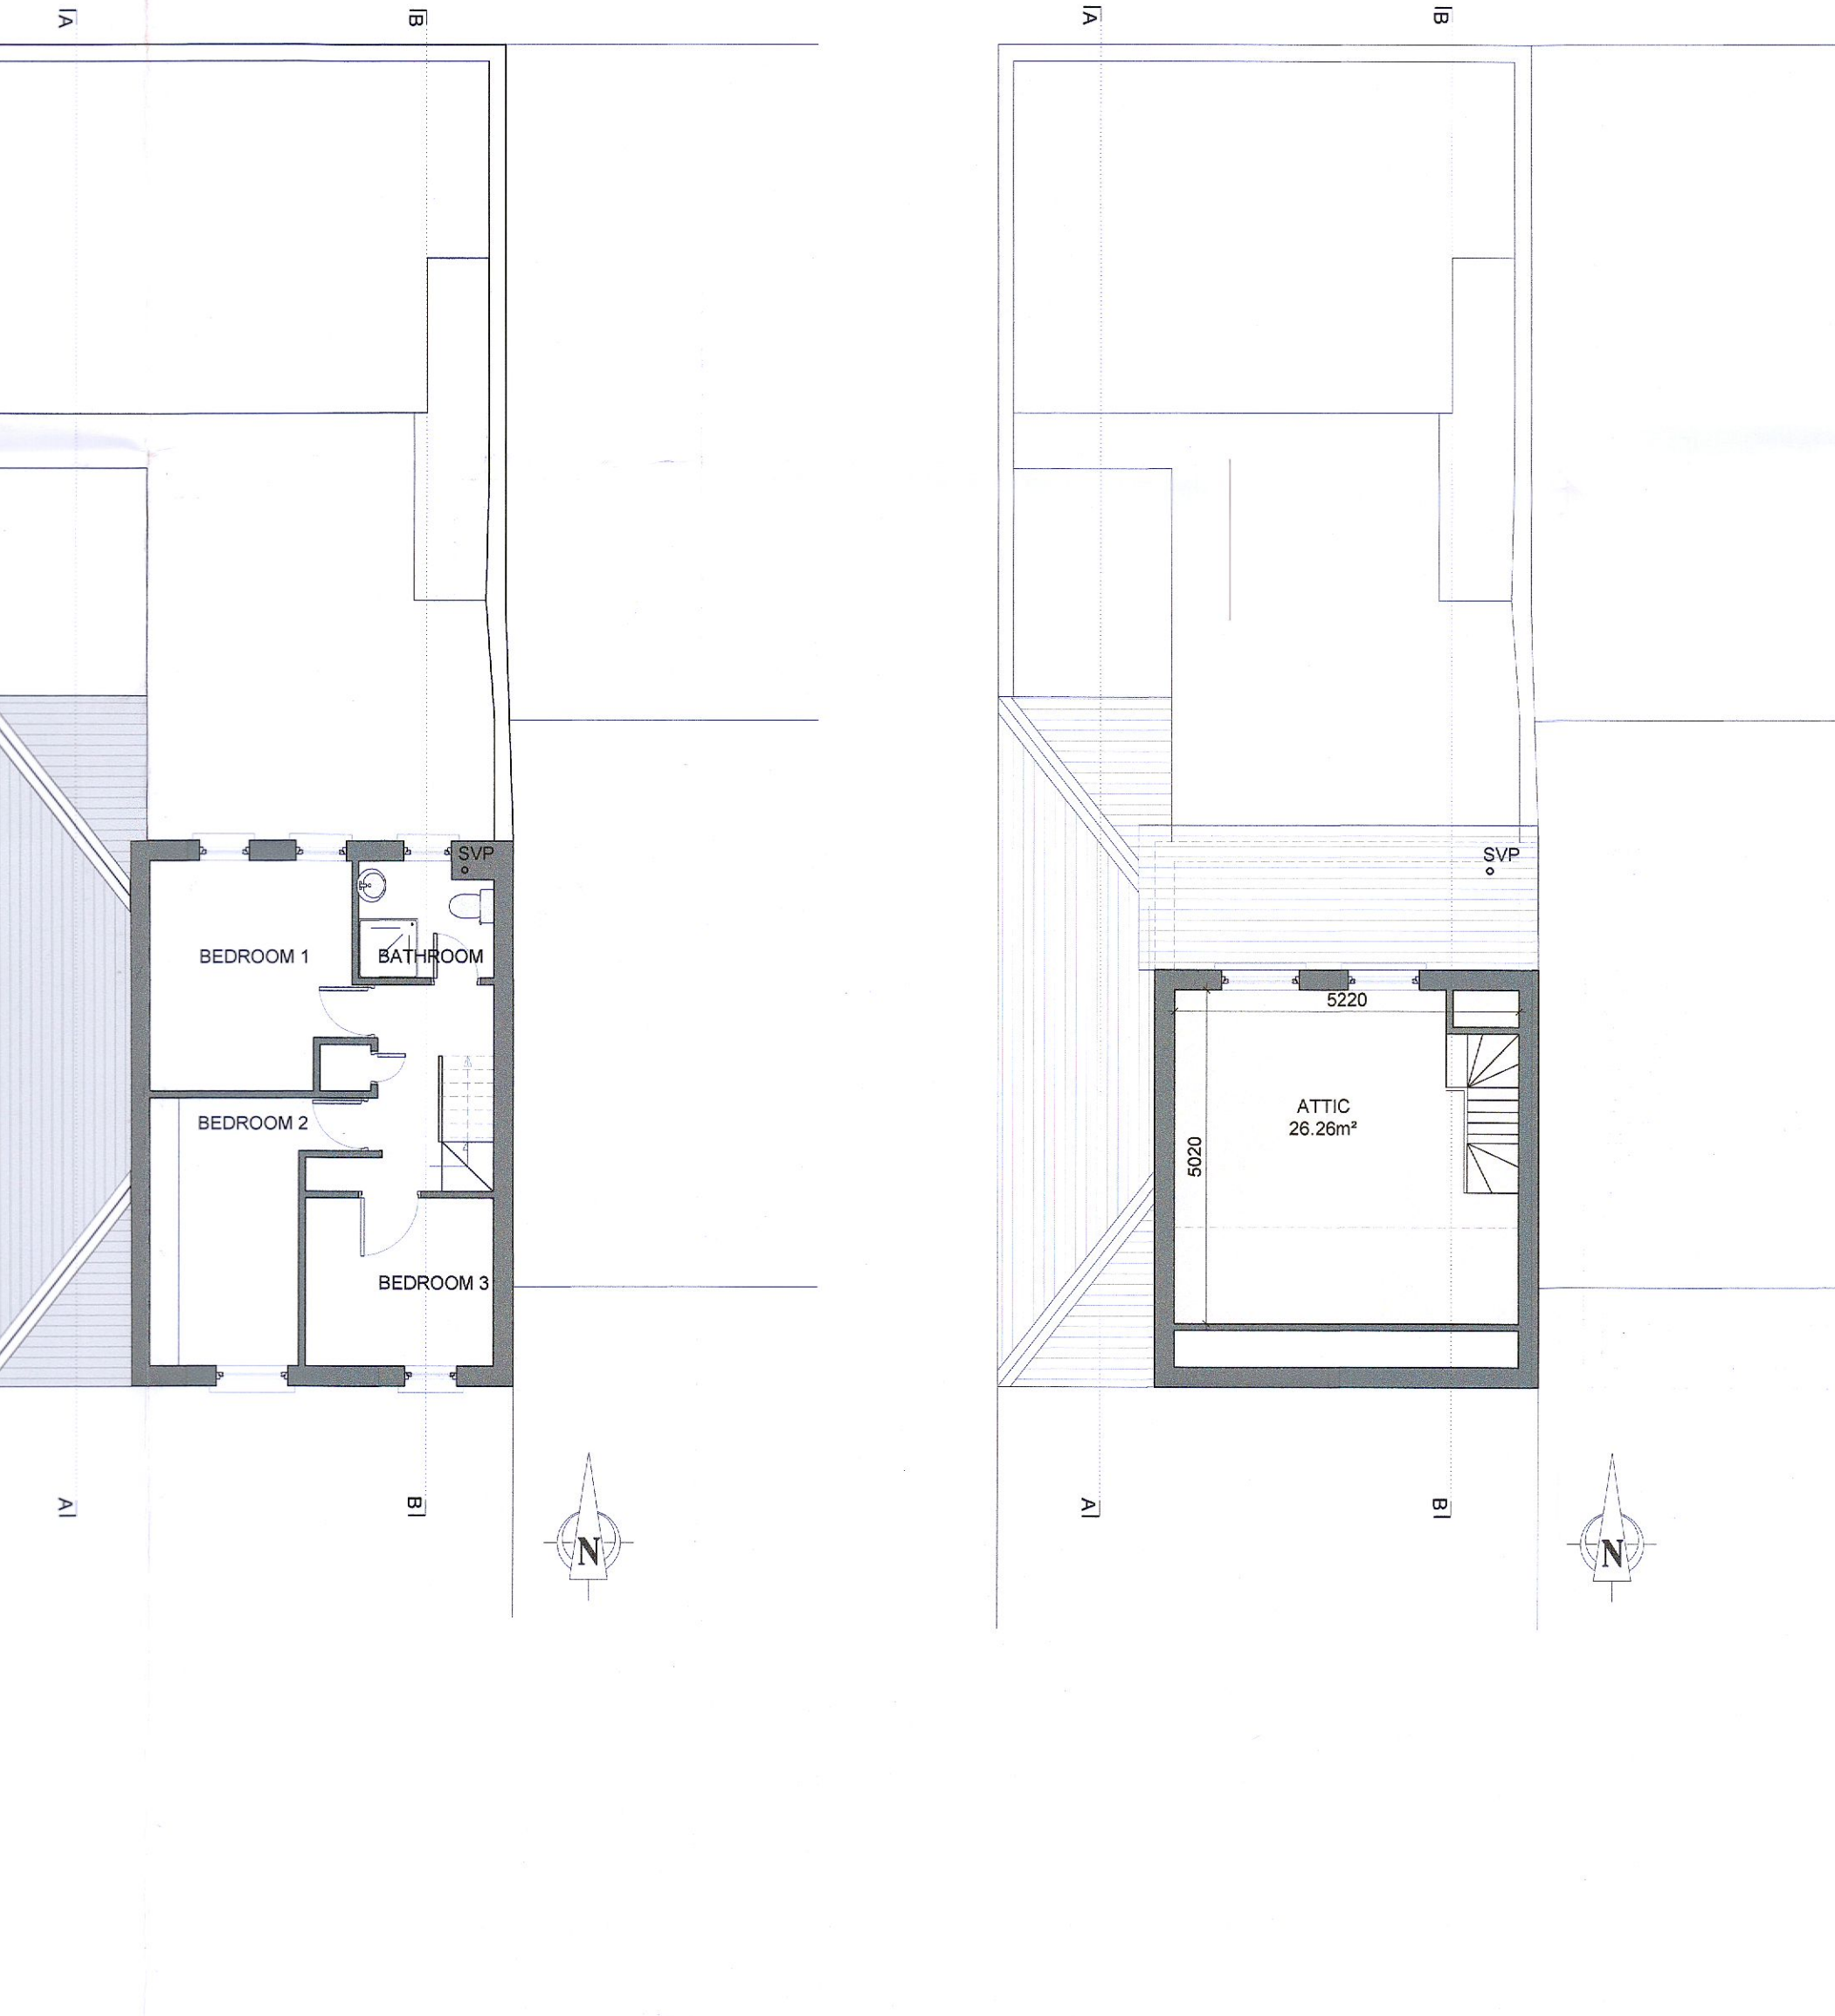

3 EXISTING "AS BUILT" FLOOR PLANS
SCALE 1:100

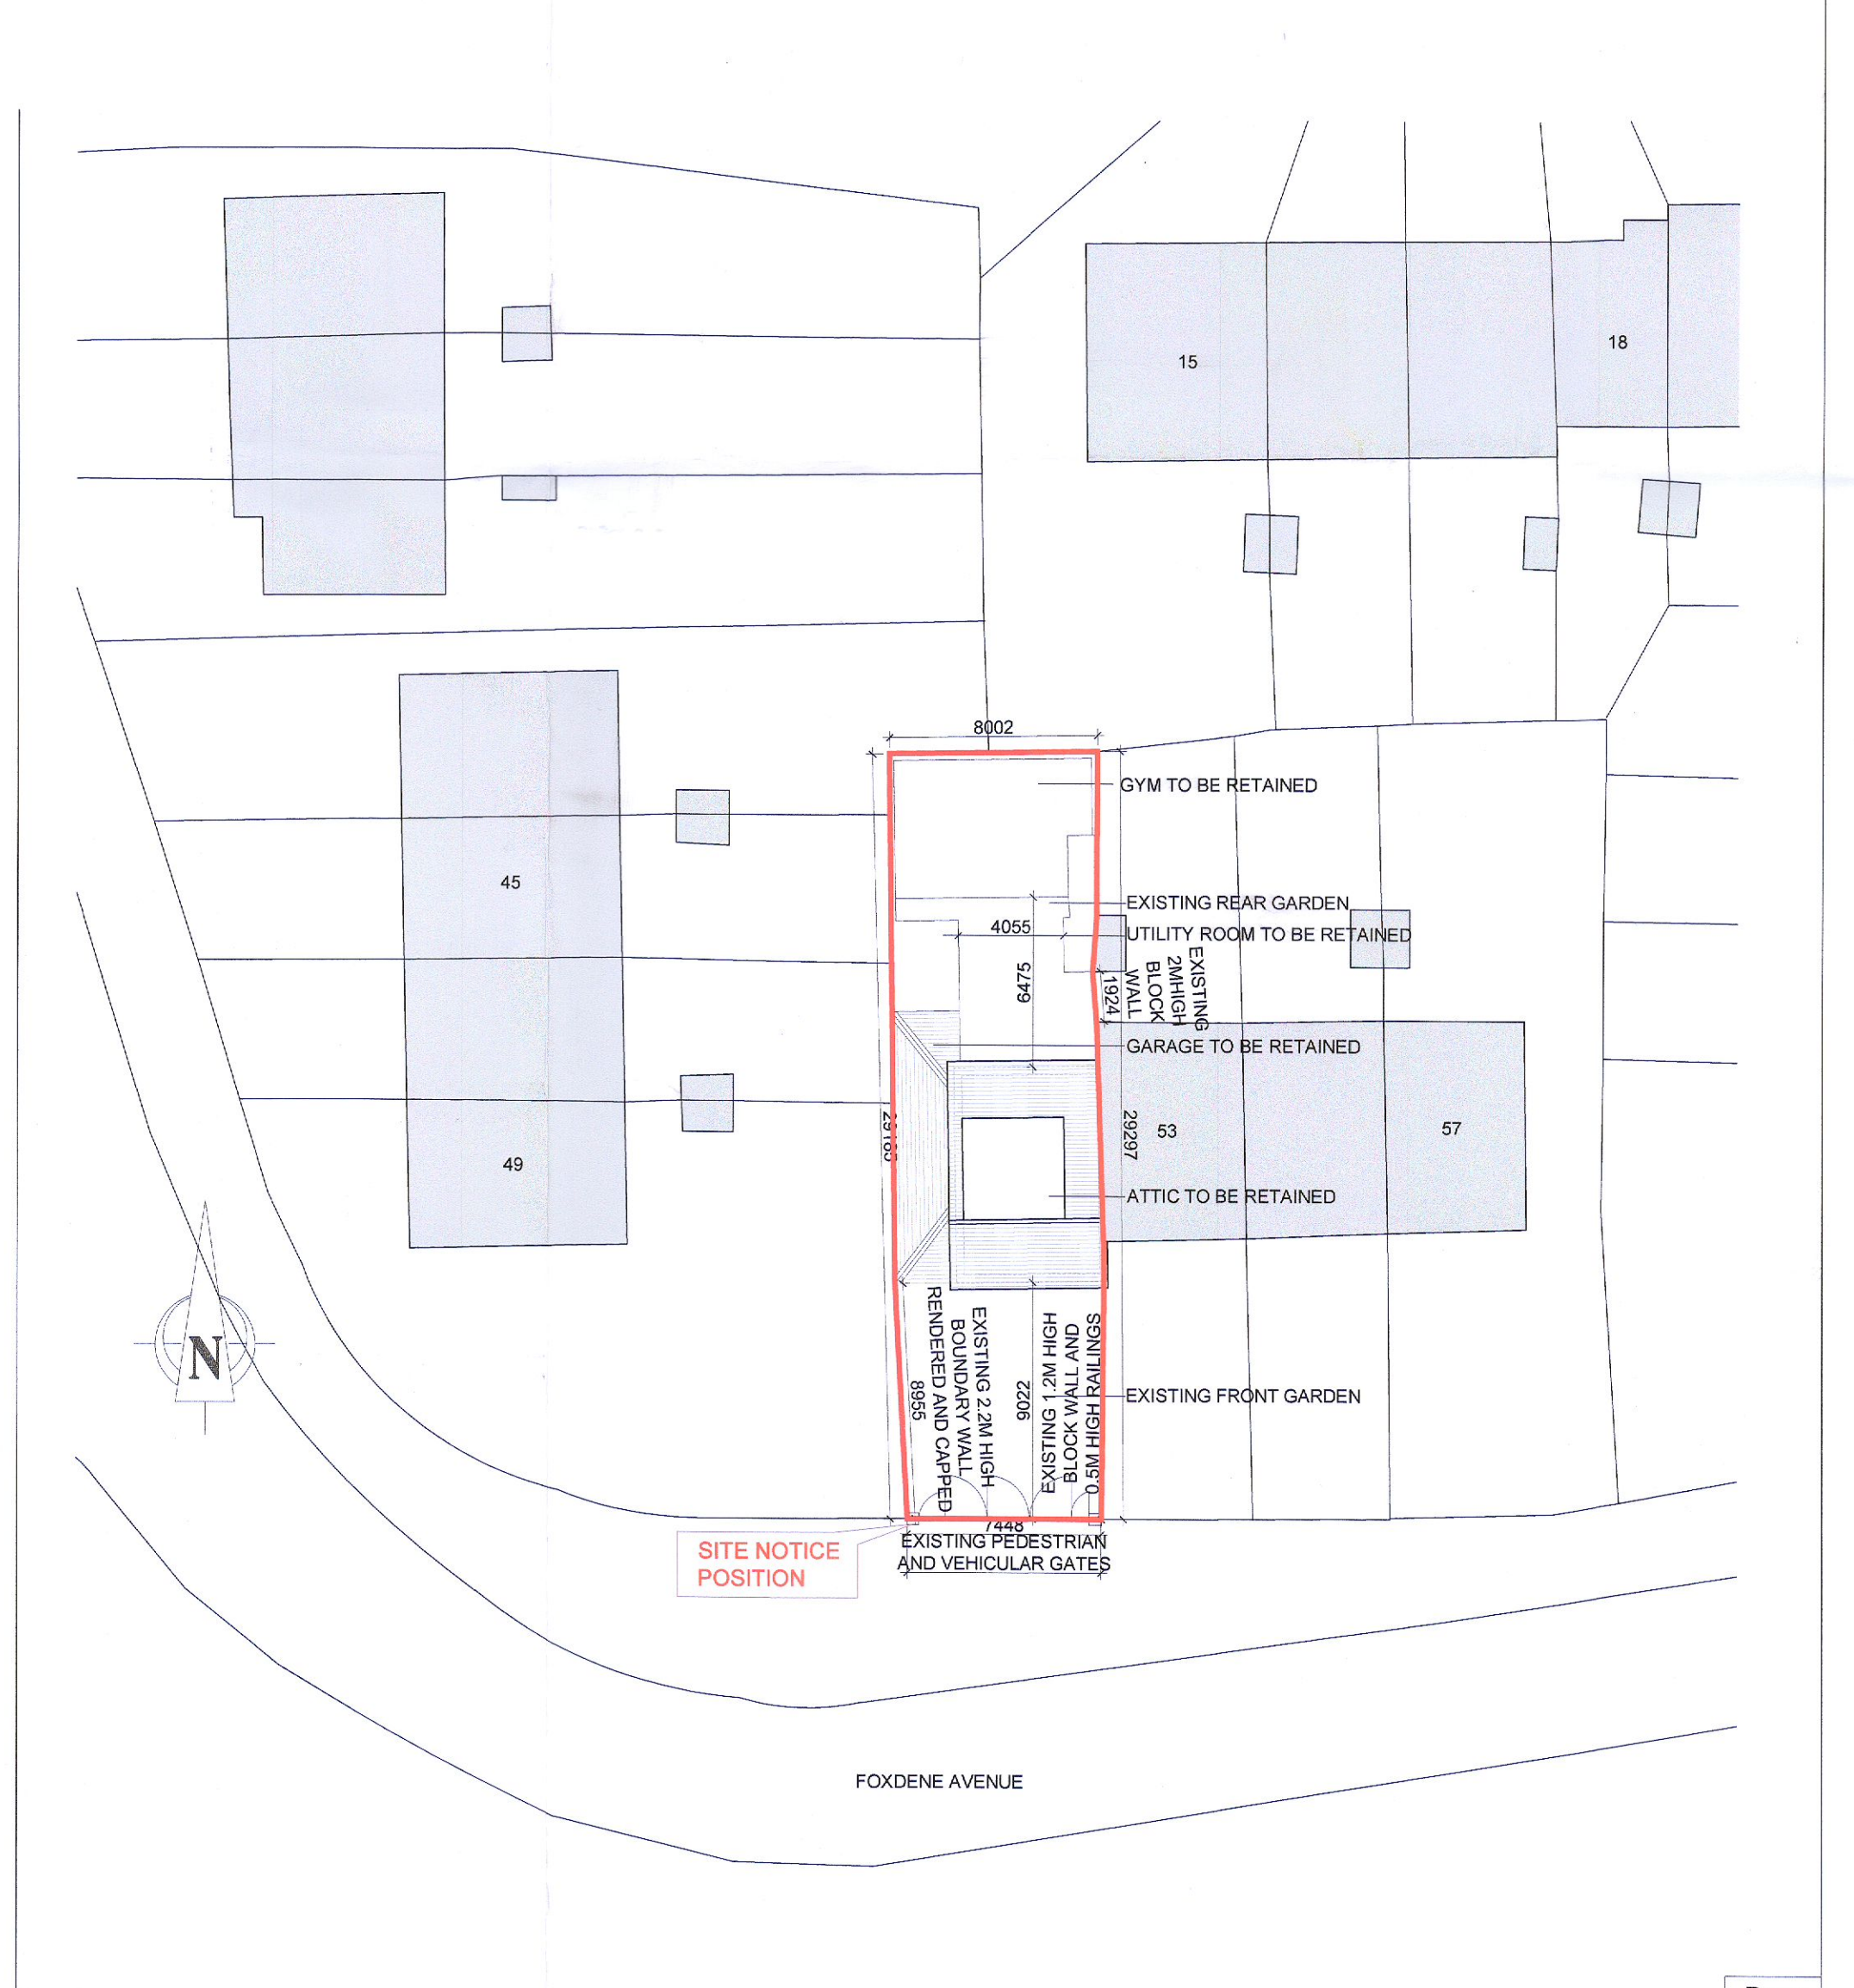

4 SITE PLAN
SCALE 1:250

NOTES
This drawing has been prepared for the following purpose only:
PLANNING
It should not be used, nor information contained therein be relied upon, for any other purpose whatsoever.
All drawings to be read in conjunction with all other related documents and other consultants drawings and documentation. Architects to be informed immediately of any discrepancies before work proceeds.

COPYRIGHT
This drawing and any design herein is copyright of Deaton Lysaght Architects and must not be reproduced in whole or in part without their express written consent.
DIMENSIONS
Figured dimensions only to be taken from this drawing. All dimensions to be checked on site. Architects to be informed immediately of any discrepancies before work proceeds.

Revisions:

No.	Revision:	Date:

Specification:

Project:
Retention at
51 Foxdene Avenue,
Lucan, Co Dublin
K78 FN76
Client:
Mrs. Amanda Bell

Drawing Title:
RETENTION OF EXTENSIONS AND ALTERATIONS TO EXISTING HOUSE
Scale: Drawing No.: Rev:
as 2217-S-01
Drawn by: Checked by: Date:
SAG ML jul. 2022

DEATON LYSAGHT ARCHITECTS
44 SOUTH RICHMOND STREET,
DUBLIN 2, IRELAND
Tel: 353 -1- 4754966
mail@dlarch.ie
www.deatonlysaght.ie