


EXISTING FIRST FLOOR PLAN

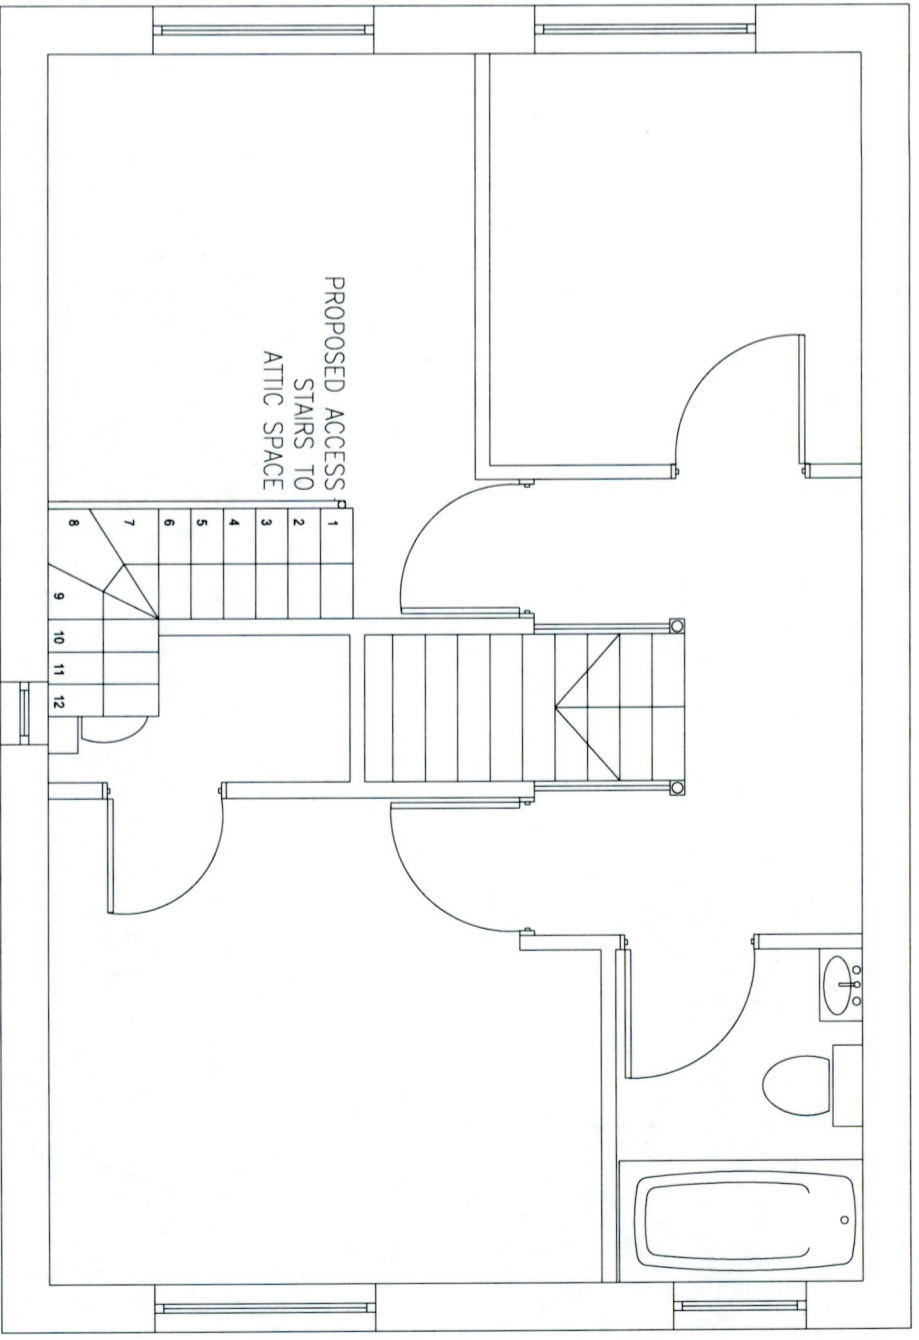


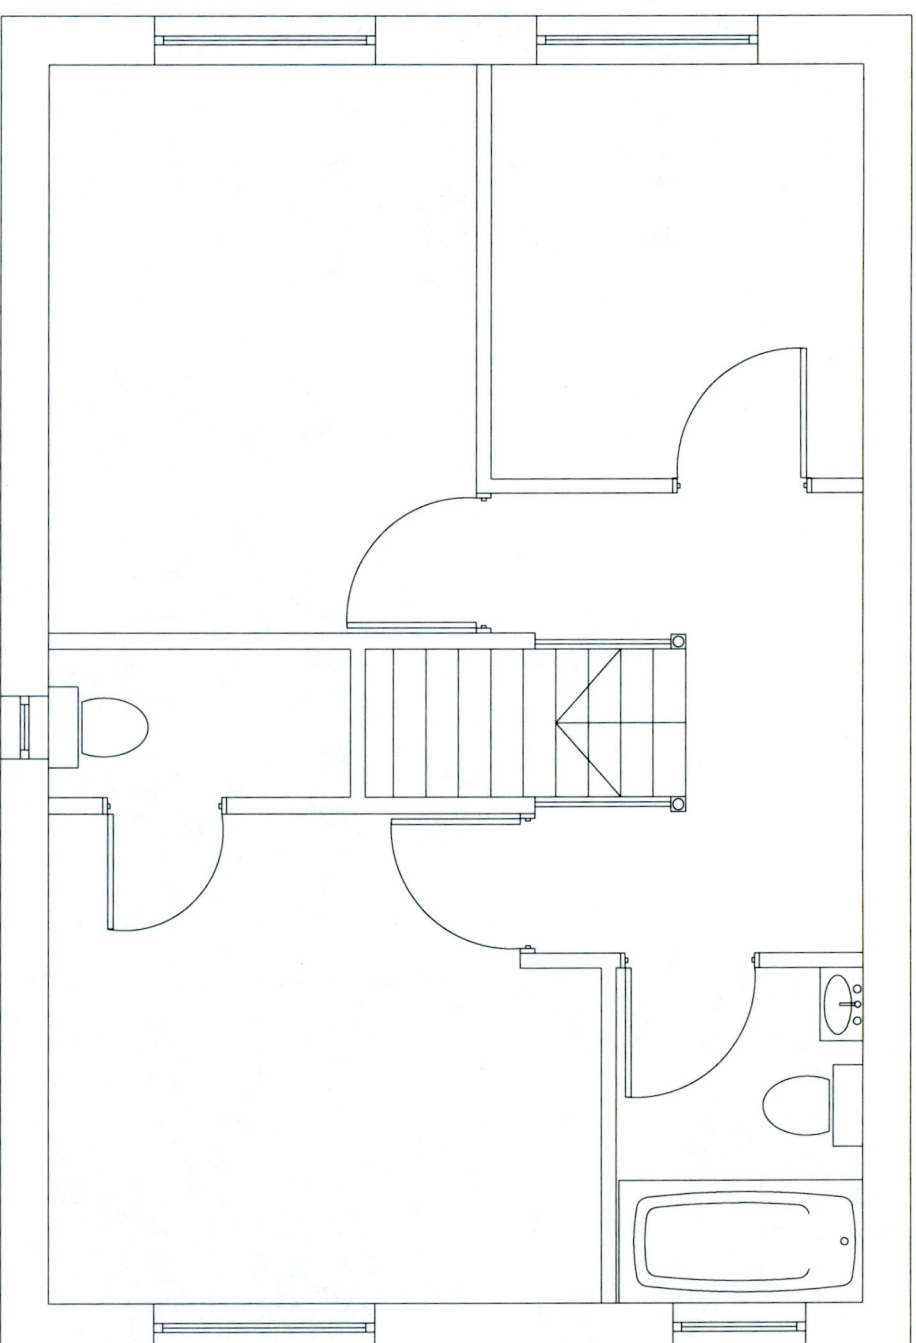
PROPOSED FIRST FLOOR PLAN

REV.	AMENDMENTS	DATE	INIT.	CHK.
-				
-				


DO NOT SCALE FROM DRAWING

Title				
18 Castlerada Grove, Lucan, K78 FN32, Dublin				
FIRST FLOOR PLAN EXISTING & PROPOSED				
Drawn	Checked	Date	Scale (A3)	Drawing Number
SC	SB	01.09.22	1:50	PP-D-02
Rev.				
-				

		Client Sarah Barragry & Stuart Campbell 18 Castlerada Grove, Lucan
Contractor TBC		Designer StuDesign
Project Dormer Attic Conversion		
stuedesign@me.com		



EXISTING FIRST FLOOR PLAN

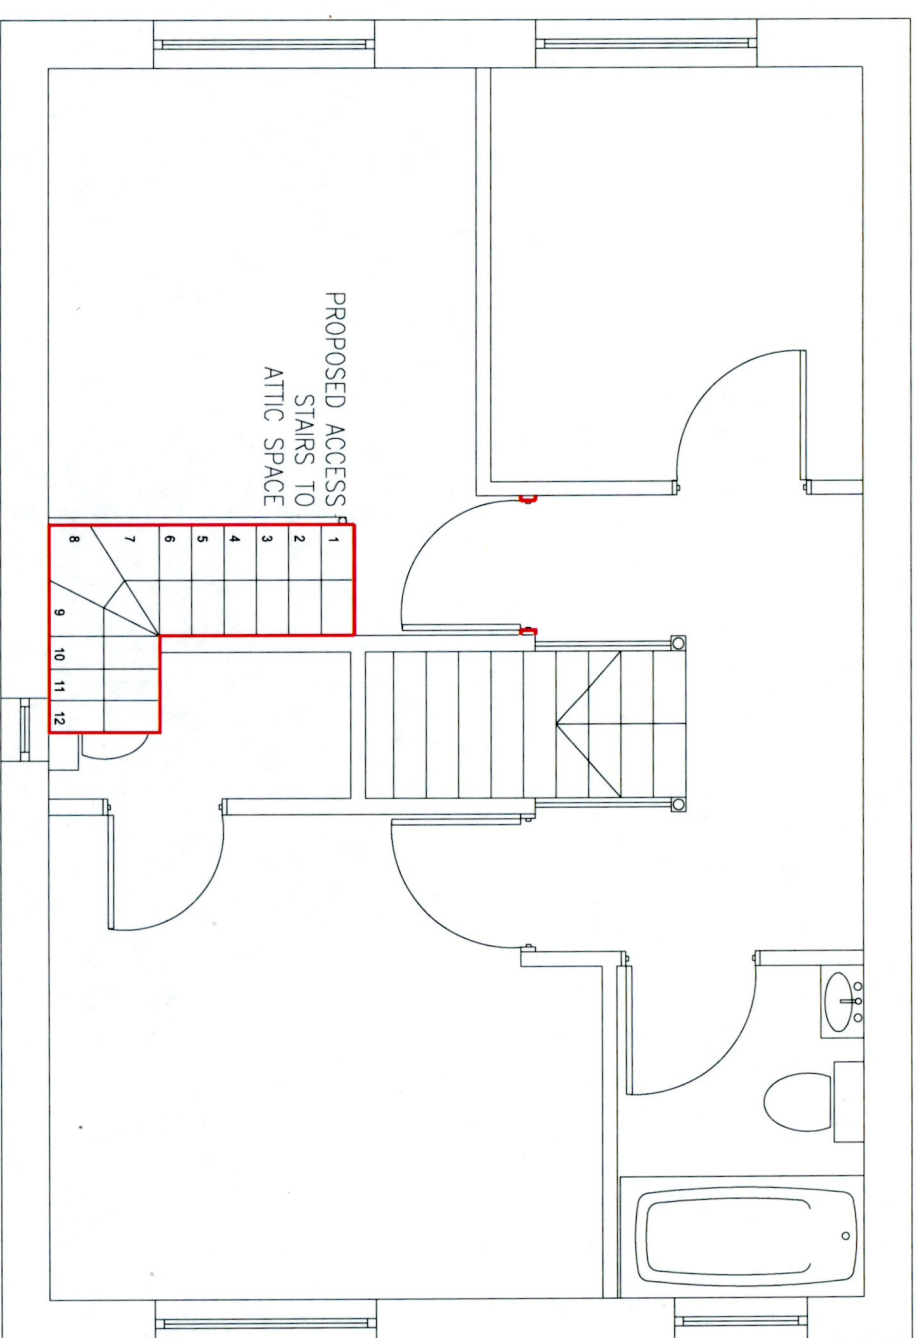

PROPOSED FIRST FLOOR PLAN



studeSign@me.com

Client
Sarah Barragry & Stuart Campbell
18 Castlerhada Grove, Lucan

Contractor
TBC
Designer
StuDesign

Project
Dormer Attic Conversion

REV.	AMENDMENTS	DATE	INIT.	CHK.
-				

DO NOT SCALE FROM DRAWING

Drawn	Checked	Date	Scale (A3)	Drawing Number	Rev.
SC	SB	01.09.22	1:50	PP-D-03	-

Title
18 Castlerhada Grove, Lucan, K78 FN32, Dublin
FIRST FLOOR PLAN EXISTING & PROPOSED - MARK UP