


NORTH  
**GROUND FLOOR PLAN AS PER SD19B/0332**  
 scale 1:100 @ A3

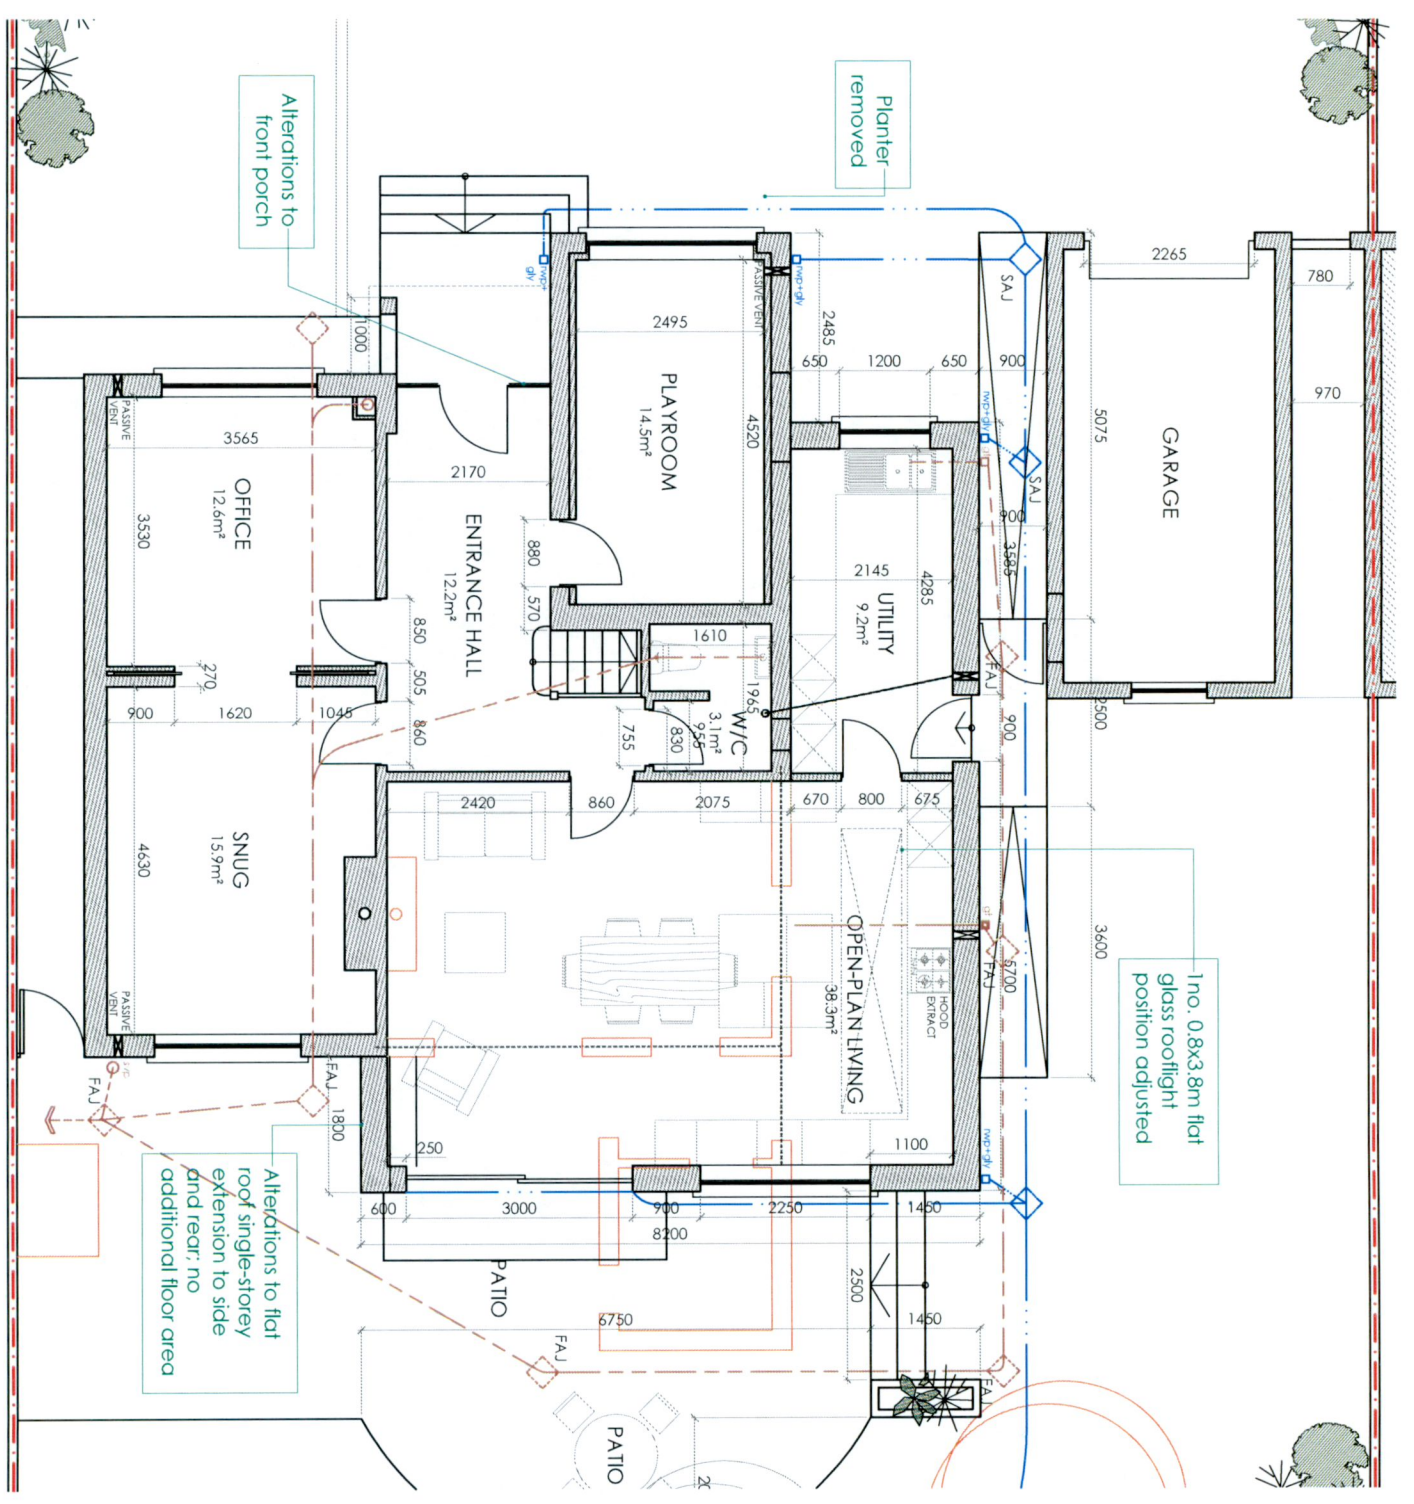

NORTH  
**GROUND FLOOR PLAN AS BUILT**  
 scale 1:100 @ A3

**Client**  
 Shane Teefy & Niamh Troy,  
 93 Marian Road,  
 Rathfarnham,  
 Dublin 14

**Revisions**



STATUS OF DRAWING  
**PLANNING RETENTION ONLY**

**notes**

All work to be carried out in accordance with the current Building Regulations and Technical Guidance Documents. These documents take precedence over any dimensions / notes / specifications on these drawings. The contractor / client is to make a thorough inspection of the site and make themselves fully aware of any peculiarities pertaining there to. The contractor is entirely responsible for the proper setting out of works on site. Written dimensions are to be used in preference to scaling. **Contractor / client is to check all dimensions prior to planning stage / construction. Any discrepancies to be reported before work is in hand.** Contractor is deemed to have included for everything required to finish off project to a satisfactory condition though not specifically described on drawings. All work to be supervised and signed off by suitably qualified persons with up to-date insurance and proper Health and Safety. All drainage works to comply with Local Authority Regulations - if in doubt contact Authority. All works must be carried out using proper materials that are fit for the use for which they are intended and for the conditions in which they are to be used; if in doubt, refer to the harmonised technical specifications.



**JOE FALLON DESIGN** ARCHITECTURE  
 First Floor, 6 Main Street, Dundrum, Dublin 14  
 1A Ryland Street, Buncloody, Enniscorthy, Co. Wexford

**Project** Retention to 93 Marian Road  
**drawing plans**  
**job no.** 18012 **scale** as shown **date** 25.09.22 **drawn by** LK **stage** Planning



**checked by** DOM  
**dwg no.** 18012-PP-03

P: 01-5143688  
 M: 087-2568908  
 F: 053-9377633

**A3**

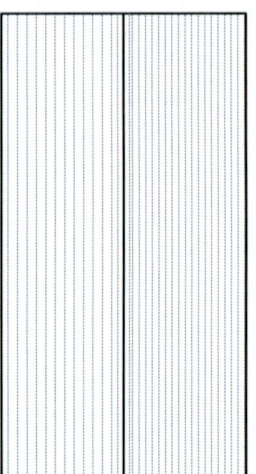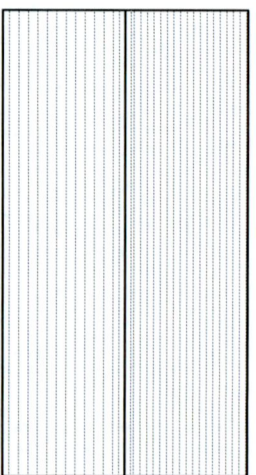

1 no. 0.8x3.8m flat glass rooflight position adjusted

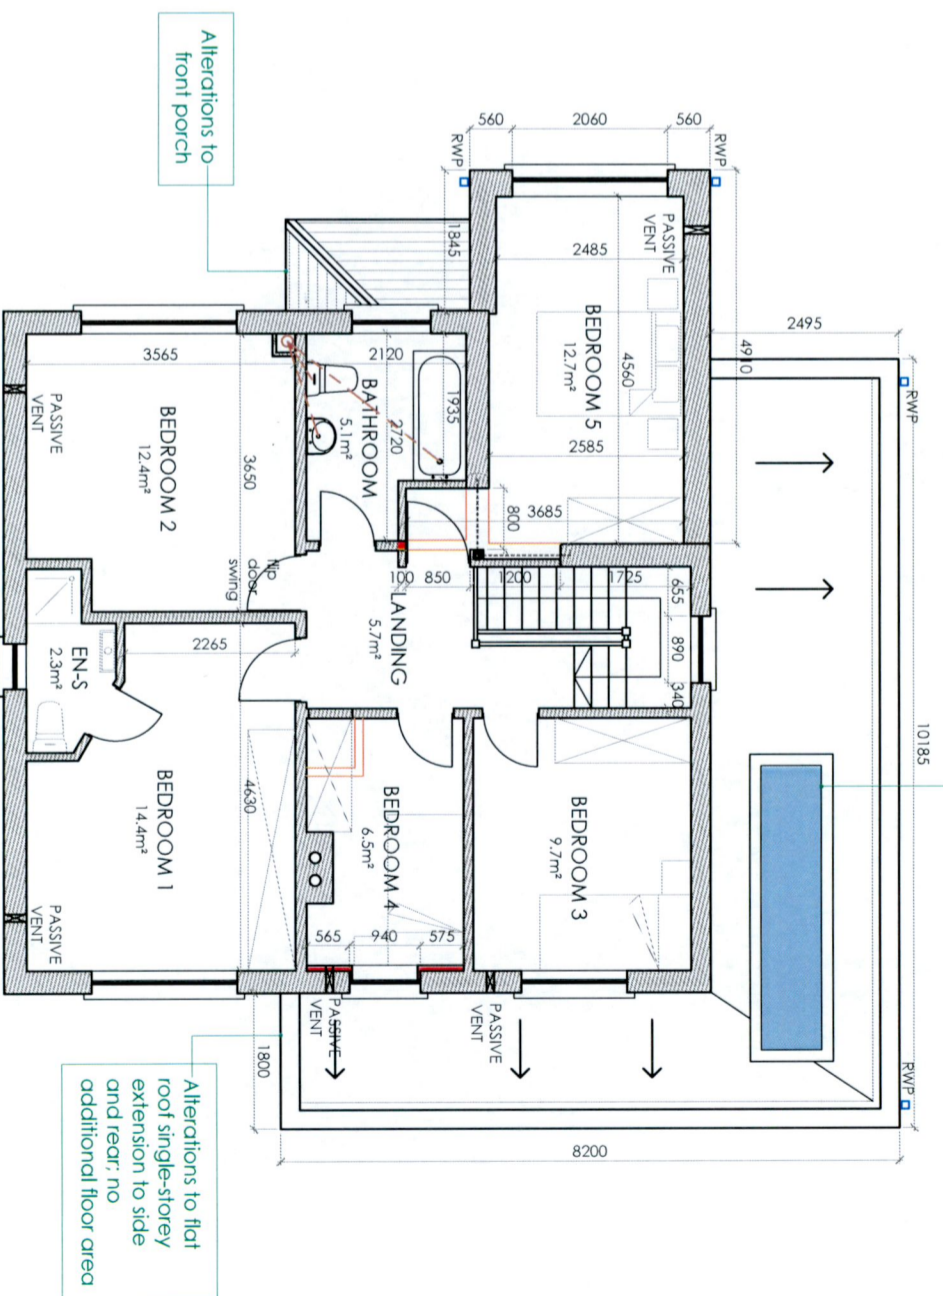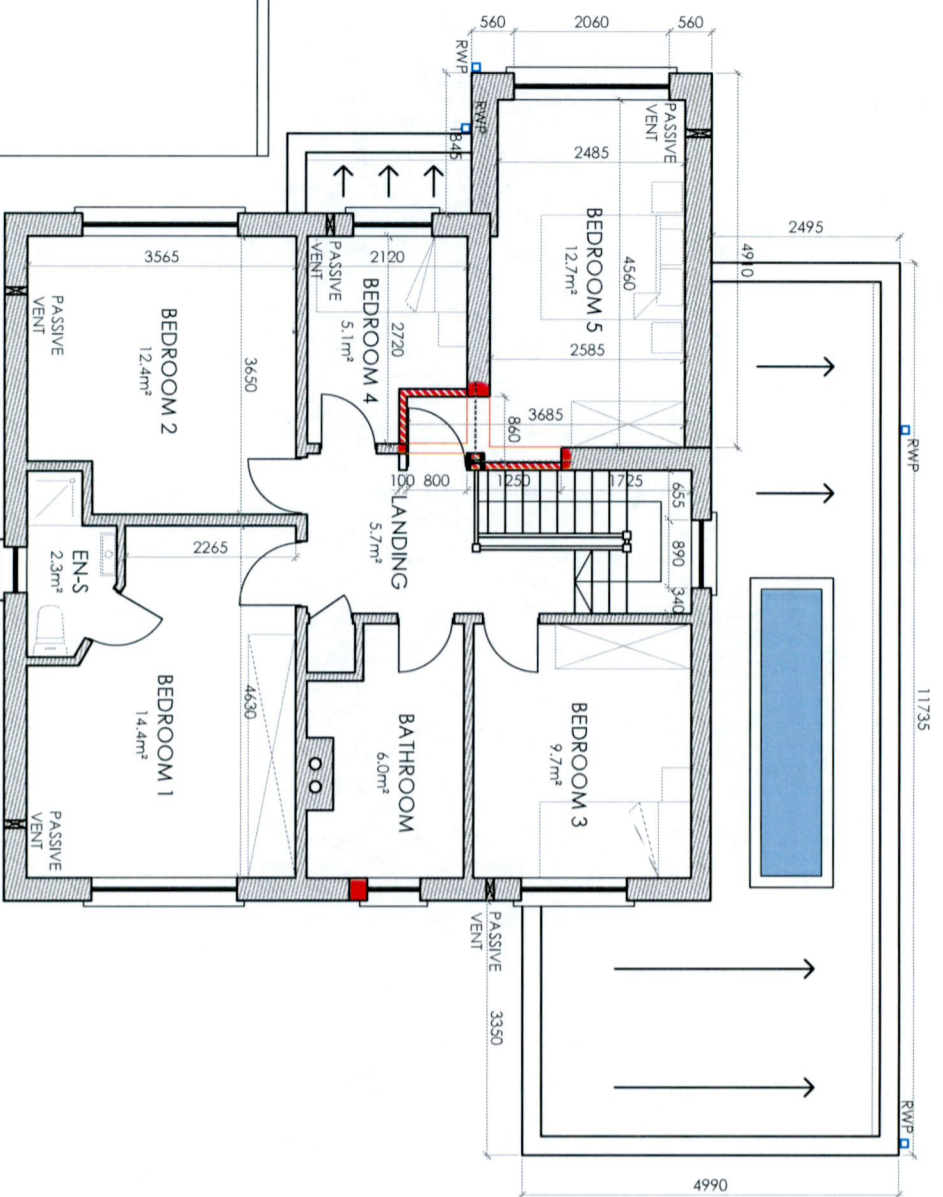

**NORTH**  
FIRST FLOOR PLAN AS PER SD19B/0332  
scale 1:100 @ A3



**NORTH**  
FIRST FLOOR PLAN AS BUILT  
scale 1:100 @ A3

**Client**  
Shane Teefy & Niamh Troy,  
93 Marian Road,  
Rathfarnham,  
Dublin 14

**Revisions**



**PLANNING RETENTION ONLY**

STATUS OF DRAWING

**JOE FALLOIDESIGN**  
ARCHITECTURE

First Floor, 6 Main Street, Dundrum, Dublin 14  
1A Ryland Street, Buncledy, Enniscorthy, Co. Wexford

P: 01-5143688  
M: 087-2566808  
P: 053-9377833

**A3**

**project** Retention to 93 Marian Road  
**drawing plans**

**dwg no.** 18012-PP-04  
**checked by** DOM

**job no.** 18012 **scale** as shown **date** 25.09.22 **drawn by** LK **stage** Planning

**notes**

All work to be carried out in accordance with the current Building Regulations and Technical Guidance Documents. These documents take precedence over any dimensions / notes / specifications on these drawings. The contractor / client is to make a thorough inspection of the site and make themselves fully aware of any peculiarities pertaining there to. The contractor is entirely responsible for the proper setting out of works on site. Written dimensions are to be used in preference to scaling. **Contractor / client is to check all dimensions prior to planning stage / construction. Any discrepancies to be reported before work is in hand.** Contractor is deemed to have included for everything required to finish off project to a satisfactory condition though not specifically described on drawings. All work to be supervised and signed off by suitably qualified persons with up-to-date insurance and proper Health and Safety. All drainage works to comply with Local Authority Regulations - if in doubt contact Authority. All works must be carried out using proper materials that are fit for the use for which they are intended and for the conditions in which they are to be used. If in doubt, refer to the harmonised technical specifications.

UNDER THE BUILDING CONTROL ACT 2007, JOE FALLOIDESIGN IS A REGISTERED ASSIGNED CERTIFIER. REG. NO. B0244 SCS1