


REAR ELEVATION AS PER SD19B/0332
scale 1:100 @ A3

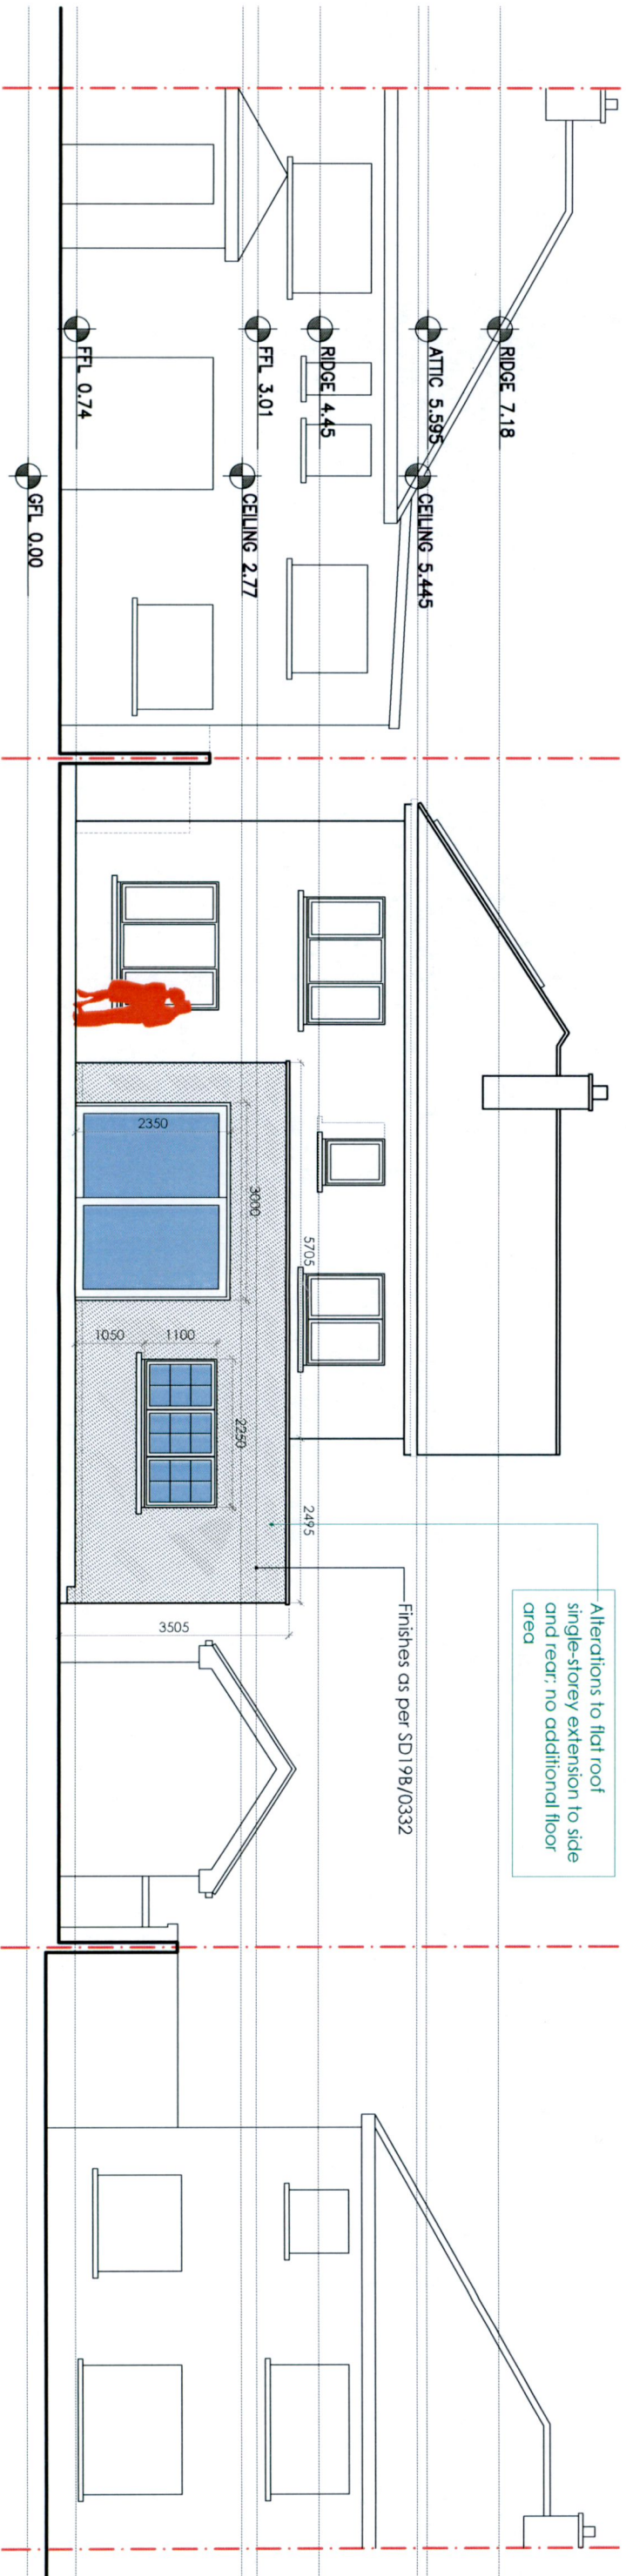

REAR ELEVATION AS BUILT
scale 1:100 @ A3

Client
Shane Teely & Niamh Troy,
93 Marian Road,
Rathfarnham,
Dublin 14

Revisions

PLANNING RETENTION ONLY

JOE FALLON DESIGN
ARCHITECTURE
First Floor, 6 Main Street, Dundrum, Dublin 14
1A Ryland Street, Buncloody, Emisborough, Co. Wickford

A3

notes
All work to be carried out in accordance with the current Building Regulations and Technical Guidance Documents. These documents take precedence over any dimensions / notes / specifications on these drawings. The contractor / client is to make a thorough inspection of the site and make themselves fully aware of any peculiarities pertaining there to. The contractor is entirely responsible for the proper setting out of works on site. Written dimensions are to be used in preference to scaling. **Contractor / client is to check all dimensions prior to planning stage / construction. Any discrepancies to be reported before work is in hand.** Contractor is deemed to have included for everything required to finish off project to a satisfactory condition though not specifically described on drawings. All work to be supervised and signed off by suitably qualified persons with up-to-date insurance and proper Health and Safety. All drainage works to comply with Local Authority Regulations - if in doubt contact Authority. All works must be carried out using proper materials that are fit for the use for which they are intended and for the conditions in which they are to be used. If in doubt, refer to the harmonised technical specifications.

STATUS OF DRAWING


job no. 18012 **scale** as shown **date** 25.09.22 **drawn by** LK **checked by** DDM **stage** Planning

Project Retention to 93 Marian Road
drawing elevations


job no. 18012 **scale** as shown **date** 25.09.22 **drawn by** LK **checked by** DDM **stage** Planning

UNDER THE BUILDING CONTROL ACT 2007, JOE FALLON IS A REGISTERED ASSIGNED CERTIFIER. REG. NO. 90244 SCS1

P: 01-51 43688
M: 087-2568908
F: 053-9377633

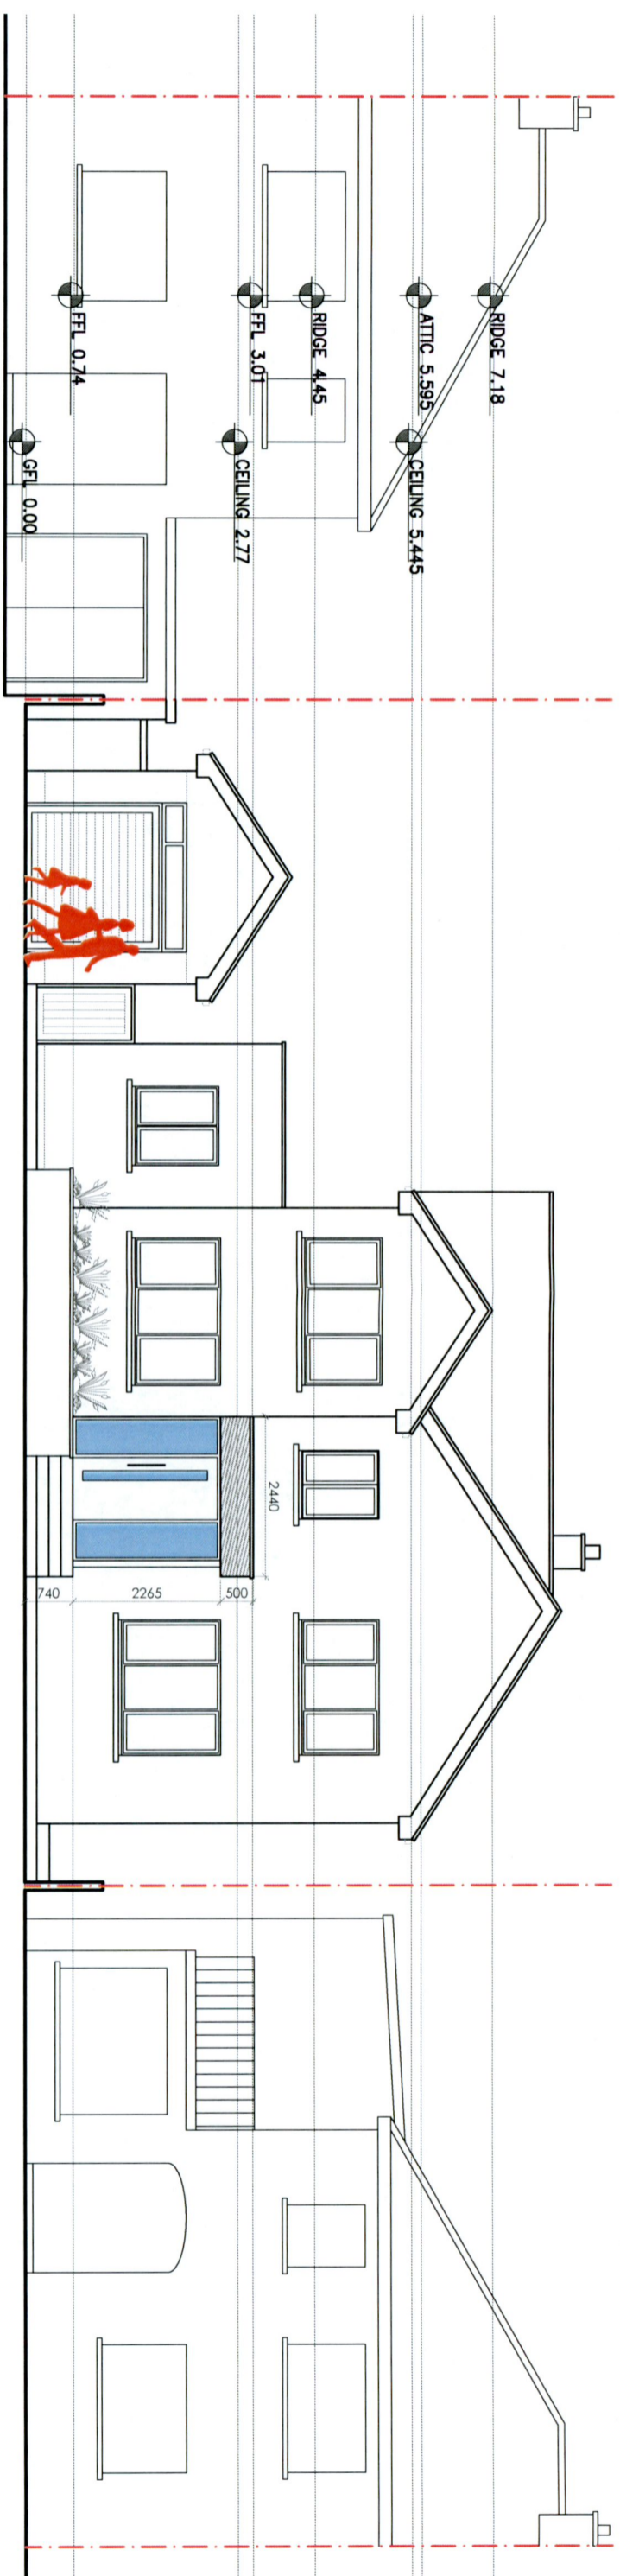

REAR ELEVATION AS PER SD19B/0332
Scale 1:100 @ A3

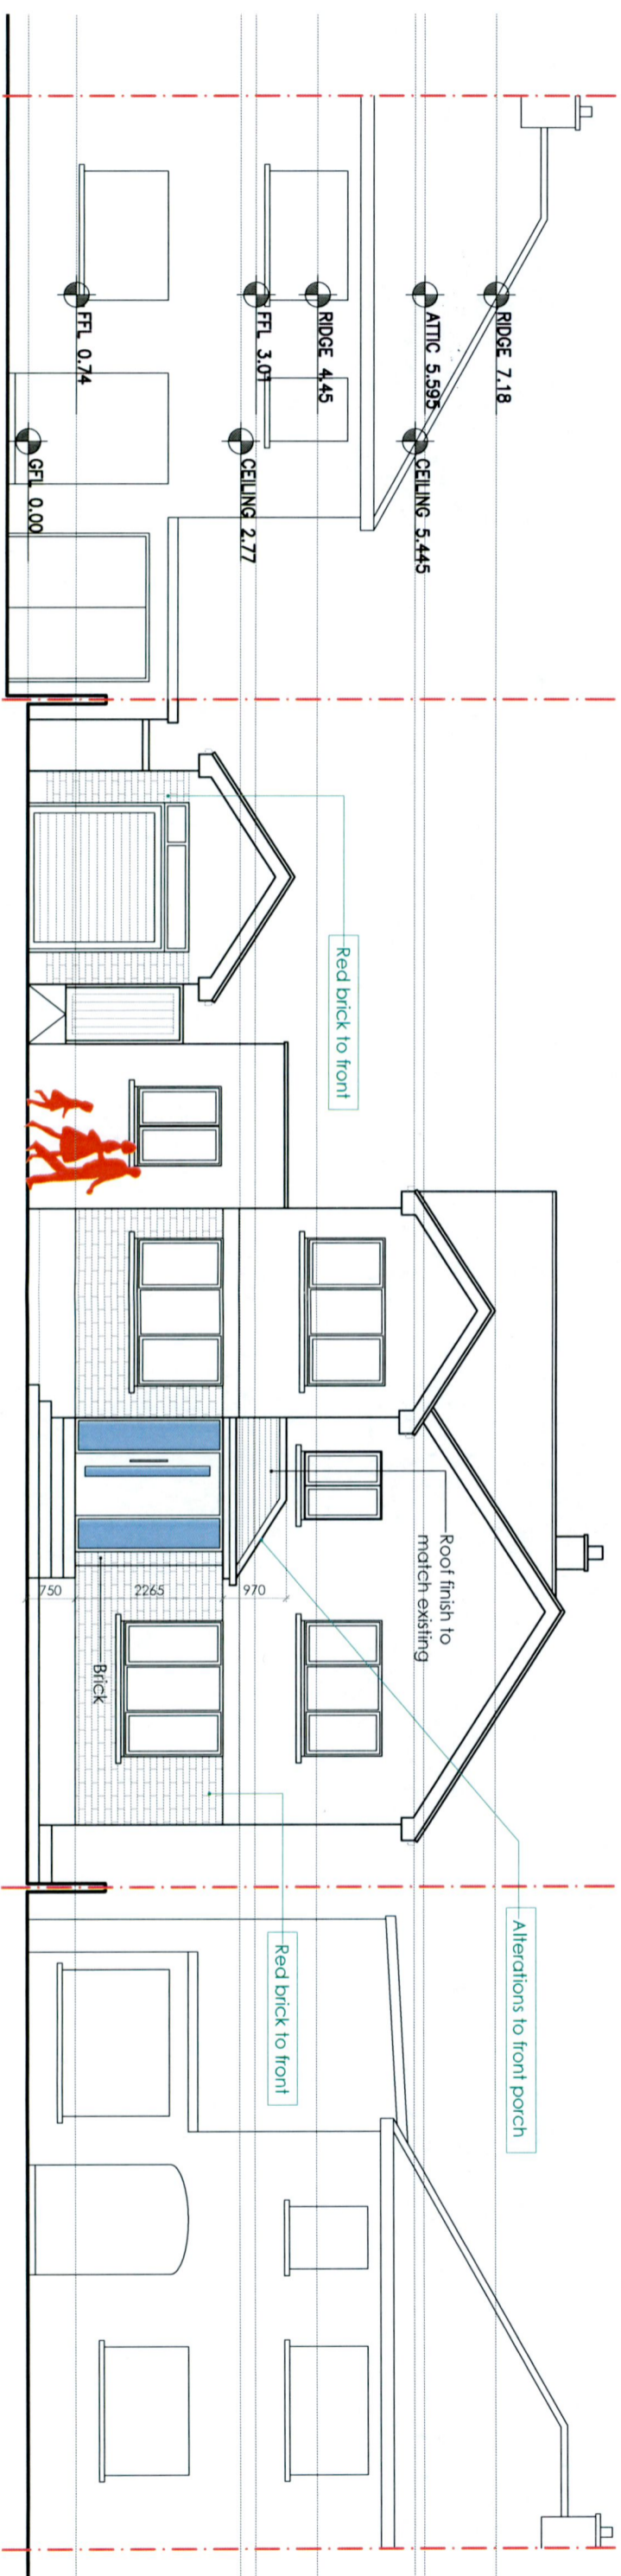

REAR ELEVATION AS BUILT
Scale 1:100 @ A3

Client
Shane Teely & Niamh Troy,
93 Marian Road,
Rathfarnham,
Dublin 14

Revisions



STATUS OF DRAWING
PLANNING RETENTION ONLY

JOE FALLON DESIGN ARCHITECTURE
First Floor, 6 Main Street, Dundrum, Dublin 14
1A Ryland Street, Buncloody, Enniscorthy, Co. Wexford
P: 01-5143688
M: 087-2556808
P: 053-9377833
A3

Project Retention to 93 Marian Road
drawing elevations
job no. 18012 **scale** as shown **date** 25.09.22 **drawn by** LK **checked by** DOM **stage** Planning

notes

All work to be carried out in accordance with the current Building Regulations and Technical Guidance Documents. These documents take precedence over any dimensions / notes / specifications on these drawings. The contractor / client is to make a thorough inspection of the site and make themselves fully aware of any peculiarities pertaining there to. The contractor is entirely responsible for the proper setting out of works on site. Written dimensions are to be used in preference to scaling. **Contractor / client is to check all dimensions prior to planning stage / construction. Any discrepancies to be reported before work is in hand.** Contractor is deemed to have included for everything required to finish off project to a satisfactory condition though not specifically described on drawings. All work to be supervised and signed off by suitably qualified persons with up to-date insurance and proper Health and Safety. All drainage works to comply with Local Authority Regulations - if in doubt contact Authority. All works must be carried out using proper materials that are fit for the use for which they are intended and for the conditions in which they are to be used. If in doubt, refer to the harmonised Technical specifications.