




1 SECTION A - PROPOSED
PL - 103 SCALE 1:100 @ A1

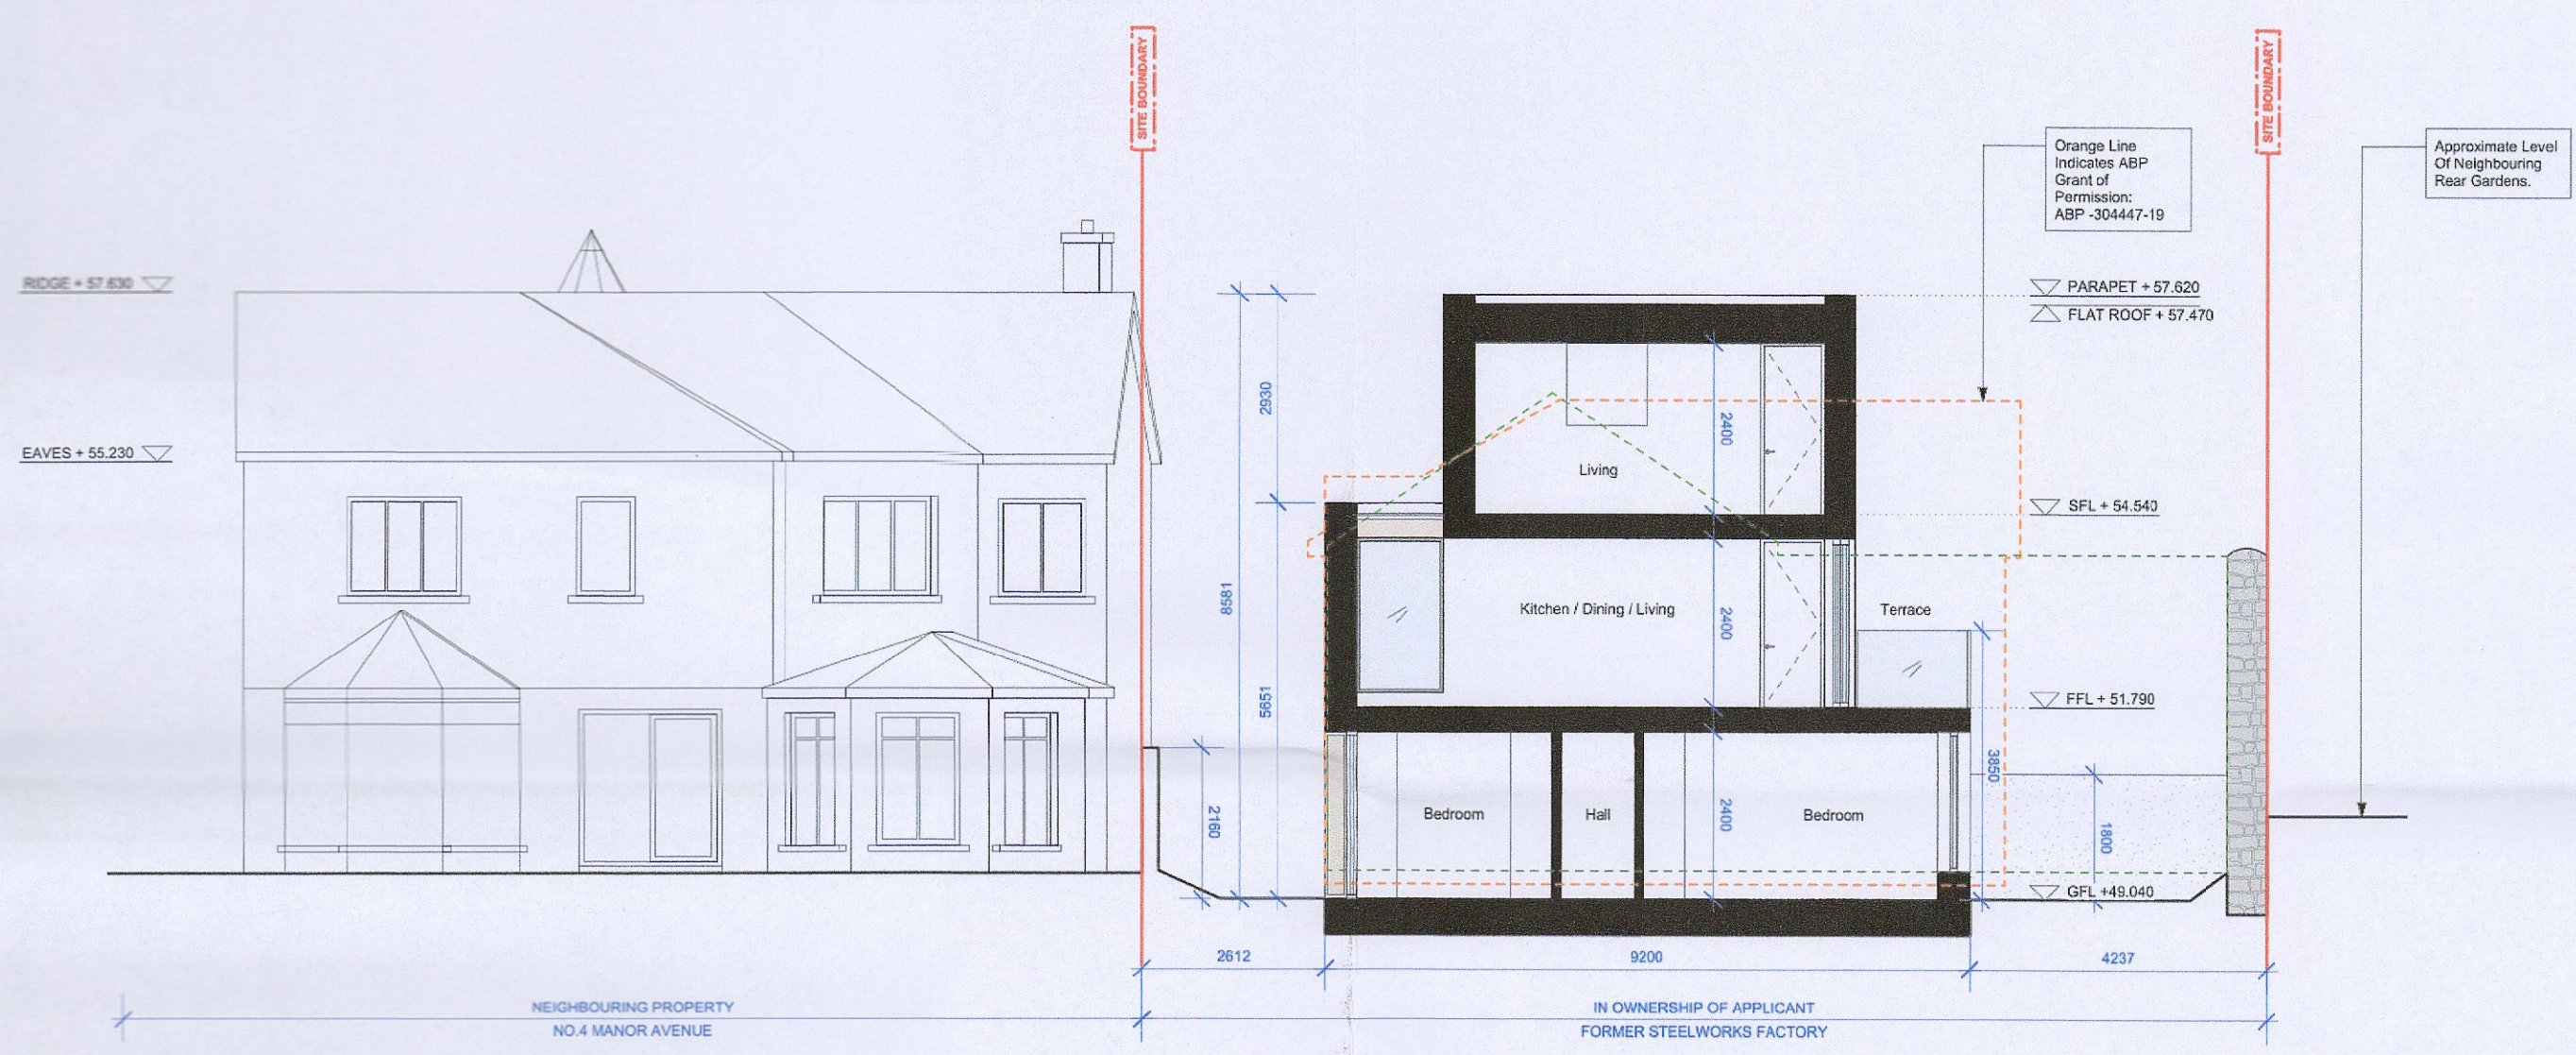

2 SECTION B - PROPOSED
PL - 103 SCALE 1:100 @ A1

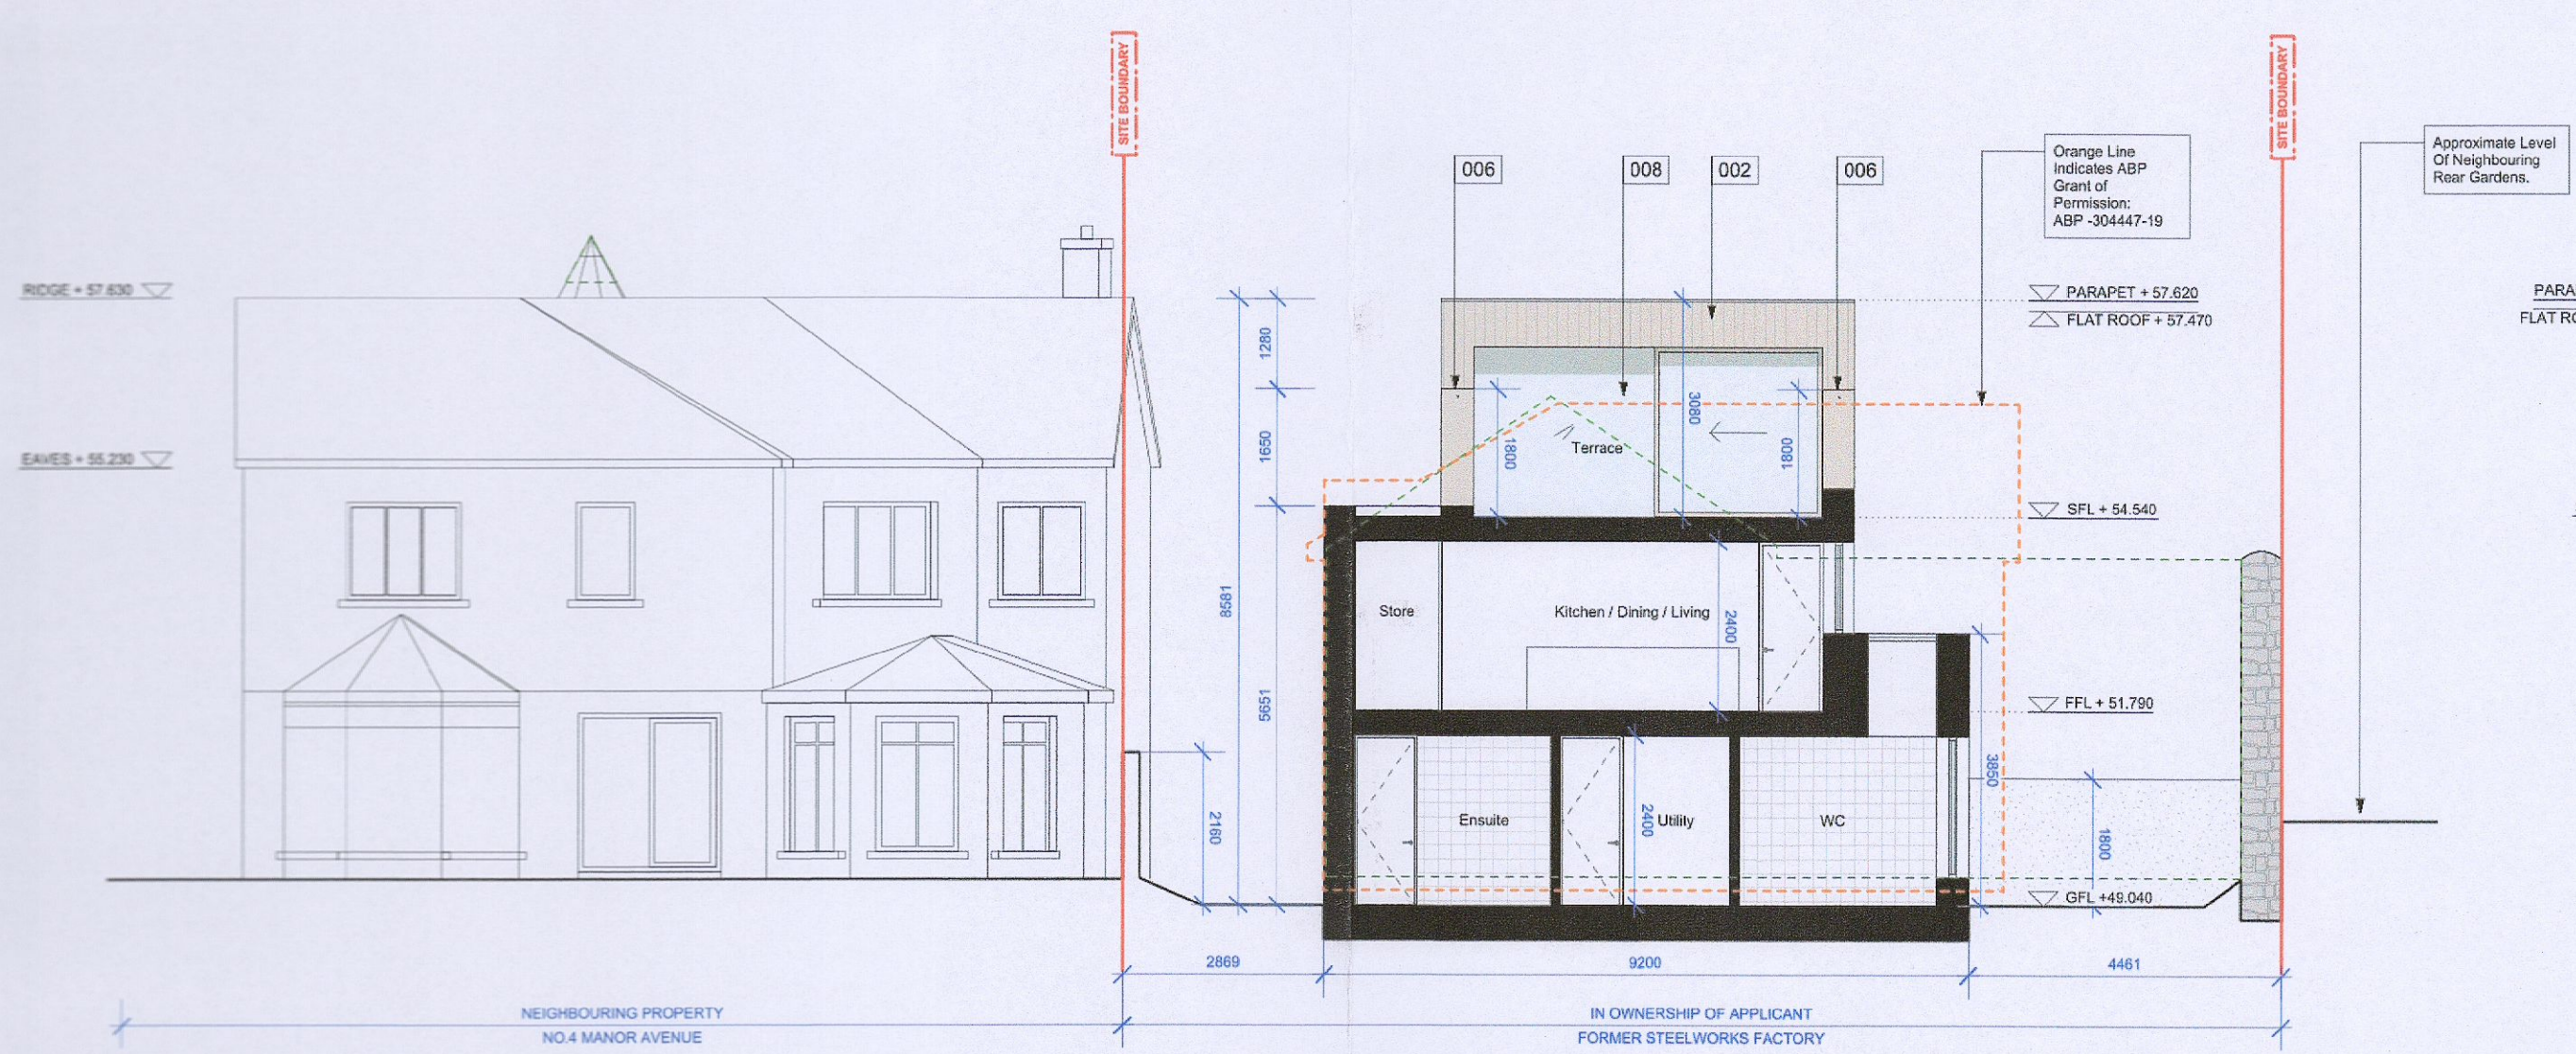

3 SECTION C - PROPOSED
PL - 103 SCALE 1:100 @ A1

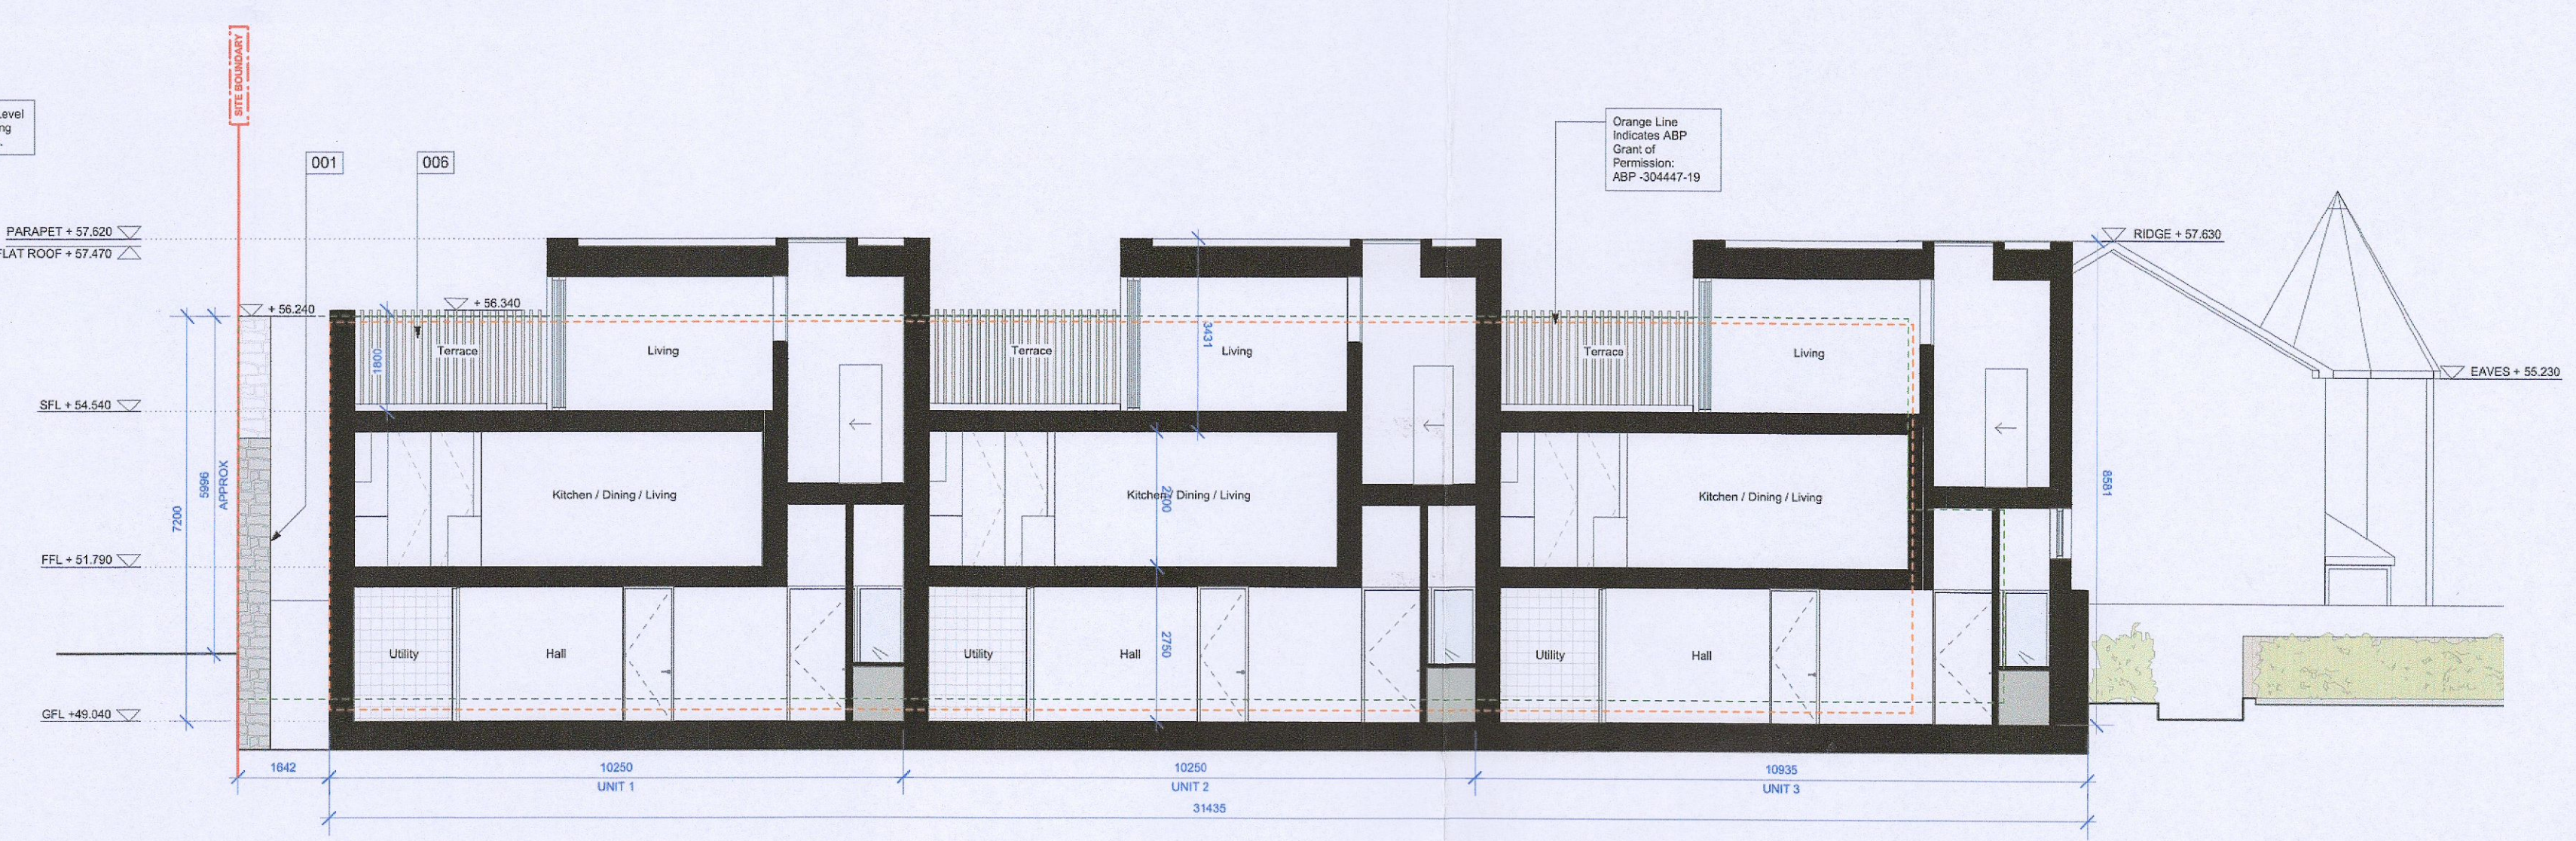

4 SECTION D - PROPOSED
PL - 103 SCALE 1:100 @ A1

DRAWING LEGEND - PROPOSED		DRAWING TAGS - PROPOSED	
Solid Red Line Indicates Site Boundary	---	005 - Proposed Glass Balustrade	010 - Proposed Fixed Glazing
Dashed Green Line Indicates Outline Of Existing Structure	---	006 - Proposed Timber Fins	011 - Proposed Fixed Opaque Glazing
Dashed Orange Line Indicates Outline Of ABP Grant of Permission	---	007 - Proposed Glazing With Opaque Operable Vert Section	012 - Proposed Acrylic Render Finish To Garden Walls
Indicates Proposed New Structure	---	008 - Proposed Glazed Sliding Doors	013 - Proposed Timber Gate
		004 - Proposed Stone Wall (Stone Re-used From Existing Structure)	014 - Proposed Sedum Roof
		009 - Proposed Operable Glazing	

PROJECT NO:	2204	DRAWING SCALE:	1:100 @ A1	S A M L E B A S
LOCATION:	MANOR AVENUE, WAINSFORT GROVE, TERENURE, DUBLIN 6	DRAWING TITLE:	SECTIONS - PROPOSED	M: +353 86 1063973 E: hello@lebas.ie
STAGE:	PLANNING	DATE:	SEP 2022	DRAWING NO:
				2204 - PL - 103