




GENERAL NOTES:
 ** Do not scale from this drawing
 ** Use figured dimensions only
 © This drawing is copyright. No part of this document may be reproduced or transmitted in any form or stored in any retrieval system from the copyright holder, except as agreed for use on a project, for which the document was originally issued.

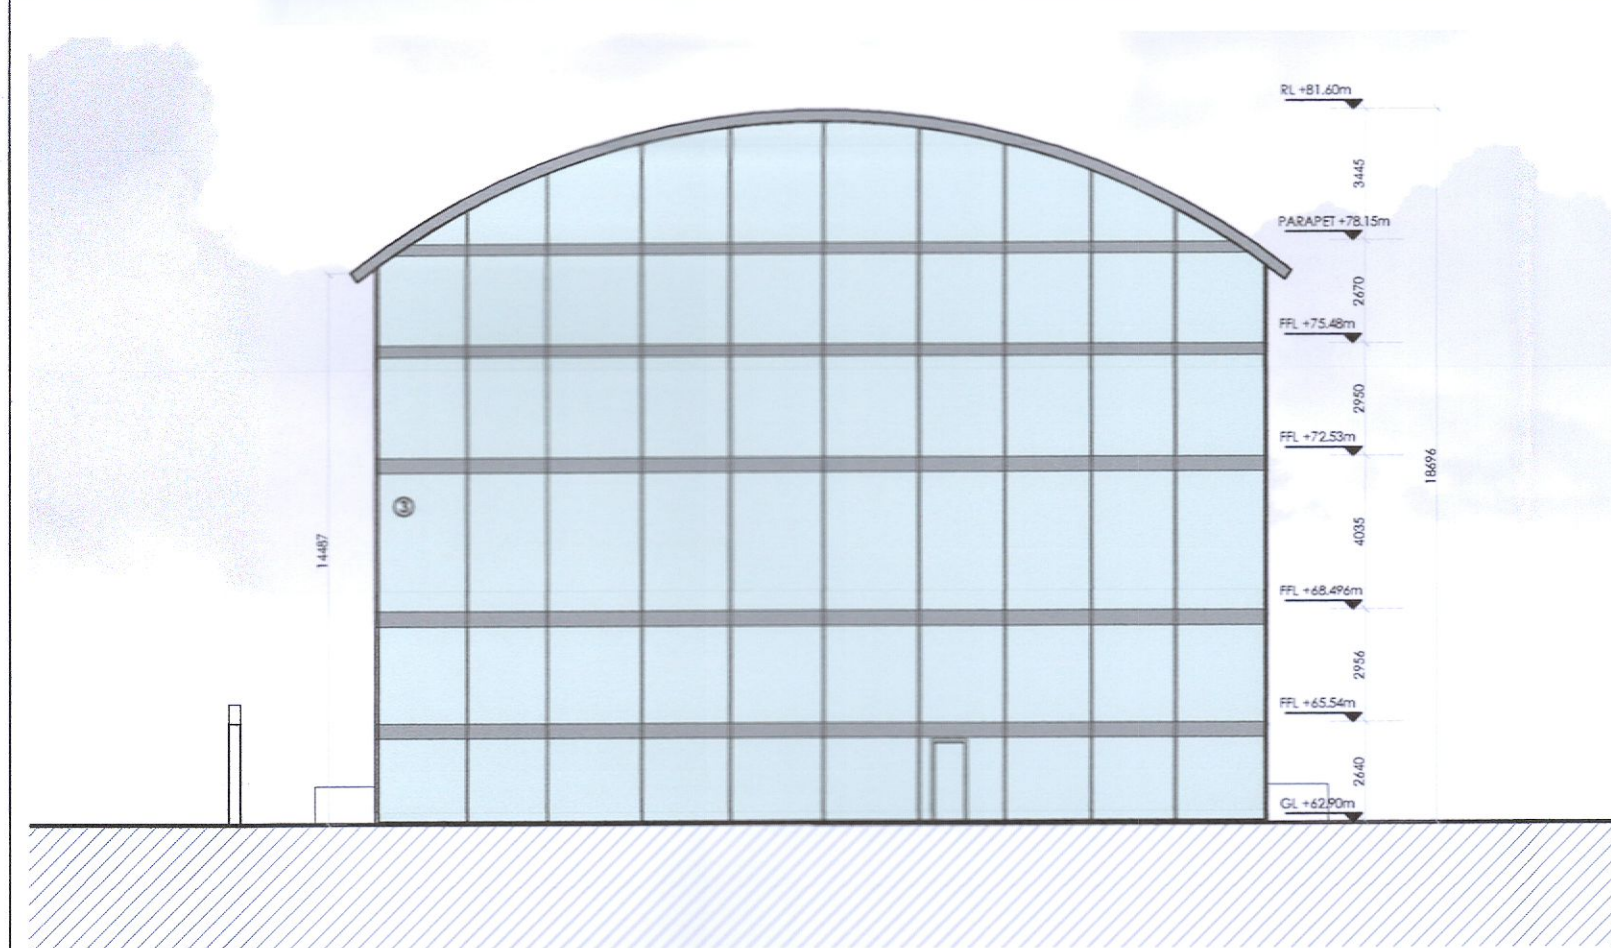


AS BUILT FRONT ELEVATION (NORTH FACING)
1:200

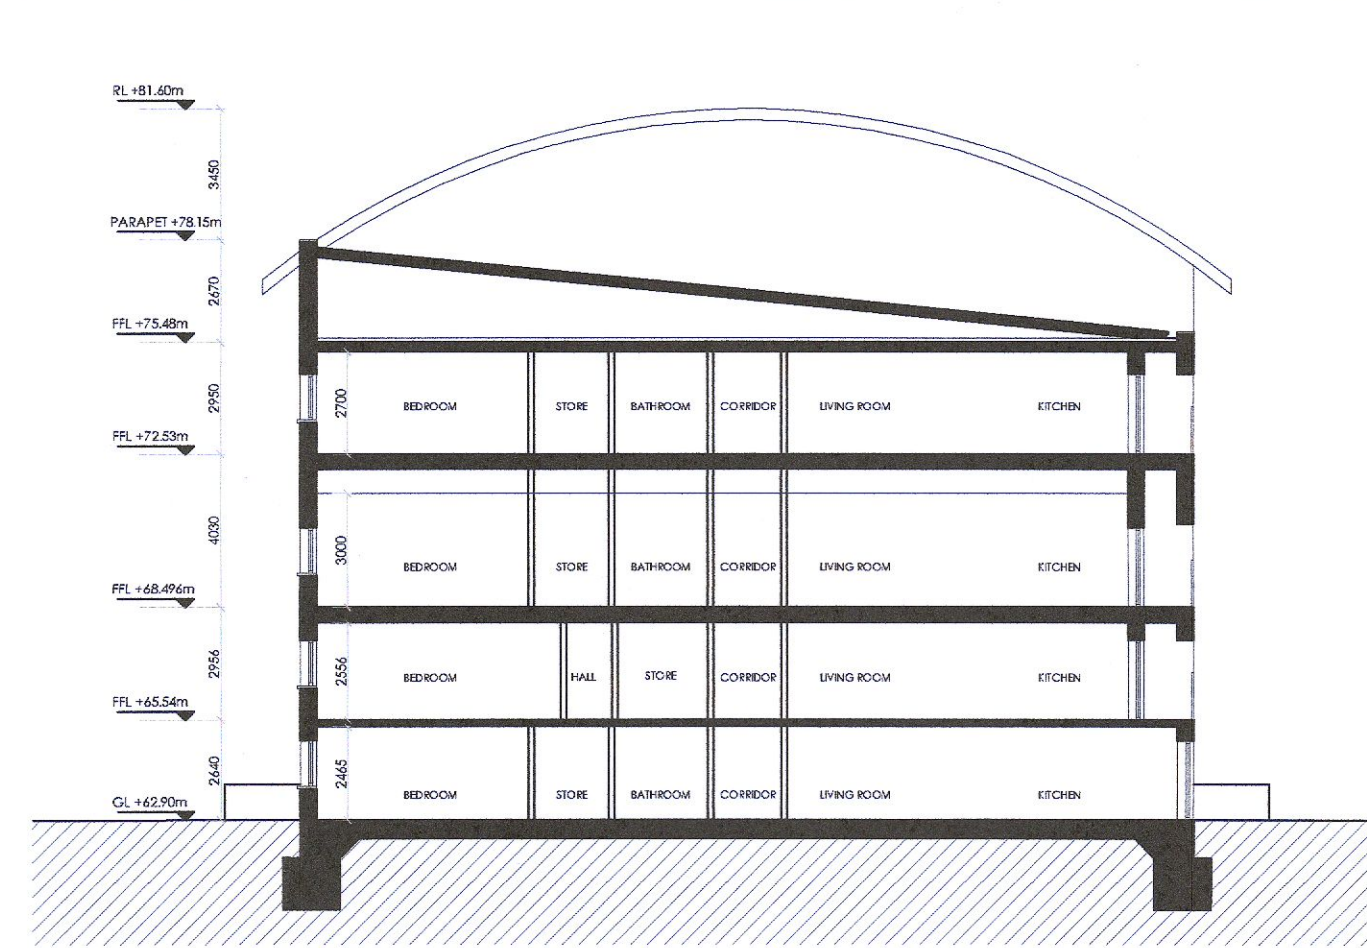


AS BUILT SECTION A-A
1:200

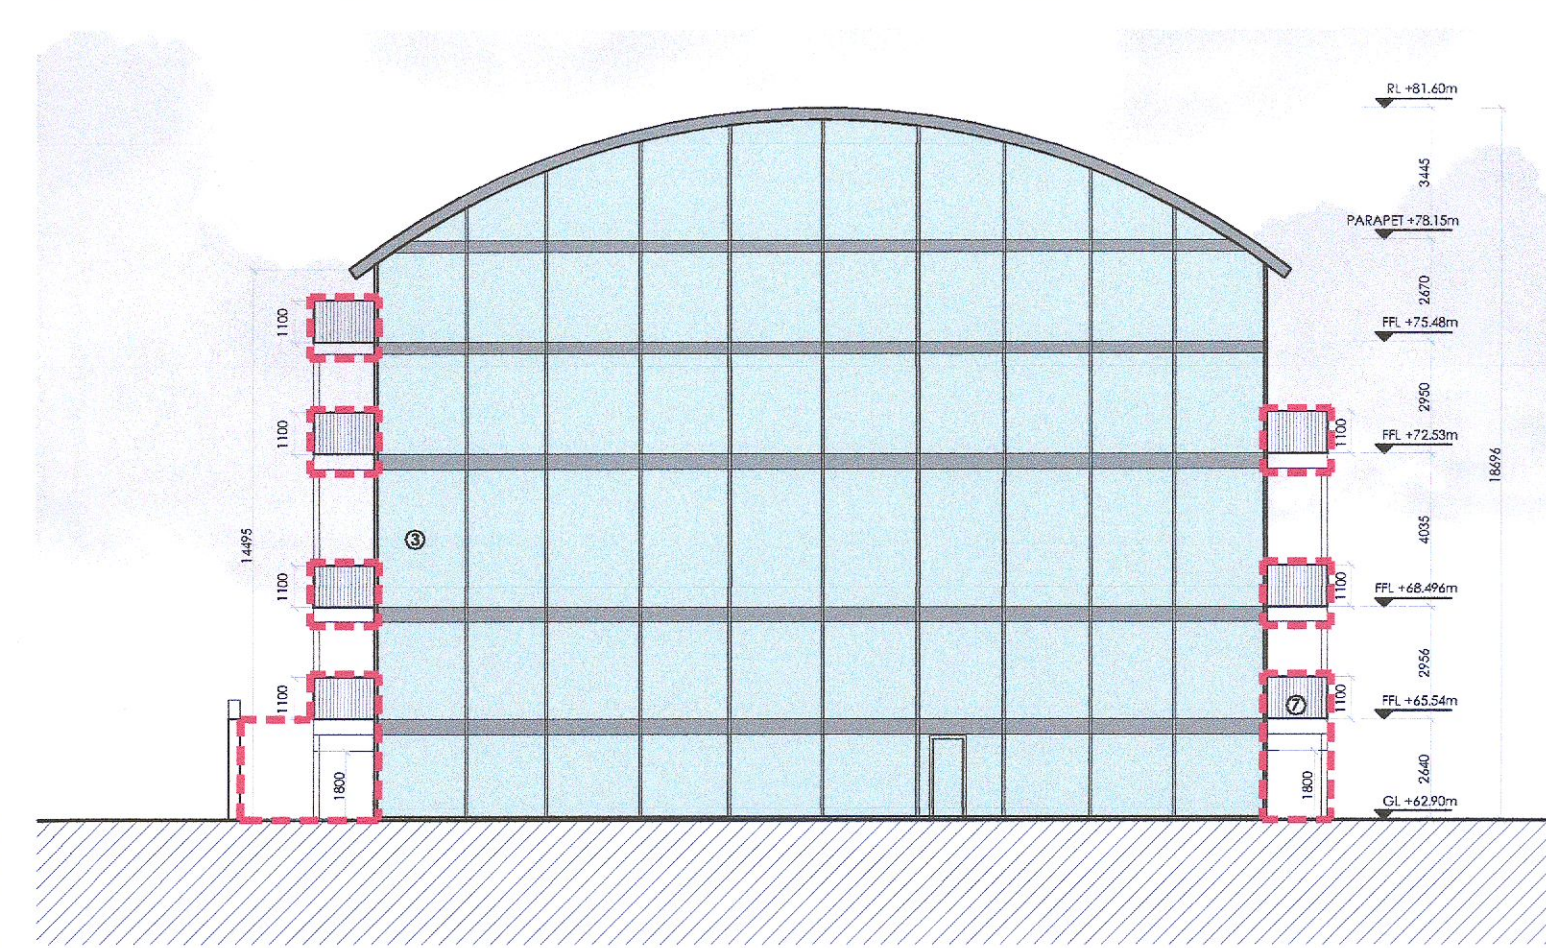


PROPOSED FRONT ELEVATION (NORTH FACING)
1:200

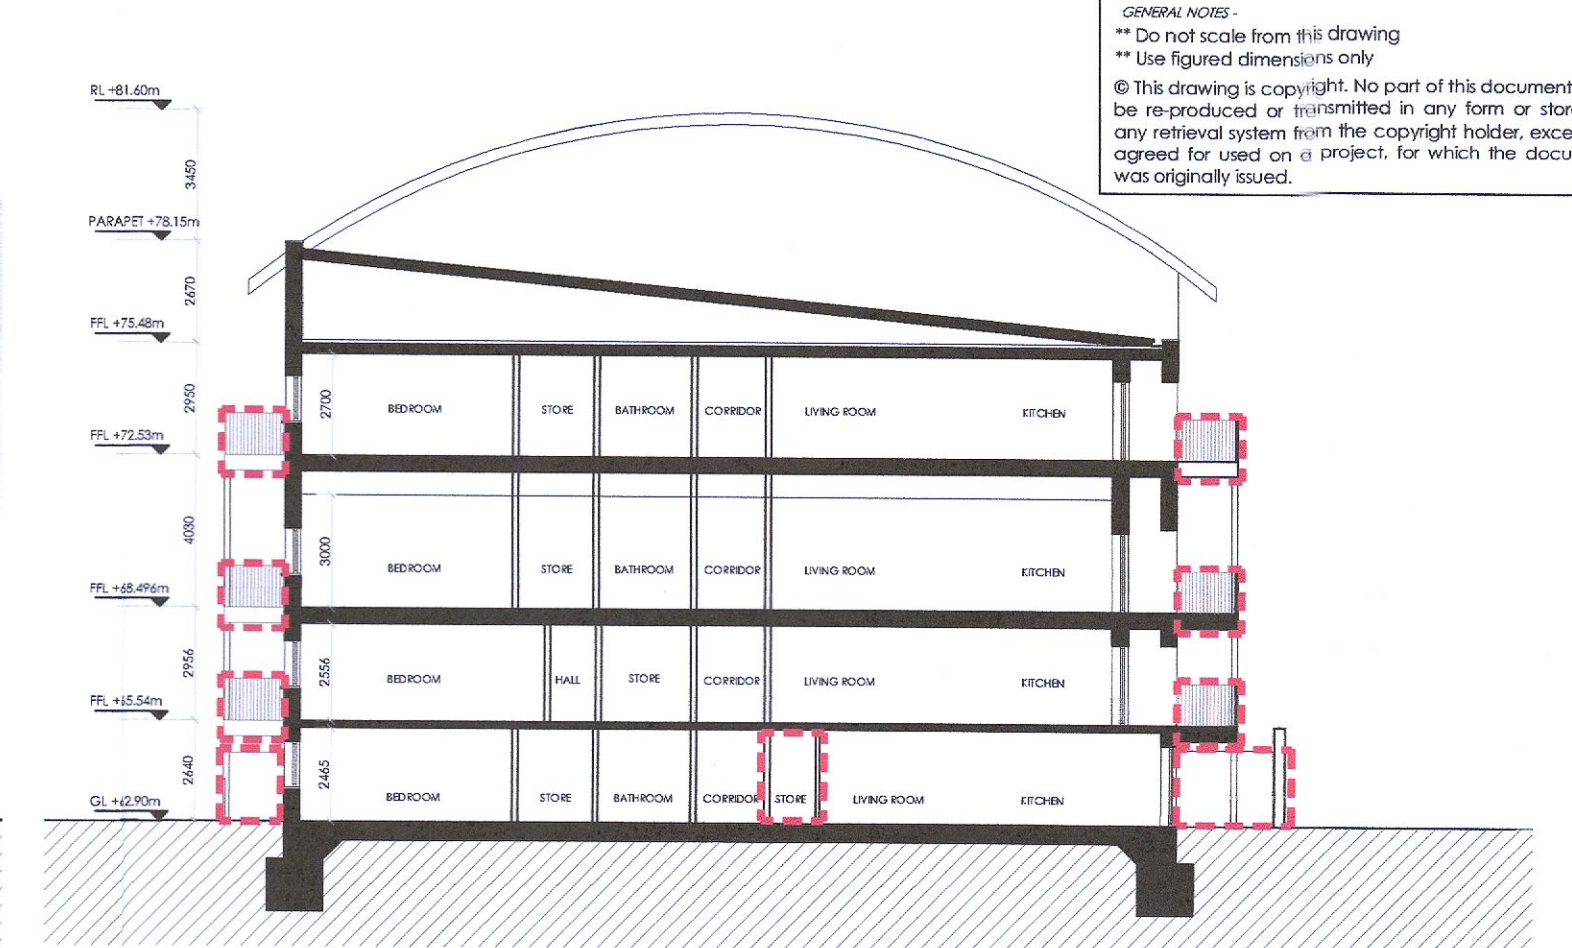

PROPOSED SECTION A-A
1:200

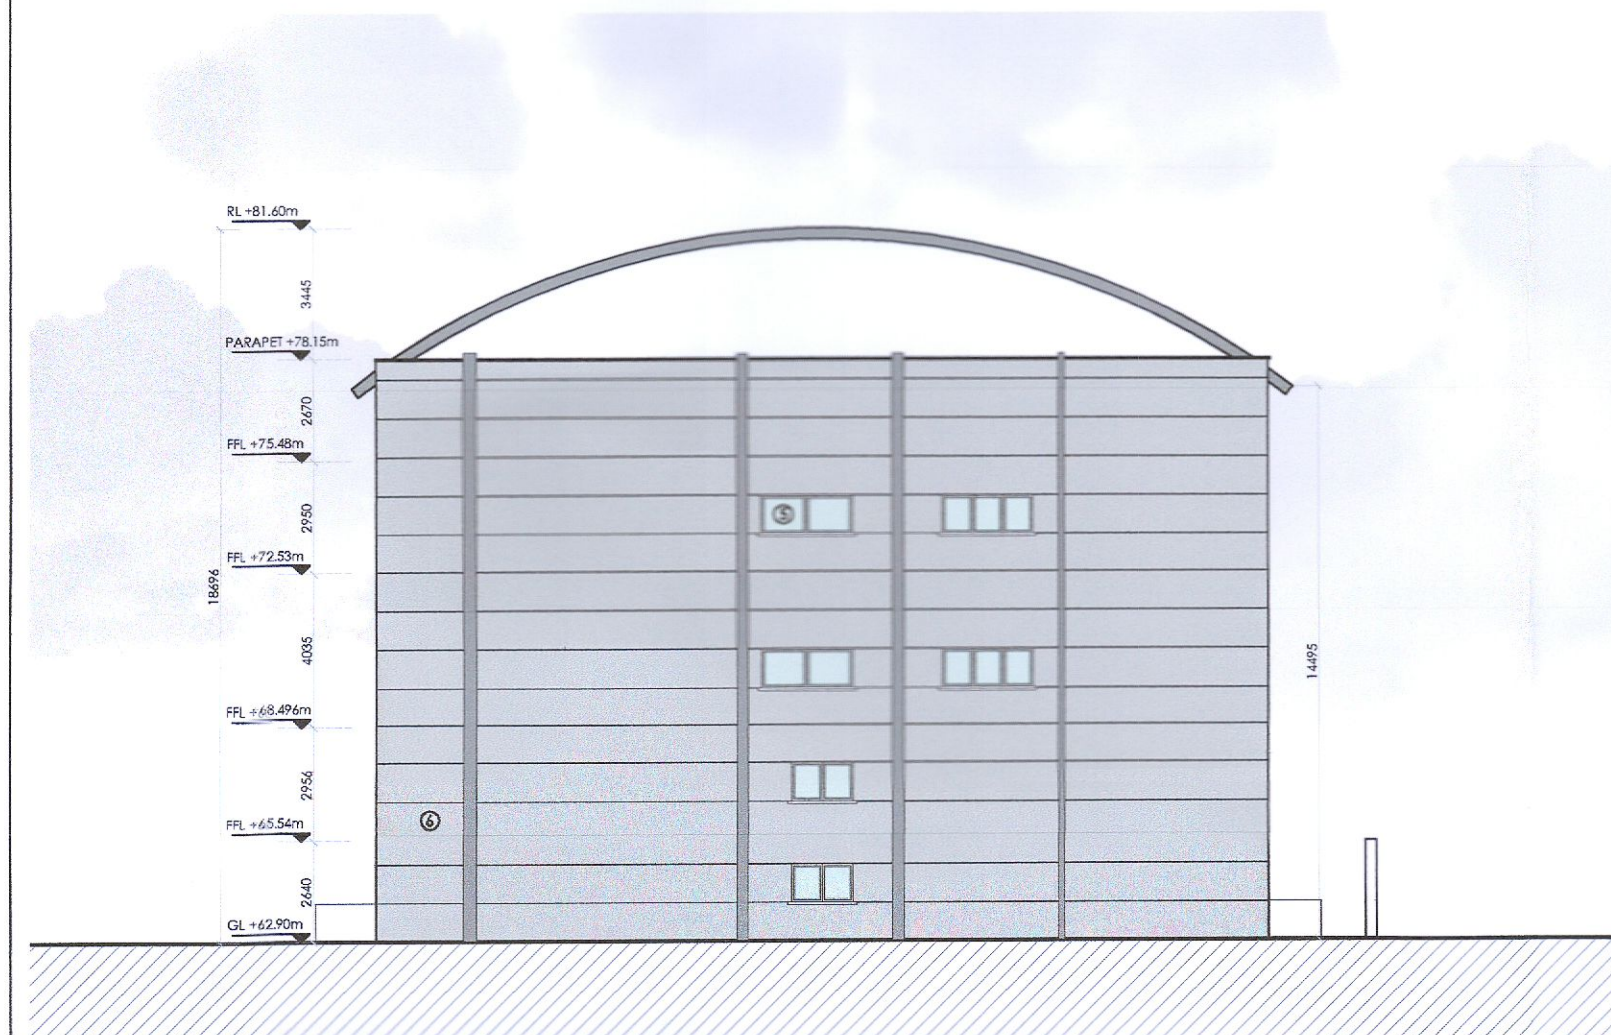

AS BUILT REAR ELEVATION (SOUTH FACING)
1:200

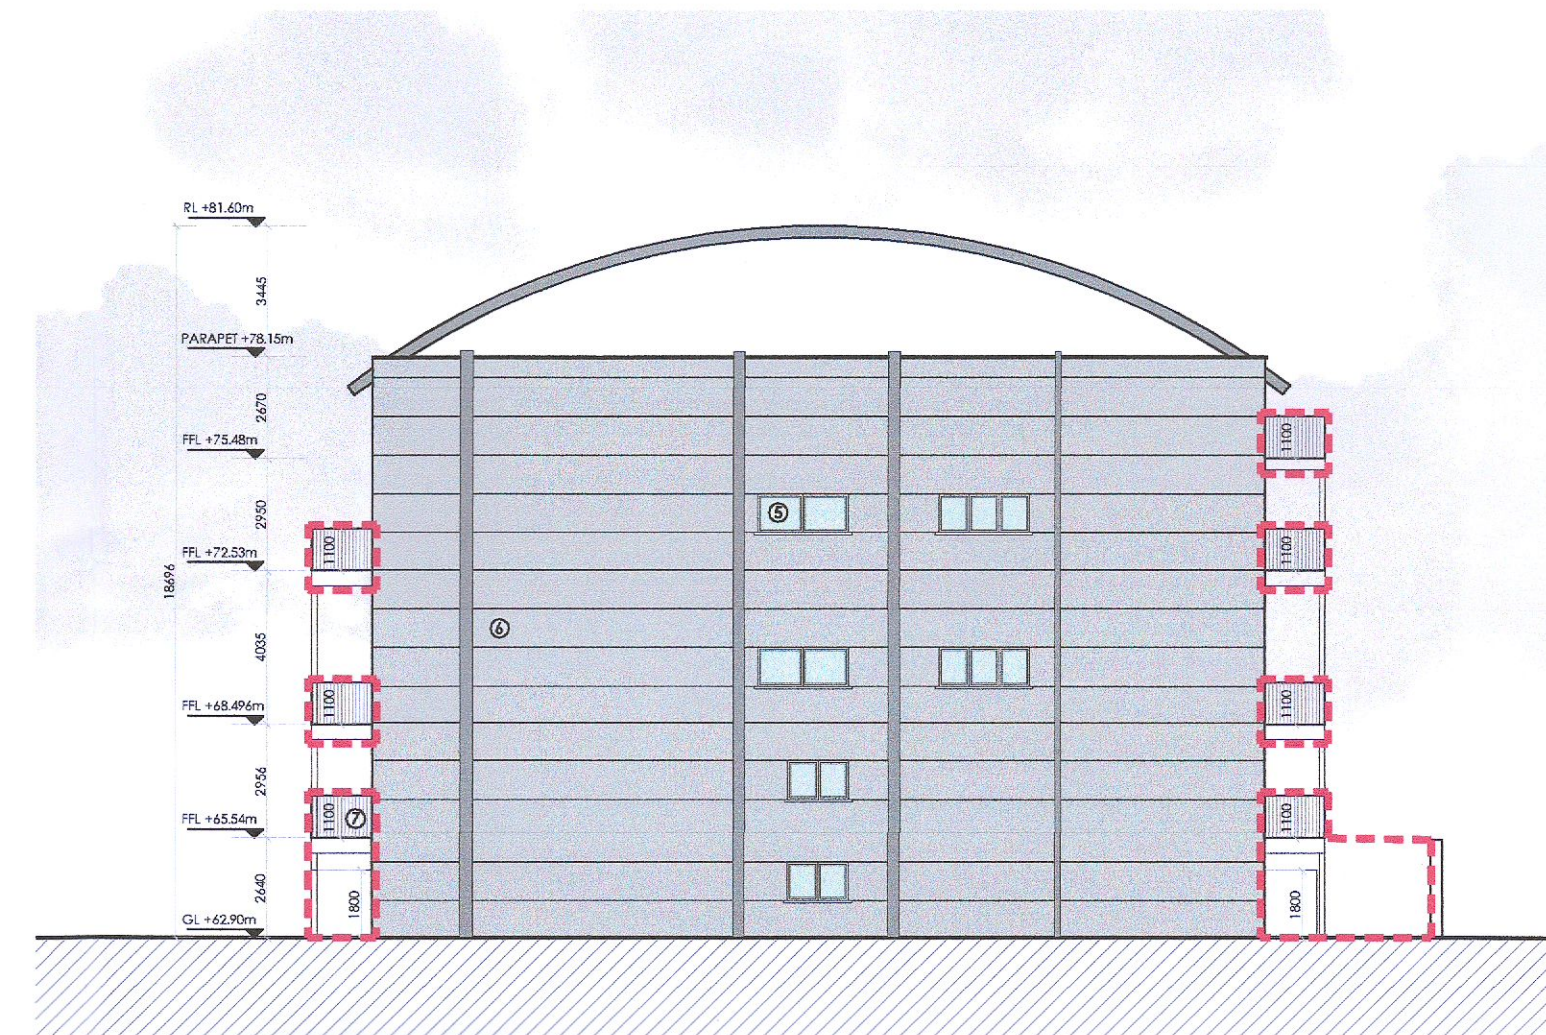

PROPOSED REAR ELEVATION (SOUTH FACING)
1:200



KEY PLAN
NTS



AS BUILT SIDE ELEVATION (EAST FACING)
1:200




PROPOSED SIDE ELEVATION (EAST FACING)
1:200

MATERIAL REFERENCES


- 1 - RED BRICK
- 2 - RENDER
- 3 - STRUCTURAL GLAZING
- 4 - ROOF
- 5 - WINDOWS & DOOR
- 6 - COMPOSITE PANEL
- 7 - BLACK METAL RAILING

NOTE: All materials to be agreed with local authority by way of compliance.

----- PROPOSED CHANGES

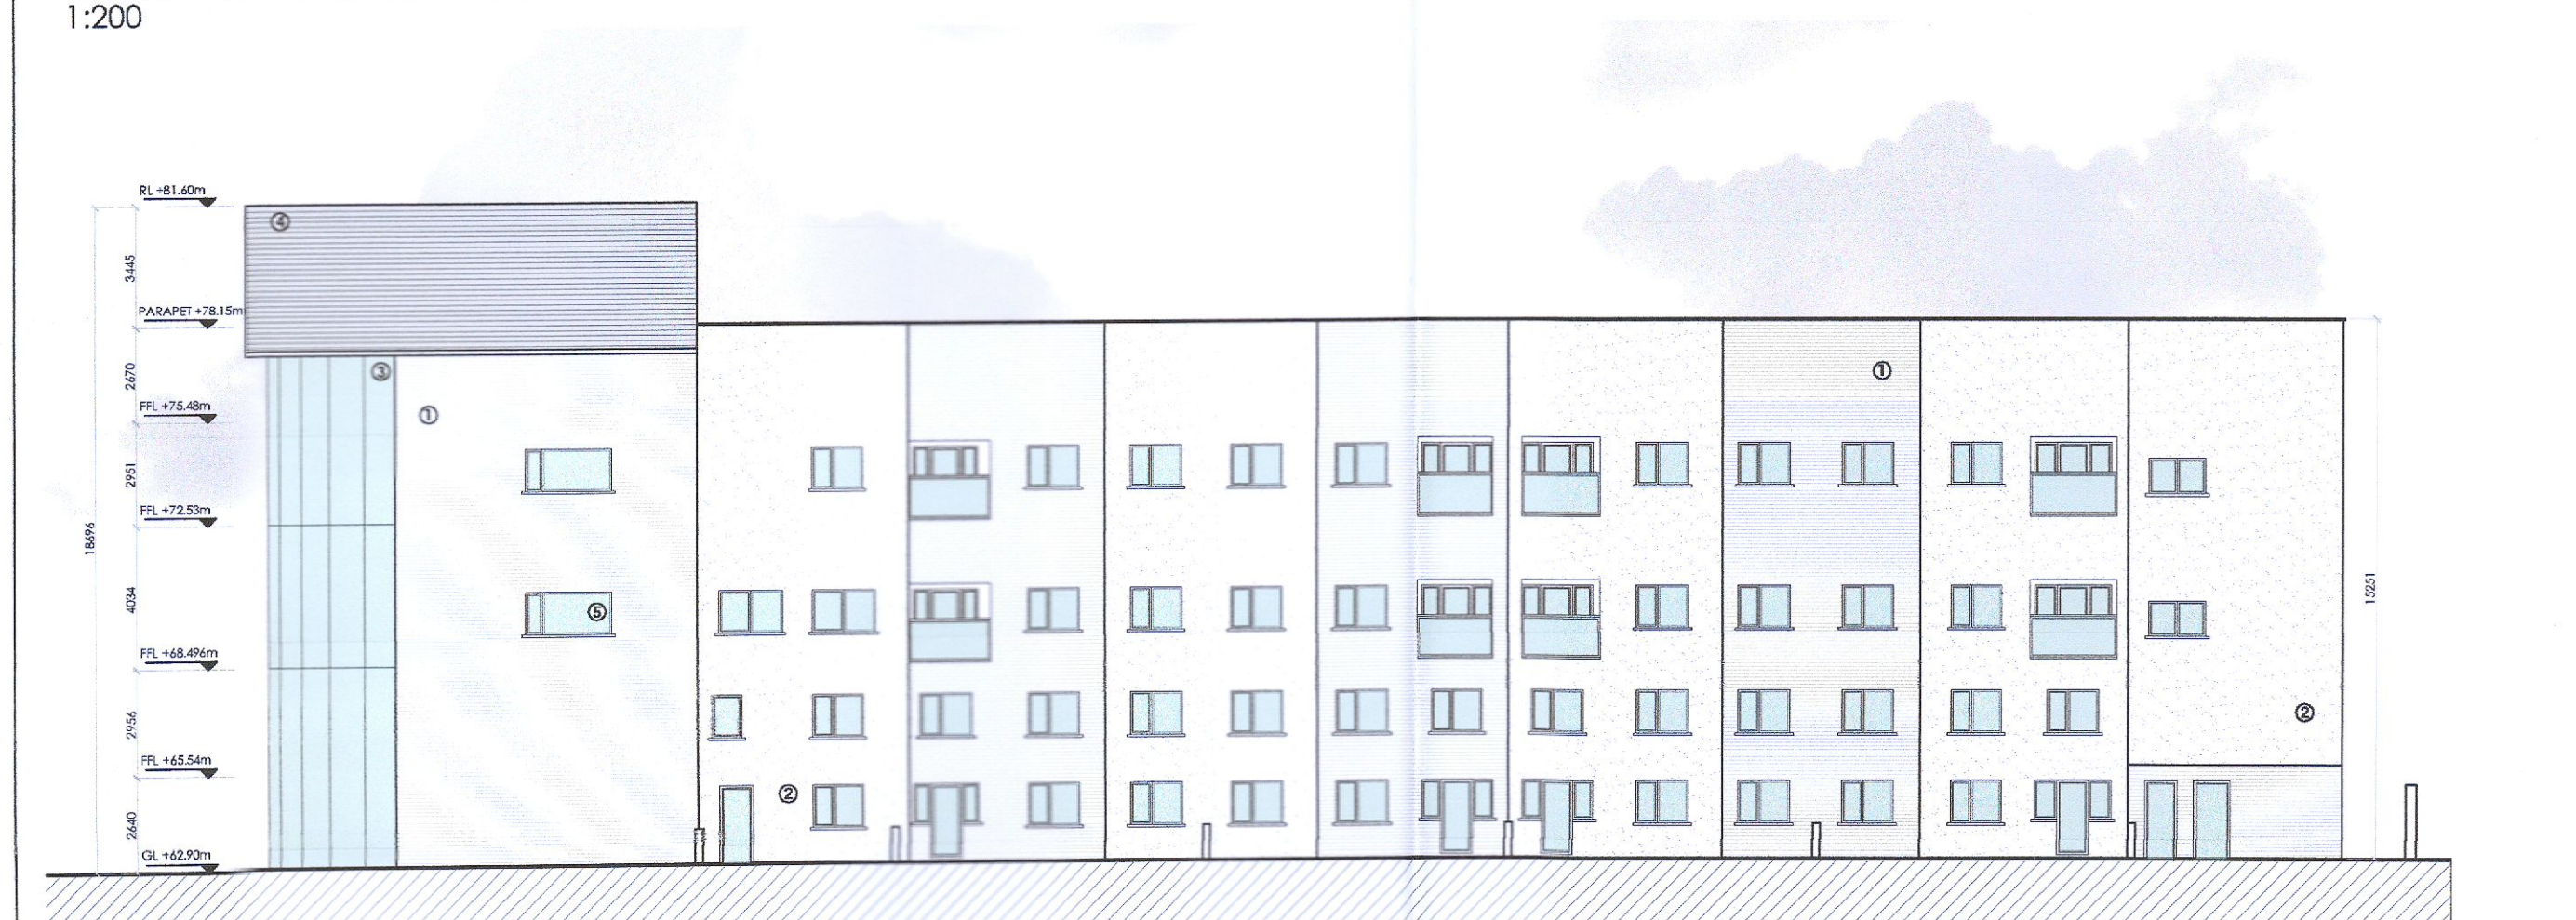

AS BUILT SIDE ELEVATION (WEST FACING)
1:200

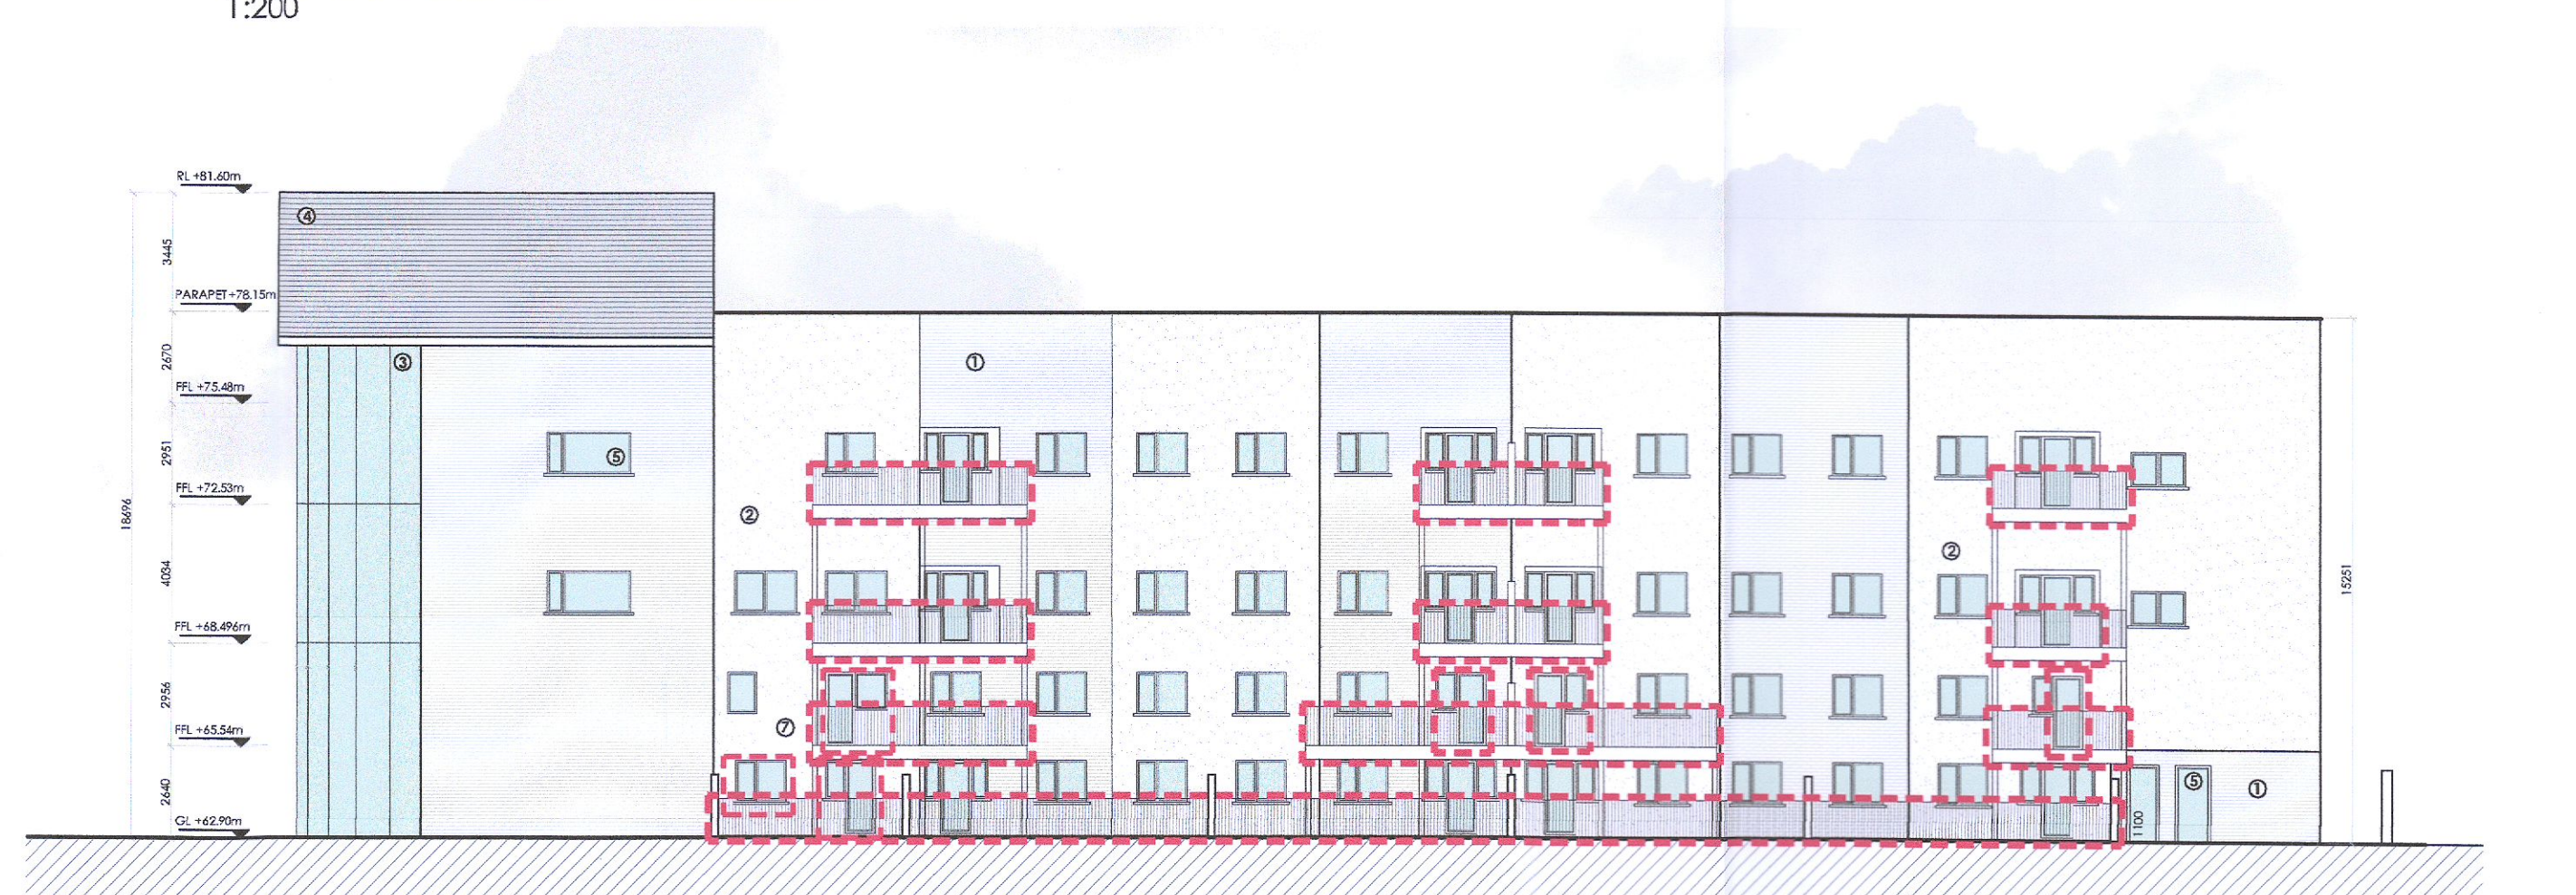

PROPOSED SIDE ELEVATION (WEST FACING)
1:200

PLANNING

ha
 DESIGN STUDIO

36 Mount Street Upper, Dublin D02 Y9B2
 +353 1 524 0709 www.hads.ie

CLIENT
 CAVVIES Ltd.
 PROJECT
 RETENTION APPLICATION AT
 LARKFIELD HOUSE, COLD CUT ROAD
 CLONDALKIN, DUBLIN 22

DWG. TITLE
 AS BUILT AND PROPOSED
 ELEVATIONS & SECTION A-A

SCALE @ A1: 1:100
 DRAWN BY: DM
 CHECKED BY: JH
 PAPER SIZE: A1
 JOB NO: 003-05
 DATE: 27.10.2022

DWG NO. PL-200