




GENERAL NOTES:
 - Do not scale from this drawing
 - Use figured dimensions only
 - This drawing is copyright. No part of this document may be reproduced or transmitted in any form or stored in any retrieval system from the copyright holder, except as agreed for use on a project, for which the document was originally issued.

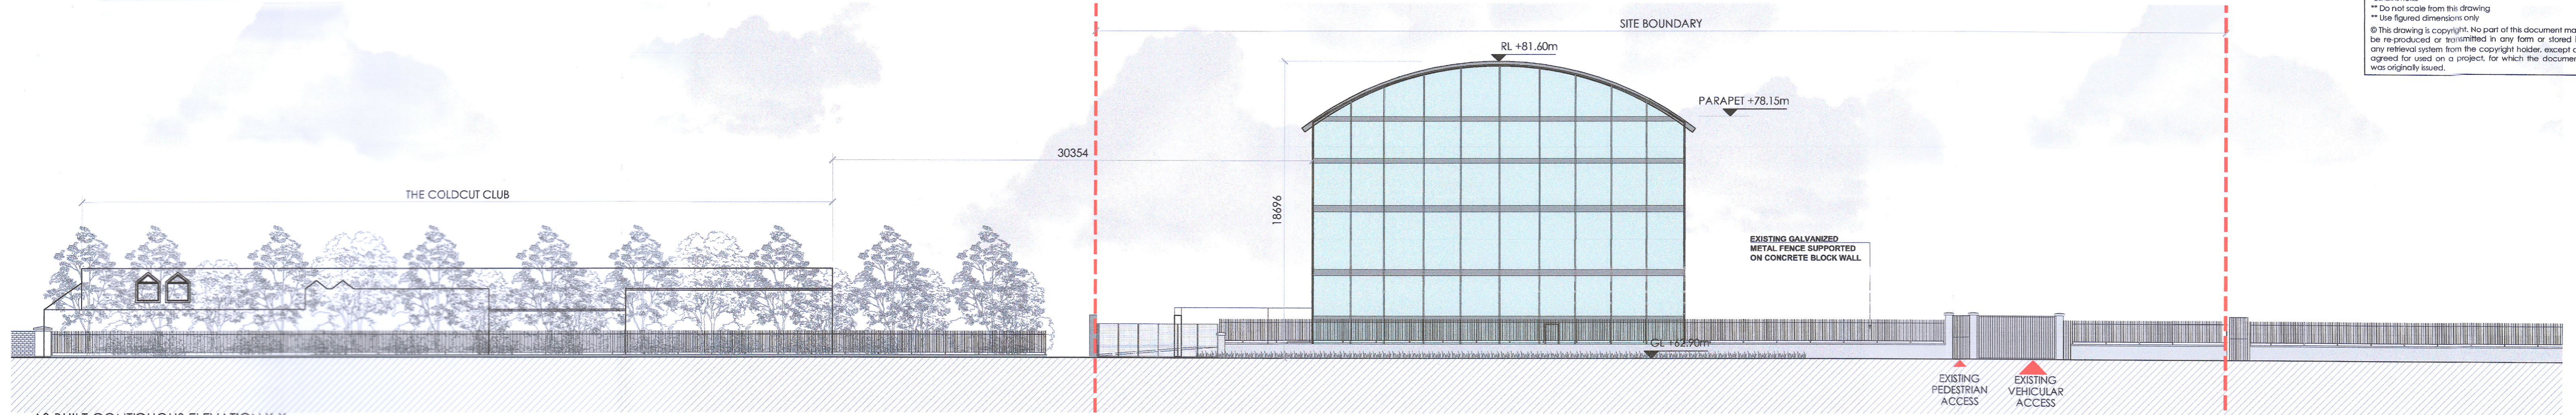


AS BUILT CONTIGUOUS ELEVATION X-X
 1:200

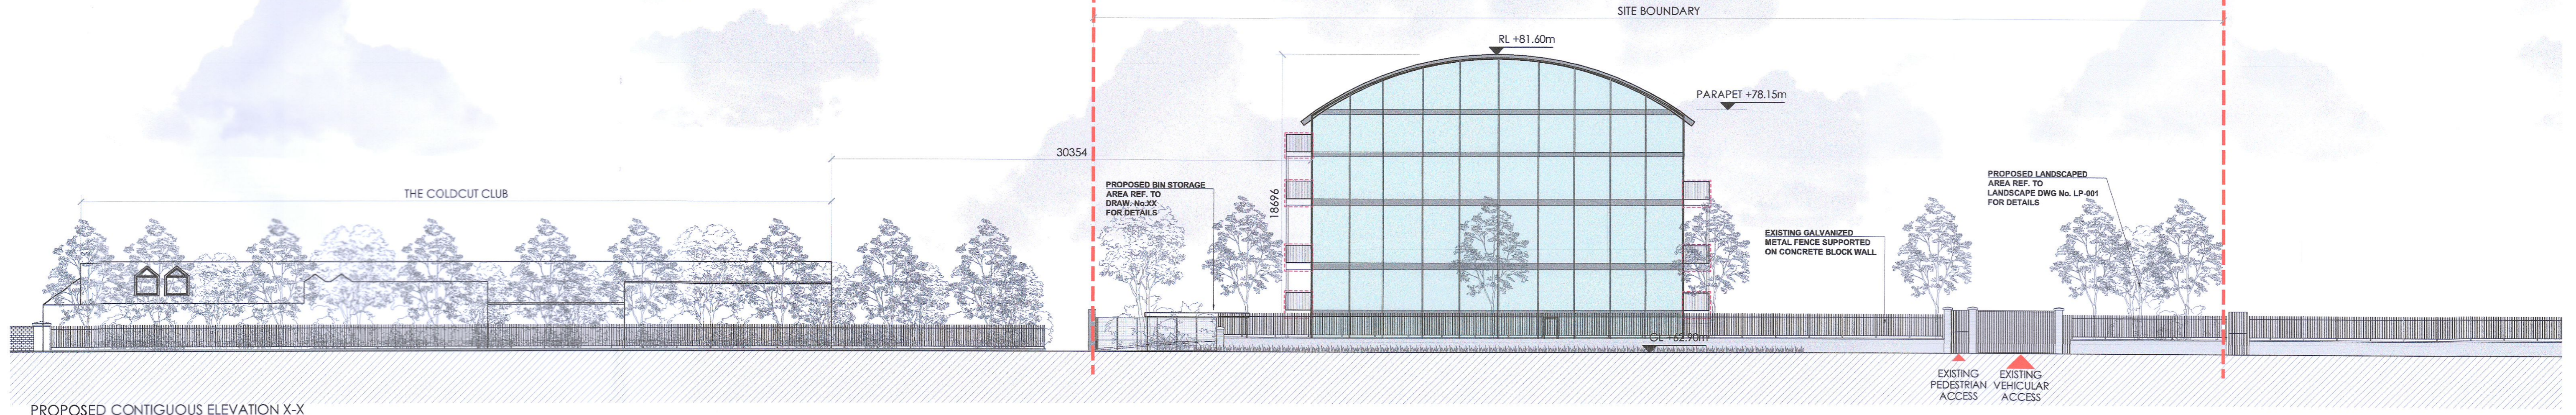


PROPOSED CONTIGUOUS ELEVATION X-X
 1:200

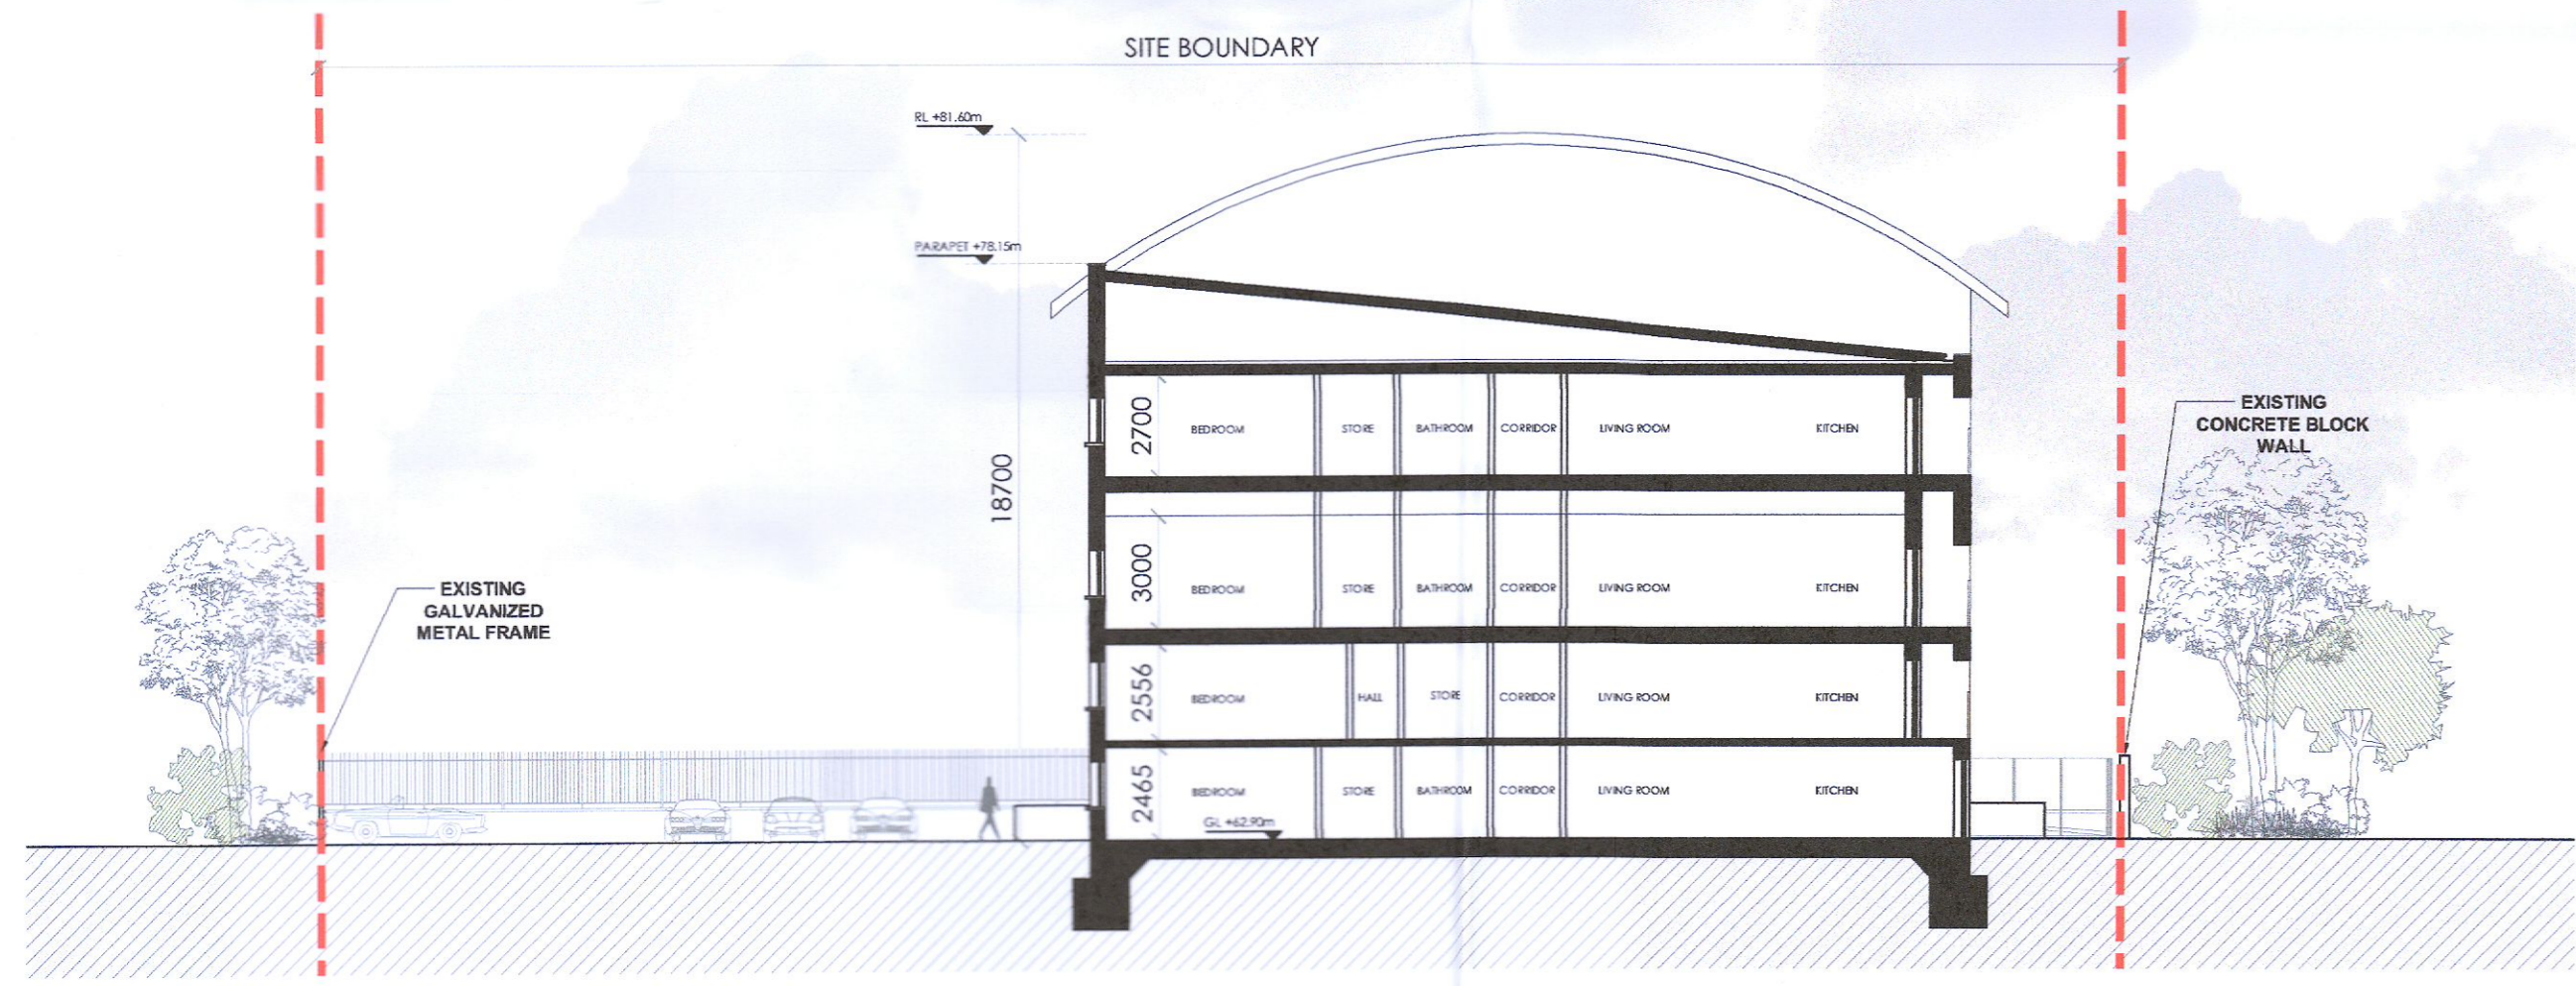

EXISTING SITE SECTION Y-Y
 1:200

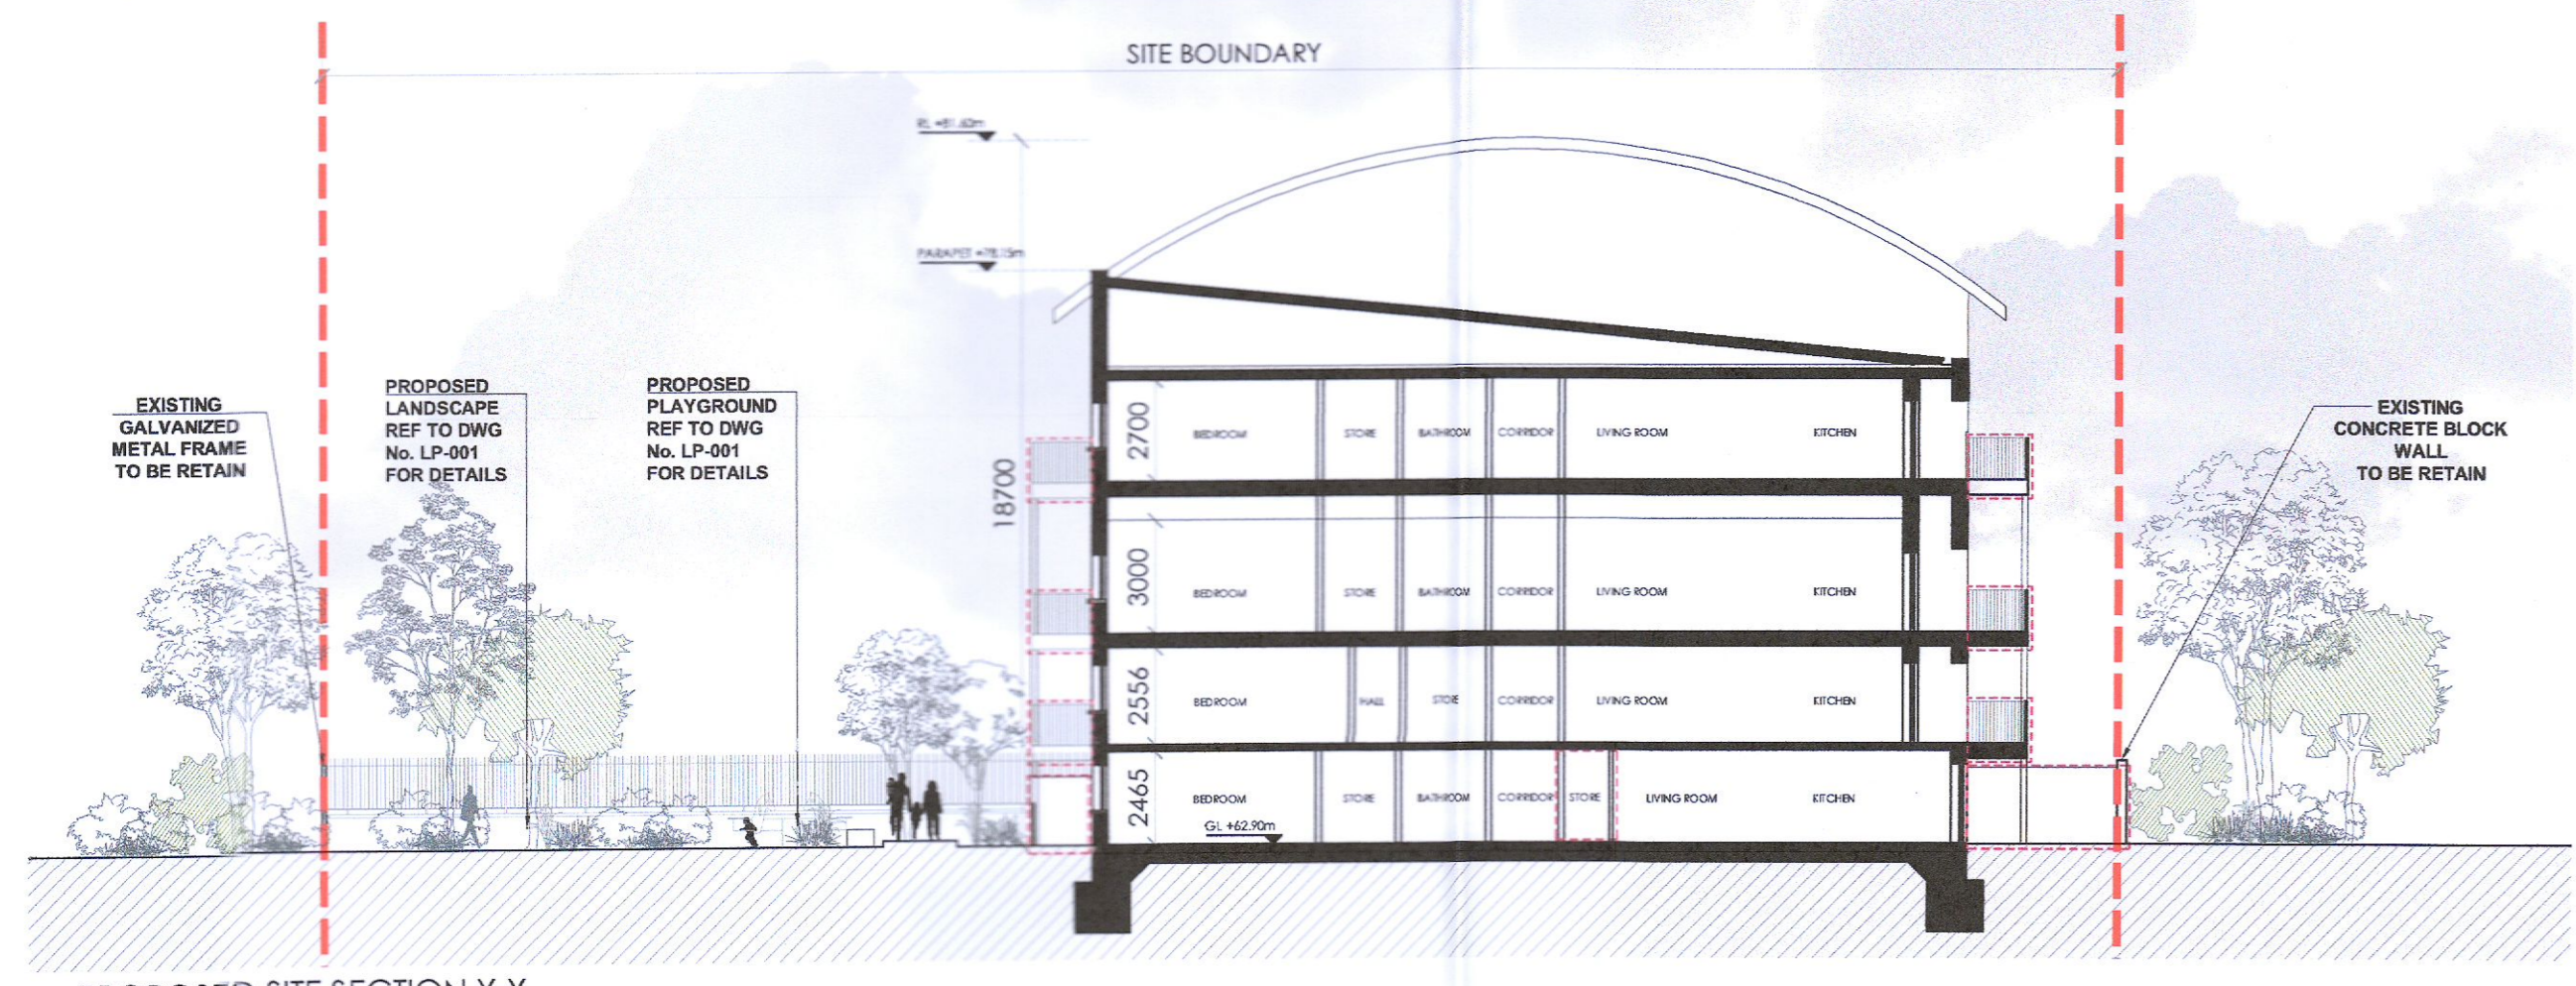

PROPOSED SITE SECTION Y-Y
 1:200

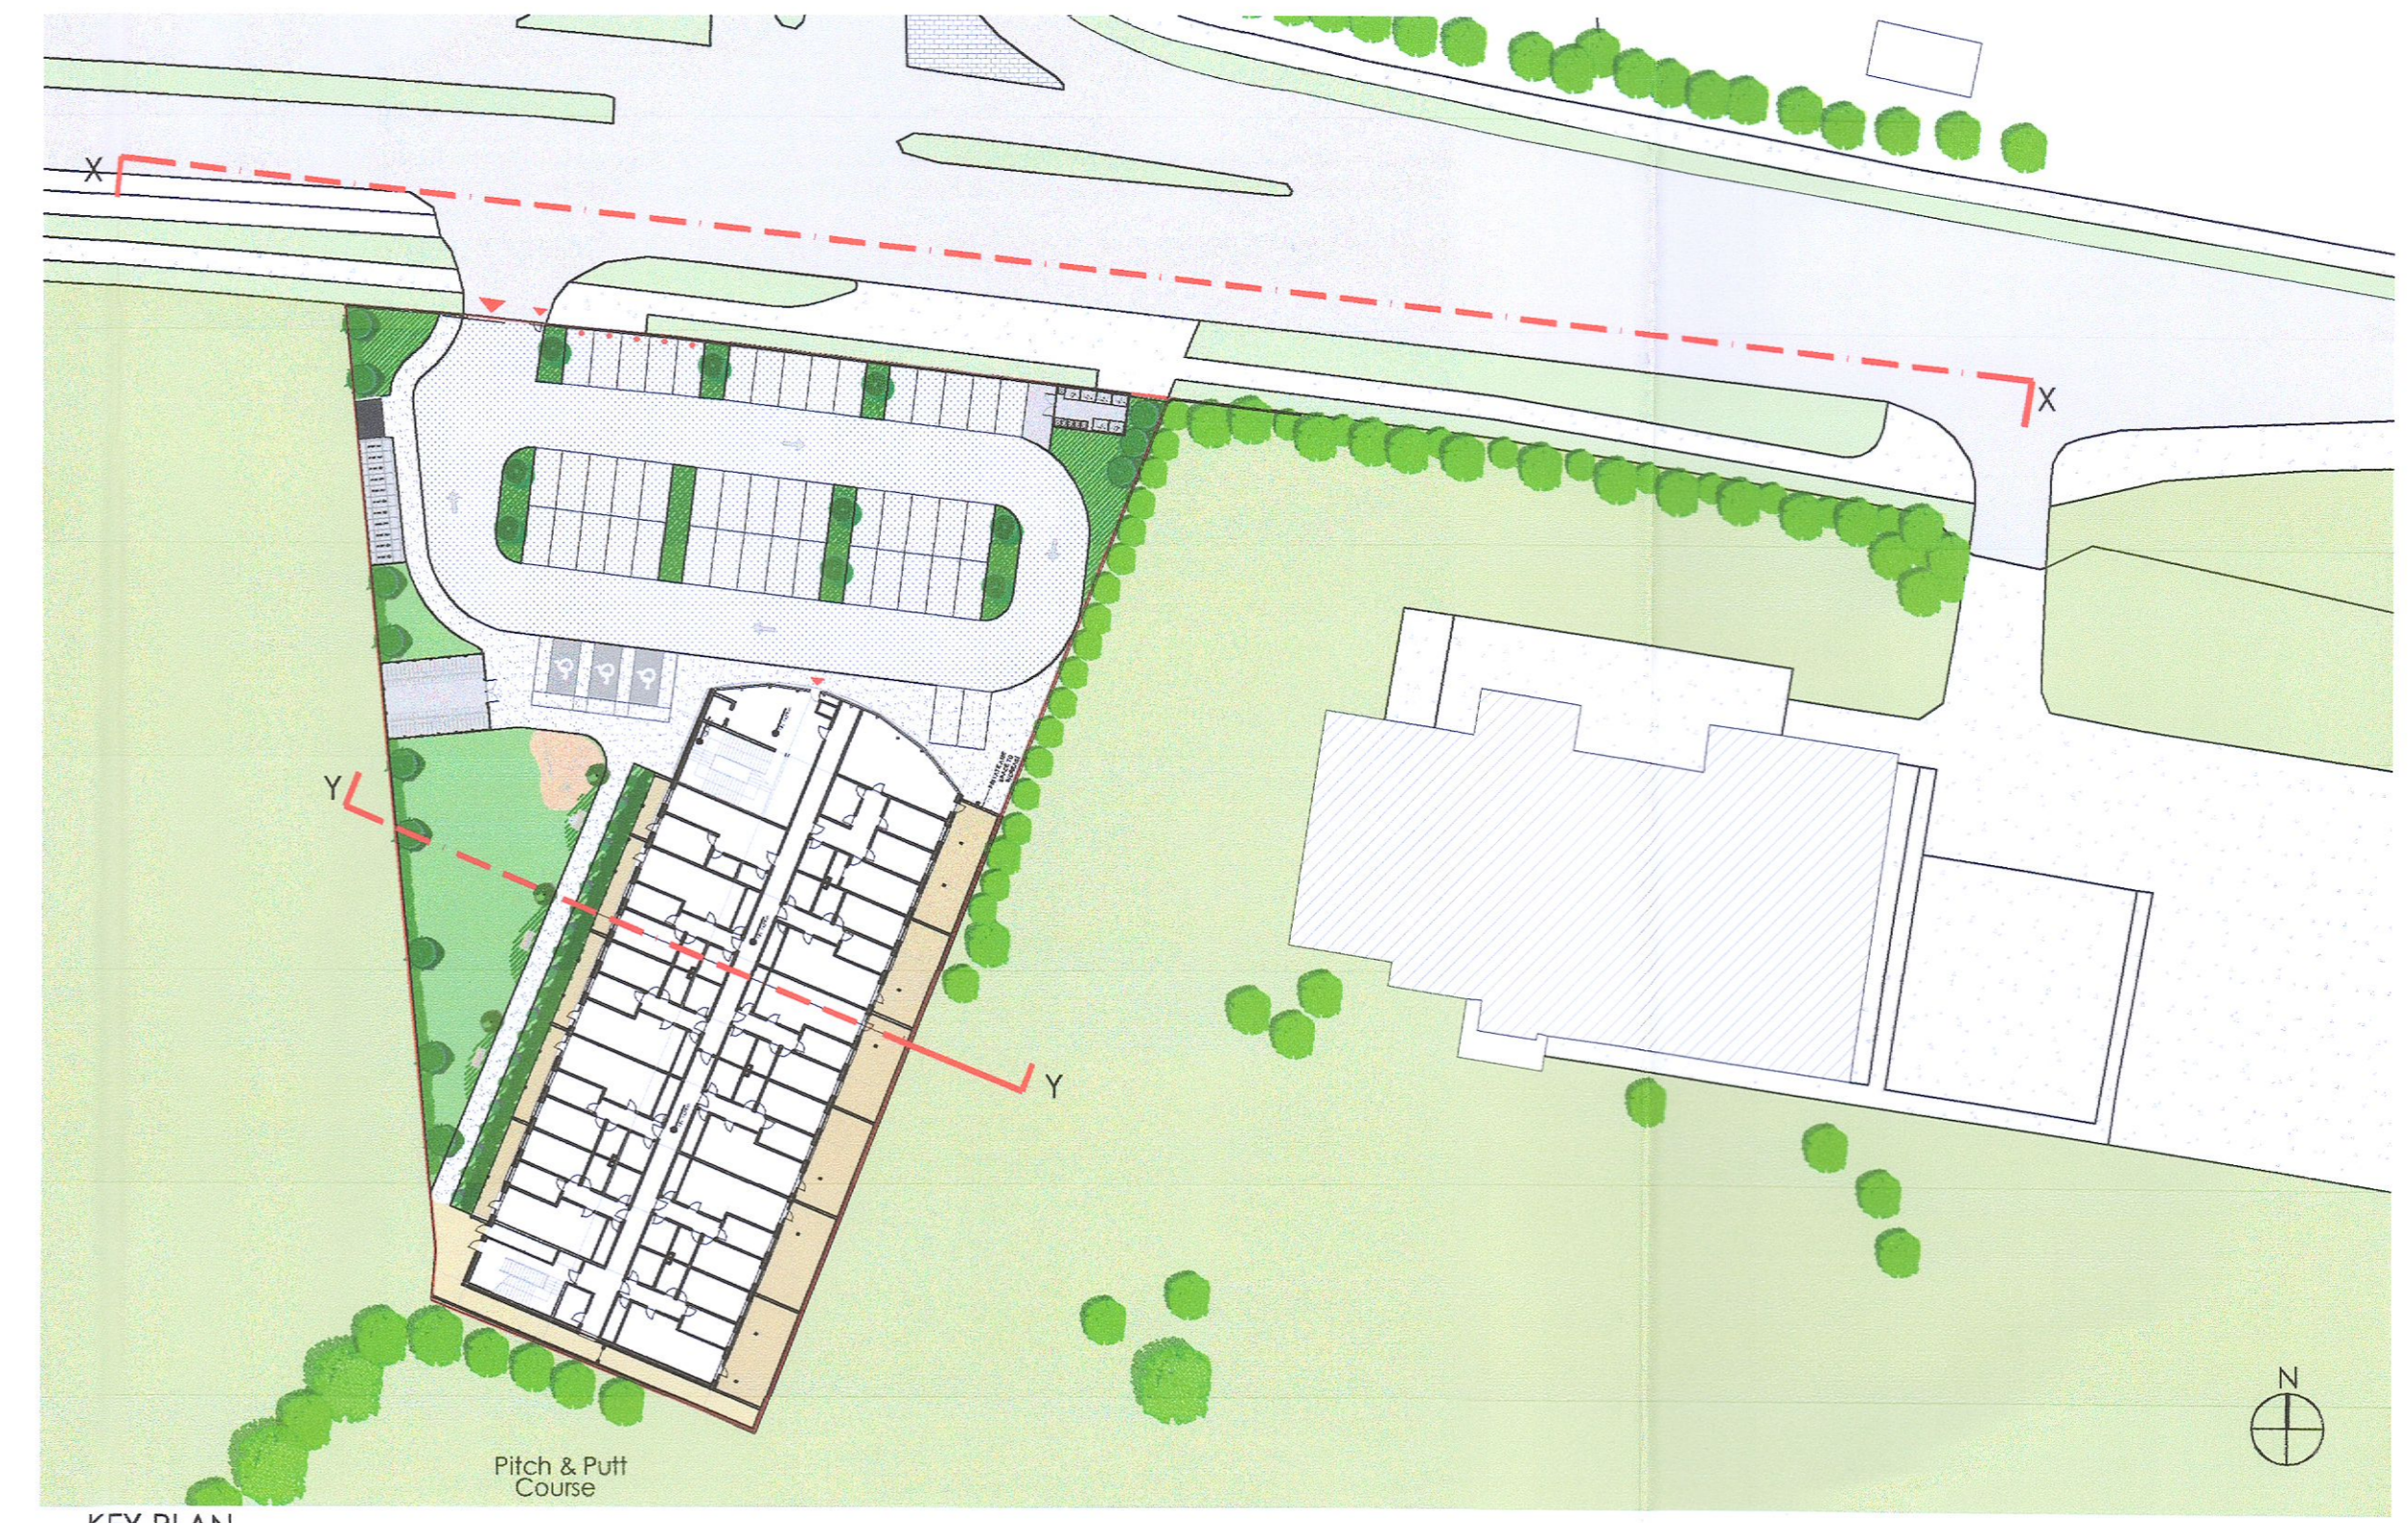

KEY PLAN
 NTS

Proposed changes

Rev Initial Date Revision Description

PLANNING



36 Mount Street Upper, Dublin D02 Y9B2
 +353 1 524 0709 www.hads.ie

CLIENT
 CAVVIES Ltd.
 PROJECT
 RETENTION APPLICATION AT
 LARKFIELD HOUSE, COLDCUT ROAD
 CLONDALKIN, DUBLIN 22

DWG. TITLE
 AS BUILT AND PROPOSED CONTIGUOUS
 ELEVATIONS X-X & SITE SECTION Y-Y

SCALE @ A1:	DWA
DRAWN BY:	JH
CHECKED BY:	AT
PAPER SIZE:	003-05
JOB NO.:	27.10.2022
DATE:	PL_201
DWG NO.:	REVISION: