



Parklands Parade

Parklands Parade


01 As Built Duplex Block A - Ground Floor Plan
PA-100 1:200

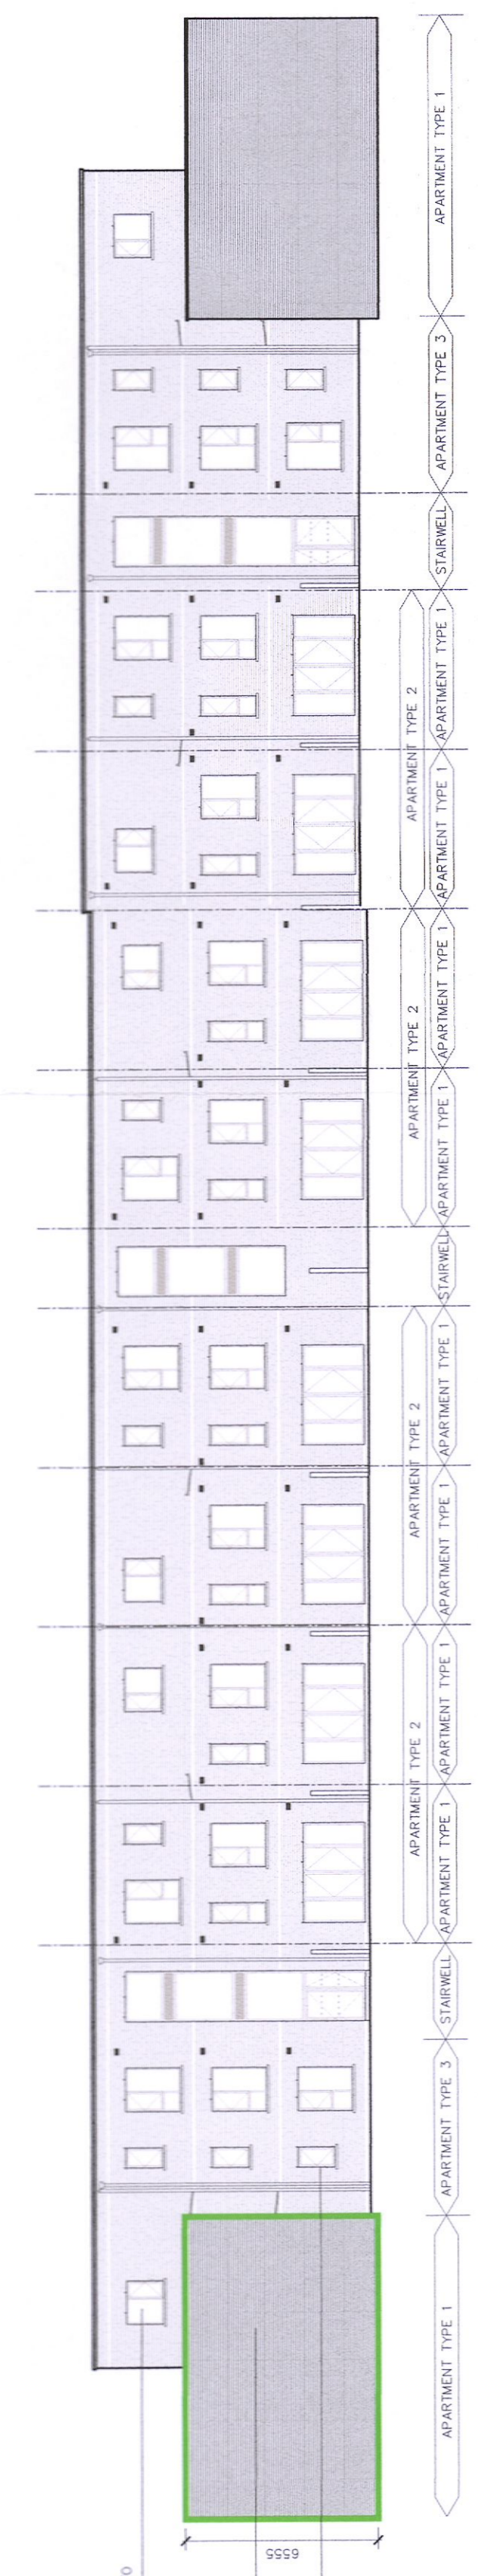

05 As Built Duplex Block A - North Elevation
PA-100 1:200

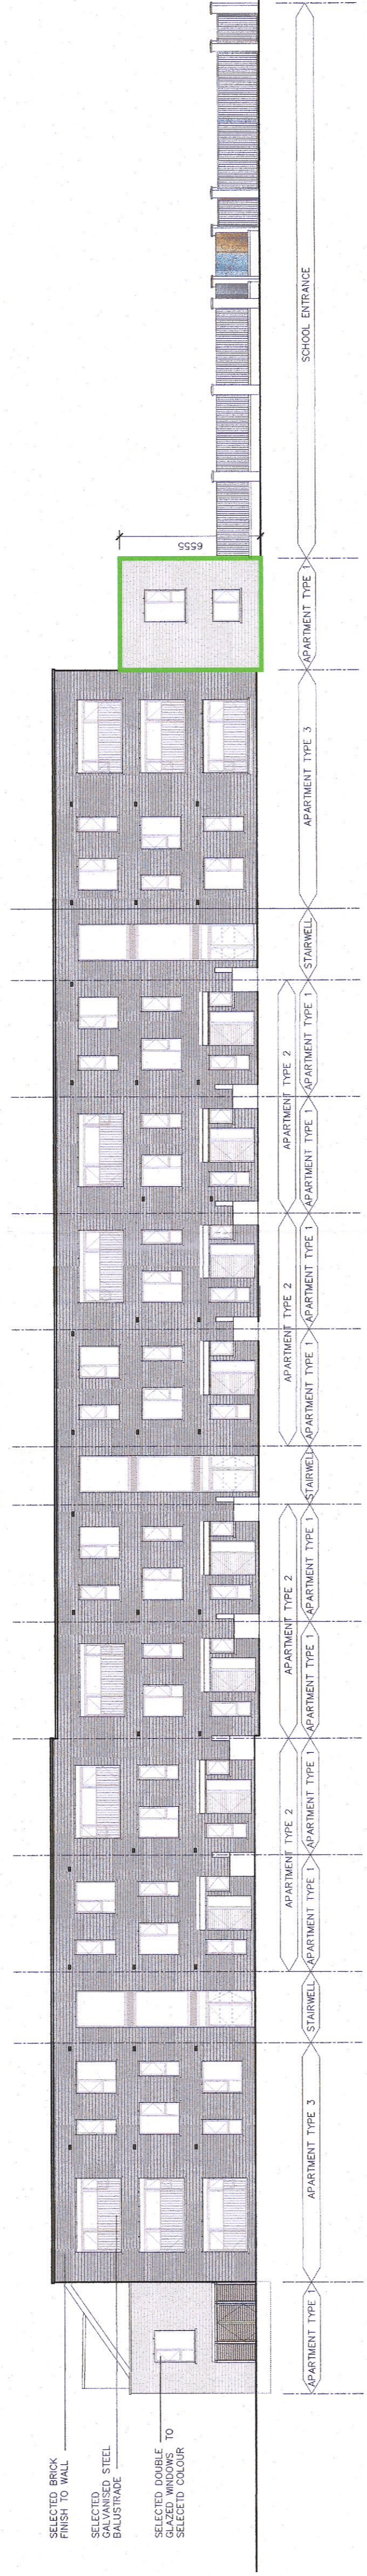


06 As Built Duplex Block A - Contextual South Elevation
PA-100 1:200

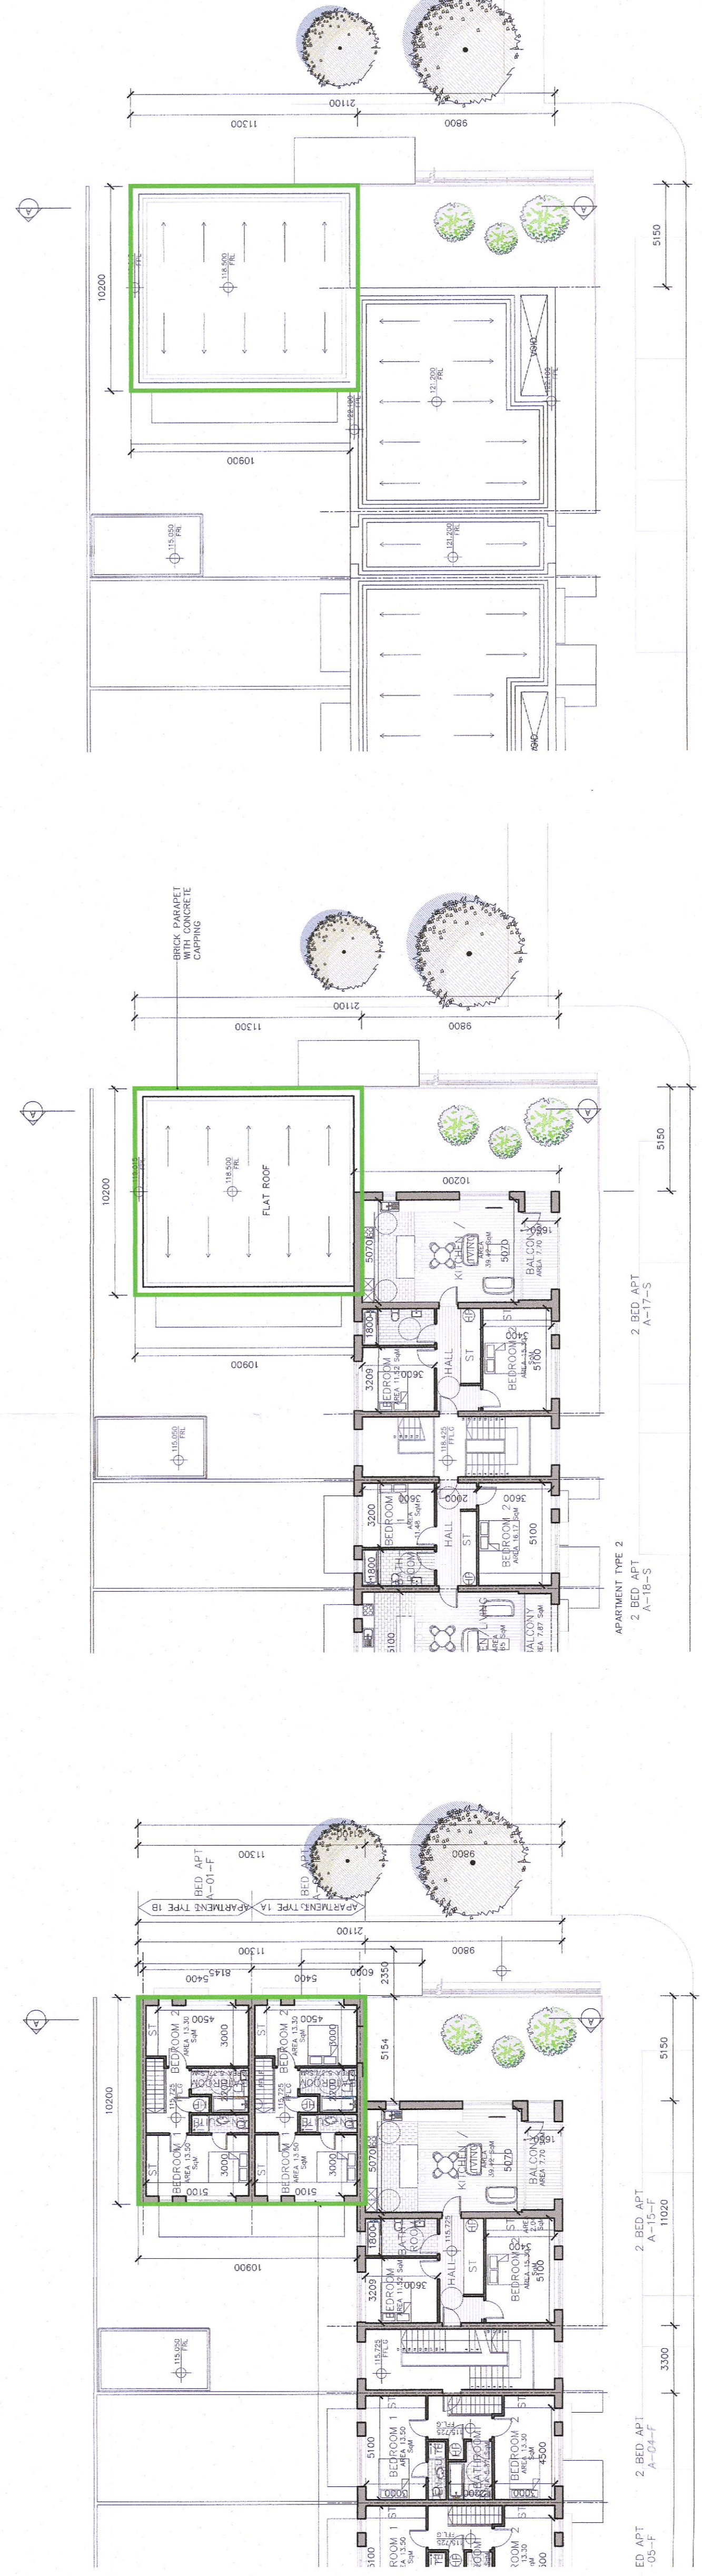


02 As Built Duplex Block A - First Floor Plan
PA-100 1:200

03 As Built Duplex Block A - Second Floor Plan
PA-100 1:200

04 As Built Duplex Block A - Roof Plan
PA-100 1:200

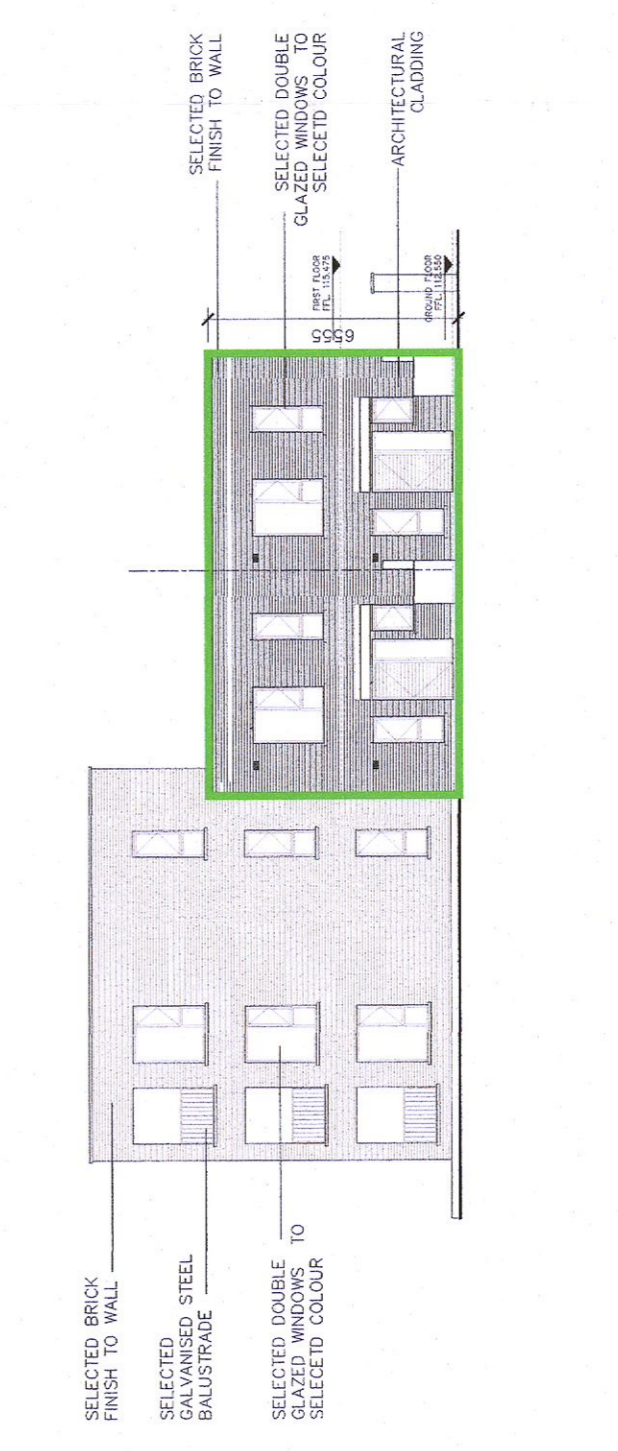

07 As Built Duplex Block A - East Elevation
PA-100 1:200

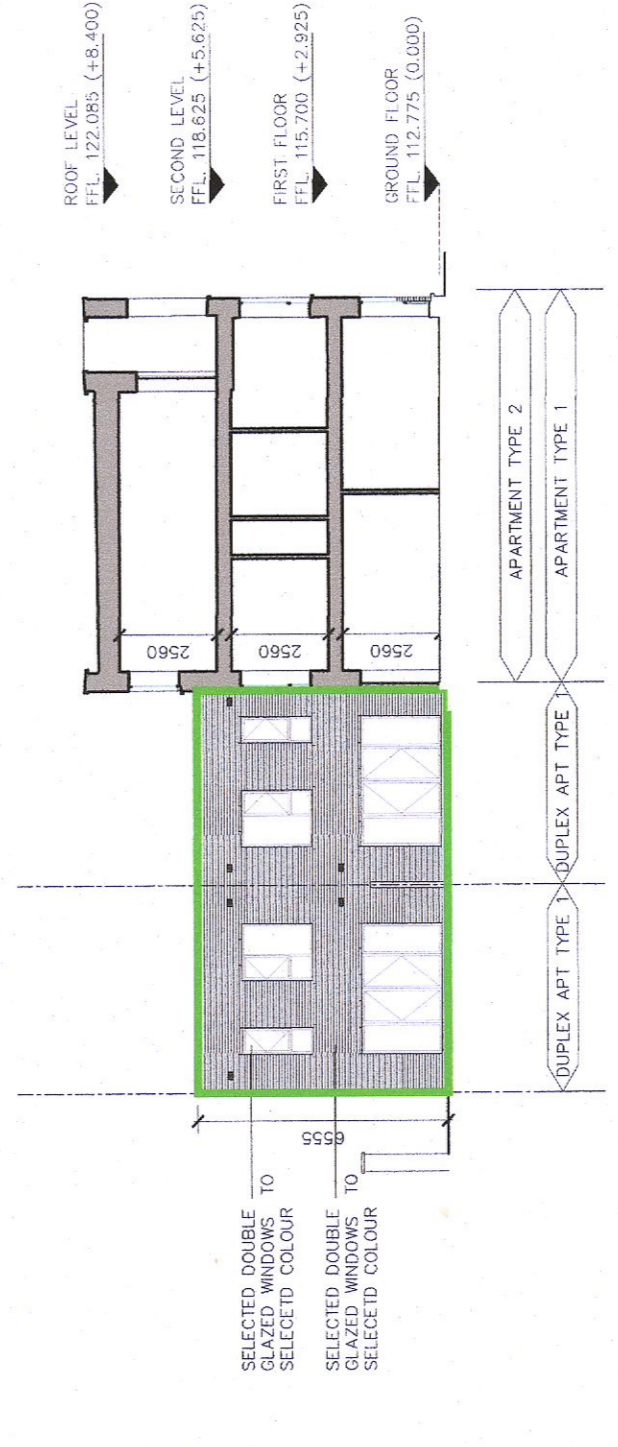



08 As Built Duplex Block A - Section A-A
PA-100 1:200

ISSUED FOR INFORMATION ONLY, NOT FOR CONSTRUCTION

NOTES:
Do not scale from this drawing.
Any discrepancies found on site to be reported to Darmony Architects immediately.
Any discrepancies found on drawings to be reported to Darmony Architects immediately.
Refer to engineers drawings for structural details.
All dimensions sized to blockwork.

Rev.	Description.	Date.	Initials.

DRAWING KEY
 Area the Subject of this Application

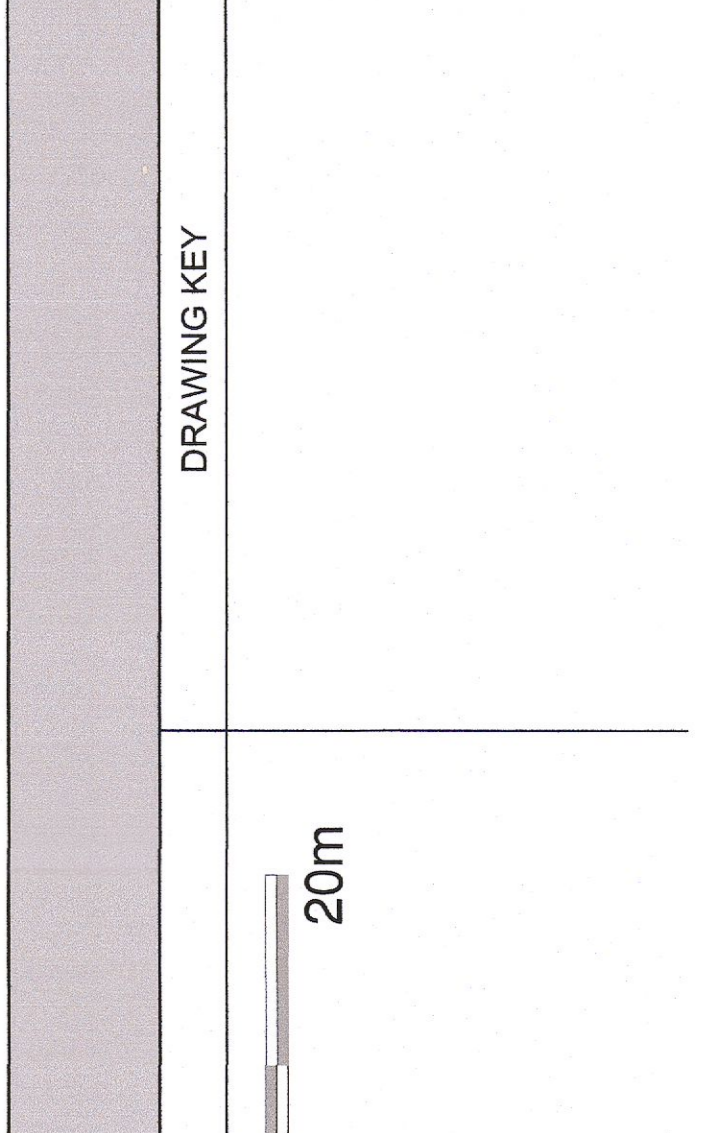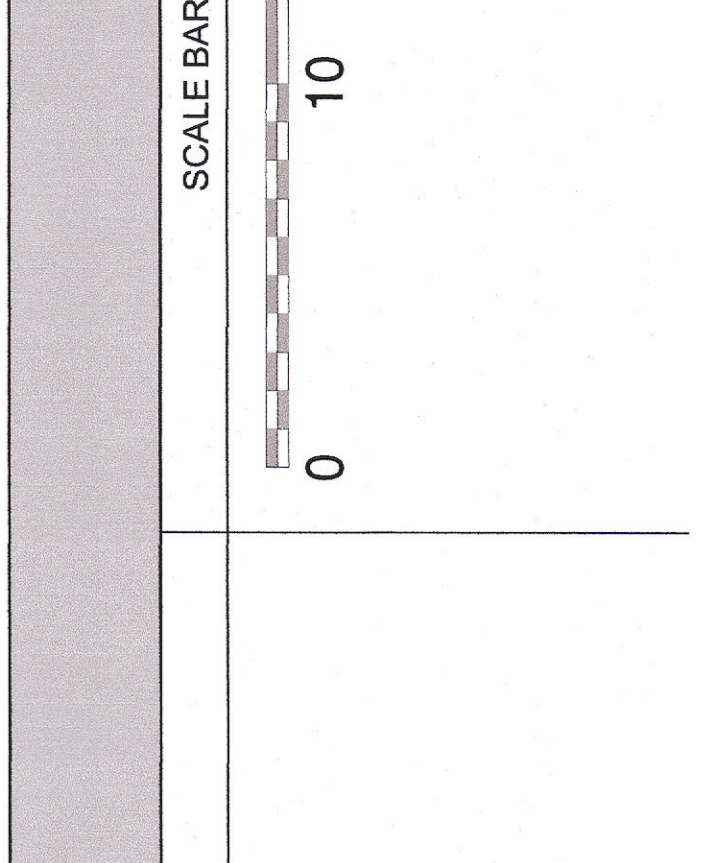

creative innovative flexible
architecture
 91 Townsend Street, Dublin 2
 353 1 672 9907
 info@darmonyarchitecture.com
 darmonyarchitecture.com

Rev. No. Scale Date Dm. By Issue
 1:200 @ A0 26/09/2022 Sean Barrett PLANNING
 Chkd. By
 Jennifer Lynch

Project: Retention of Change of Use at Parklands Parade
 Parklands, Saggart, Co. Dublin
 Title: AS BUILT DUPLEX BLOCK A PLANS, ELEVATIONS, CONTEXTUAL ELEVATION, & SECTION
 Client: Greenacre Residential DAC
 Dwg. No. Job No.
 PA-100 20040