




NO 16 ALLENTON ROAD REAR SHED ROOF PLAN

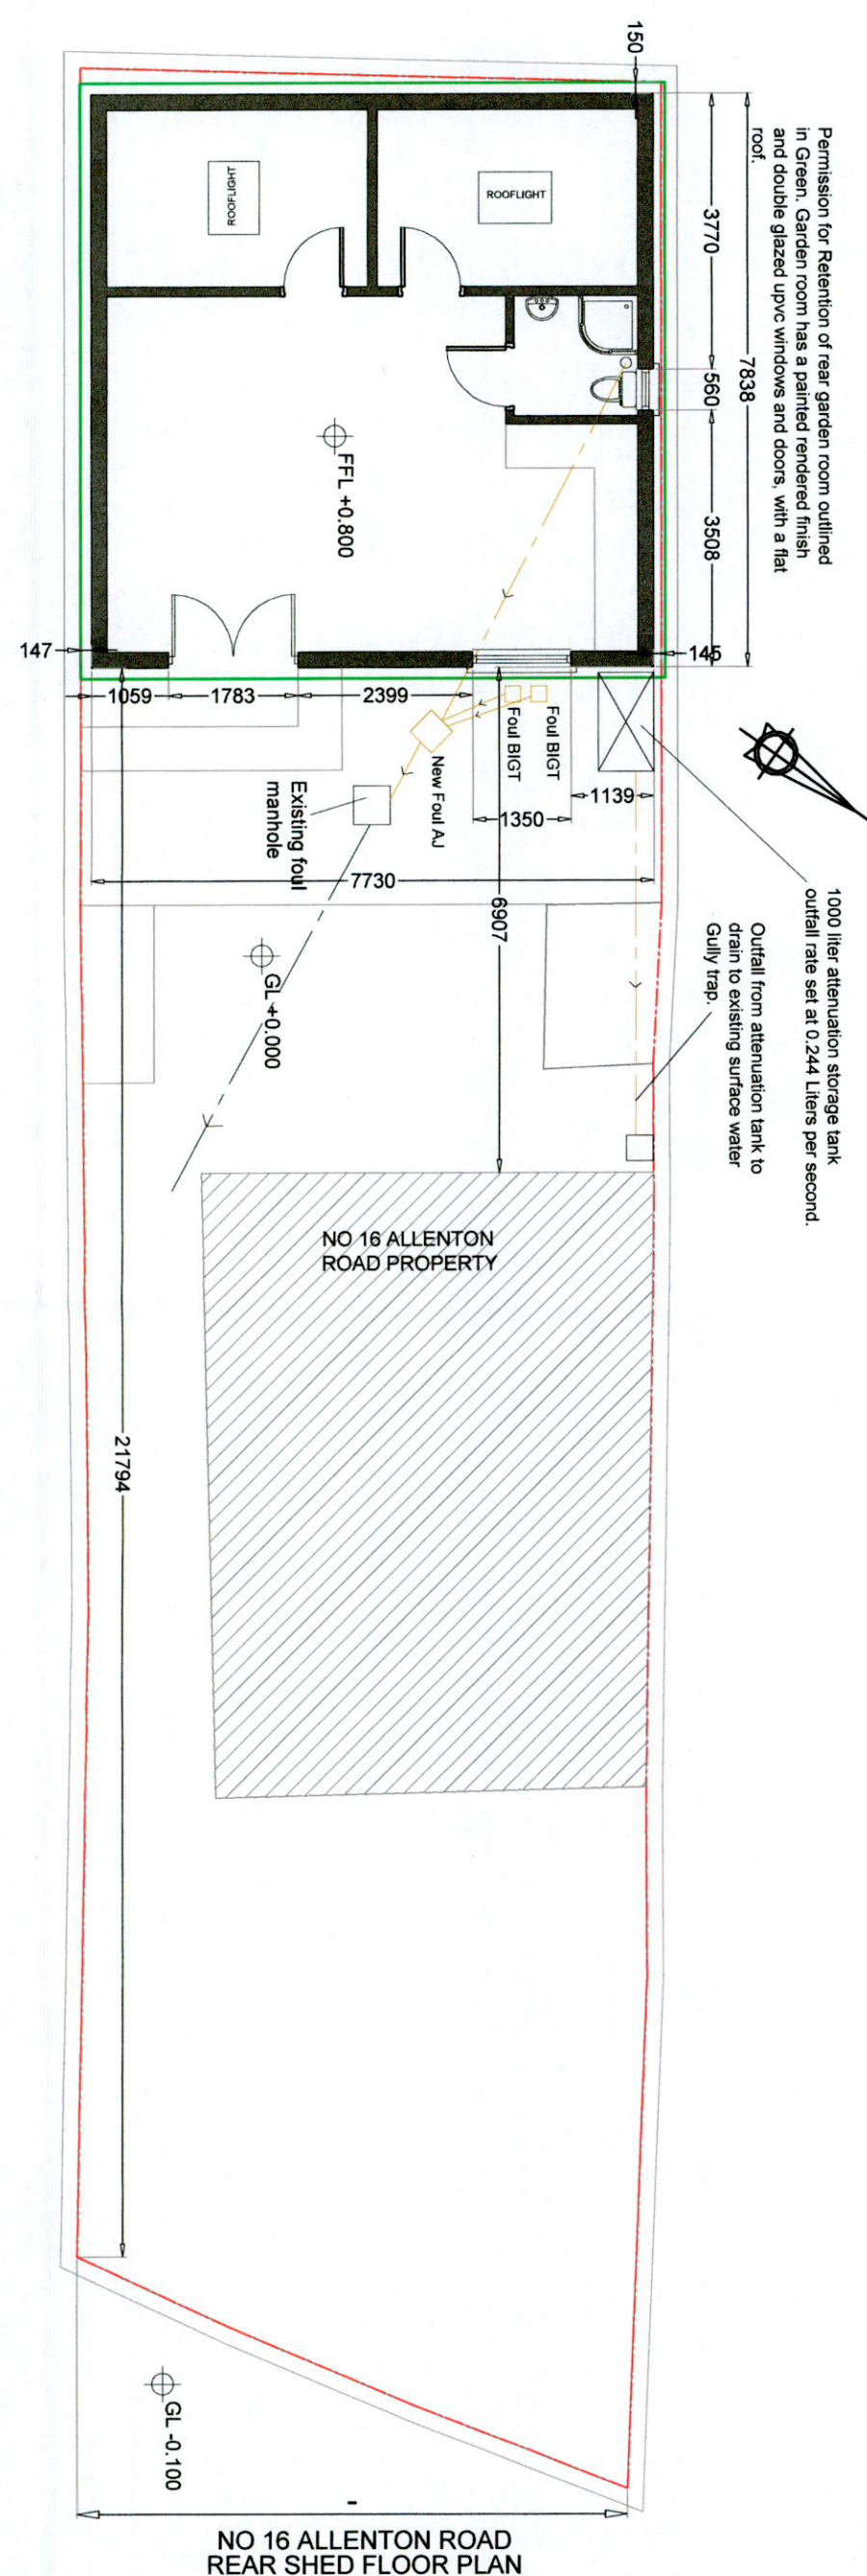

NO 16 ALLENTON ROAD REAR SHED FLOOR PLAN

Permission for Retention of rear garden room outlined in Green. Garden room has a painted rendered finish and double glazed upvc windows and doors, with a flat roof.

1000 liter attenuation storage tank outfall rate set at 0.244 Liters per second. Outfall from attenuation tank to drain to existing surface water Gully trap.

SCHEDULE OF AREAS:

EXISTING HOUSE	-80 sqm
REAR SHED	-54 sqm
TOTAL	-134 sqm

Extent of Application OUTLINED in Green
SDCC Ref No. S9016

Note: No scaled measurements to be taken from this drawing, all dimensions to be checked on site. Scales are indicative only and can vary with different printing and photocopying methods. This is not a construction document. Reproduction and distribution without written permission is prohibited.

Project	Permission For Retention A Shed to the rear of No. 16 Allenton Road, Ballycogh, Dublin 24		
Drawing Title	As Built Plans		
Issue No.	22.17	Draw No.	PL-003
Rev	0-3	Rev Date	
Scale	1:100	Drawn	Ian Furlong
Date	NOV 2022	Check	

Drawings prepared by
Ian Furlong
DESIGN & DRAFTING SERVICES
Ayle, Cappanahilly, County Tipperary
Phone: 086 5080782
E-Mail: ianfurlong_5@hotmail.com