


CONTIGUOUS ELEVATION - SITE SECTION
Scale 1:200

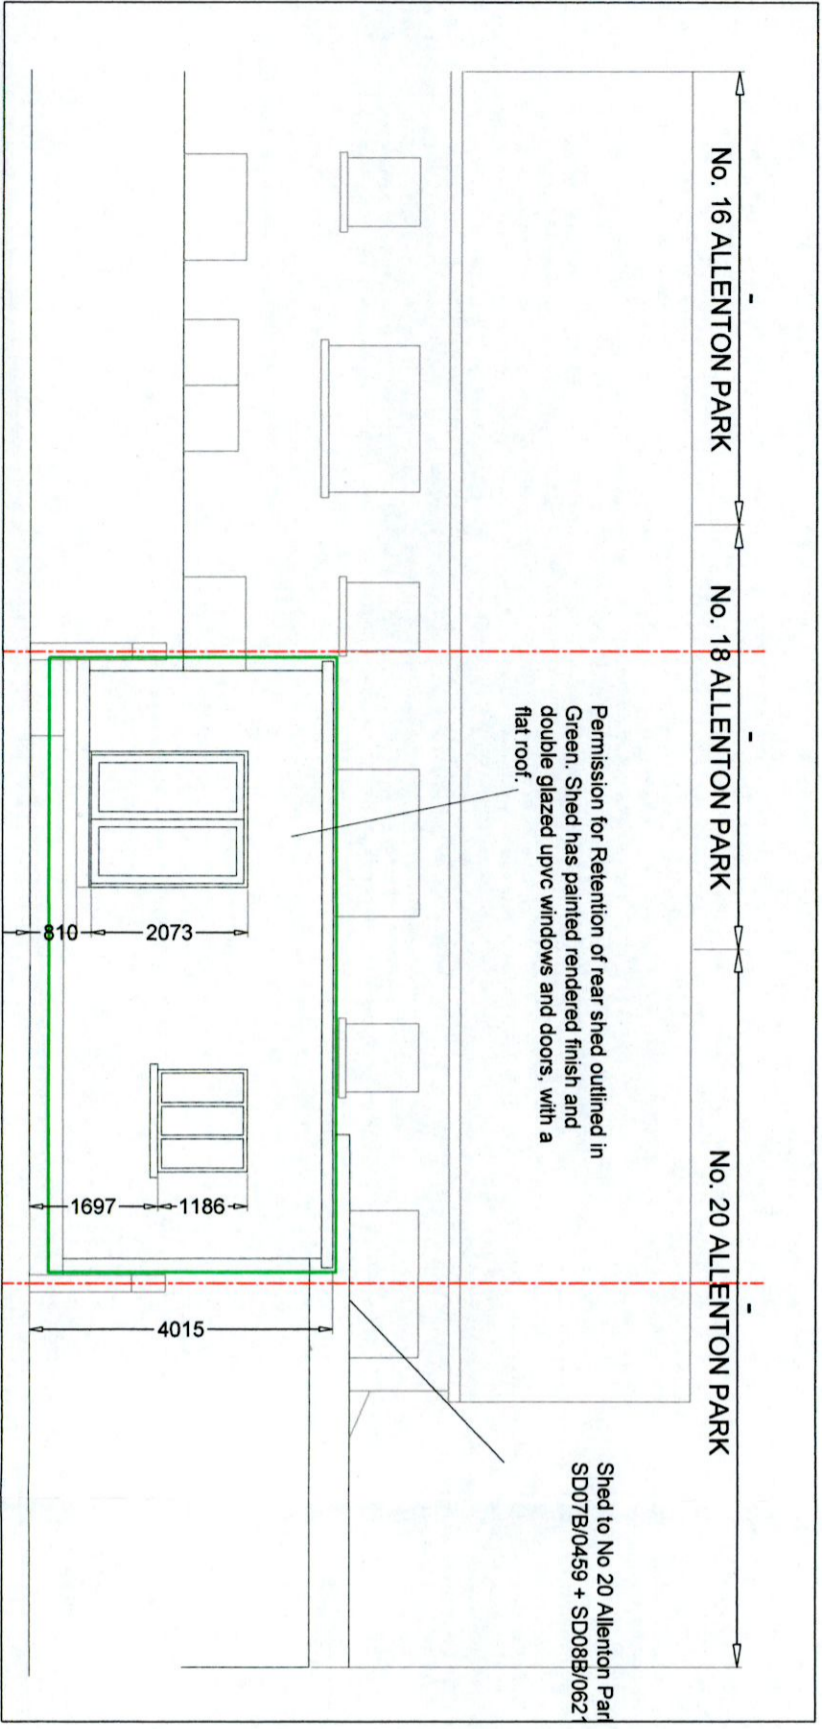

CONTIGUOUS ELEVATION - FRONT ELEVATION
Scale 1:100

Extent of Application OUTLINED in Green
SDCC Ref No. S9016

Note: No scaled measurements to be taken from this drawing, all dimensions to be checked on site. Scales are indicative only and can vary with different printing and photocopying methods. This is not a construction document. Reproduction and distribution without written permission is prohibited.

Project		Permission For an Alter Conversion to No 62 Monastery Grove, Enniskerry, Co Wicklow	
Drawing Title		As Built Contiguous Elevations/Site Section/Front Elevation	
Job No	22.16	Drawn by	PL-007
Rev	0x=1	Plot Date	Sept 2022
Scale	As shown	Drn	Ian Furlong
Date	Oct 2022	Chkd	

Drawings prepared by
Ian Furlong
DESIGN &
DRAFTING
SERVICES
Ayle, Cappanville,
County Tipperary
Phone: 086 3080782
E-Mail: ianfurlong_5@hotmail.com