




1 EAST ELEVATION - PROPOSED
PL - 102 SCALE 1:100 @ A1

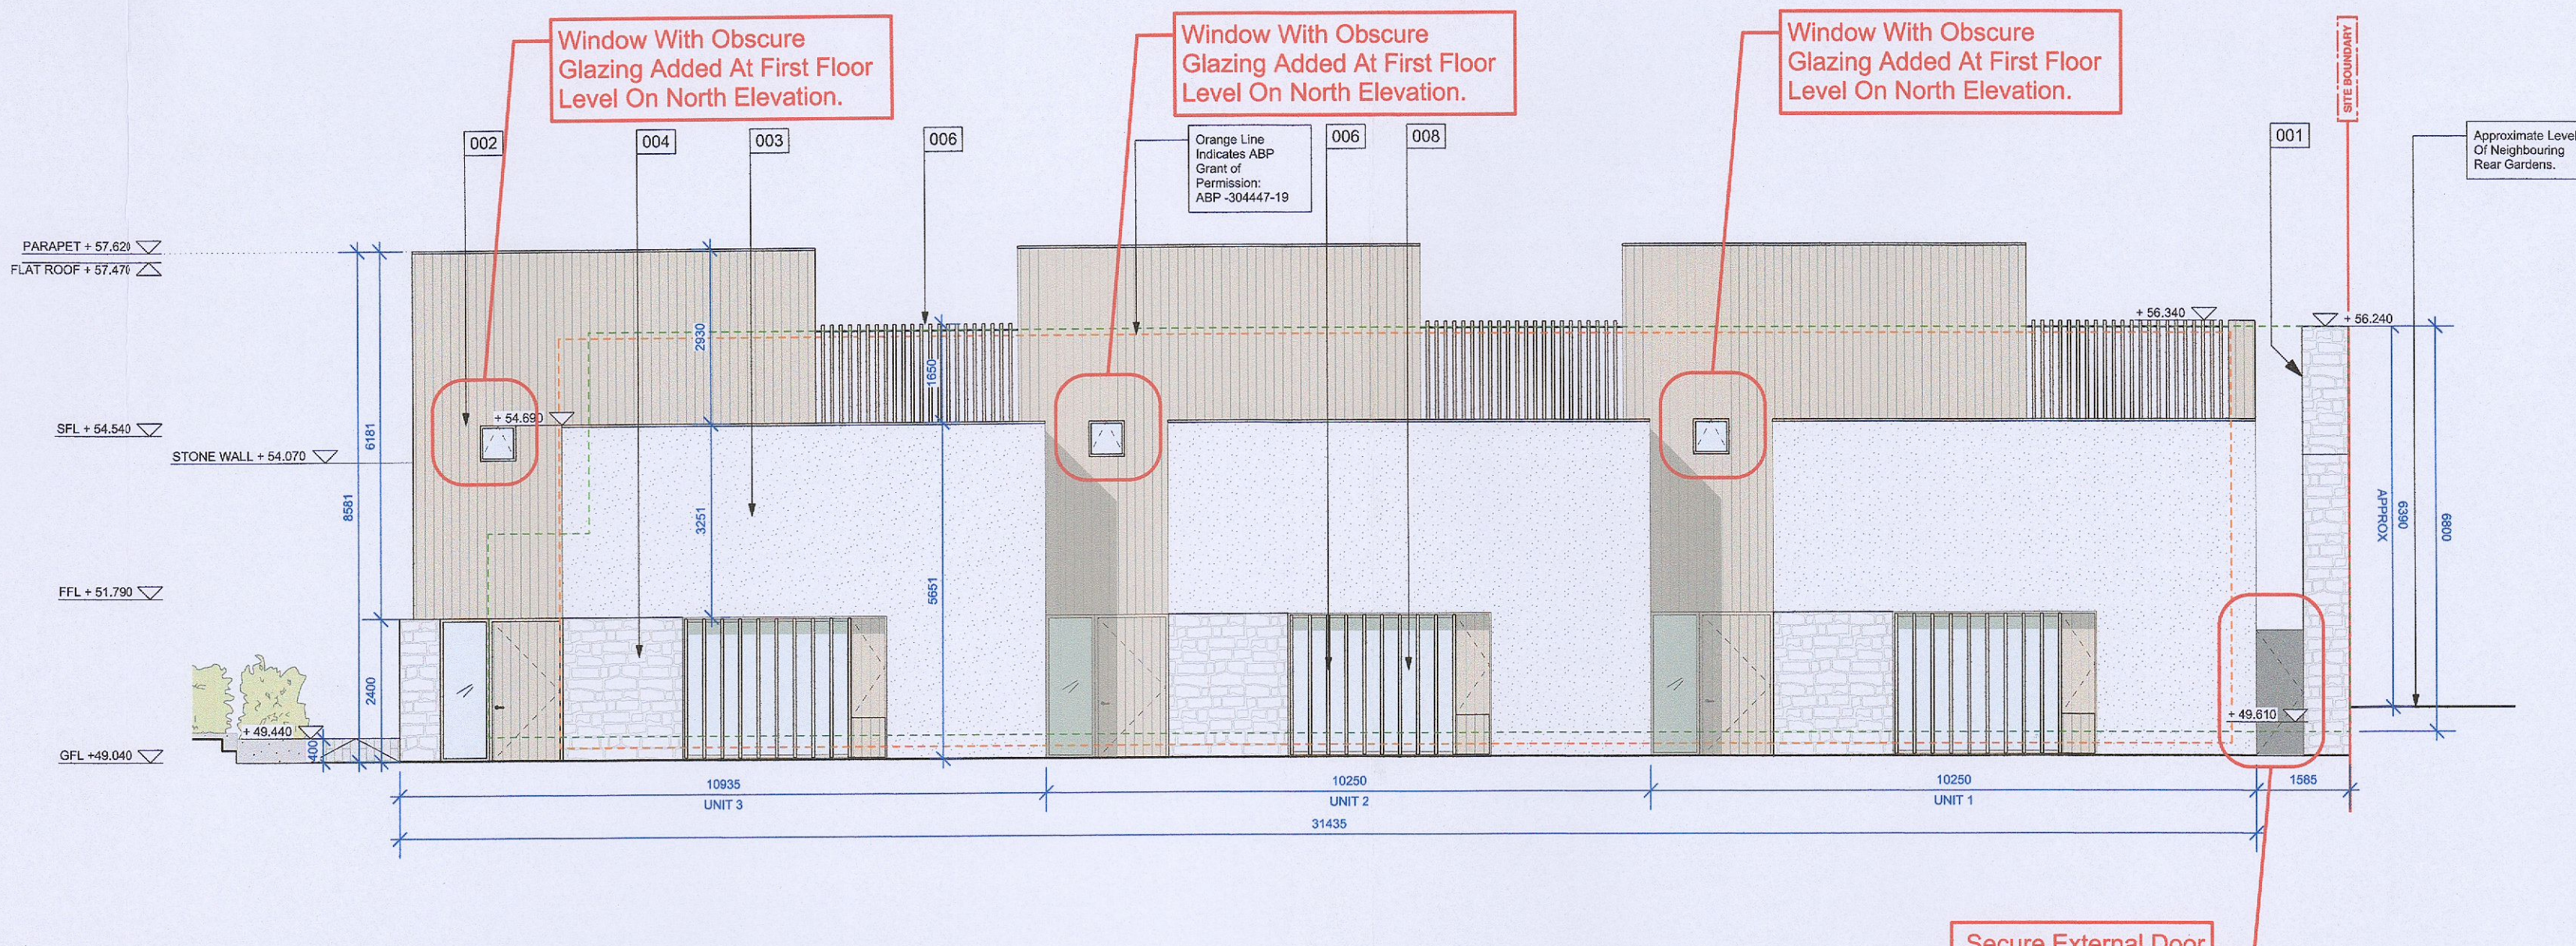


4 NORTH ELEVATION - PROPOSED
PL - 102 SCALE 1:100 @ A1

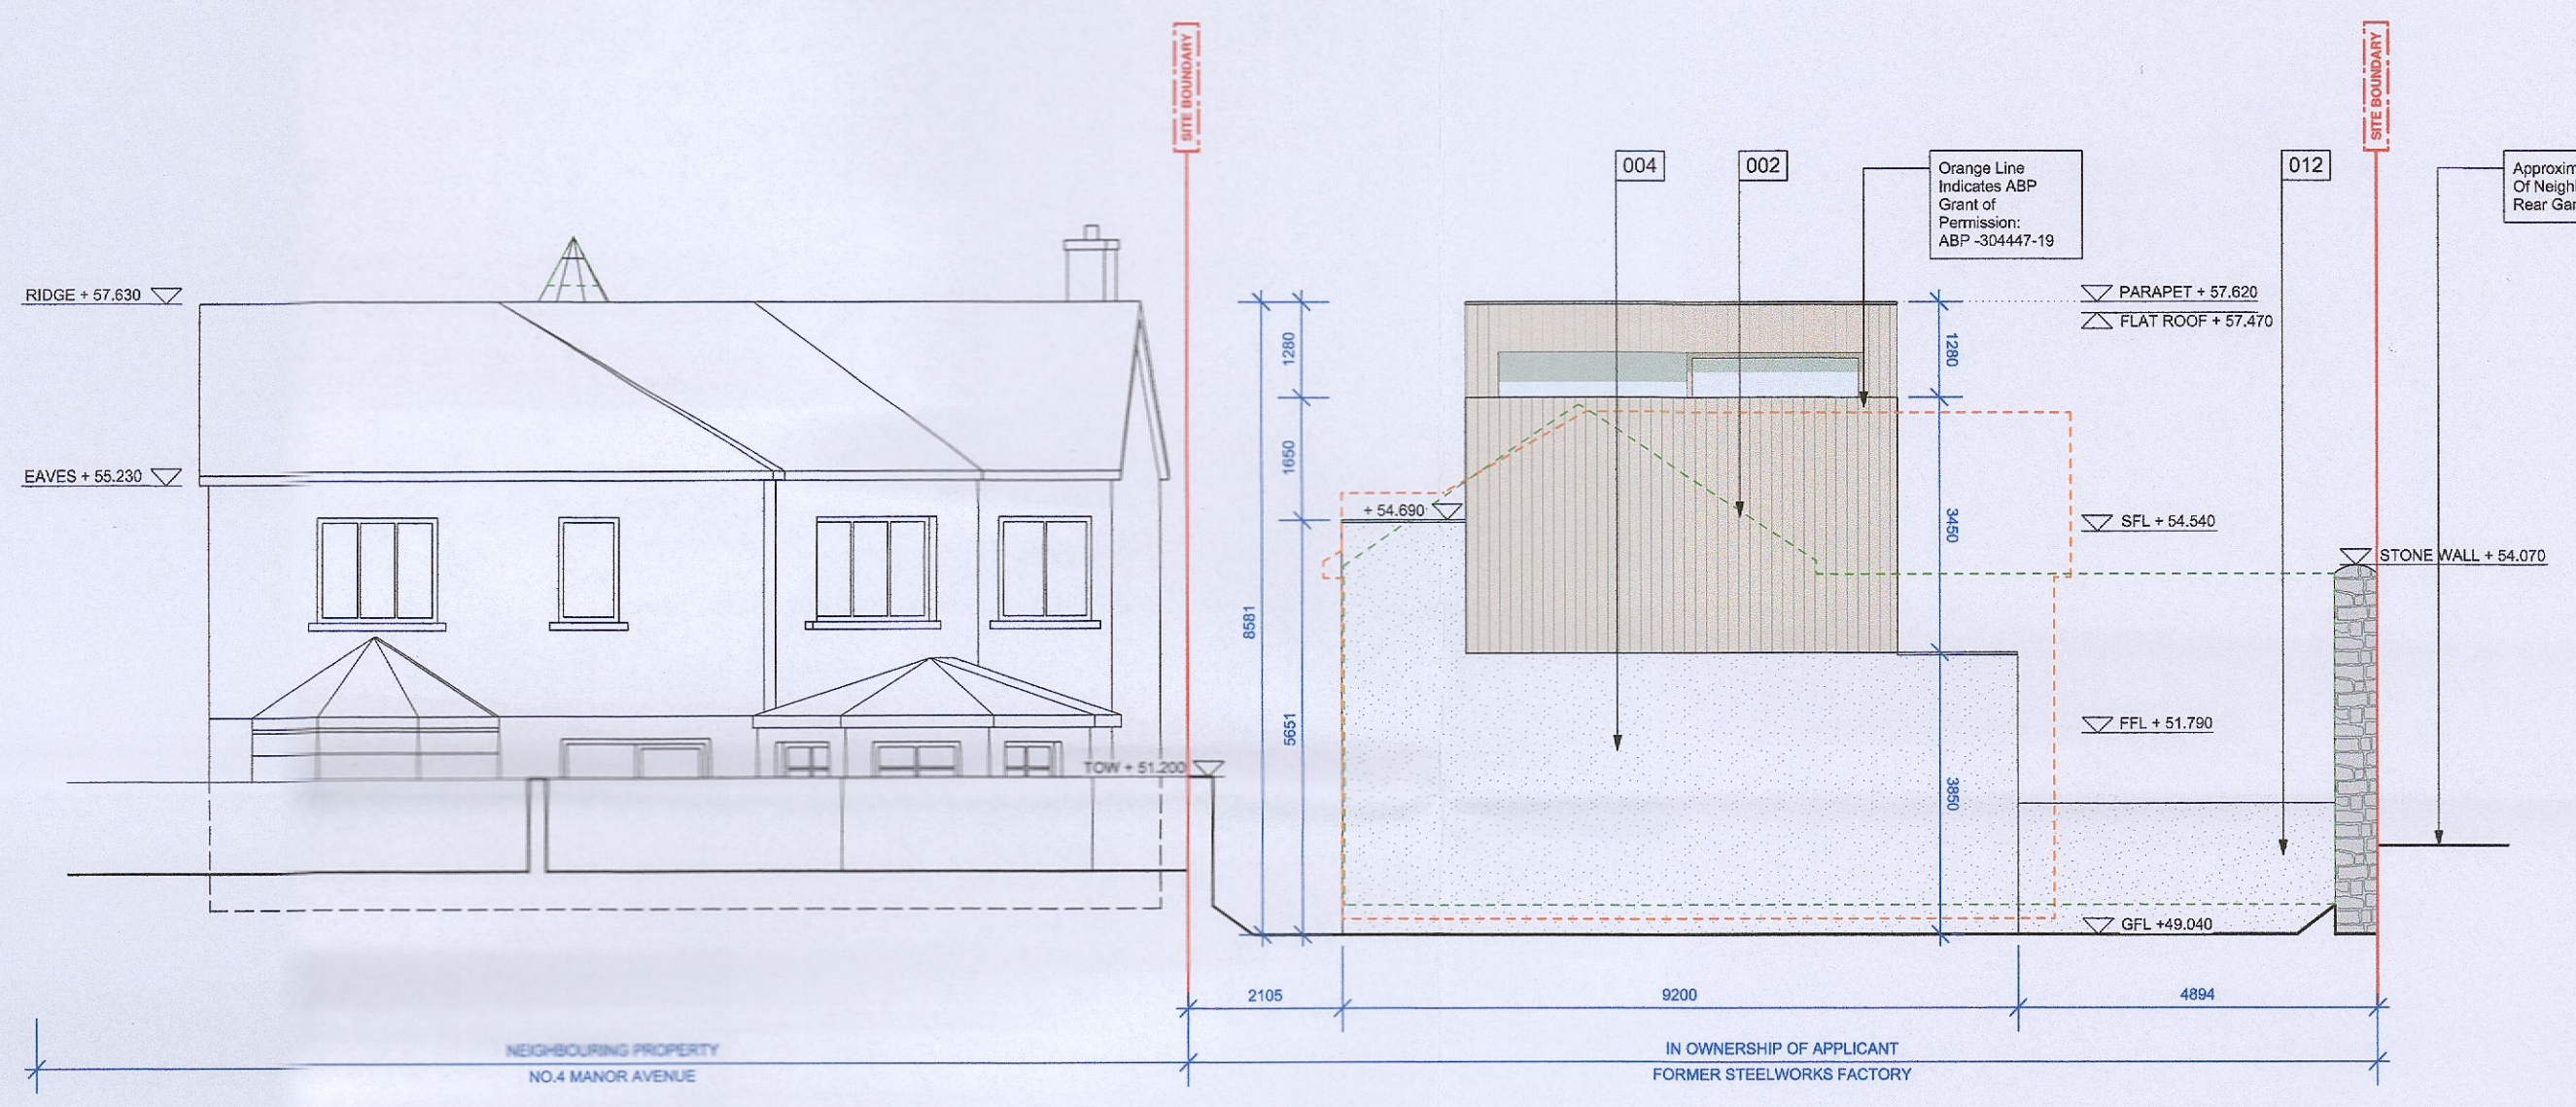


2 WEST ELEVATION - PROPOSED
PL - 102 SCALE 1:100 @ A1

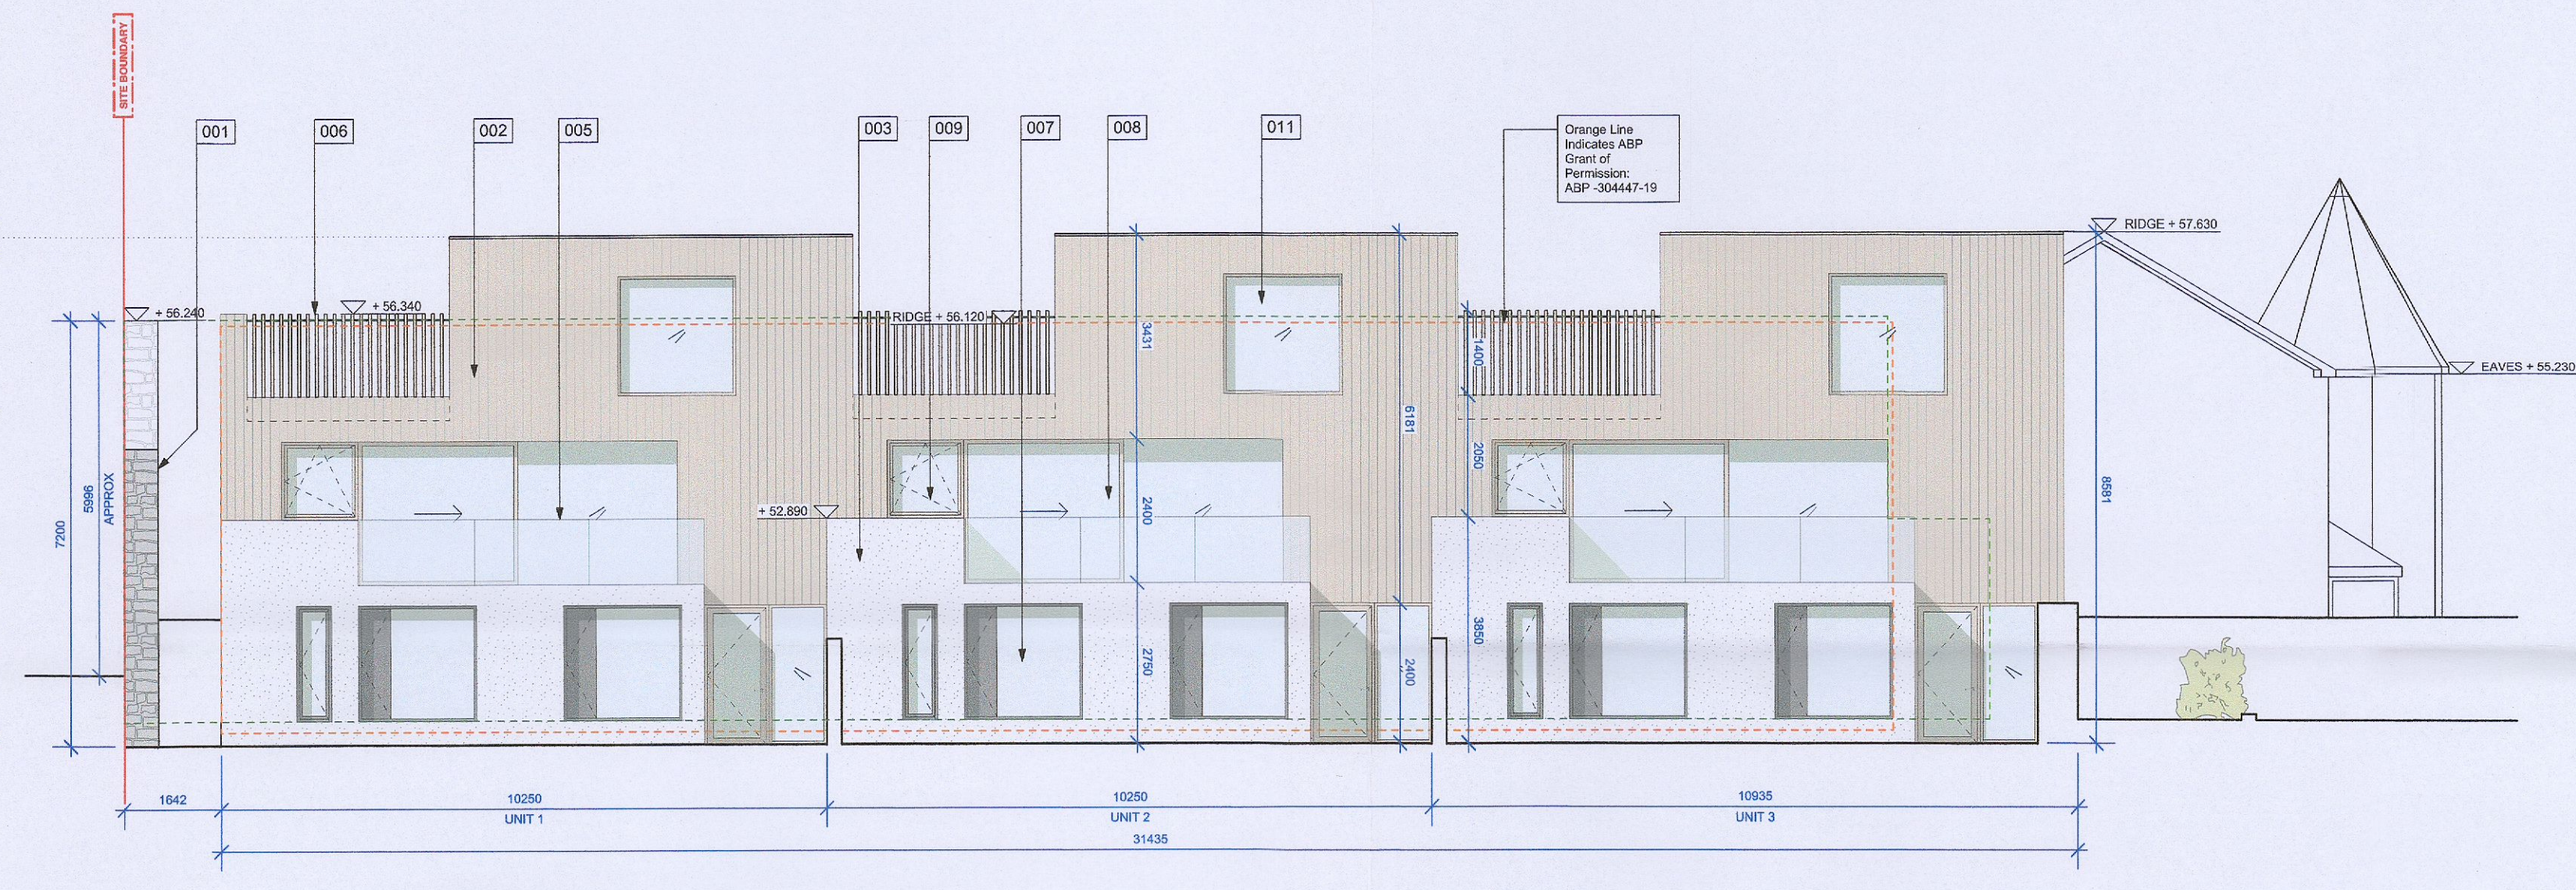

5 SOUTH ELEVATION - PROPOSED
PL - 102 SCALE 1:100 @ A1

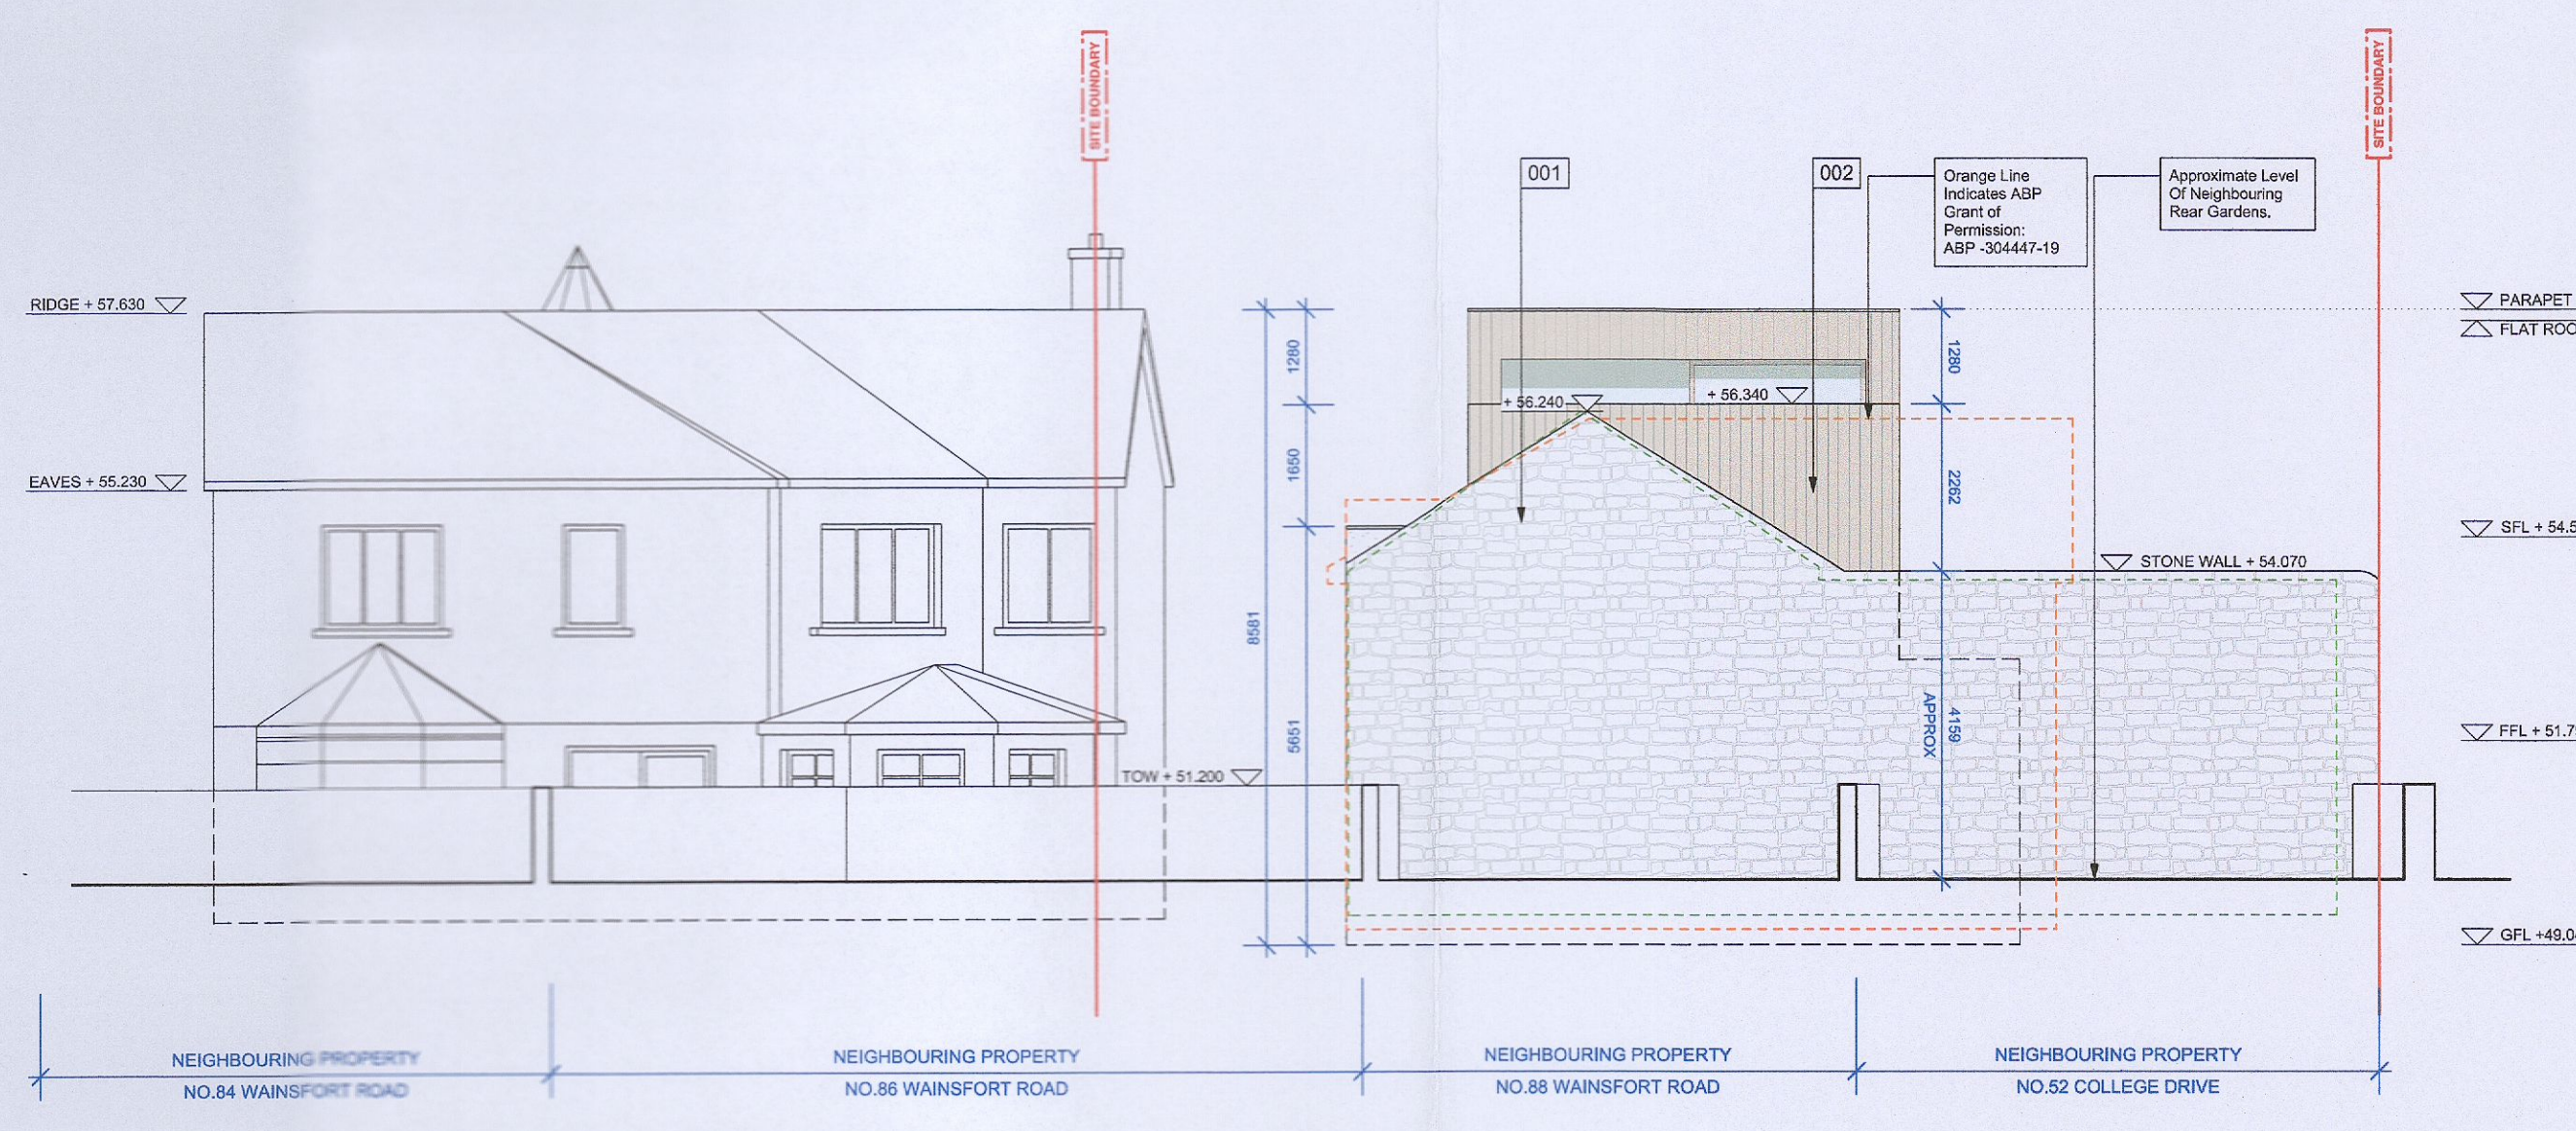

3 WEST BOUNDARY ELEVATION - PROPOSED
PL - 102 SCALE 1:100 @ A1

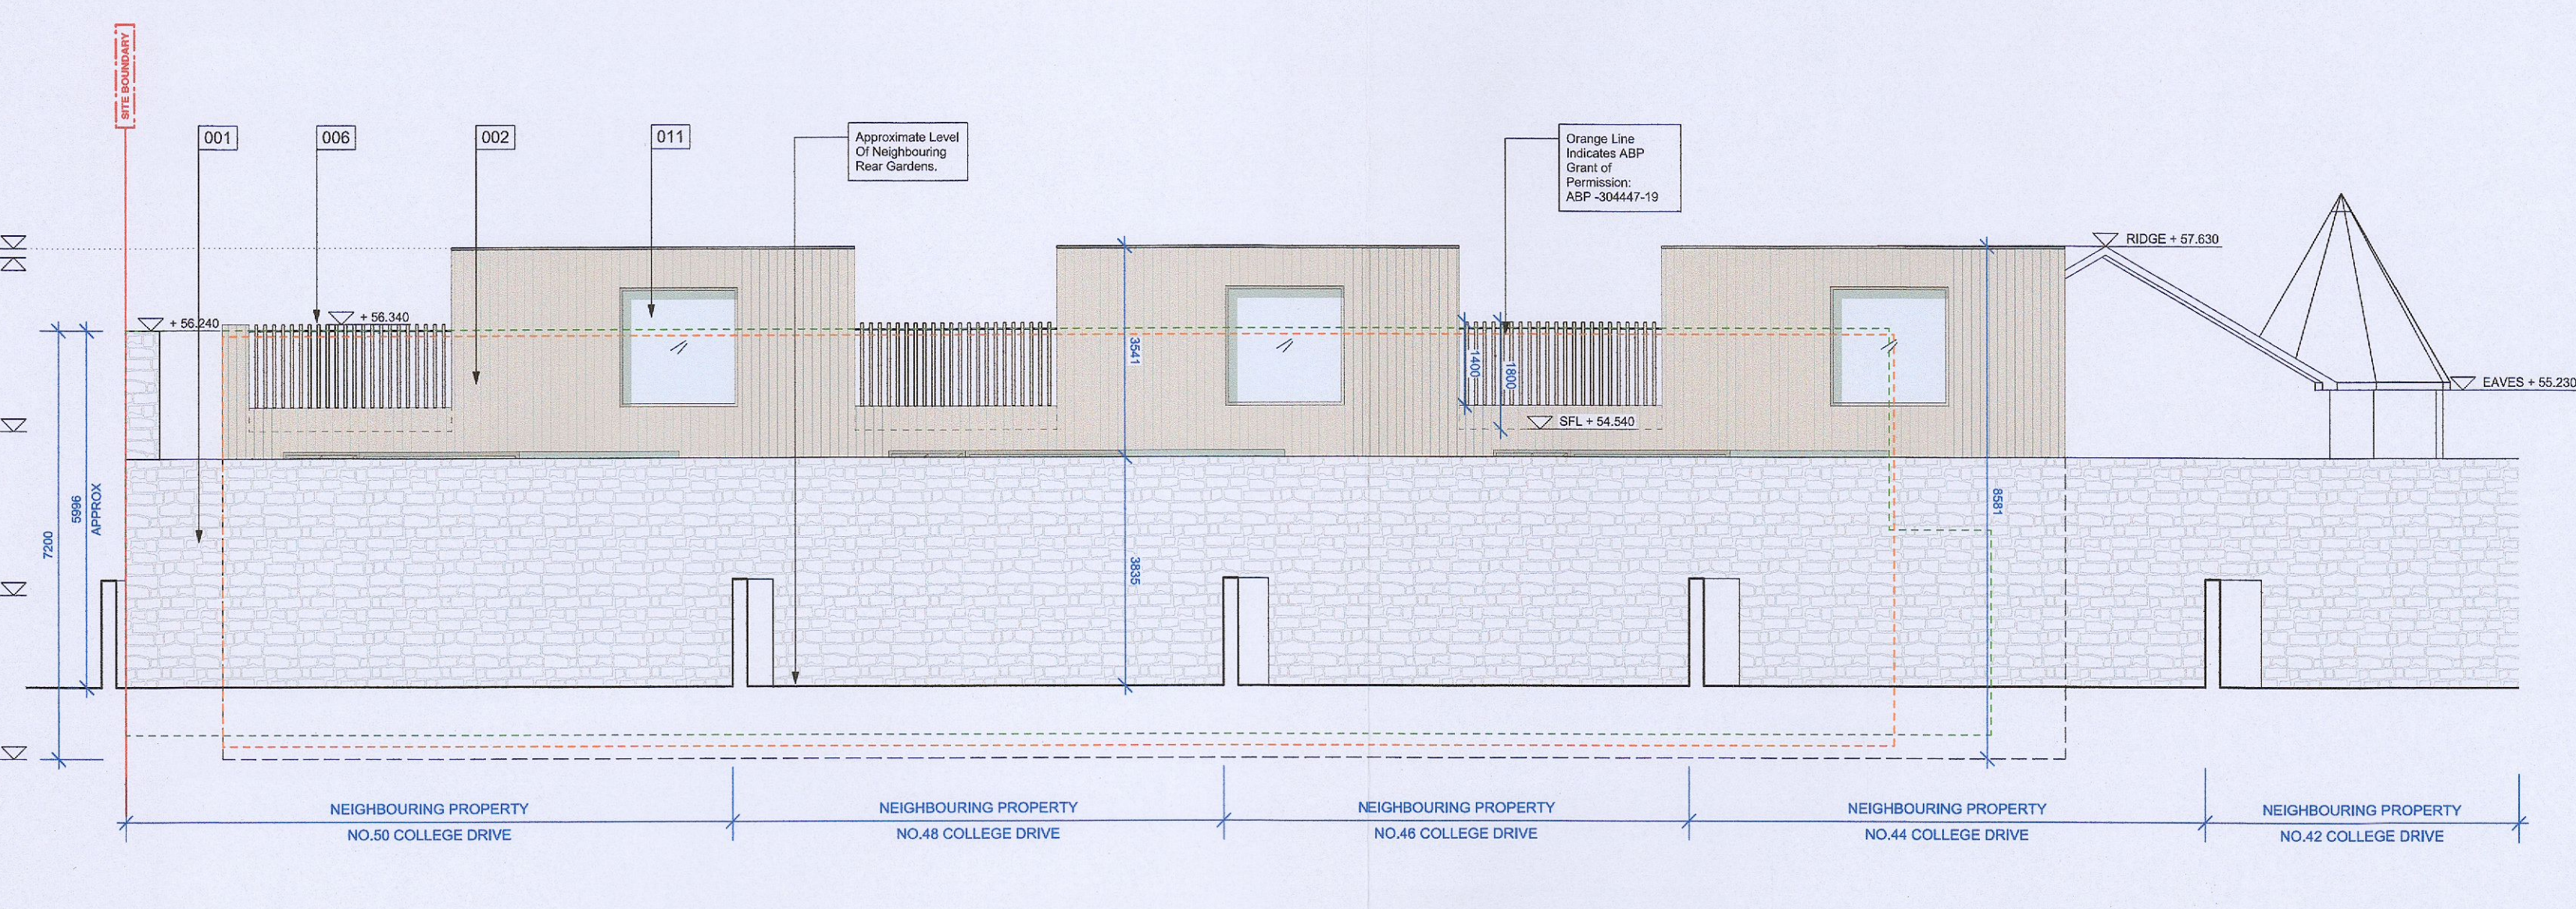

6 SOUTH BOUNDARY ELEVATION - PROPOSED
PL - 102 SCALE 1:100 @ A1

DRAWING LEGEND - PROPOSED		DRAWING TAGS - PROPOSED	
Solid Red Line Indicates Site Boundary	001 - Existing Stone Boundary Wall Retained	005 - Proposed Glass Balustrade	010 - Proposed Fixed Glazing
Dashed Green Line Indicates Outline Of Existing Structure	002 - Proposed Timber Cladding	006 - Proposed Timber Fins	011 - Proposed Fixed Opaque Glazing
Dashed Orange Line Indicates Outline Of ABP Grant of Permission	003 - Proposed Acrylic Render Finish	007 - Proposed Glazing With Opaque Operable Vent Section	012 - Proposed Acrylic Render Finish To Garden Walls
Indicates Proposed New Structure	004 - Proposed Stone Wall (Stone Re-used From Existing Structure)	008 - Proposed Glazed Sliding Doors	013 - Proposed Timber Gate
		009 - Proposed Operable Glazing	014 - Proposed Sedum Roof

RFI RESPONSE HIGHLIGHTED IN RED

PROJECT NO:	2204	DRAWING SCALE:	1:100 @ A1	S A M L E B A S
LOCATION:	MANOR AVENUE, WAINSFORT GROVE, TERENCE, DUBLIN 6	DRAWING TITLE:	ELEVATIONS - PROPOSED	MR: +353 86 106973 E: hello@lebas.ie
STAGE:	RFI RESPONSE	DATE:	FEB 2023	DRAWING NO:
				2204 - PL - 102