


SURFACE WATER SEWER		
Manhole No.	Cover Level (m)	Invert Level (m)
S1	55.981	
S2	53.832	
S3	51.802	
S22.1	51.481	
S21	51.015	
S22	49.749	
S23	49.544	
DEFENDER 1	49.509	
S24	51.632	
S25	51.005	
S26	50.071	
S19	49.711	
S18	49.578	
SPUR 1	50.200	
S17	49.103	
S37	49.069	
S53	48.995	
S54	48.944	
DEFENDER 2	48.920	
S55	48.912	
S56	48.864	
SMH1	47.999	
SMH2	47.620	
SPUR 2	47.811	
SMH3	47.235	
SMH4	46.912	
SMH4A	46.691	
SPUR 3	46.800	
SMH5	46.541	
SMH6	46.178	
SPUR 4	46.450	
SMH7	45.745	
SMH8	44.830	

FOUL SEWER		
Manhole No.	Cover Level (m)	Invert Level (m)
F1	54.149	
F4	53.323	
F5	52.835	
F6	51.934	
F12	52.719	
F13	51.514	
F14	51.439	
F15	51.327	
F27.2	50.842	
F27	50.470	
F27.1	50.093	
F34	49.418	
F33	49.338	
F23	49.055	
F28	48.676	
FMH1.4	50.305	
FMH1.3	50.036	
FMH1.2	49.524	
FMH1.1	49.264	
FMH1	49.137	
FMH2	48.931	
FMH3	48.597	
FMH4	48.377	
FMH5	48.170	
FMH6	47.877	
Ex. FH1	46.952	

LEGEND:

- PUBLIC LIGHTING
- FOUL WATER
- SURFACE WATER
- WATERMAIN
- HYDRANT
- SLUICE VALVE
- PRESSURE RELIEF VALVE
- METER
- END CAP
- END PLATE
- PUBLIC LIGHTING POLE

AS CONSTRUCTED

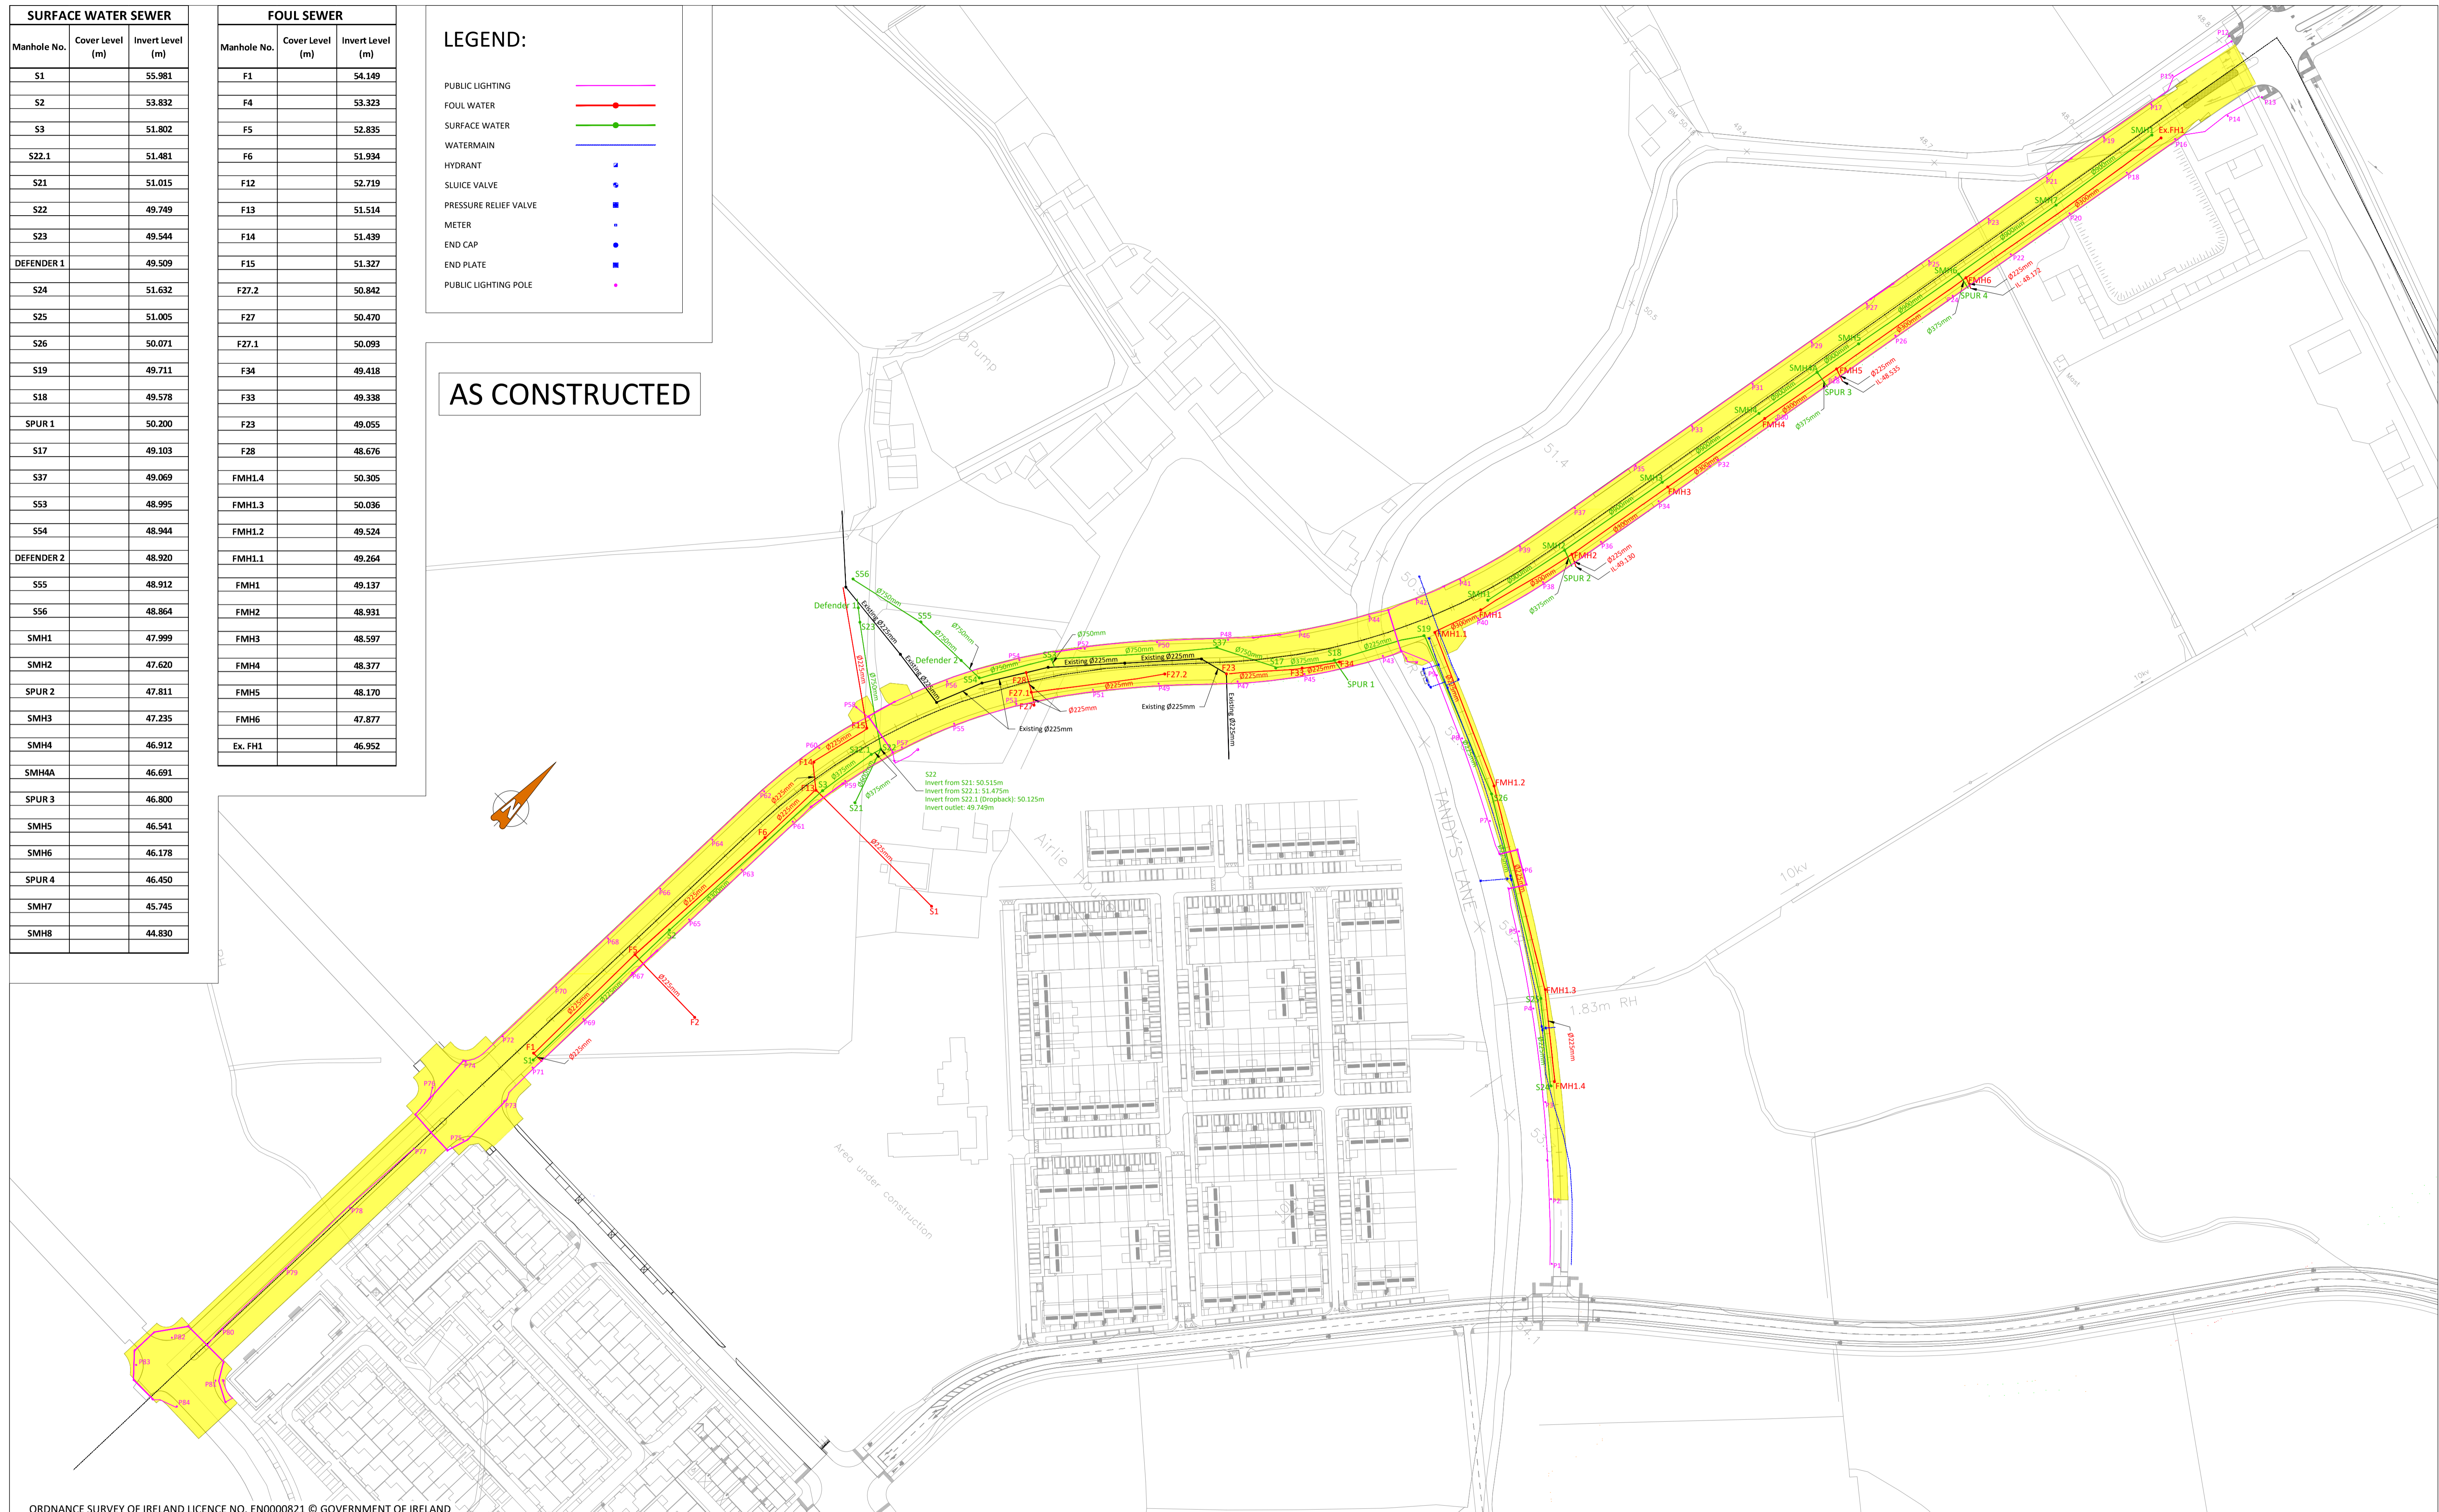

ORDNANCE SURVEY OF IRELAND LICENCE NO. EN0000821 © GOVERNMENT OF IRELAND

- FOR SETTING OUT REFER TO ARCHITECT'S DRAWINGS.
- THIS DRAWING TO BE READ IN CONJUNCTION WITH ALL OTHER ARCHITECTURAL AND ENGINEERING DRAWINGS AND ALL OTHER RELEVANT DRAWINGS AND SPECIFICATIONS.
- DO NOT SCALE THIS DRAWING. USE FIGURED DIMENSIONS ONLY.
- NO PART OF THIS DOCUMENT MAY BE REPRODUCED OR TRANSMITTED IN ANY FORM OR STORED IN ANY RETRIEVAL SYSTEM OF ANY NATURE WITHOUT THE WRITTEN PERMISSION OF O'CONNOR SUTTON CRONIN AS COPYRIGHT HOLDER EXCEPT AS AGREED FOR USE ON THE PROJECT FOR WHICH THE DOCUMENT WAS ORIGINALLY ISSUED.

Rev No.	Date	Revision Note	Drn by	Chkd by	Rev No.	Date	Revision Note	Drn by	Chkd by
C01	24.01.22	RECORD DRAWING	RB	GL					

Head Office,
9 Prussia Street,
Dublin 7,
D07 KT57

TEL +353 (0)1 8682000

e: contactus@ocsc.ie
w: www.ocsc.ie

Dublin | London | Belfast | Galway | Cork | Birmingham

Client: Cairn Homes Construction Ltd
Project: ADAMSTOWN BOULEVARD

Title: TAKING IN CHARGE

Code	Originator	Zone	Level	Type	Role	Number	Status	Revision
A580	OCSC	XX	XX	DR	C	0590	CR	C01

Date: 24.01.22 Scale: 1:1250@ A1 Drn by:RB Chkd by:GL Aprvd by:AH