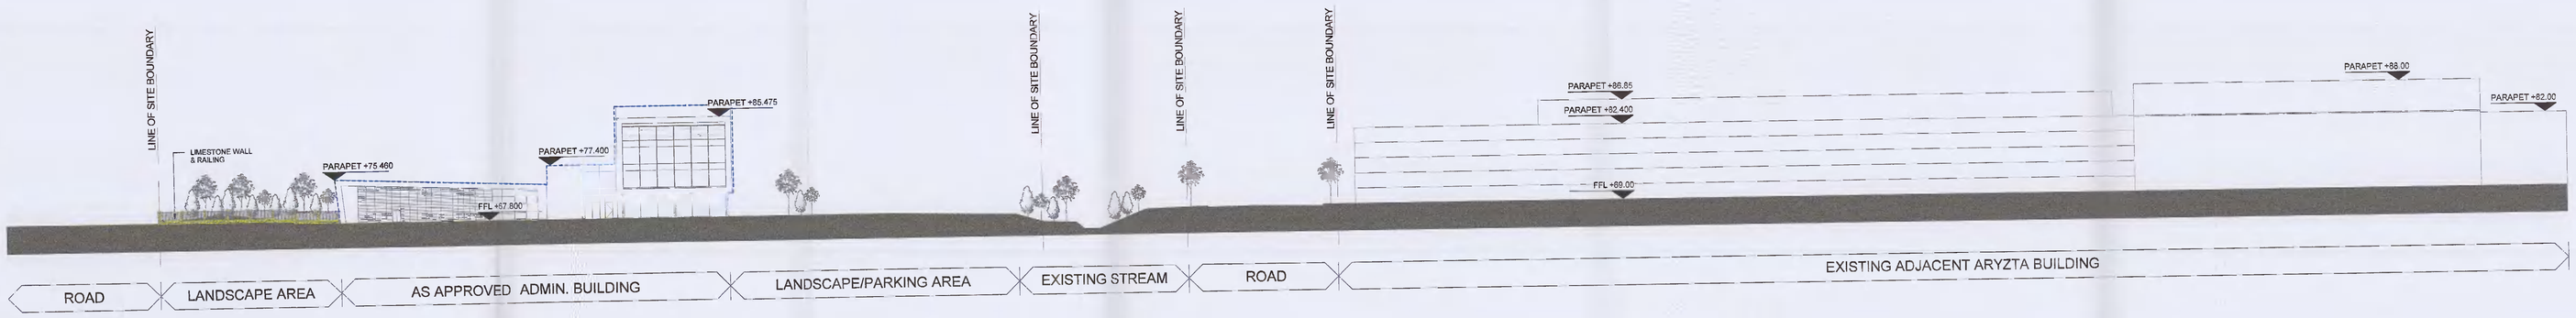

1 As Approved - Contiguous Elevation C-C
1 : 500

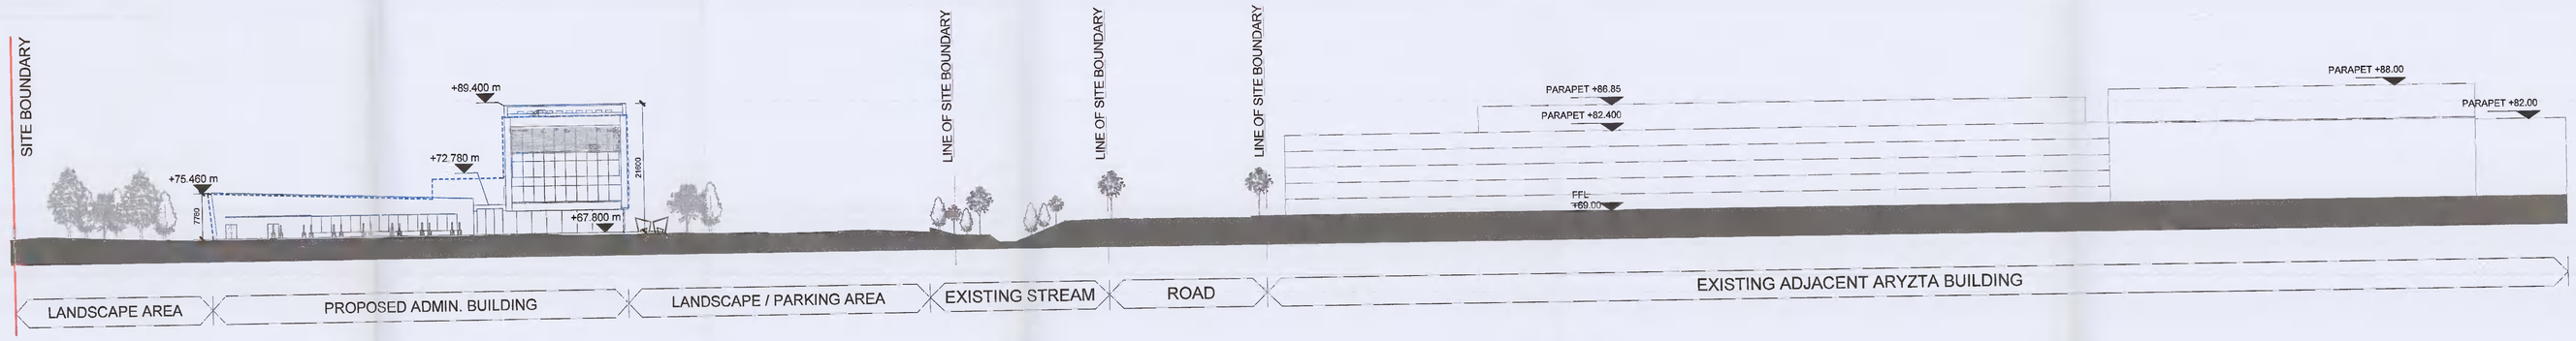

2 Proposed - Contiguous Elevation C-C
1 : 500

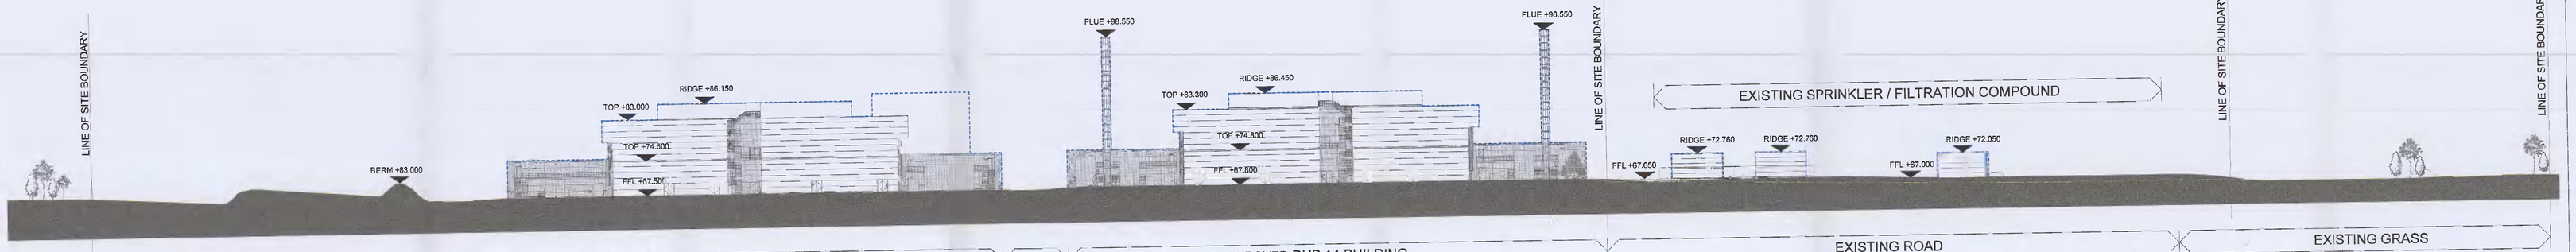

3 As Approved - Contiguous Elevation D-D
1 : 500

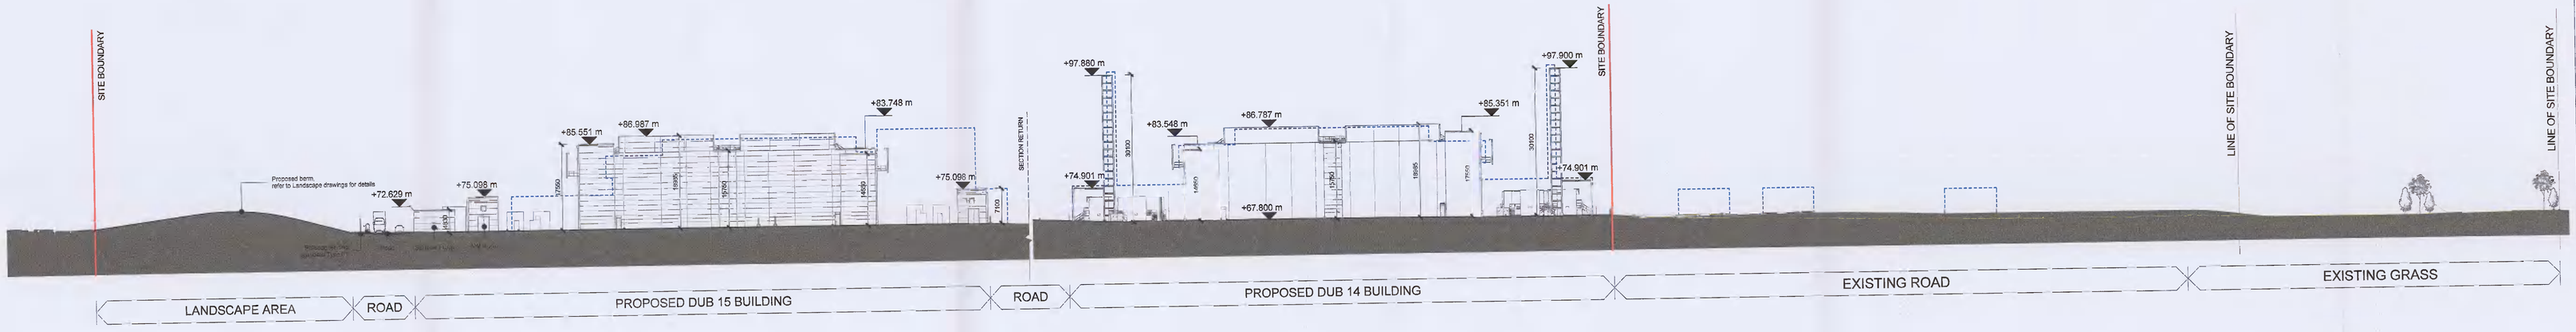

4 Proposed - Contiguous Elevation D-D
1 : 500

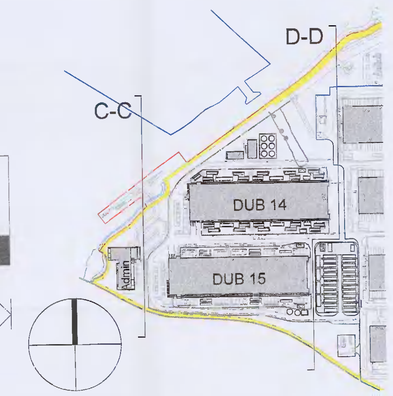

5 Masterplan Key
1 : 5000

Approvals:

Customer	Microsoft	Date	29/01/21
Microsoft Mechanical Engineer	Greg Lynch		
Microsoft Telecom Engineer	Cathal O'Sullivan		
Microsoft Electrical Engineer	Alan Kelett		
Engineering Manager	Declan Comerford		
Security Manager	Michael O'Donnell		
CSA	Lanae Maher / Sharondra Naidu		

General Notes:

1. This is not an installation drawing and shows design intent information only.
2. All dimensions are in millimetres (mm) unless noted otherwise. all levels are in metres (m)unless noted otherwise.
3. Do not scale; work to figured dimensions only. This drawing shall be read in conjunction with building services documents and other relevant contract documents.
4. Equipment and plant details are not manufacturer specific. Contractor selected equipment shall meet the given constraints and long lead equipment will be coordinated by the GC based on final equipment selection.
5. All service penetrations through fire rated compartments shall be fire stopped to achieve a rating equivalent to the compartment and shall be designed to accommodate thermal movement.
6. All services crossing the movement joints shall be installed to accommodate the movements as defined in the structural engineers contract documentation.
7. The Contractor will produce fully coordinated installation drawings prior to installation for approval.
8. The Contractor will produce as built drawings prior to handover for approval.

LEGEND

Denotes outline of as approved (SD20A/0283) building location

14/07/2021 19:51:11

Issue	Date	Revision Description
P01	25.06.21	Issue for Planning

ARUP

Client
Microsoft

Project Title
DUB 14/15
Proposed Modifications to Previously Approved Scheme SDA\0283

Key Plan

Drawing Title
Approved & Proposed Side Wide Contiguous Elevations
Sheet 3

Scale at A0	As indicated	By / Chkd / Appd	BJ/MM/RA
Role	Architecture		
Status	S2 - Suitable for Information - Planning -		
Arup Job No	279225	Rev	P01
ID	A1032		

© Arup