1- Elevation - As Approved - East Elevation

Scale 1 : 250

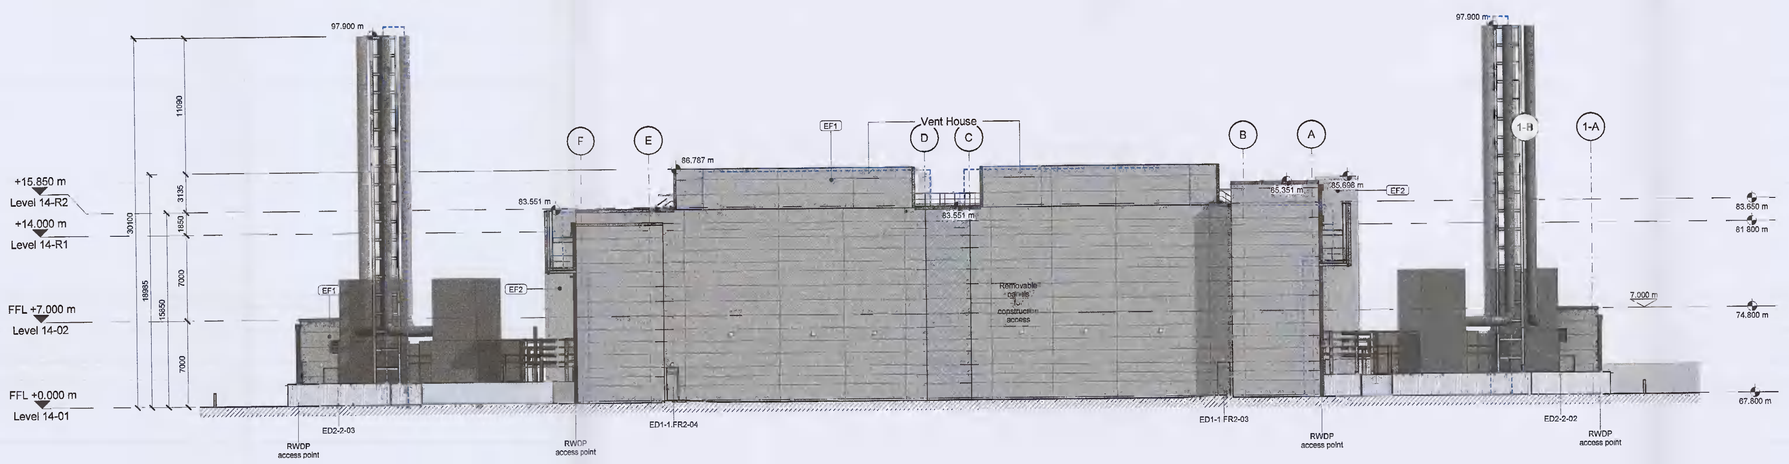

2- Elevation - Proposed - East Elevation

Scale 1 : 250

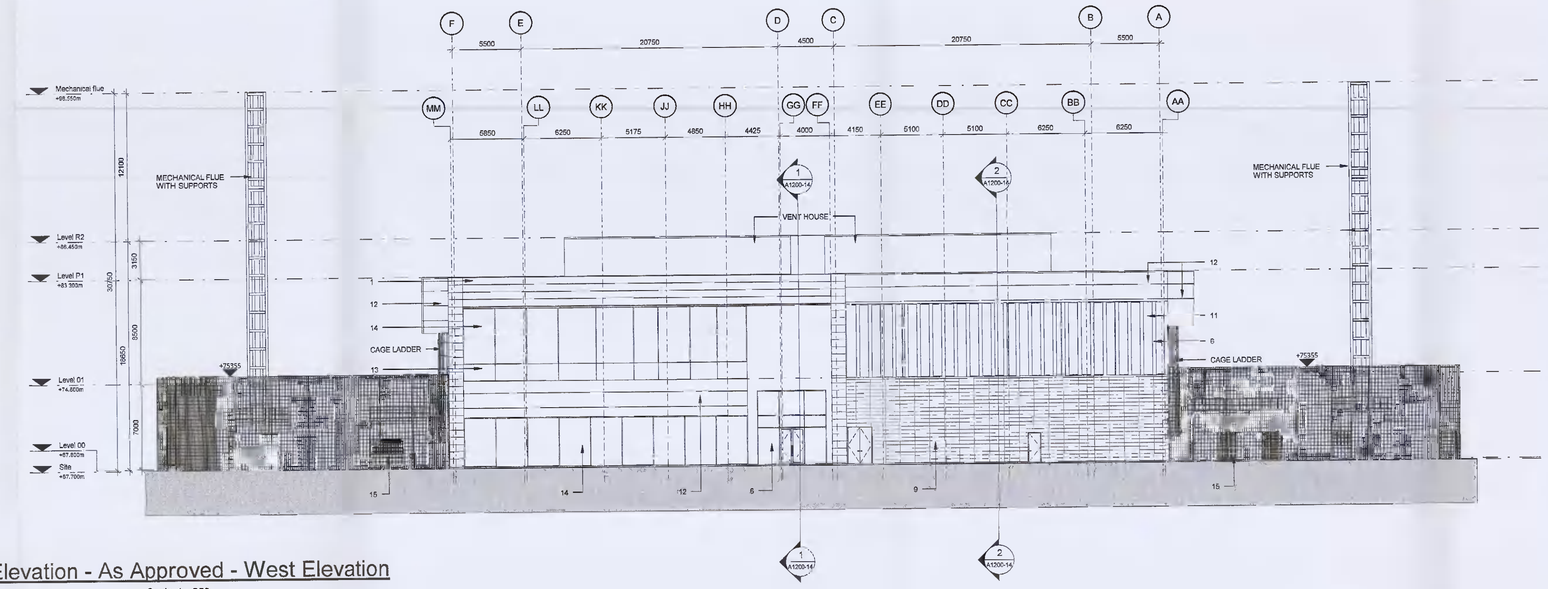

3- Elevation - As Approved - West Elevation

Scale 1 : 250

4- Elevation - Proposed - West Elevation

Scale 1 : 250

Approvals:

Customer	Microsoft	Date | 29/01/21
Microsoft Mechanical Engineer	Craig Lynch	
Microsoft Telecom Engineer	Cathal O'Sullivan	
Microsoft Electrical Engineer	Alan Kellett	
Engineering Manager	Declan Comerford	
Security Manager	Michael O'Donnell	
CRA	Laoise Maher / Sharandra Naidu	

General Notes:

1. This is not an installation drawing and shows design intent information only.
2. All dimensions are in millimetres (mm) unless noted otherwise. all levels are in metres (m)unless noted otherwise.
3. Do not scale; work to figured dimensions only. This drawing shall be read in conjunction with building services documents and other relevant contract documents.
4. Equipment and plant details are not manufacturer specific. Contractor selected equipment shall meet the given constraints and long lead equipment will be coordinated by the GC based on final equipment selection.
5. All service penetrations through fire rated compartments shall be fire stopped to achieve a rating equivalent to the compartment and shall be designed to accommodate thermal movement.
6. All services crossing the movement joints shall be installed to accommodate the movements as defined in the structural engineers contract documentation.
7. The Contractor will produce fully coordinated installation drawings prior to installation for approval.
8. The Contractor will produce as built drawings prior to handover for approval.

LEGEND - FACADE TYPES

- EF1, Facade Aluminium Unsulated Panels, RAL 9006
- EF1.1, Facade Aluminium Unsulated Panels, RAL 7043
- EF2, Fire Rated Facade Sandwich Panels, RAL 7043
- EF3, Fire Rated Facade Sandwich Panels, RAL 9006
- EF4, Stone Facade Tiles, RAL7045
- EF5, Metal Boxing Panels, RAL 7043
- EF6, Facade Glazing System with Vertical Sun Blinds
- EF7, Facade Glazing System
- EF8, Louvre Panels, RAL 7043
- EF9, Insulated Facade Panels, RAL 7043

Key:

Outline of planning approved

Issue	Date	Revision Description
P01	25.06.21	Issue For Planning

ARUP

Client: Microsoft

Project Title:
DUB 14/15
Proposed Modifications to Previously Approved Scheme SD20A0283

Key Plan

Drawing Title:
Approved and Proposed Elevations
DUB 14 Data Centre
Sheet 2

Scale at A0	As indicated	By / Chkd / Appd CJ/MM/RA
Role	Architecture	
Status	S2 - Suitable for Information - Planning -	
Arup Job No	279225	Rev P01
ID	A1301 - 14	

14/07/2021 12:25:05

Do not scale

© Arup