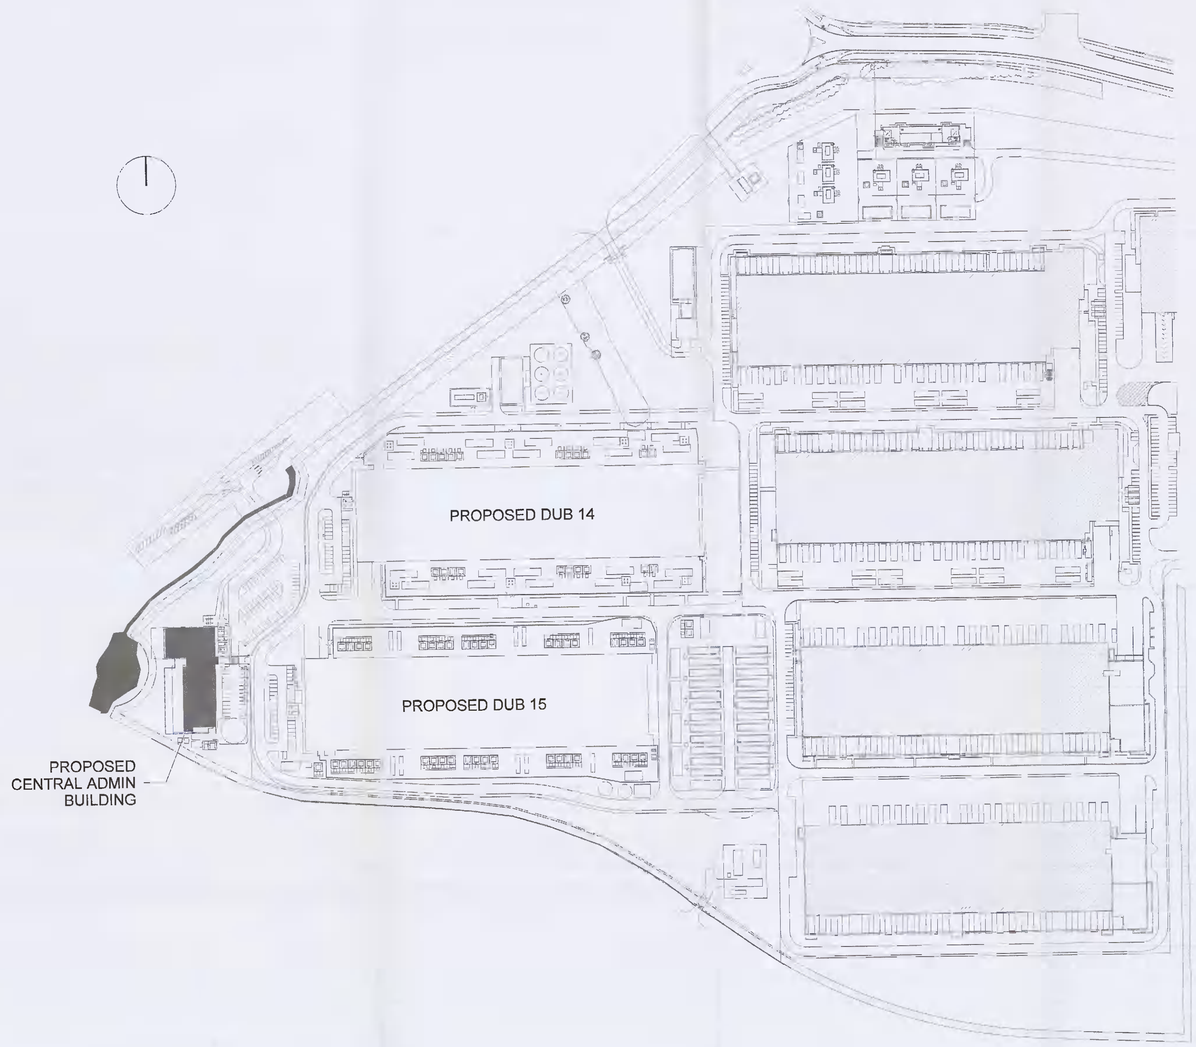

4 Site Plan
1 : 2000

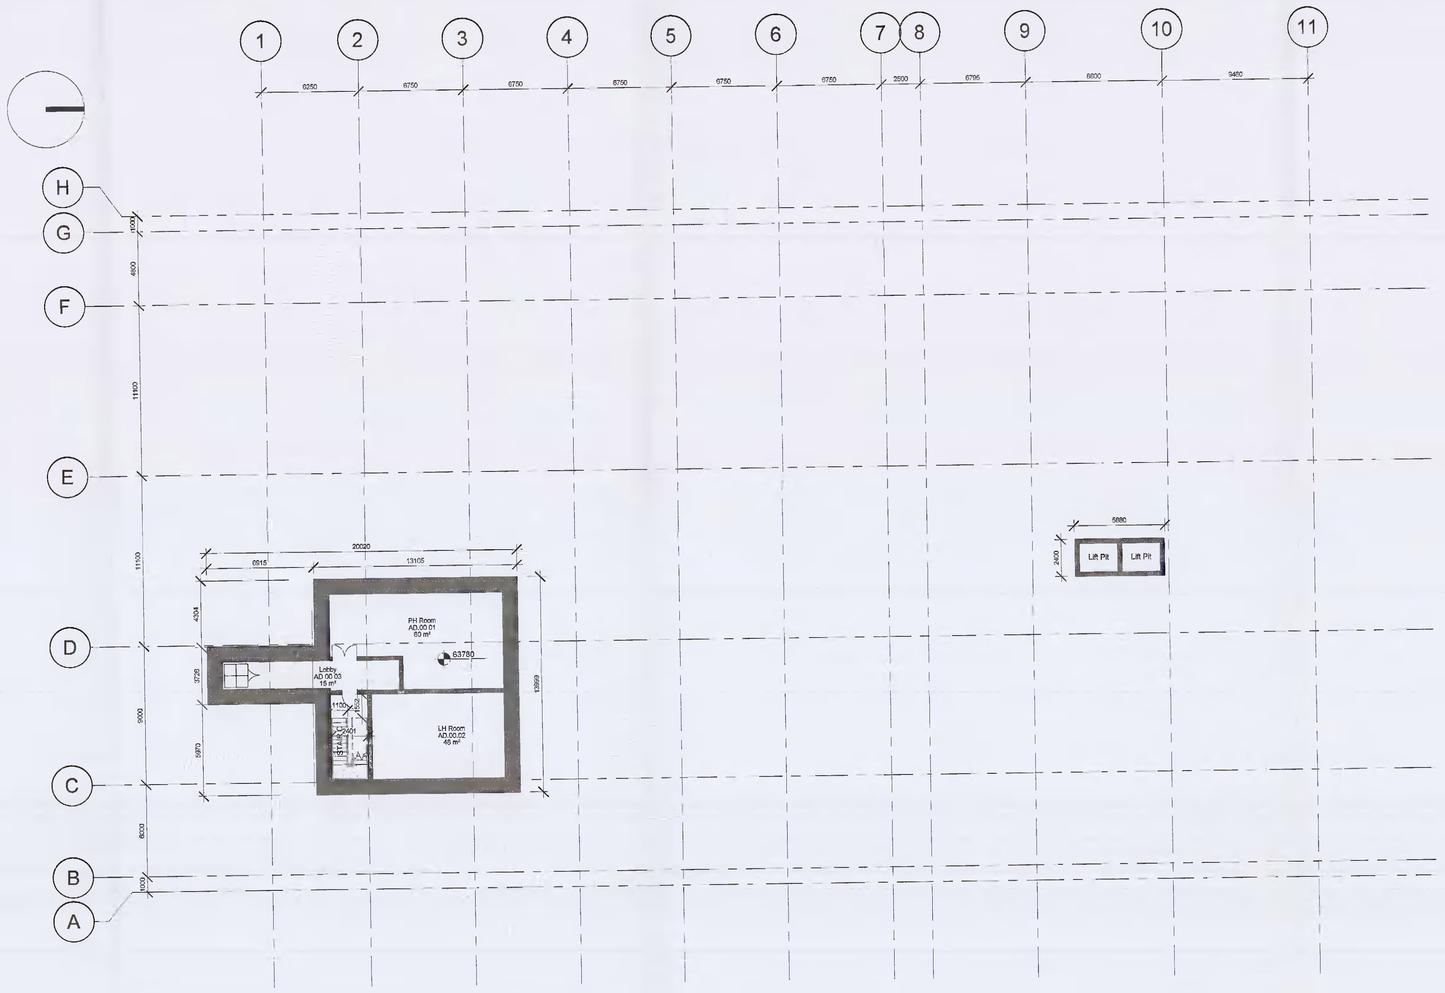

1 Basement Plan Proposed
1 : 200

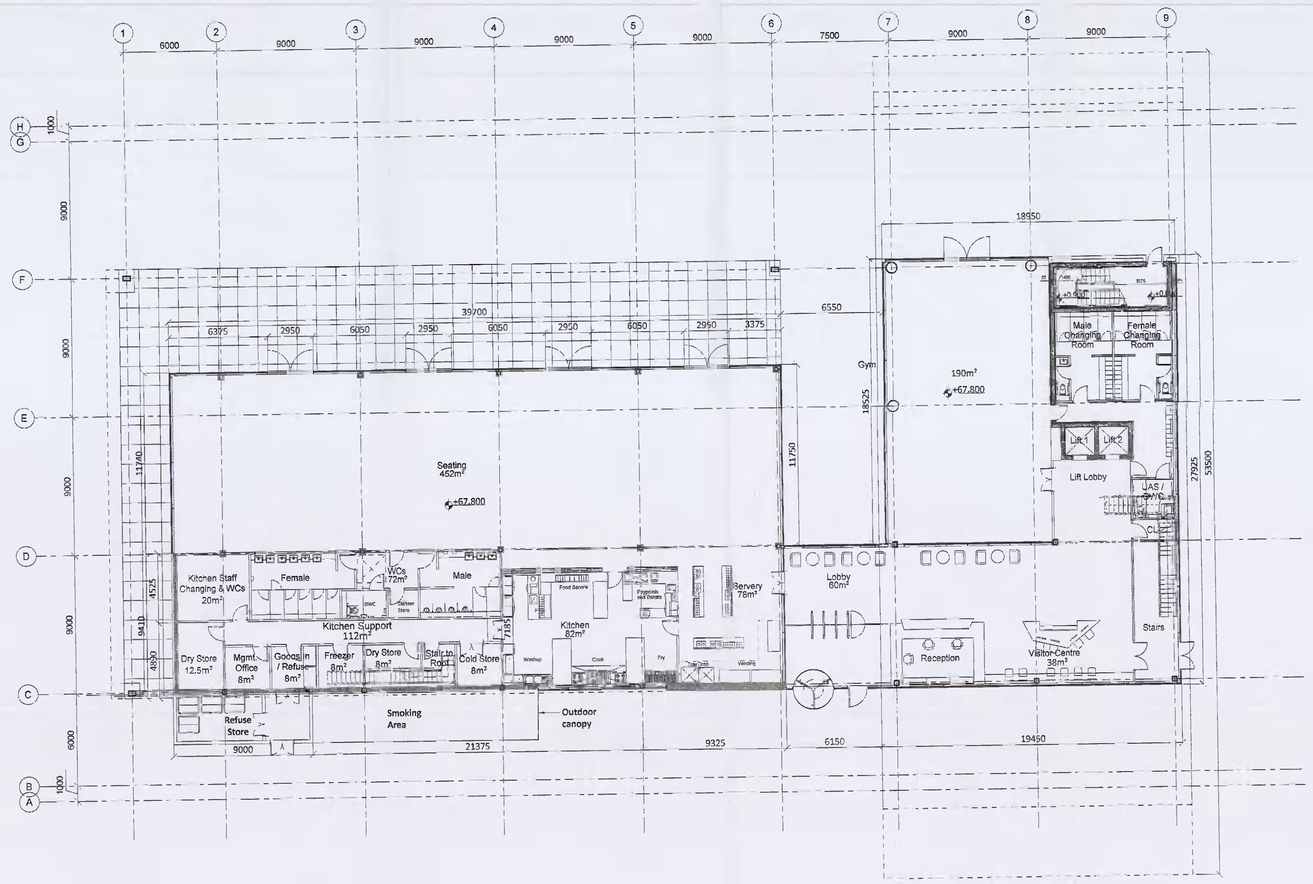

3 Ground Floor Plan Approved
1 : 200

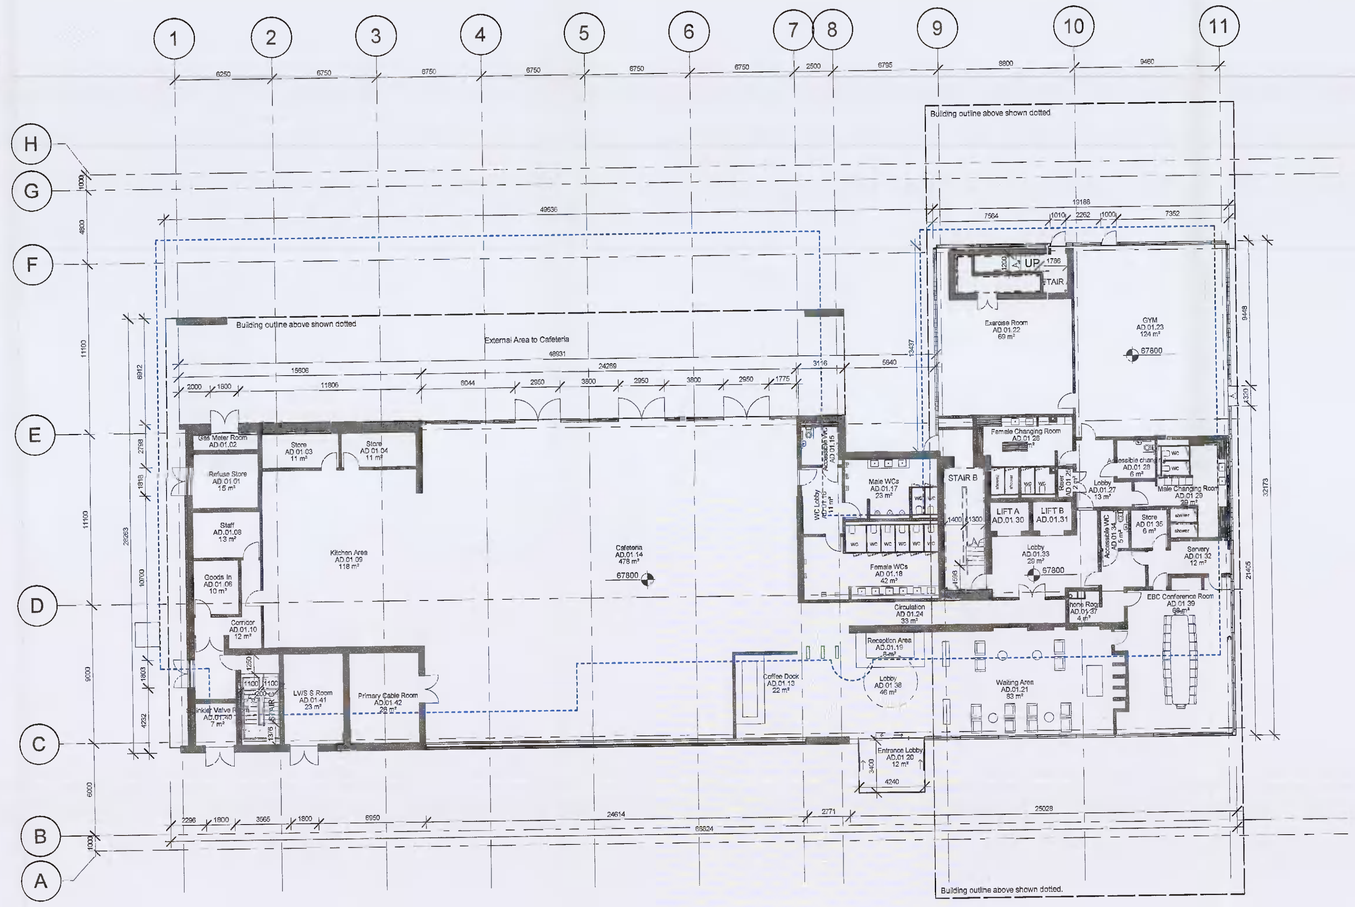

2 Ground Floor Plan Proposed
1 : 200

Approvals:

Customer	Microsoft	Date | 21/05/21
Microsoft Mechanical Engineer	Andy Lloyd	
Microsoft Telecom Engineer	Cathal O'Sullivan	
Microsoft Electrical Engineer	Alan Kellett	
Engineering Manager	Declan Comerford	
Security Manager	Daniel Jones	
CSA	Lacka Maher / Sharendra Naidu / Jeff Schumacher	

General Notes:

1. This is not an installation drawing and shows design intent information only.
2. All dimensions are in millimetres (mm) unless noted otherwise, all levels are in metres (m)unless noted otherwise.
3. Do not scale; work to figured dimensions only. This drawing shall be read in conjunction with building services documents and other relevant contract documents.
4. Equipment and plant details are not manufacturer specific. Contractor selected equipment shall meet the given constraints and long lead equipment will be coordinated by the GC based on final equipment selection.
5. All service penetrations through fire rated compartments shall be fire stopped to achieve a rating equivalent to the compartment and shall be designed to accommodate thermal movement.
6. All services crossing the movement joints shall be installed to accommodate the movements as defined in the structural engineers contract documentation.
7. The Contractor will produce fully coordinated installation drawings prior to installation for approval.
8. The Contractor will produce as built drawings prior to handover for approval.

Denotes outline of approved (SD20A/0283) building footprints

Issue	Date	Revision Description
P01	25/06/21	Issued for Planning

ARUP Microsoft

DONNELLY TURPIN ARCHITECTS

55 Camden Street Lower, Dublin, D02 CH60
Tel: +353(0)1 475 9055
E| projects@donnellyturpin.com
W|www.donnellyturpin.com

Client

Project Title
DUB 14/15
Proposed Modifications to Previously Approved Scheme SD20A/0283

Drawing Title
Floor Plans
Office Building
Sheet 1
(Approved & Proposed Comparison)

Scale at A0	By / Chkd / Appd
As indicated	BJ/ JW/SC/RA/MT

Role: Architecture
Status: S2 - Suitable for Information - Planning
Job No: 2035
Rev: P01
ID: A1100

© Donnelly Turpin Architects