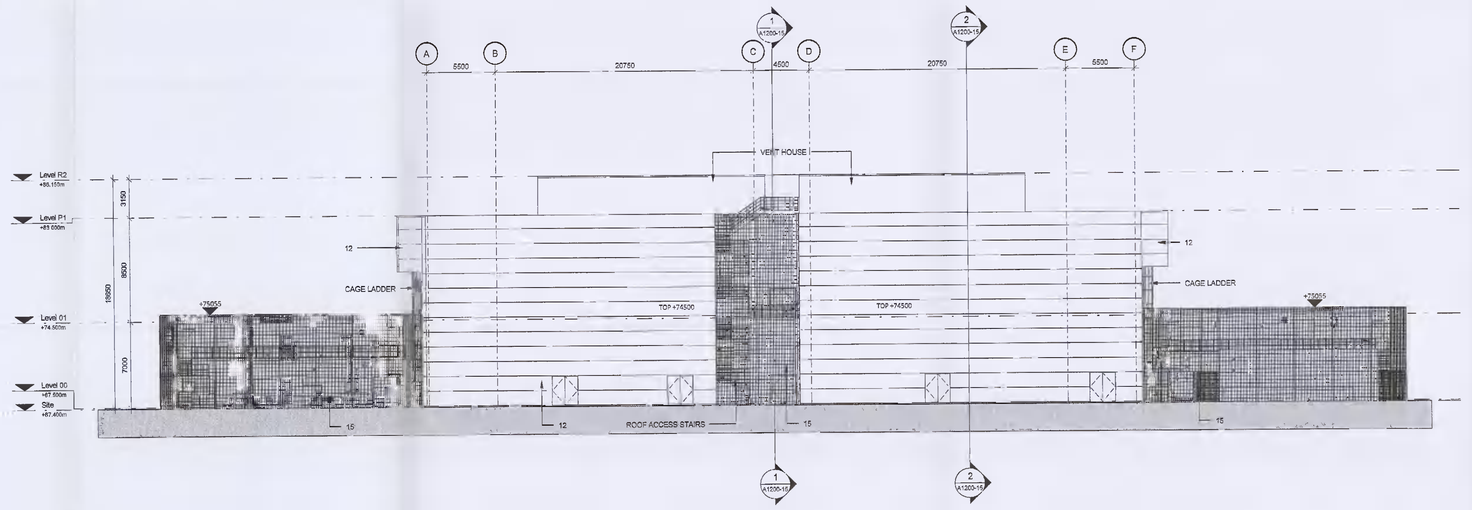

01- Elevation - As Approved - East Elevation

Scale 1 : 250

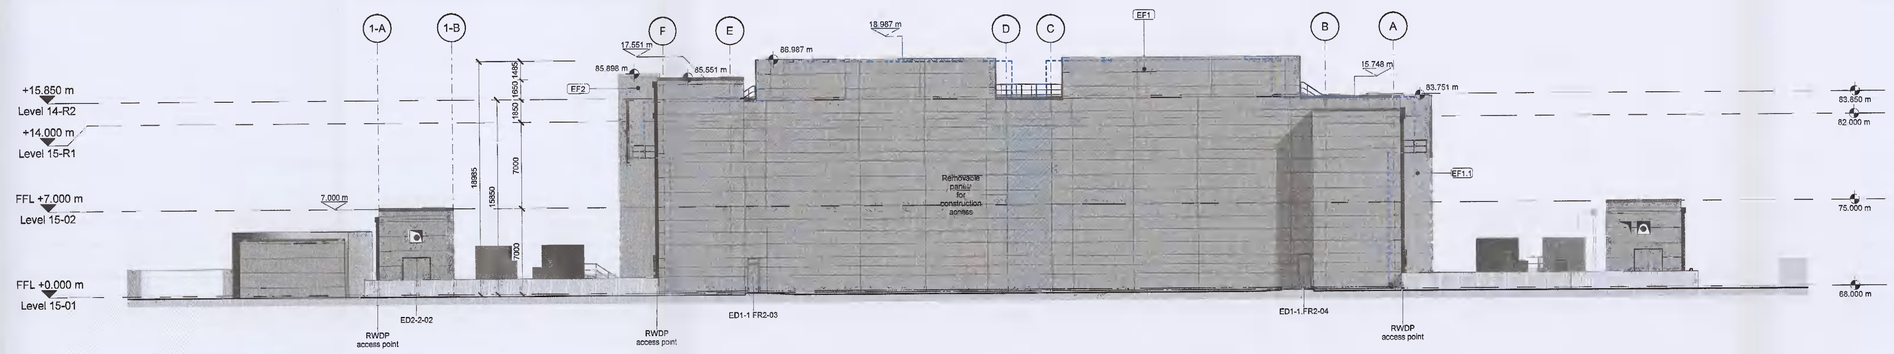

2- Elevation - Proposed - East Elevation

Scale 1 : 250

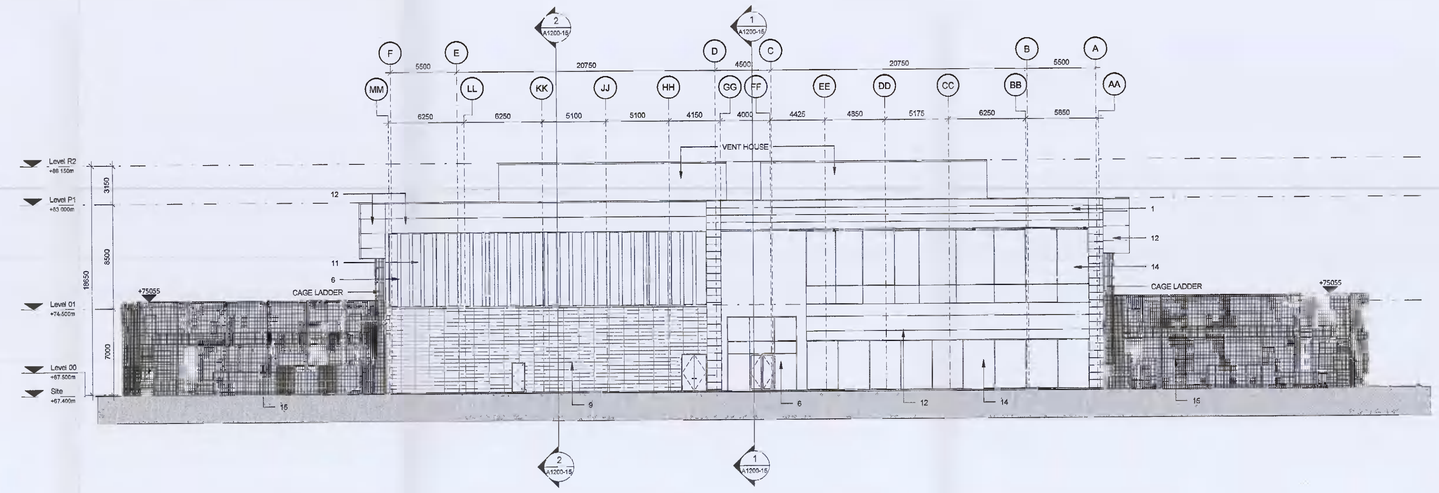

3- Elevation - As Approved - West Elevation

Scale 1 : 250

1- Elevation - Proposed - West Elevation

Scale 1 : 250

Approvals:

Customer	Microsoft	Date | 25/01/21
Microsoft Mechanical Engineer	Greg Lynch	
Microsoft Telecom Engineer	Cathal O'Sullivan	
Microsoft Electrical Engineer	Alan Killett	
Engineering Manager	Declan Comerford	
Security Manager	Michael O'Donnell	
CSA	Lasse Maher / Sharenda Naidu	

General Notes:

1. This is not an installation drawing and shows design intent information only.
2. All dimensions are in millimetres (mm) unless noted otherwise. all levels are in metres (m)unless noted otherwise.
3. Do not scale, work to figured dimensions only. This drawing shall be read in conjunction with building services documents and other relevant contract documents.
4. Equipment and plant details are not manufacturer specific. Contractor selected equipment shall meet the given constraints and long lead equipment will be coordinated by the CC based on final equipment selection.
5. All service penetrations through fire rated compartments shall be fire stopped to achieve a rating equivalent to the compartment and shall be designed to accommodate thermal movement.
6. All services crossing the movement joints shall be installed to accommodate the movements as defined in the structural engineers contract documentation.
7. The Contractor will produce fully coordinated installation drawings prior to installation for approval.
8. The Contractor will produce as built drawings prior to handover for approval.

LEGEND - FACADE TYPES

- EF1, Facade Metal Composite Panel , RAL 9006 (EWS-01)
- EF1.1, Facade Metal Composite Panel , RAL 7043 (EWS-01)
- EF2, Fire Rated Metal Composite Panel , RAL 7043 (EWS-01)
- EF3, Fire Rated Metal Composite Panel , RAL 9006 (EWS-01)
- EF4, Rainscreen Cladding, RAL7045 (EWS-06)
- EF5, Canopy Cladding, RAL 7043 (EWS-09)
- EF6, Facade Glazing System with Vertical Facade Fins (EWS-02, EWS-07)
- EF7, Facade Glazing System (EWS-02)
- EF8, Louvre Panels, RAL 7043 (EWS-04)
- EF9, Insulated Facade Panels, RAL 7043 (EWS-02)
- Vertical Louvres (EWS-03)

Key:

Outline of planning approved

Issue	Date	Revision Description
P01	25.06.21	Issue for Planning

ARUP

Client: Microsoft

Project Title
DUB 14/15
Proposed Modifications to Previously Approved Scheme SD20A\0283

Key Plan

Drawing Title
Approved and Proposed Elevations
DUB 15 Data Centre
Sheet 2

Scale at A0	As Indicated	By / Chkd / Appd CJ/MM/RA
Role	Architecture	
Status	S2 - Suitable for Information - Planning	
Arup Job No	279225	Rev. P01
ID	A1301 - 15	

14/07/2021 10:58:43

© Arup

Do not scale