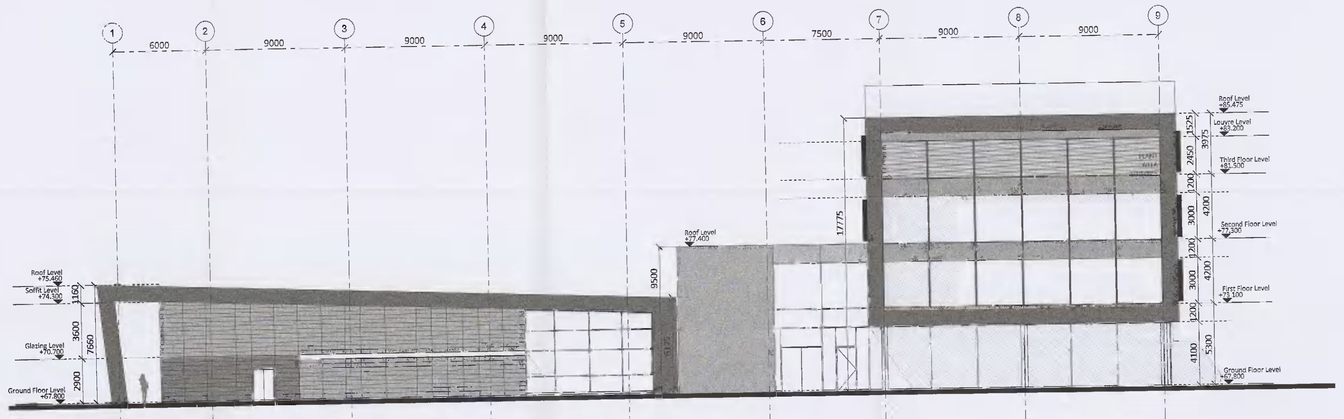

5 East Elevation Approved
1 : 200

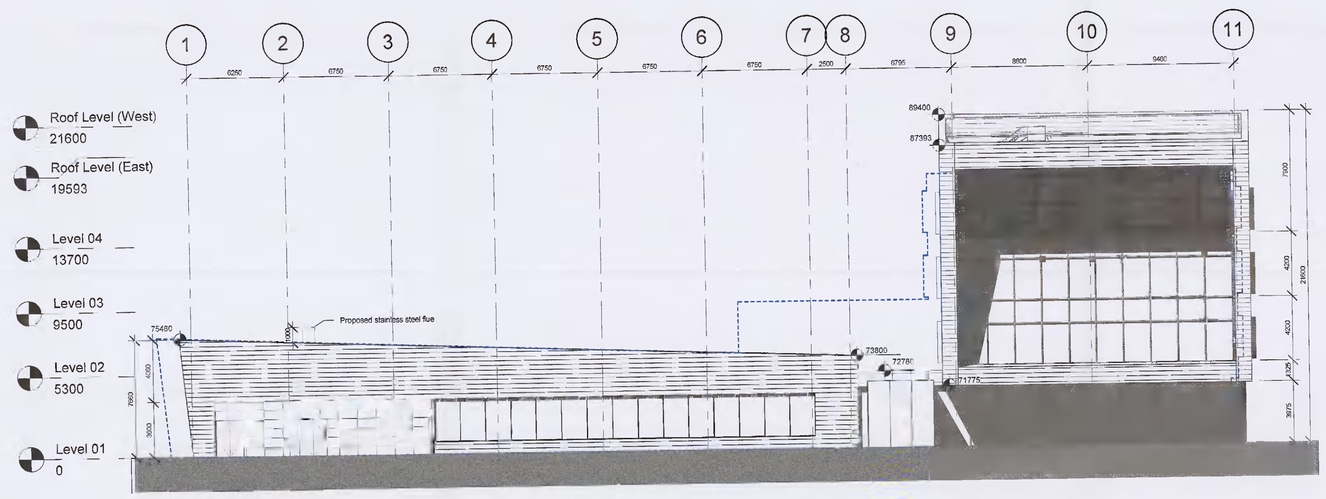

1 East Elevation Proposed
1 : 200

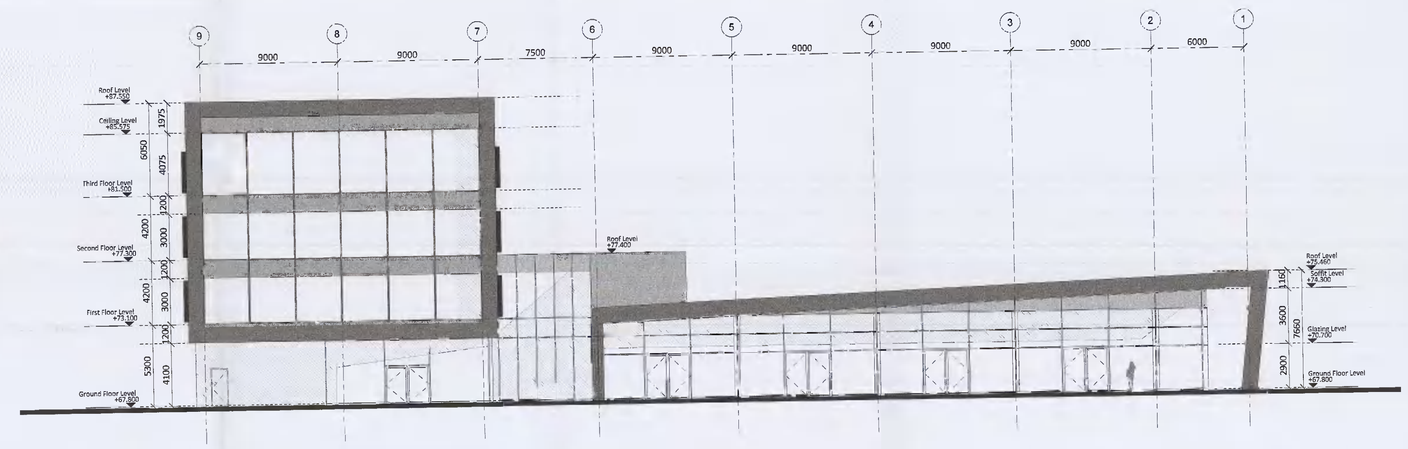

7 West Elevation Approved
1 : 200

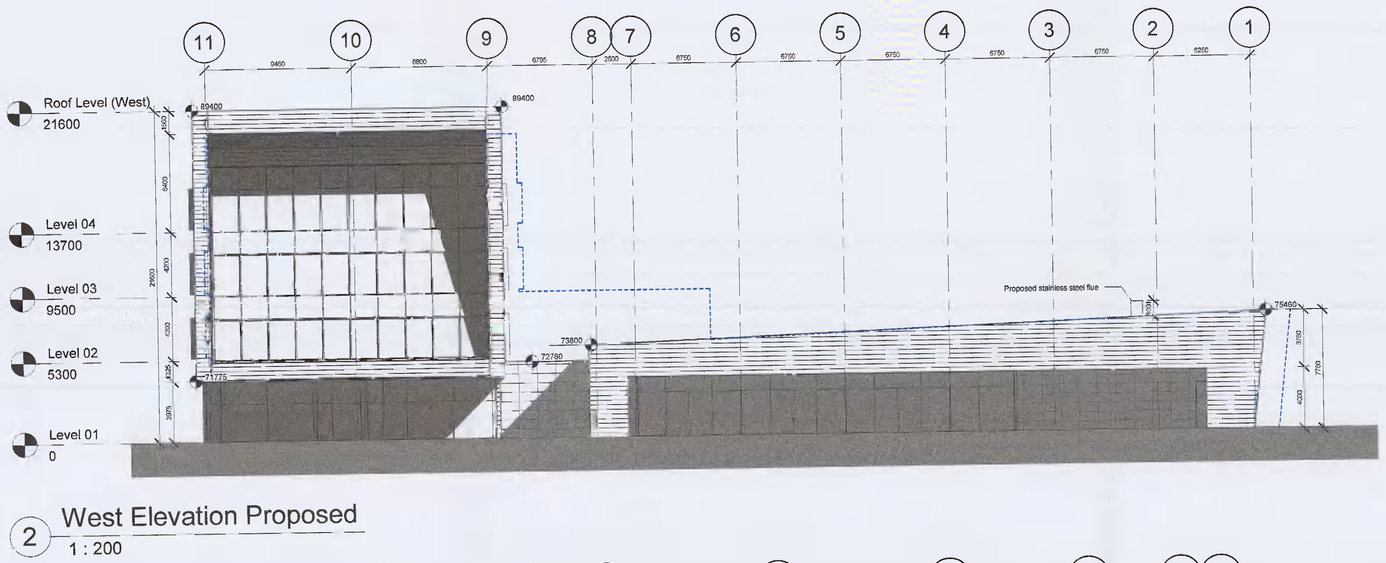

2 West Elevation Proposed
1 : 200

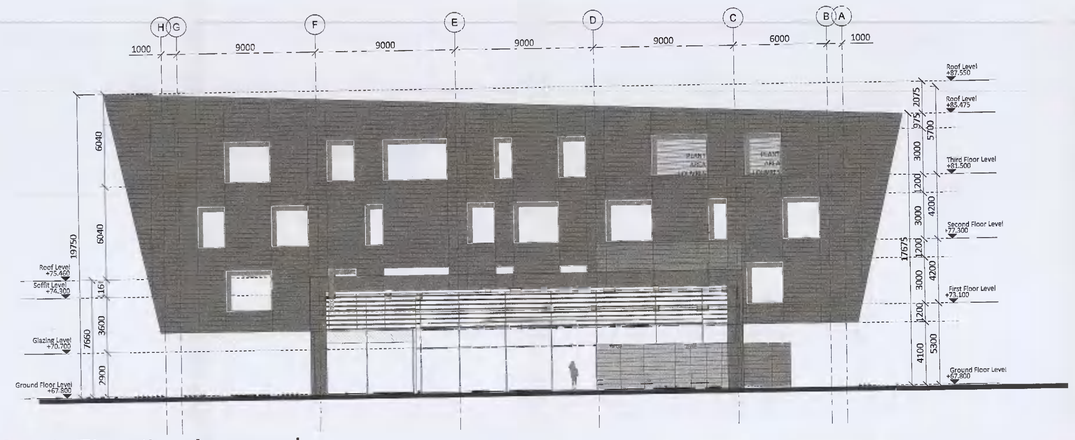

8 South Elevation Approved
1 : 200

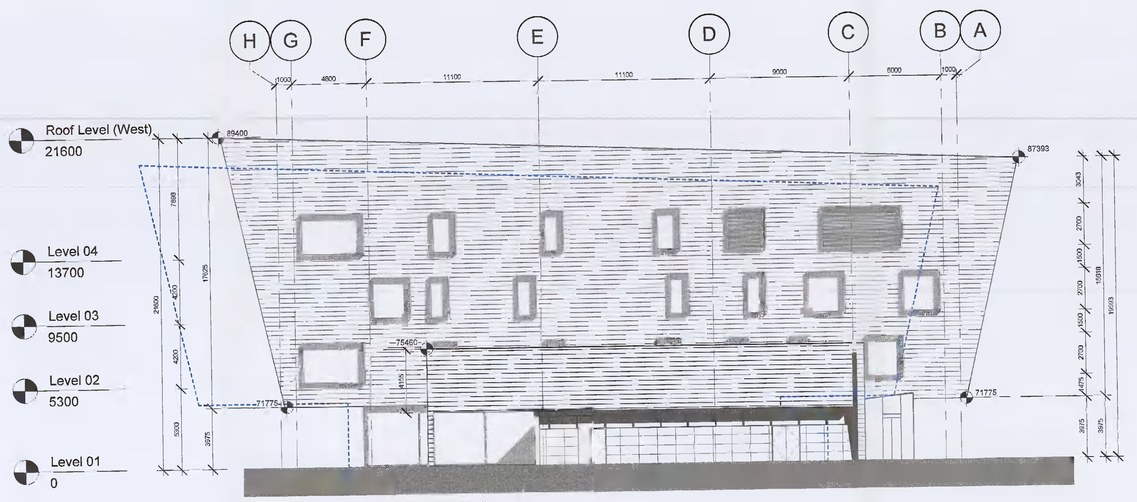

3 South Elevation Proposed
1 : 200

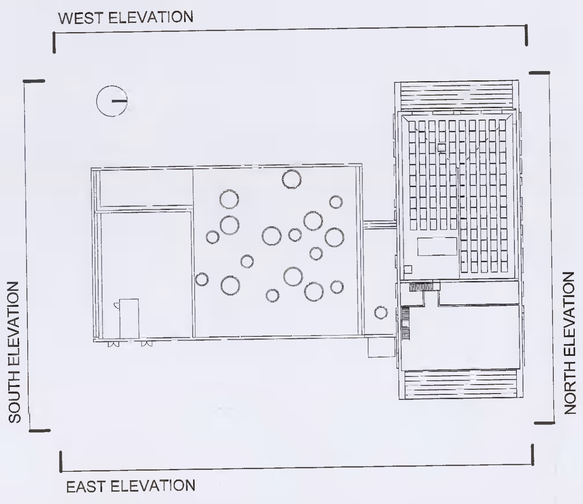

9 Key Plan
1 : 500

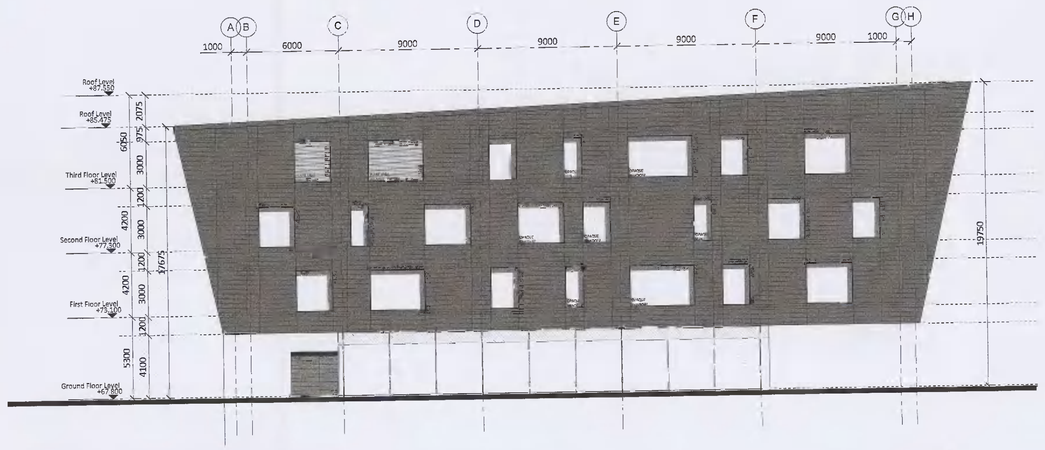

6 North Elevation Approved
1 : 200

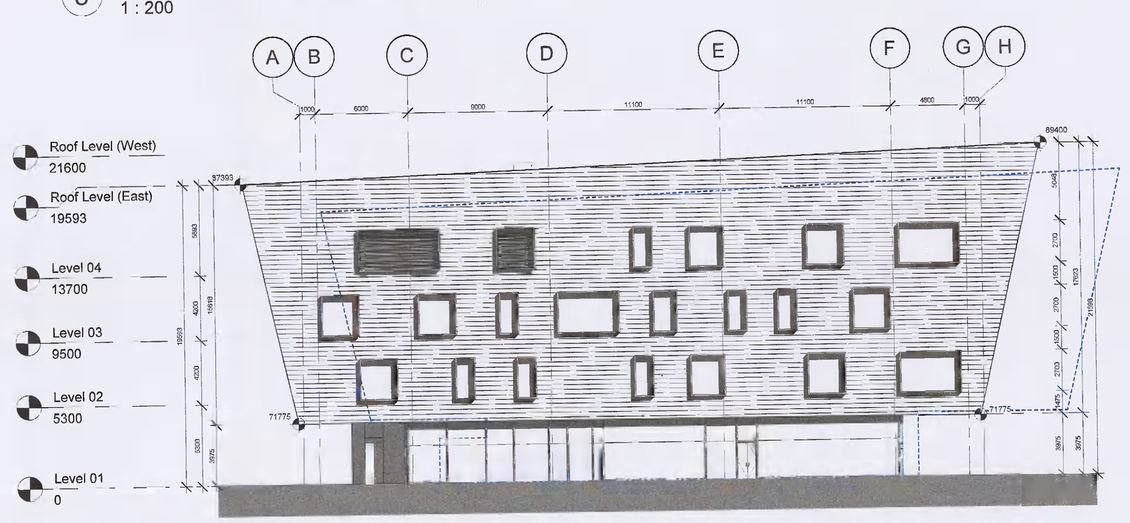

4 North Elevation Proposed
1 : 200

Approvals:

Customer	Microsoft	Date | 21/06/21
Microsoft Mechanical Engineer	Andy Leyn	
Microsoft Telecom Engineer	Cathal O'Sullivan	
Microsoft Electrical Engineer	Alan Kellett	
Engineering Manager	Docian Comerford	
Security Manager	Daniel Jones	
CRA	Lasse Maher / Sharendra Naicu / Jeff Schumacher	

General Notes:

1. This is not an installation drawing and shows design intent information only.
2. All dimensions are in millimetres (mm) unless noted otherwise. all levels are in metres (m)unless noted otherwise.
3. Do not scale; work to figured dimensions only. This drawing shall be read in conjunction with building services documents and other relevant contract documents.
4. Equipment and plant details are not manufacturer specific. Contractor selected equipment shall meet the given constrains and long lead equipment will be coordinated by the GC based on final equipment selection.
5. All service penetrations through fire rated compartments shall be fire stopped to achieve a rating equivalent to the compartment and shall be designed to accommodate thermal movement.
6. All services crossing the movement joints shall be installed to accommodate the movements as defined in the structural engineers contract documentation.
7. The Contractor will produce fully coordinated installation drawings prior to installation for approval.
8. The Contractor will produce as built drawings prior to handover for approval.

Denotes outline of approved (SD20A/0283) Buildings footprints

Issue	Date	Revision Description
P01	25/06/21	Issued for Planning

ARUP Microsoft

DONNELLY TURPIN ARCHITECTS
50 Dorset Street Lower, Dublin, D02 CH60
Tel: +353(0)1 475 9065
E: projects@donnellyturpin.com
W:www.donnellyturpin.com

Client

Project Title
DUB 14/15
Proposed Modifications to Previously Approved Scheme SD20A/0283

Drawing Title
Elevations
Office Building
(Approved & Proposed Comparison)

Scale at A0	As indicated	By / Chkd / Appd	SJ / JWS/CR/AMMT
Role	Architecture		
Status	S2 - Suitable for Information - Planning		
Job No	2035	Rev	P01
ID	A1300		

© Donnelly Turpin Architects