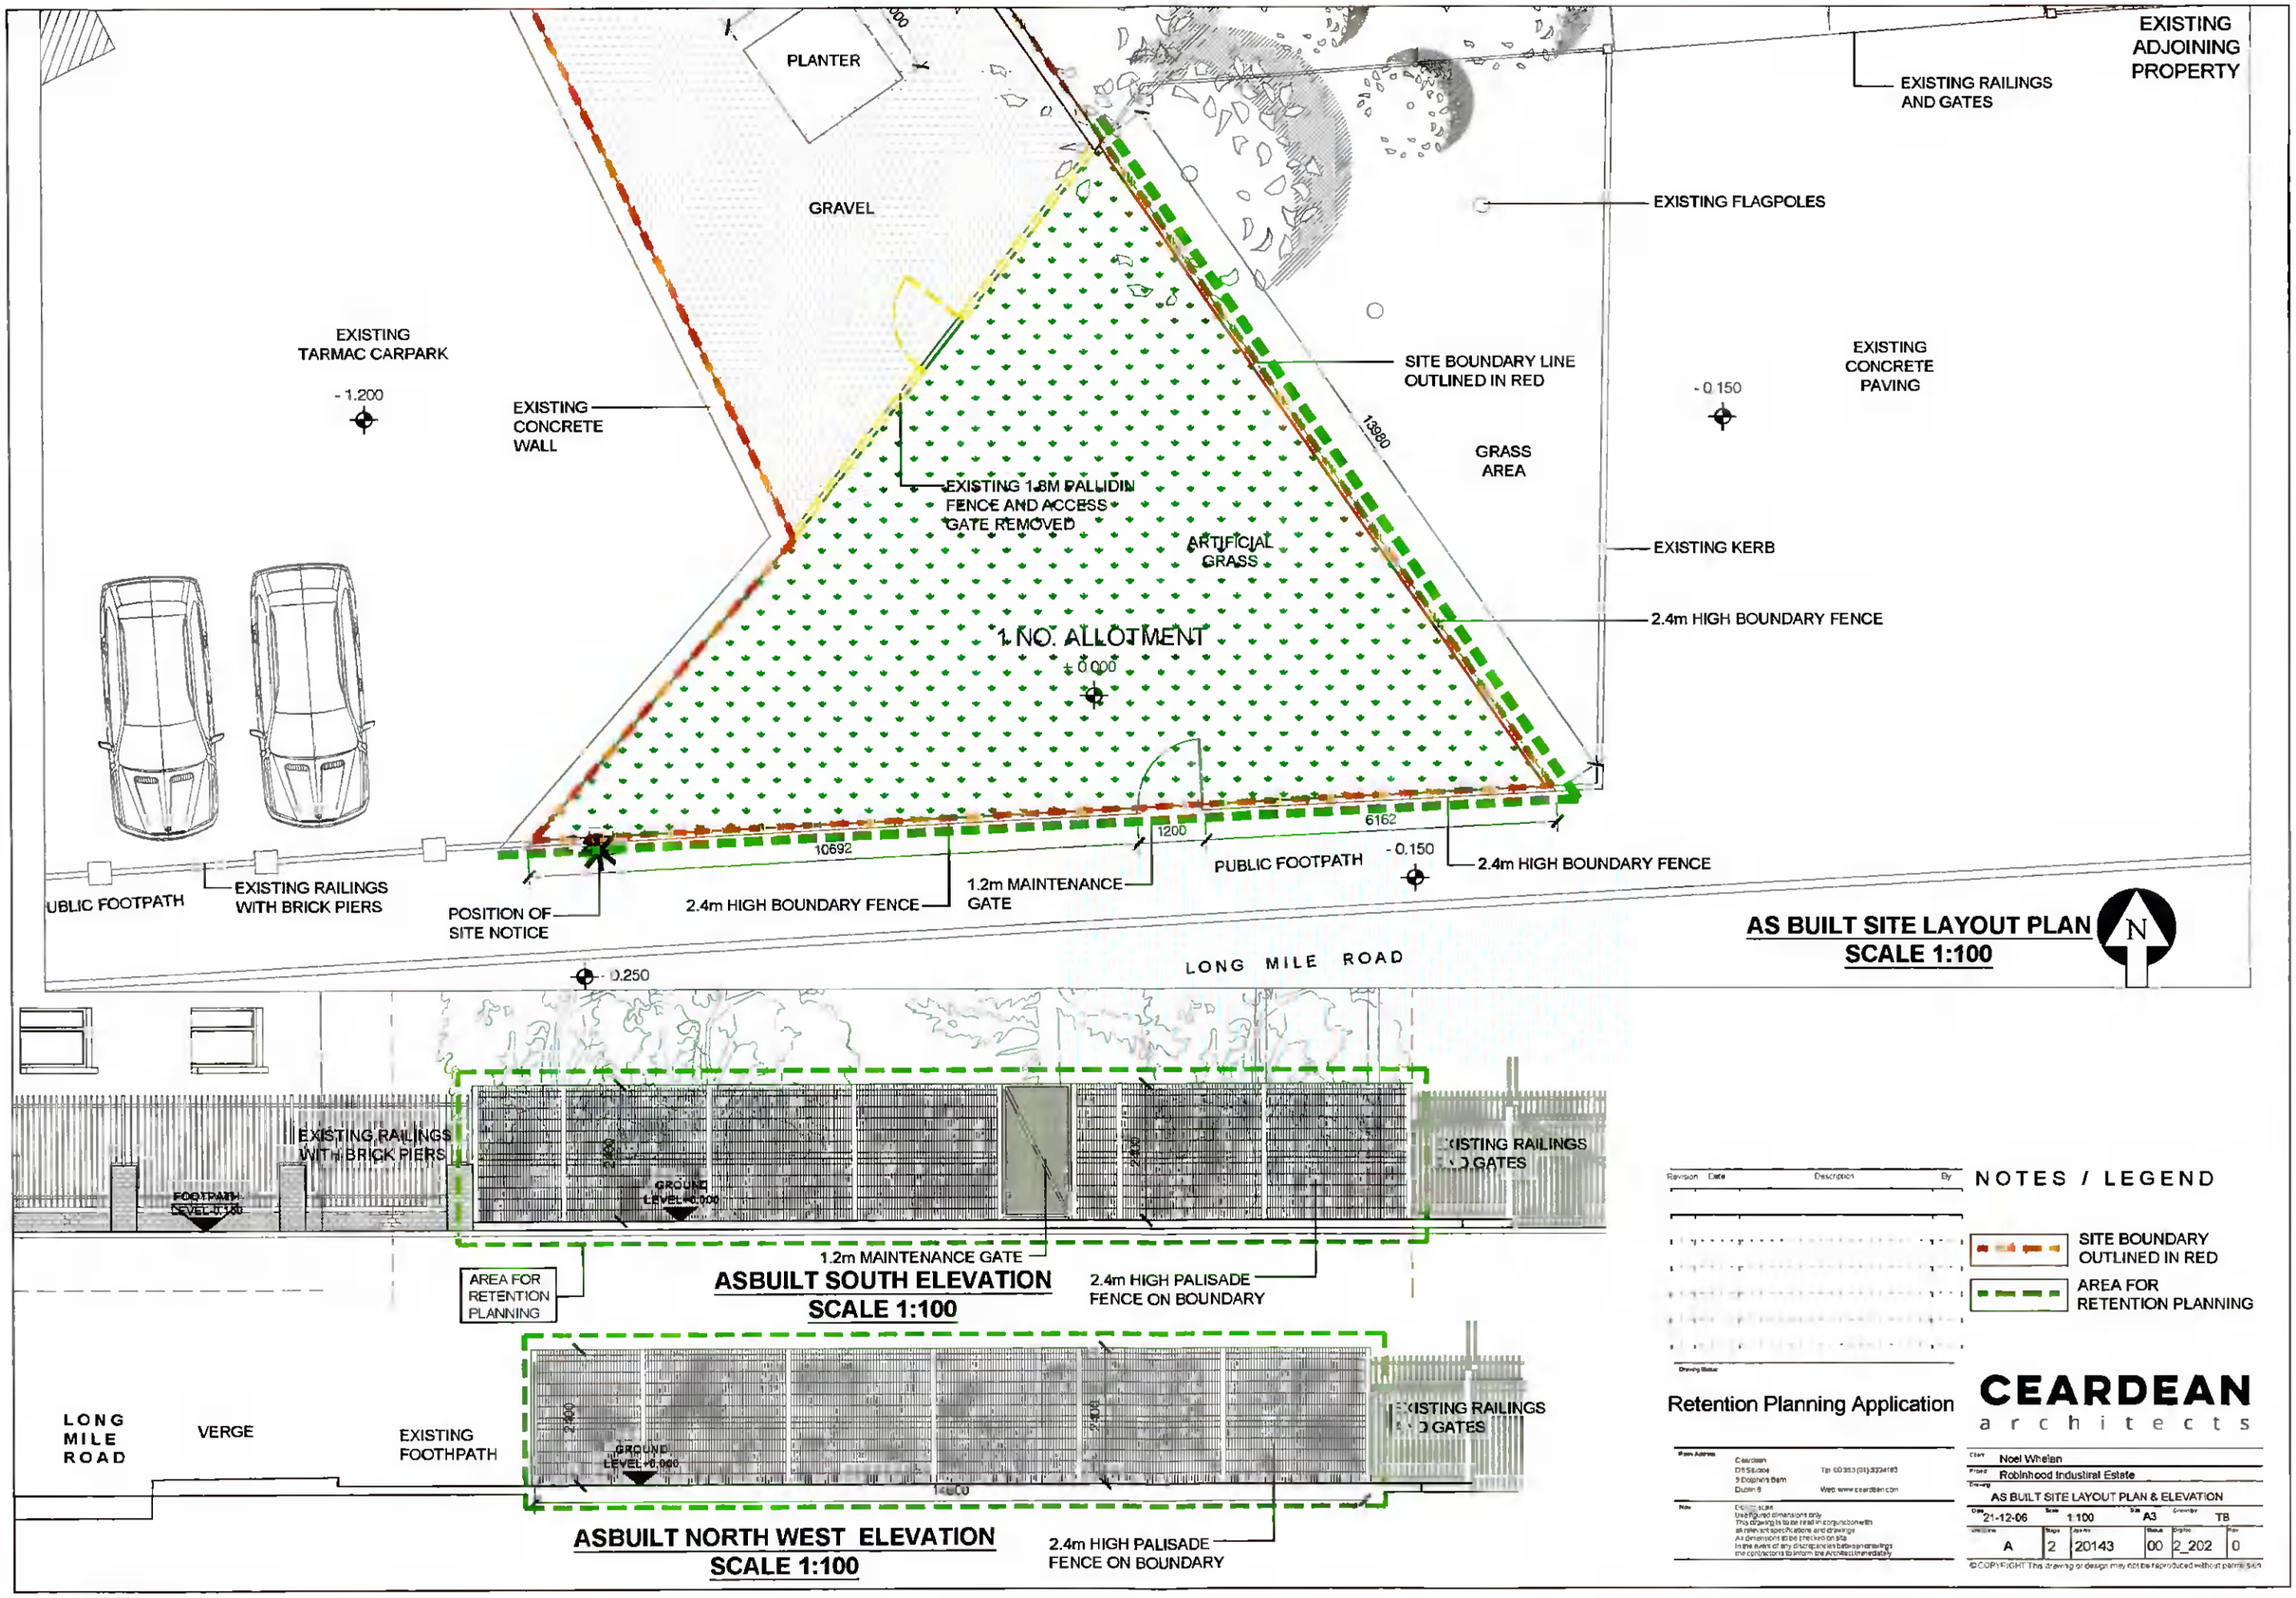

AS BUILT SITE LAYOUT PLAN
SCALE 1:100

ASBUILT SOUTH ELEVATION
SCALE 1:100

ASBUILT NORTH WEST ELEVATION
SCALE 1:100

NOTES / LEGEND

SITE BOUNDARY OUTLINED IN RED

AREA FOR RETENTION PLANNING

Revision | Date | Description | By

Drawing Status:

Retention Planning Application

CEARDEAN architects

Client: Noel Whelan

Project: Robinhood Industrial Estate

Drawing: AS BUILT SITE LAYOUT PLAN & ELEVATION

Date	Scale	Size	Drawn by
21-12-06	1:100	A3	TB

Unit Name	Stage	Job No	Status	Drg No	Rev
A	2	20143	00	2_202	0

© COPYRIGHT This drawing or design may not be reproduced without permission