




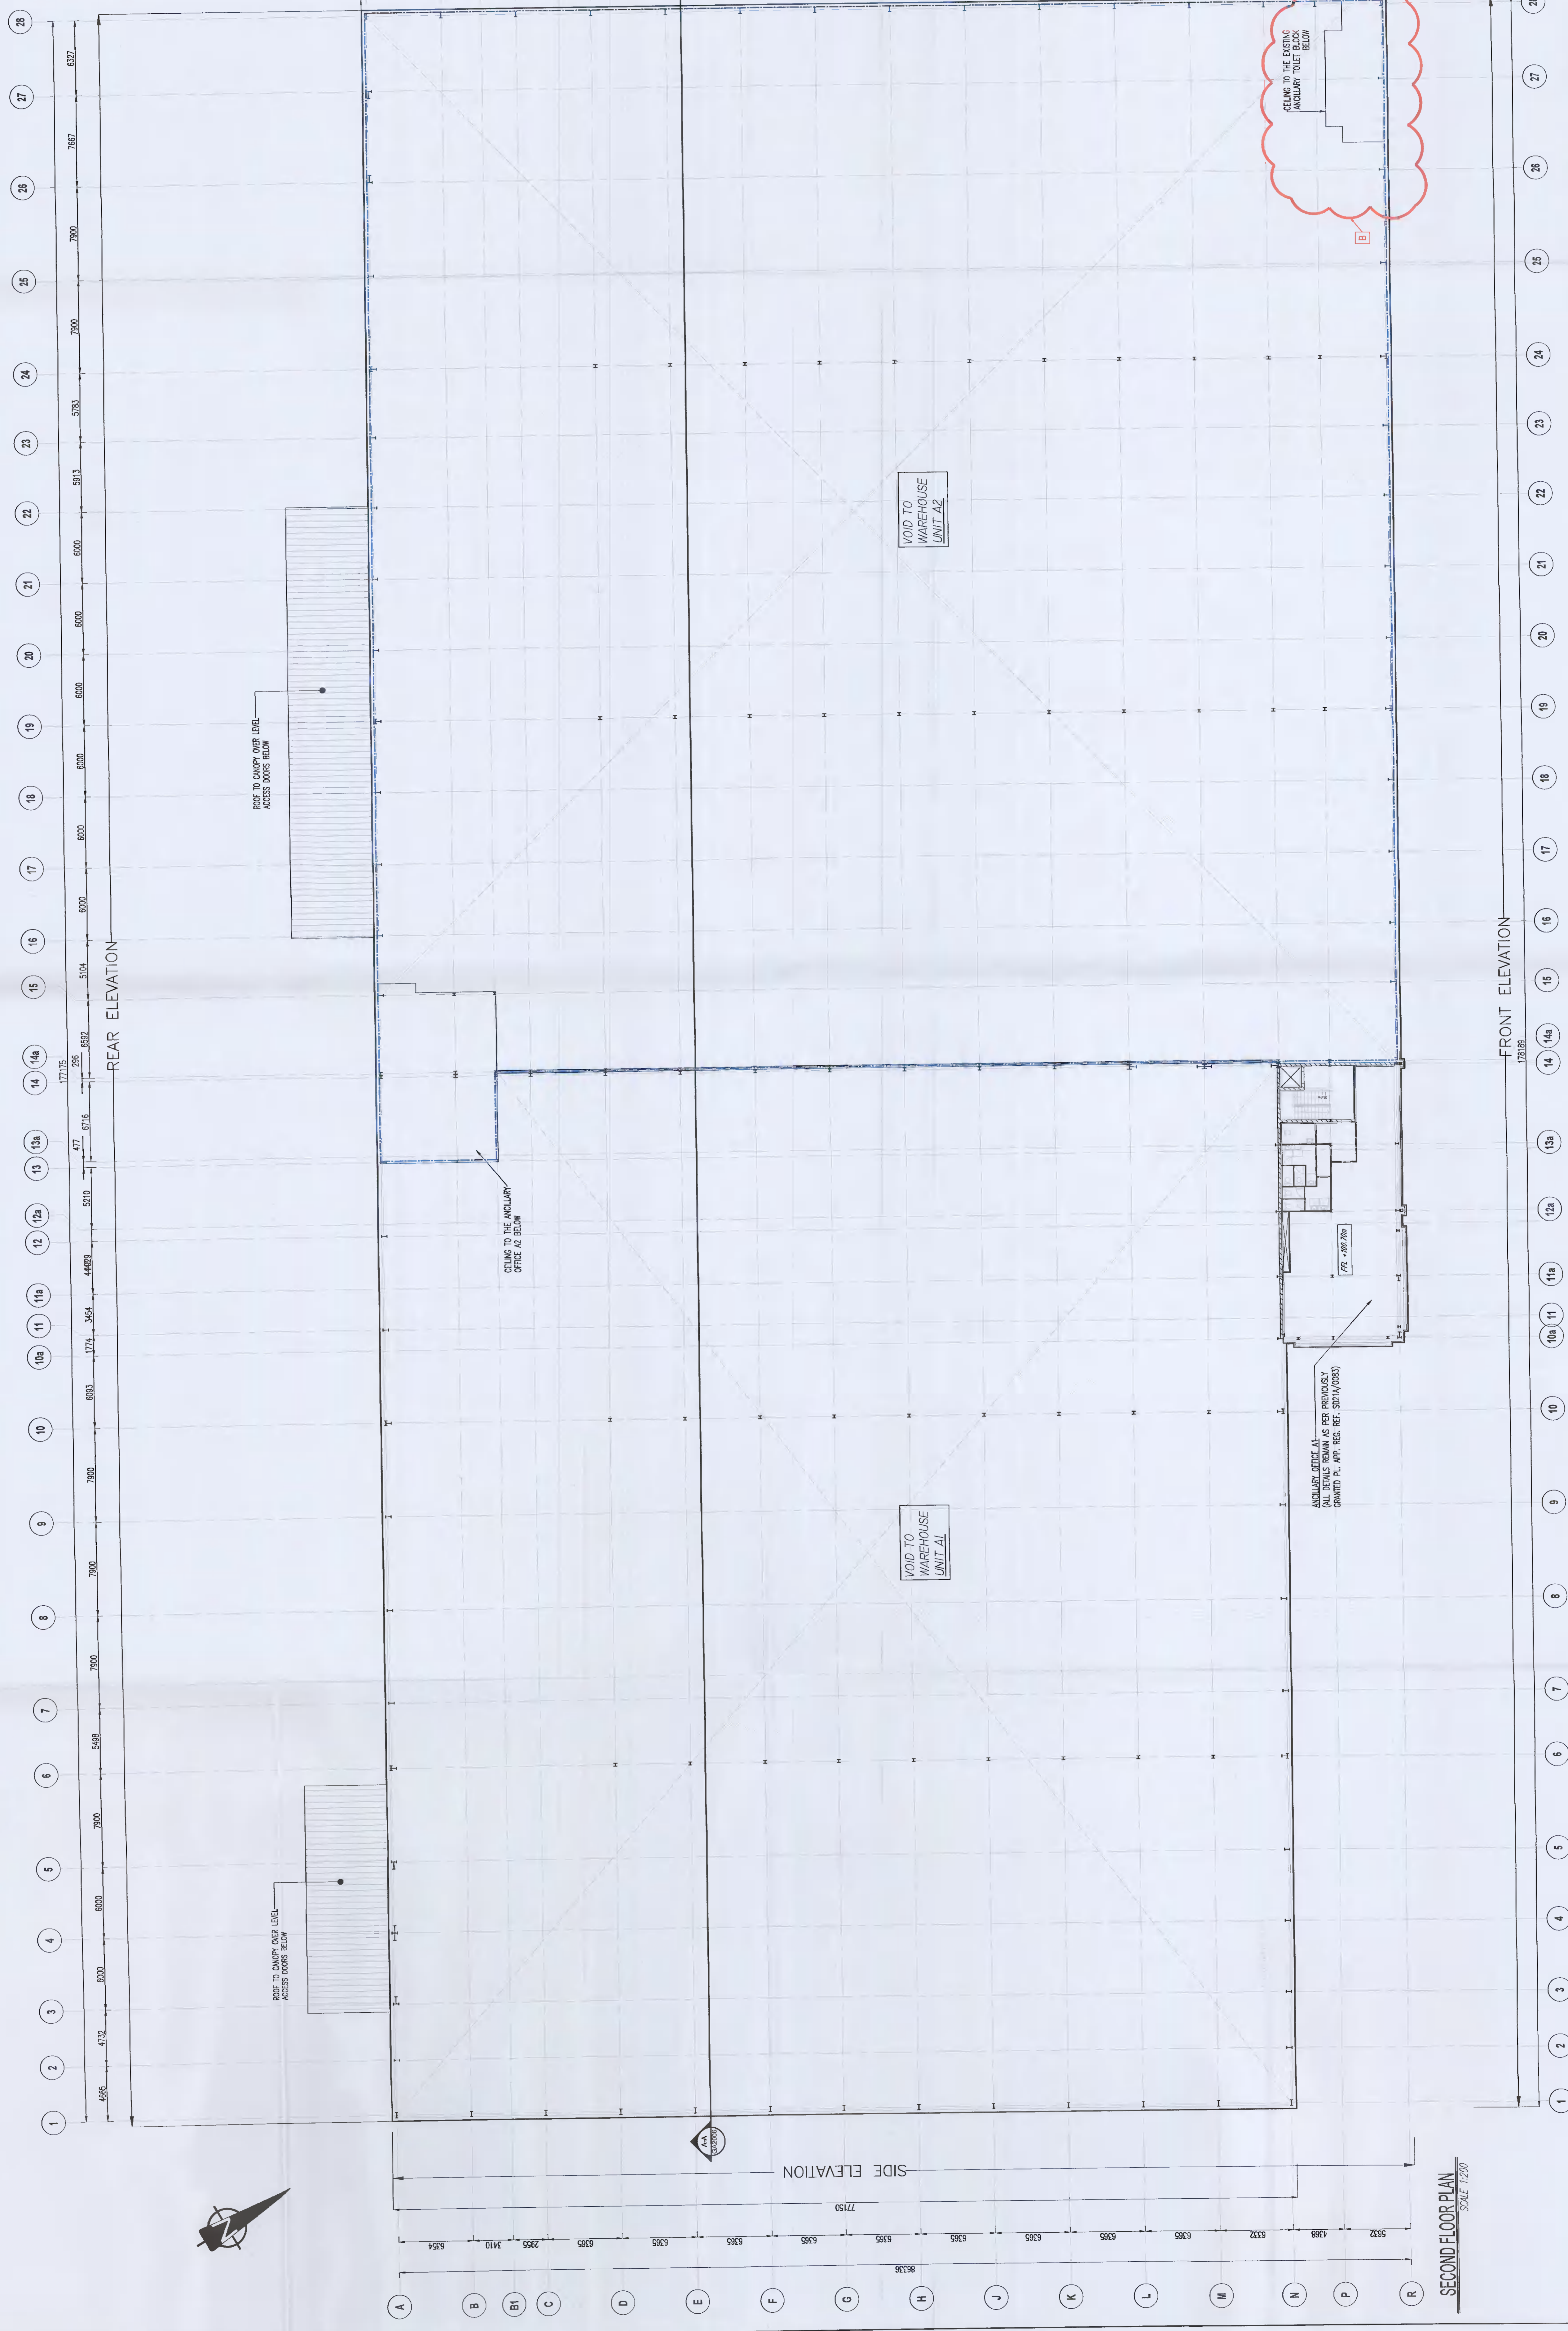

ALTERATIONS DESCRIPTION:
 Alterations refer to subdivided Unit A2 only and are shown in red. Existing structures are shown in grey which is no longer required as part of the development.
 The results of:
 - Change of use of 133m² ancillary office/staff facilities area on the ground floor to warehouse area, and
 - Provision of 17m² ancillary office/staff facilities area on the first floor.
 All other details remain as per the granted application No. P/1627/A/0063.

KEY PLAN
 SCALE: 1:2500

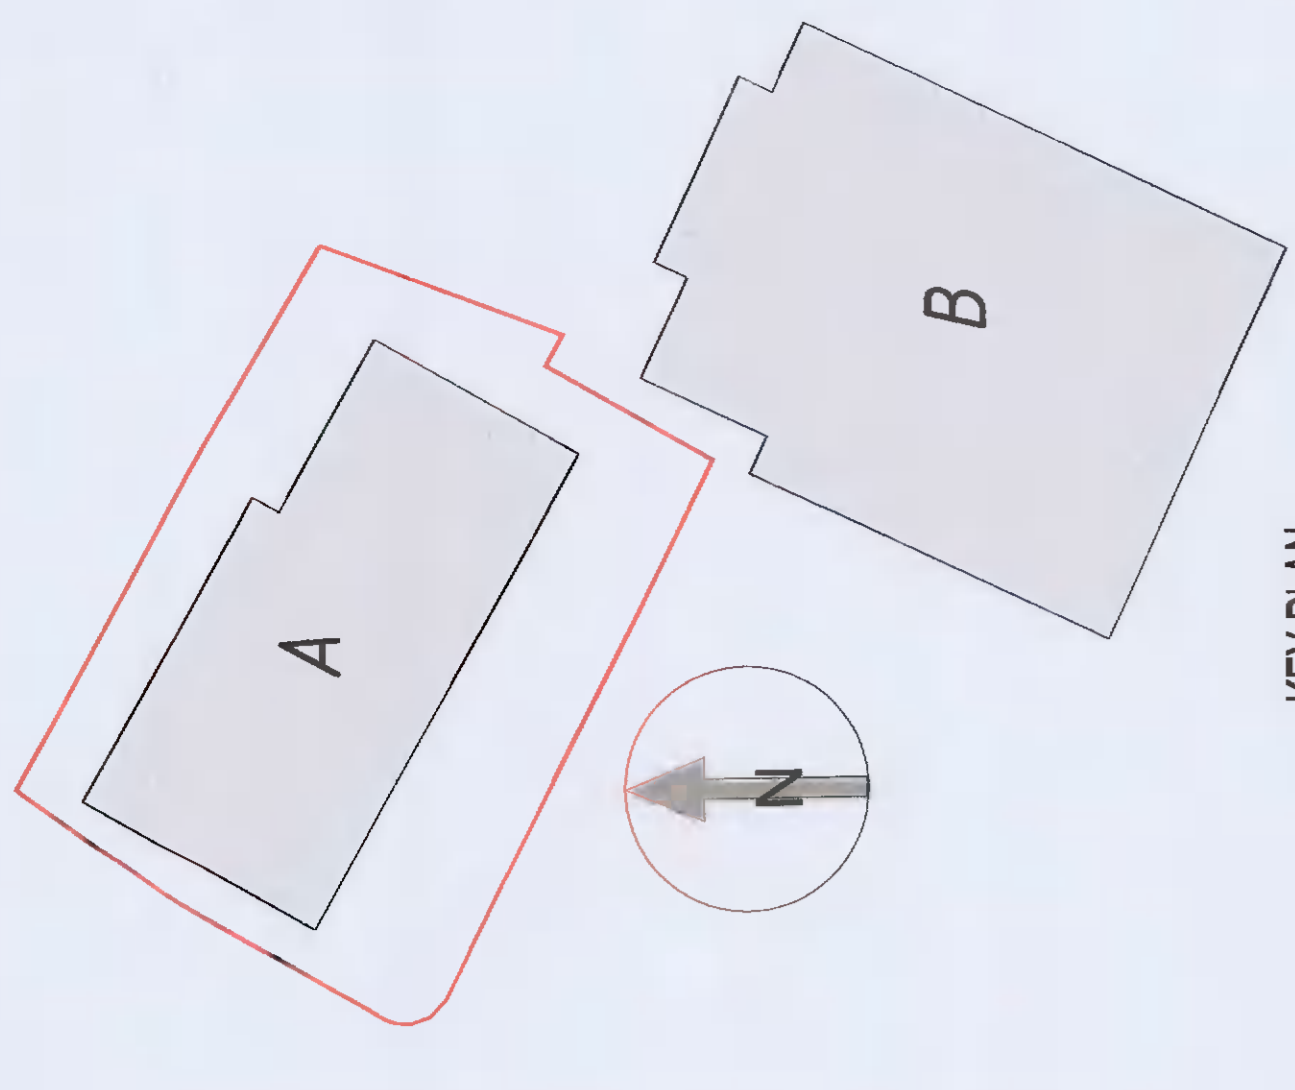

SECOND FLOOR PLAN
 SCALE: 1:200

<p>KAVANAGH BURKE CONSULTING ENGINEERS</p> <p>14, 15, 16, 17,</p>	
--	--