
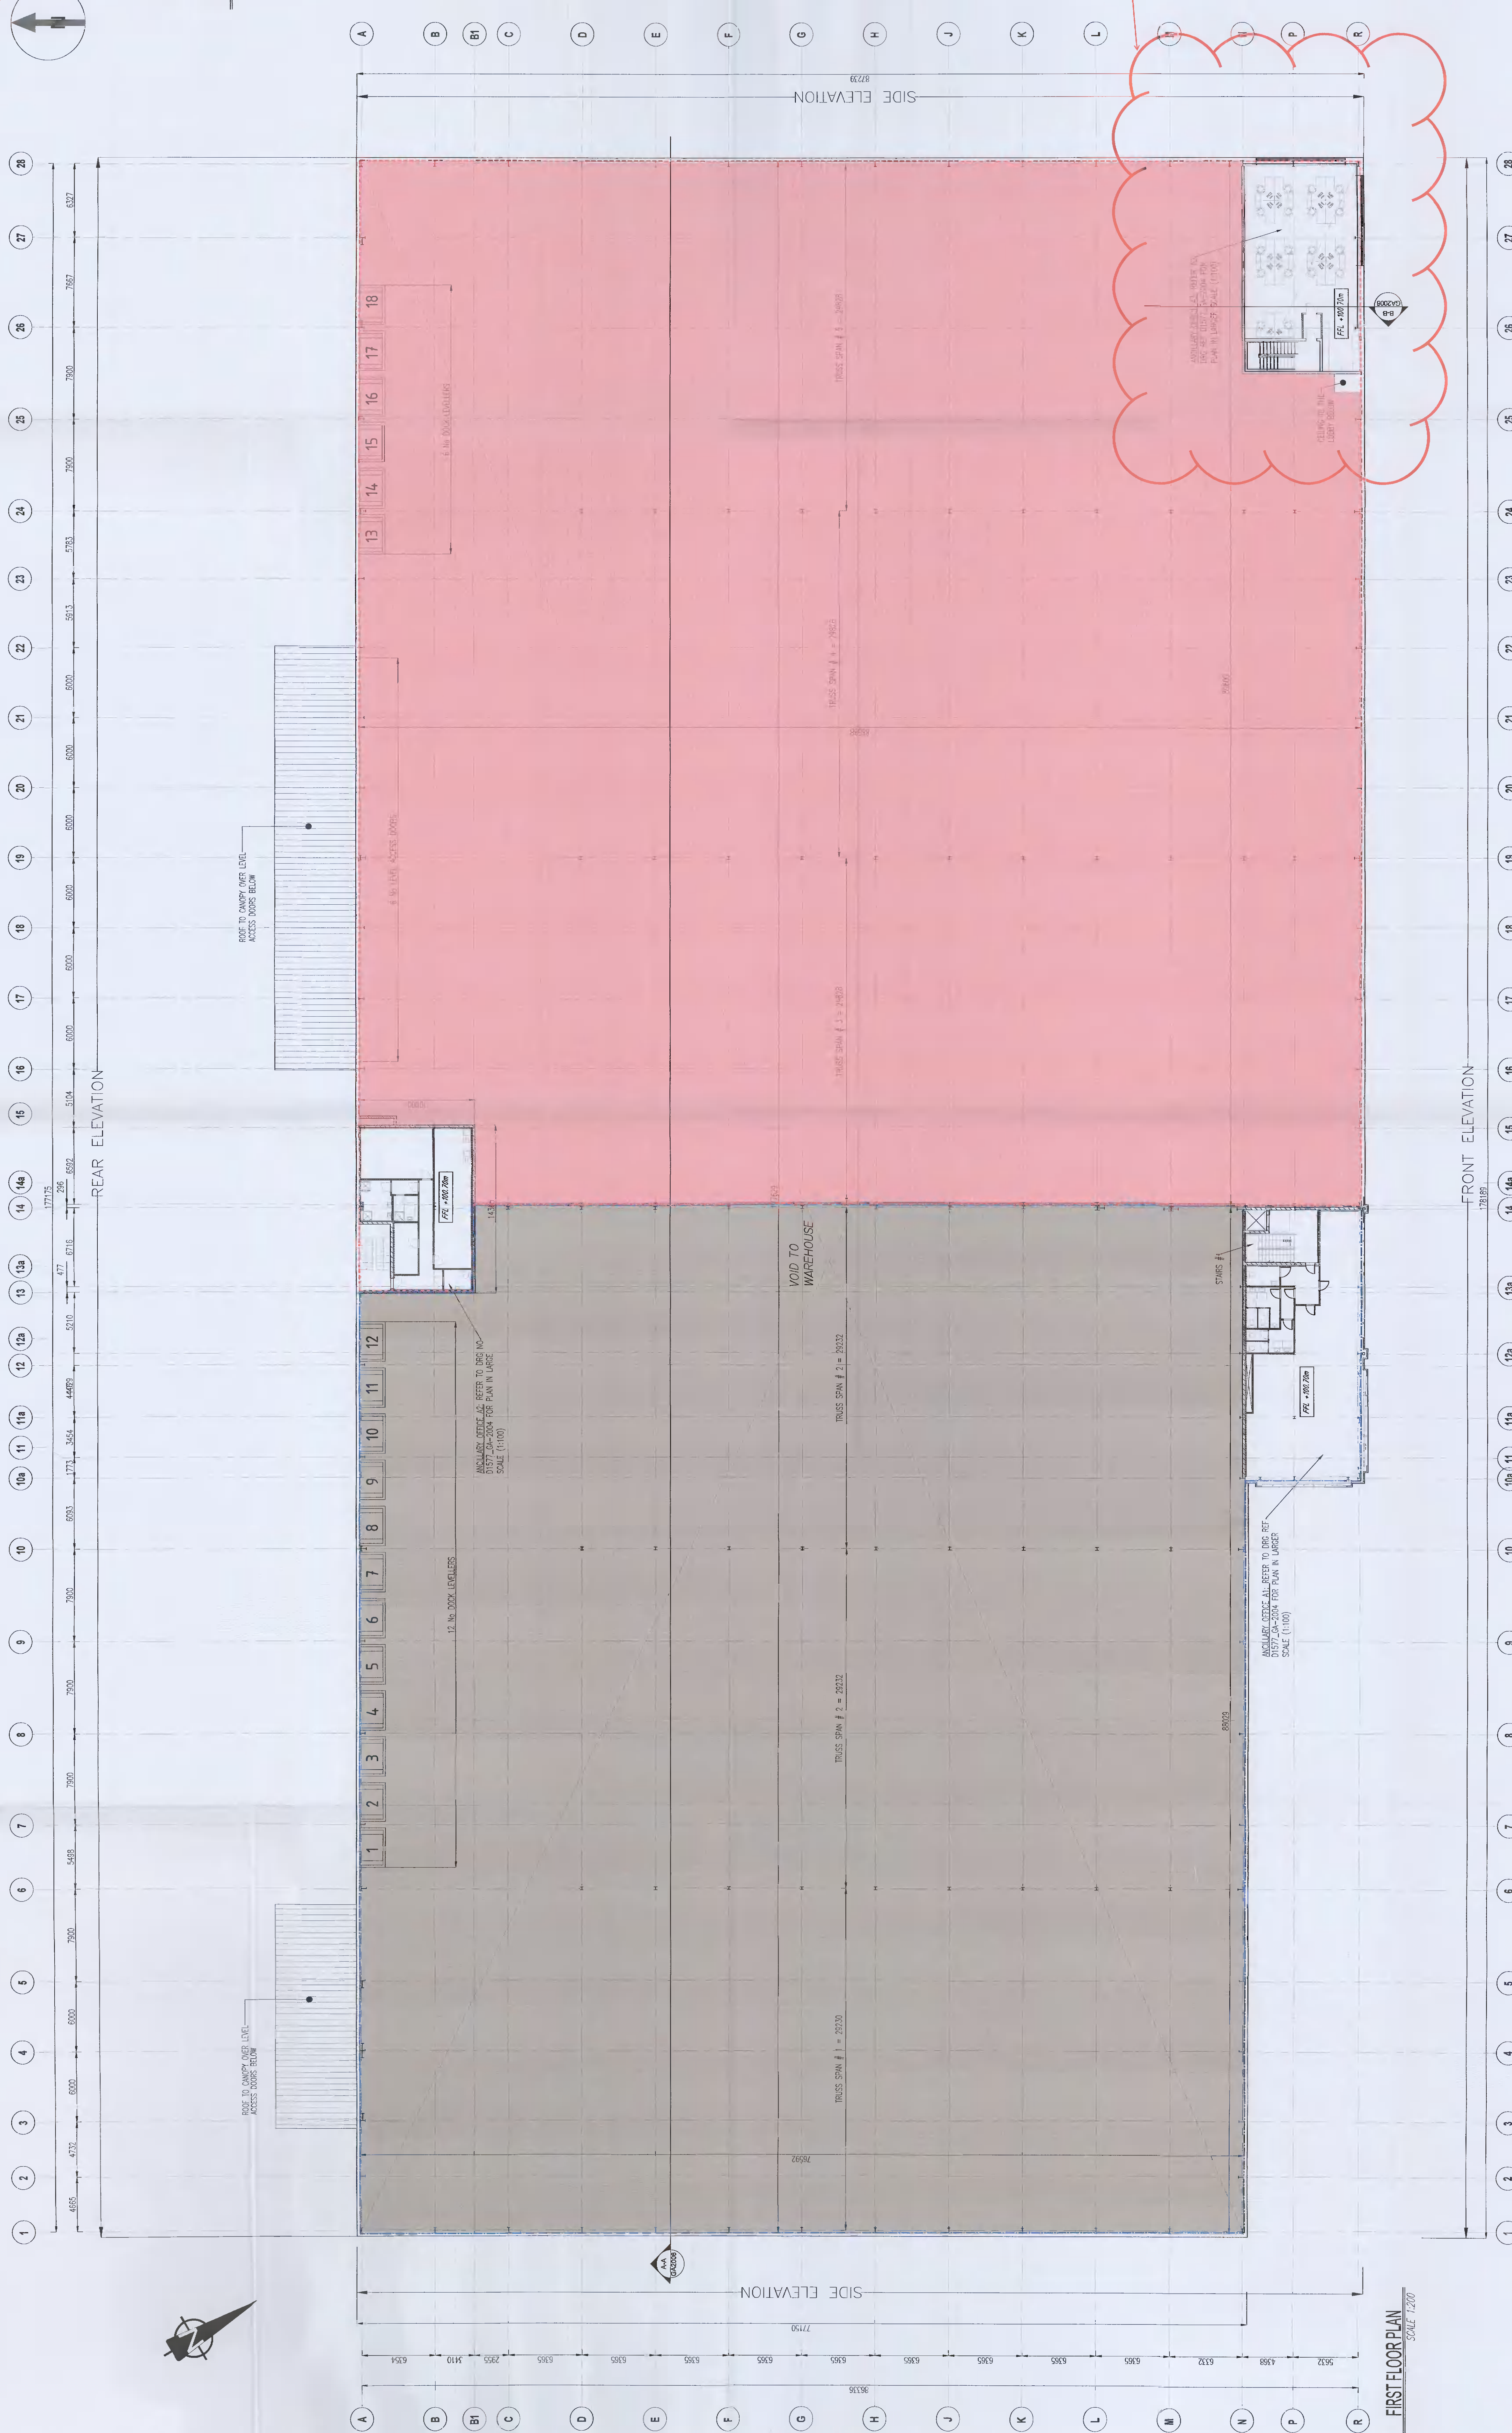



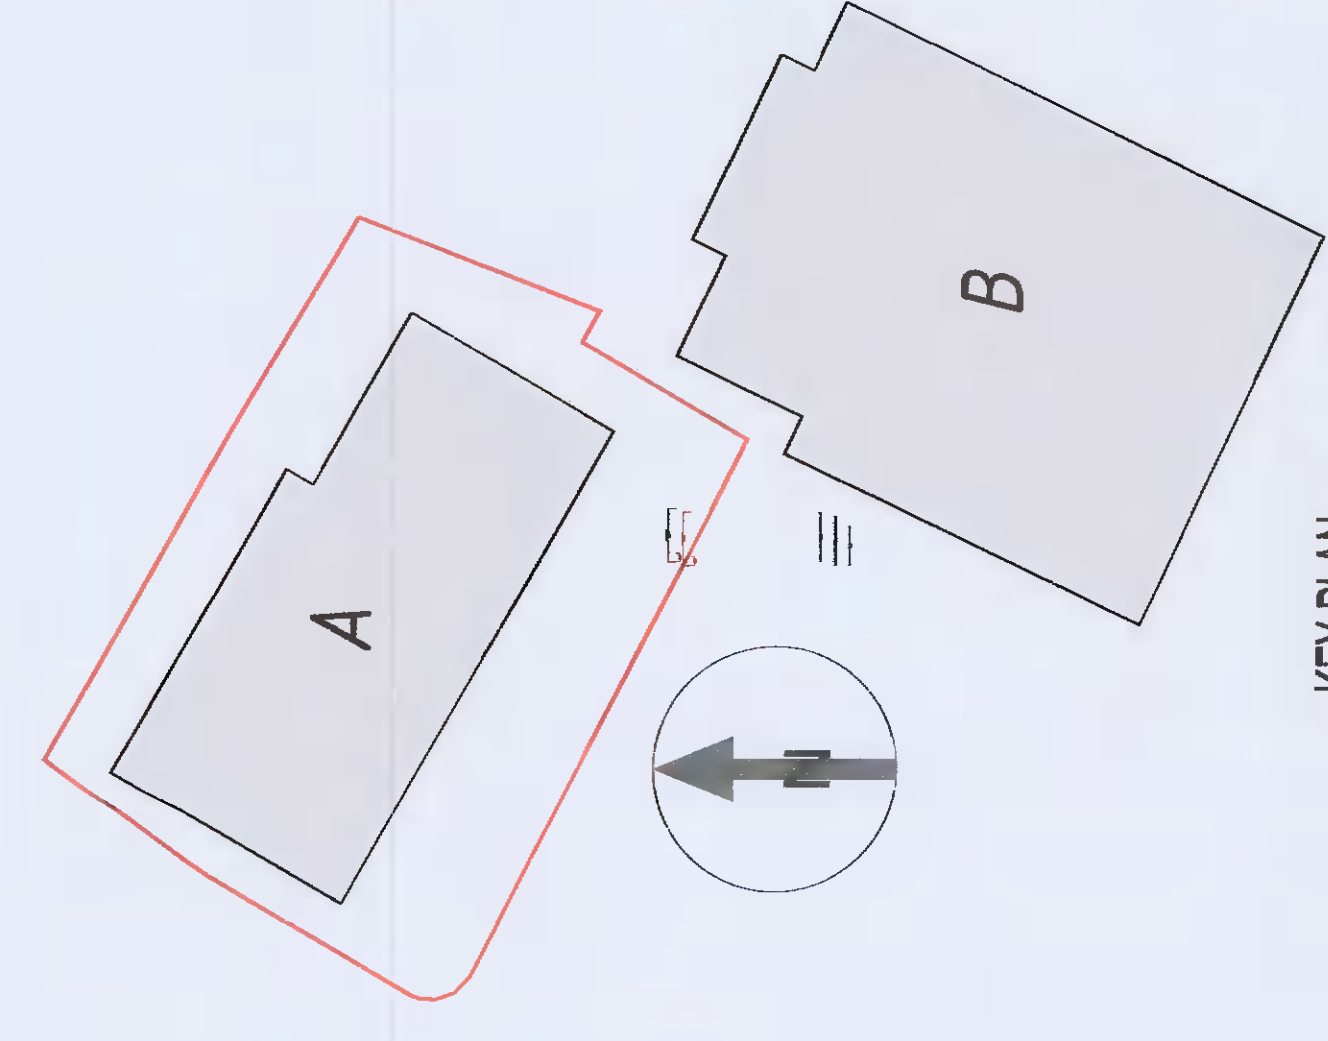

AREA SUBJECT TO THIS PLANNING ALTERATION APPLICATION


NOTE: THIS IS A RECORD DRAWING ONLY.

INDUSTRIAL DEVELOPMENT AT  
COLLEGE LANE GREENOUE  
RATHCOOLE CO. DUBLIN

Project: PLANNING ALTERATIONS (1) BLOCK A

Client: Aerofarms PropCo Limited

**KAVANAGH BURKE**  
CONSULTING ENGINEERS

11 - 452 9694 Unit G3, Calmount Pt.  
12 - 452 4340 Balmacan  

Scale: 1:200

Project No: GA-2022

Sheet No: D1577

Date: 15/01/2024

FIRST FLOOR PLAN  
SCALE 1:200