


NRB Consulting Engineers Ltd recommend that Road and land ownership boundaries are verified through Legal & Land searches by the Client.
 This drawing is based upon Downey Planning drawing S25-001-A1-001_Site Layout - Ground Floor Plan, received 12/04/22. NRB Consulting Engineers Ltd shall not be liable for any inaccuracies or deficiencies.



AUTOTRACK OF A LARGE REFUSE VEHICLE ENTERING THE LOADING/SET-DOWN AREA

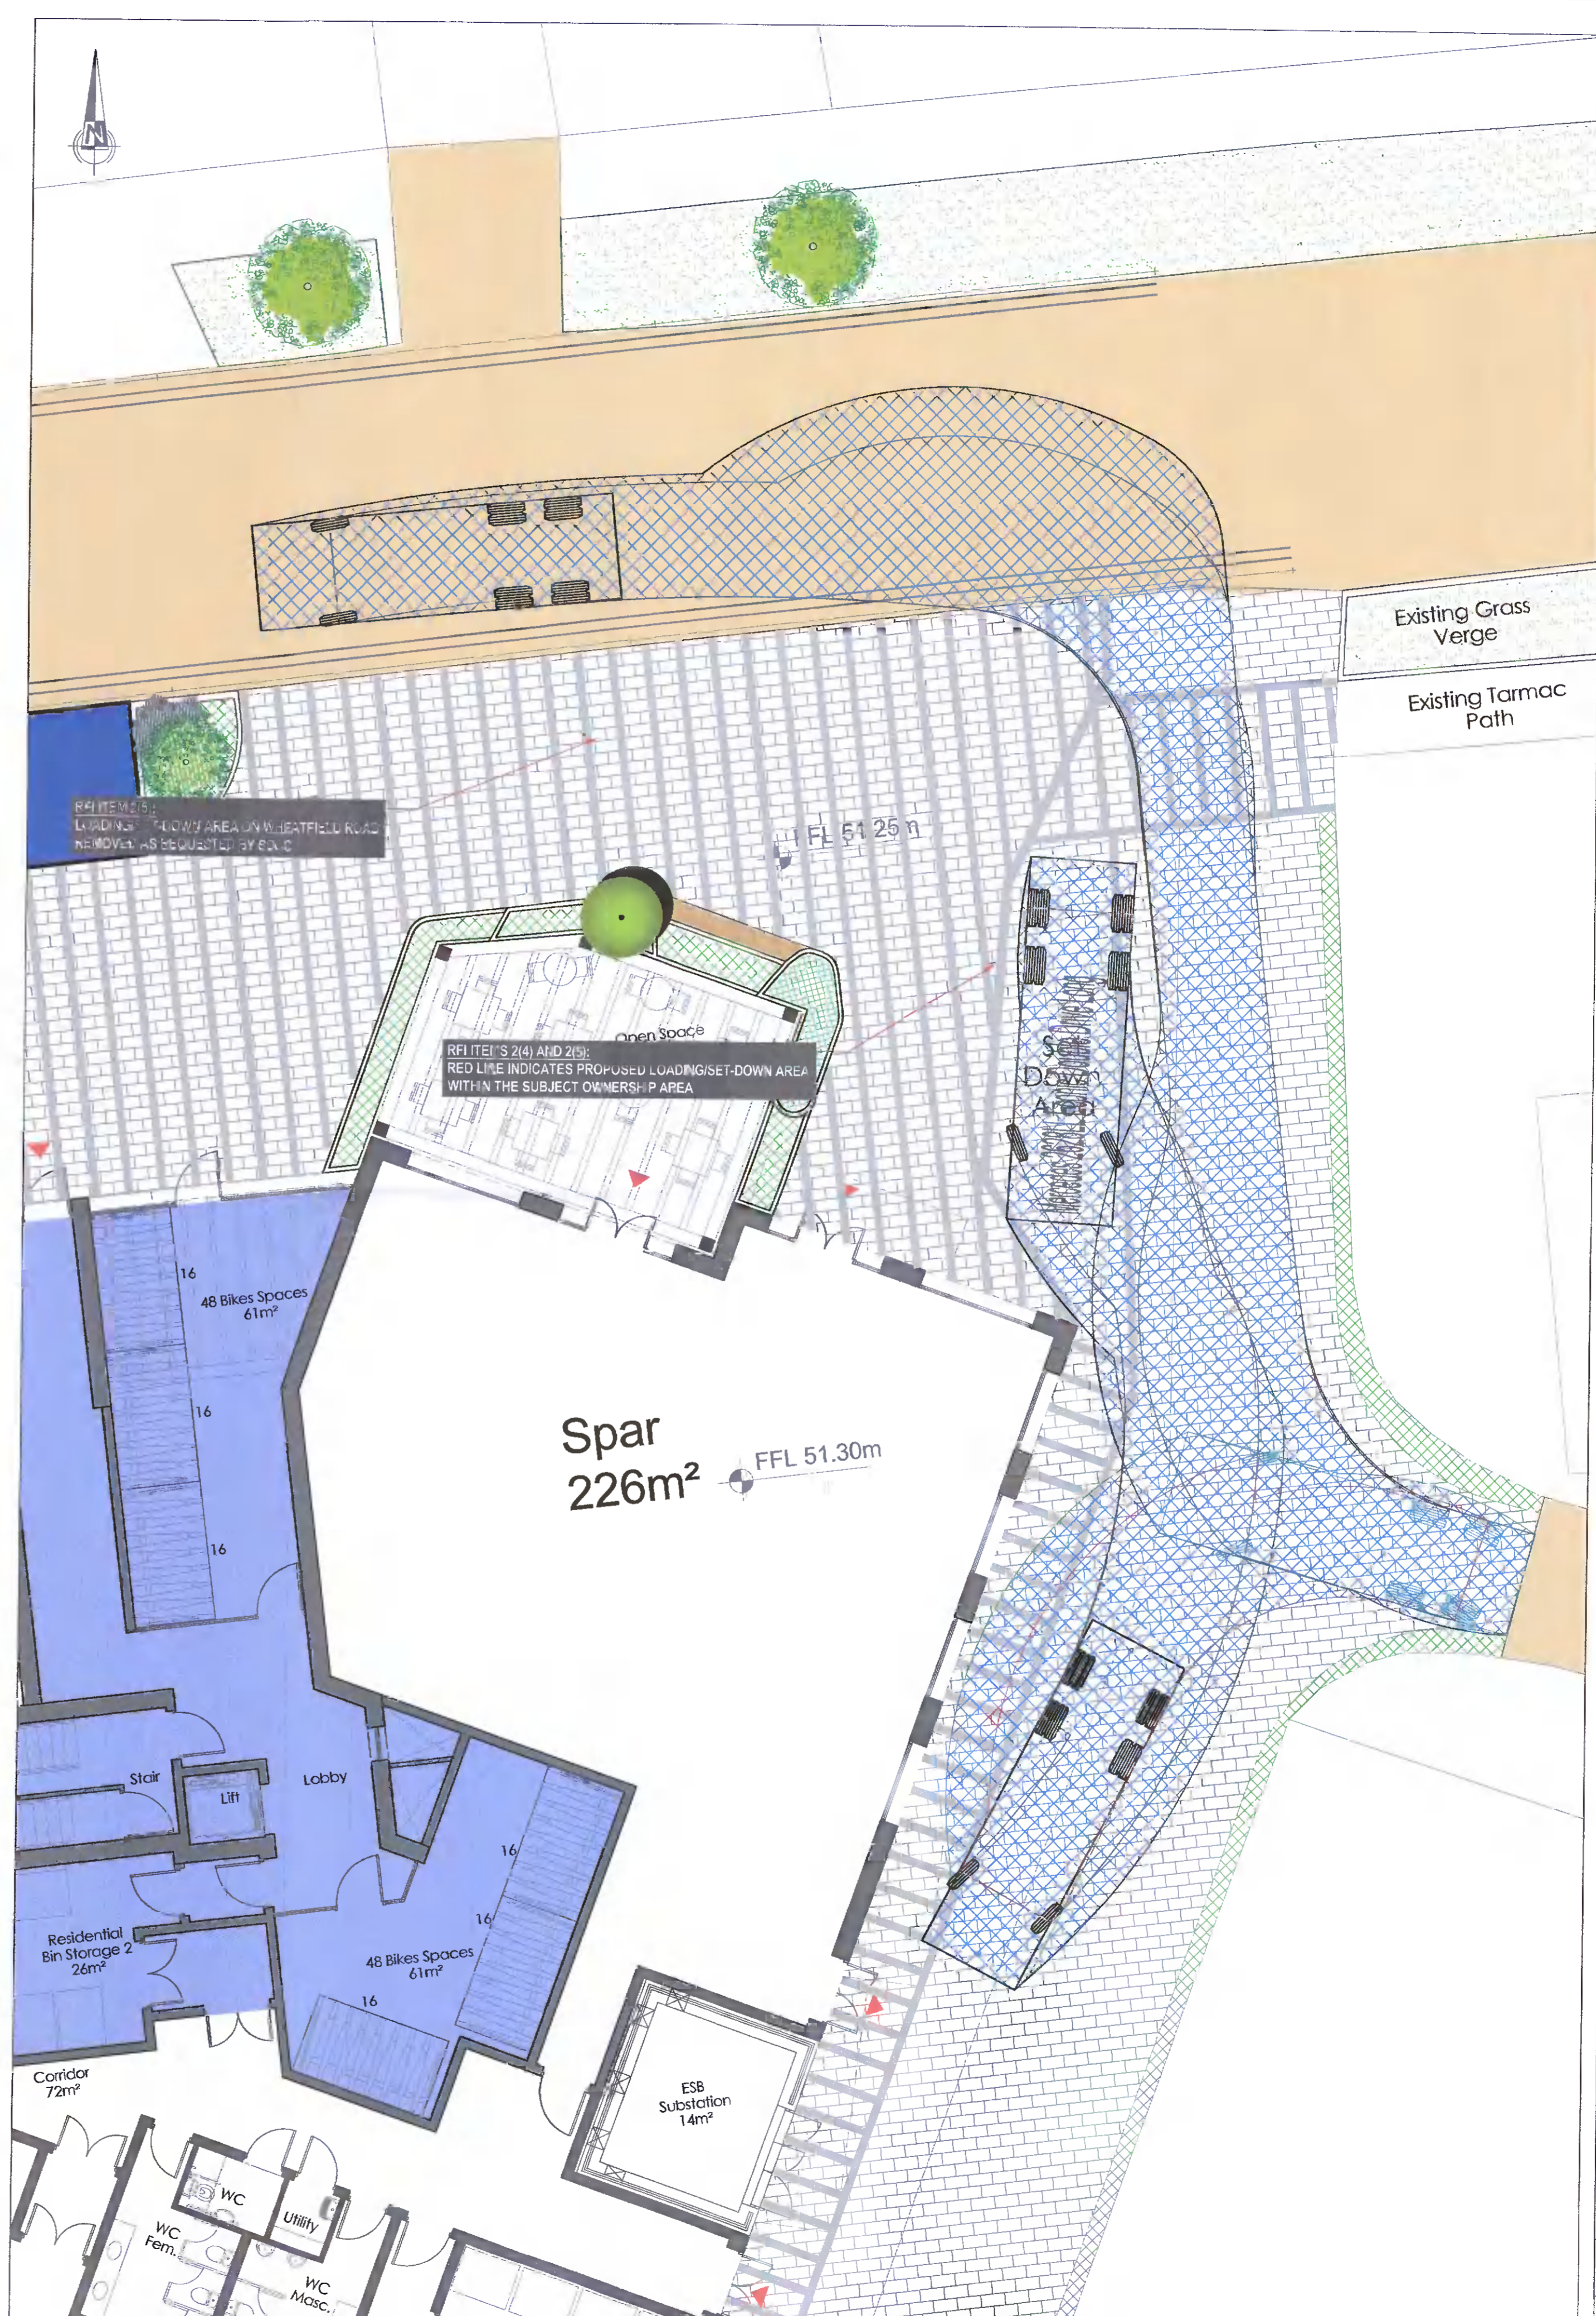

AUTOTRACK OF A LARGE REFUSE VEHICLE EXITING THE LOADING/SET-DOWN AREA

REV	DATE	AMENDMENTS	DRAWN	CHK	APP
NRB Consulting Engineers Ltd 1st Floor, Apollo Building Dundrum Road Dundrum Dublin 14					
Phone/Fax: +353 1 292 1941 Email: info@nrbe.ie Web: www.nrbe.ie Registered in Ireland No. 491679					
Client					
Project: Silver Granite RFI					
Title: Autotracks of a Large Refuse Vehicle at the Proposed Development					
Project No. 21-022		Drawing No. NRB-RFI-002			
Drawn: PB	Checked: SN	Approved: SN	Date: 12/04/22		
Date: 13-Apr-22		Scale @ A1: 1:100		Rev: A	
Purpose of Issue: <input type="checkbox"/> Draft <input type="checkbox"/> Information <input type="checkbox"/> Approval <input type="checkbox"/> As Built <input type="checkbox"/> Tender <input type="checkbox"/> Construction					
<small>NRB Consulting Engineers Ltd accept no responsibility for any unauthorised amendments to this drawing. Only figured dimensions to be worked to.</small>					