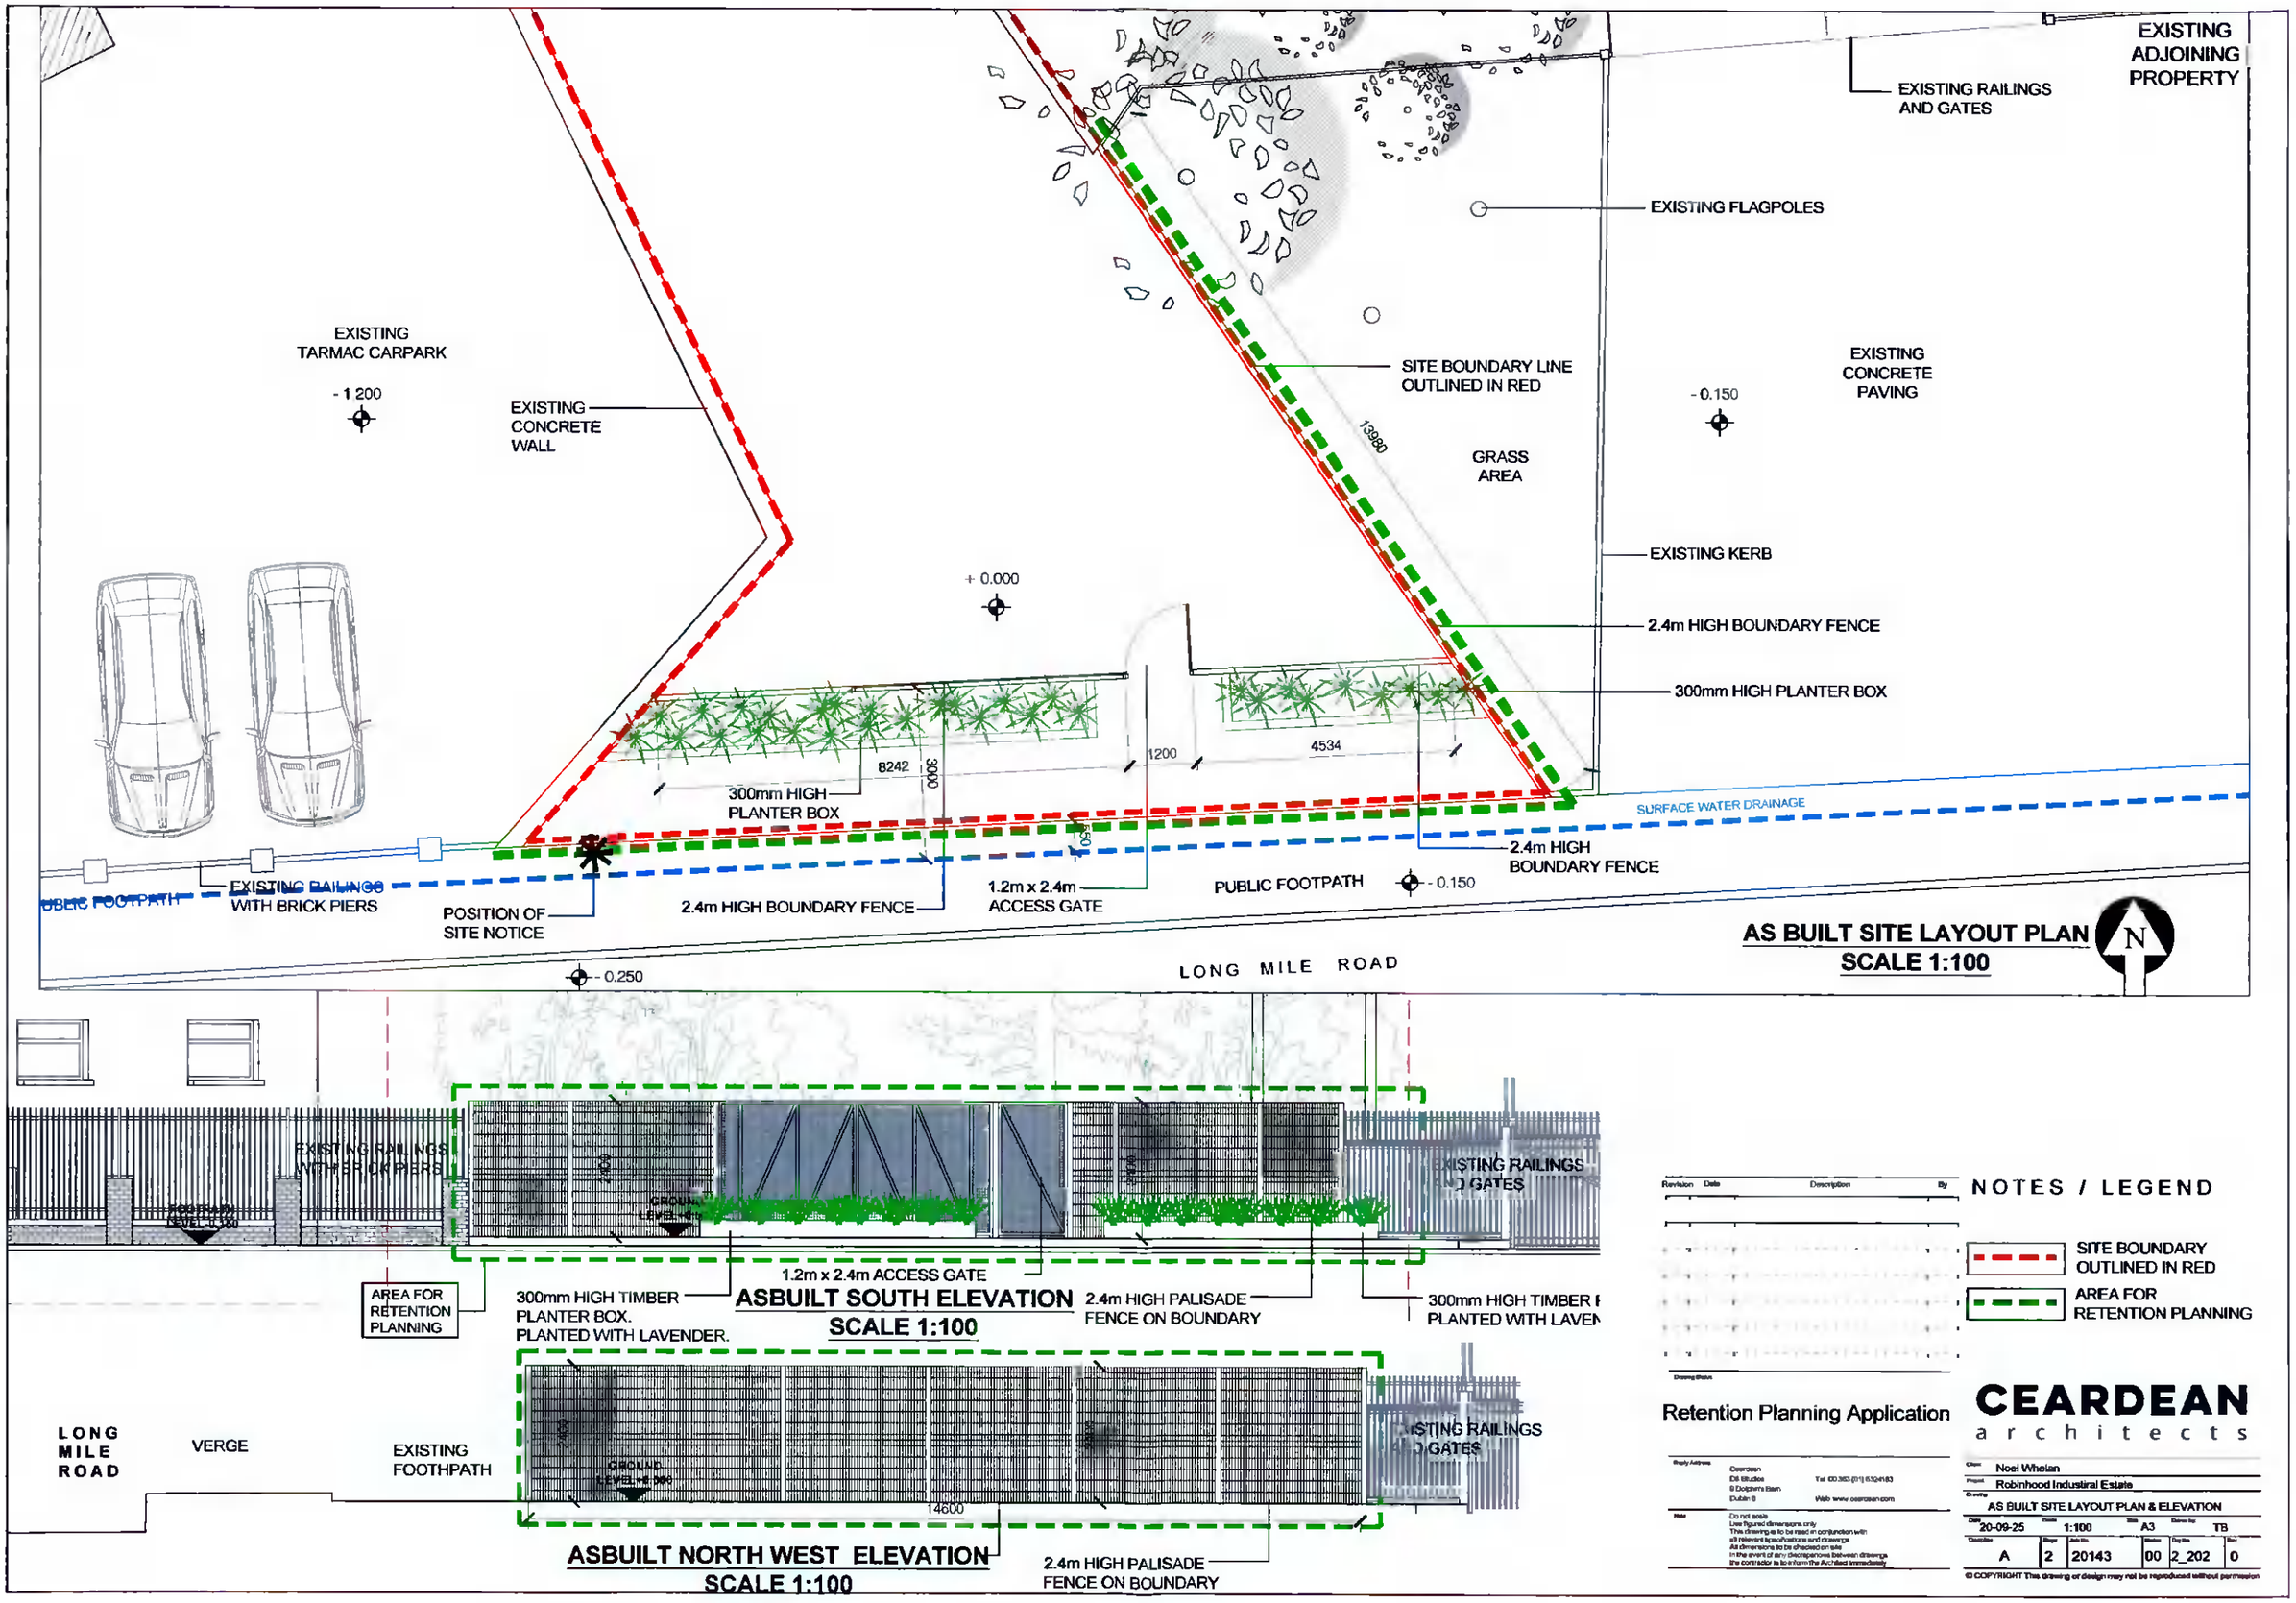
EXISTING ADJOINING PROPERTY
EXISTING RAILINGS AND GATES
EXISTING FLAGPOLES
EXISTING TARMAC CARPARK
- 1 200
EXISTING CONCRETE WALL
SITE BOUNDARY LINE OUTLINED IN RED
EXISTING CONCRETE PAVING
- 0.150
13980
GRASS AREA
EXISTING KERB
+ 0.000
2.4m HIGH BOUNDARY FENCE
300mm HIGH PLANTER BOX
8242
3000
1200
4534
300mm HIGH PLANTER BOX
SURFACE WATER DRAINAGE
2.4m HIGH BOUNDARY FENCE
EXISTING RAILINGS WITH BRICK PIERS
POSITION OF SITE NOTICE
2.4m HIGH BOUNDARY FENCE
1.2m x 2.4m ACCESS GATE
PUBLIC FOOTPATH
- 0.150
- 0.250
LONG MILE ROAD
AS BUILT SITE LAYOUT PLAN
SCALE 1:100
N
EXISTING RAILINGS WITH BRICK PIERS
EXISTING RAILINGS AND GATES
AREA FOR RETENTION PLANNING
300mm HIGH TIMBER PLANTER BOX. PLANTED WITH LAVENDER.
1.2m x 2.4m ACCESS GATE
ASBUILT SOUTH ELEVATION
SCALE 1:100
2.4m HIGH PALISADE FENCE ON BOUNDARY
300mm HIGH TIMBER PLANTED WITH LAVEN
LONG MILE ROAD
VERGE
EXISTING FOOTHPATH
14600
EXISTING RAILINGS AND GATES
ASBUILT NORTH WEST ELEVATION
SCALE 1:100
2.4m HIGH PALISADE FENCE ON BOUNDARY
NOTES / LEGEND
SITE BOUNDARY OUTLINED IN RED
AREA FOR RETENTION PLANNING
Retention Planning Application
CEARDEAN architects
Noel Whelan
Robinhood Industiral Estate
AS BUILT SITE LAYOUT PLAN & ELEVATION
20-09-25
1:100
A3
TB
A
2
20143
00
2_202
0
© COPYRIGHT This drawing or design may not be reproduced without permission