RED LINE INDICATES EXTENT OF PREVIOUS PROPOSED HOUSE DESIGN.

RED LINE INDICATES EXTENT OF PREVIOUS PROPOSED HOUSE DESIGN

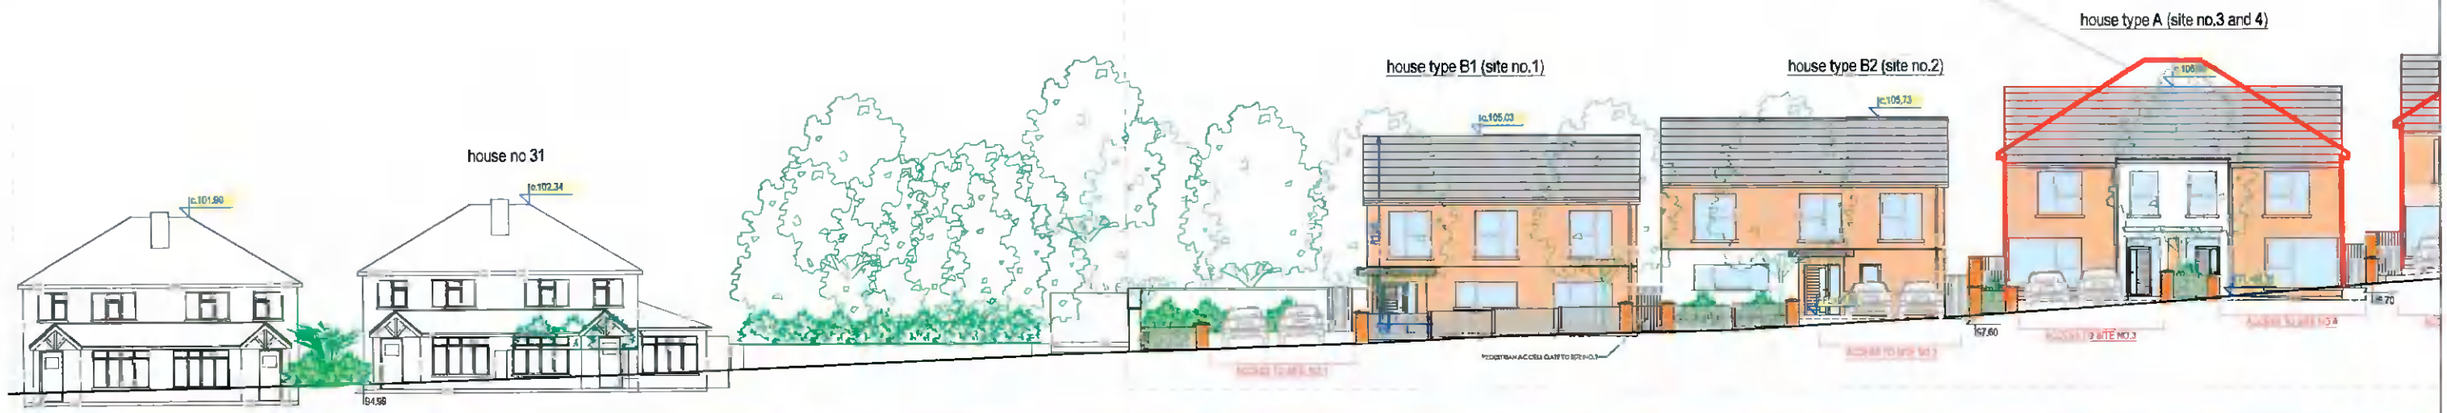

TYPICAL CONTIGUOUS ELEVATION - VIEW FROM THE PUBLIC ROAD (GRANGEBROOK AVENUE) SCALE 1:250

TYPICAL CONTIGUOUS ELEVATION - VIEW FROM THE PUBLIC ROAD (GRANGEBROOK AVENUE) SCALE 1:500

FOR FURTHER INFORMATION PURPOSES ONLY

Decision no 1379 Reg ref. SD21A/0246

ISSUE DATE 06.05.2022

TERRY & O'FLANAGAN LTD.
REGISTERED ARCHITECTS

CONTIGUOUS STREET ELEVATION - APPROVED AND PROPOSED COMPARISON

BECKETT DEVELOPMENTS LTD

PROPOSED 6 HOUSES AT THE PART OF THE GROUNDS OF "PALMYRA" WHITECHURCH ROAD (GRANGEBROOK AVENUE), RATHFARNHAM DUBLIN 16

MAY 2022		1:250 (A3)
D1194 - 2 - 18 a		KP