

...NING CIRCLE
 ...FIC CONSULTANT'S
 ...ORE INFORMATION
 RED LINE INCREASED TO INCLUDE HEDGEROW FOR MITIGATION PURPOSES
 RED LINE INCREASED TO INCLUDE HEDGEROW FOR MITIGATION PURPOSES


INDICATIVE APARTMENT BUILDING CAR PARK ENTRANCE

BUS LAY-BYS
 REFER TO TRAFFIC CONSULTANT'S DRAWINGS FOR MORE INFORMATION


BUS LAY-BYS
 REFER TO TRAFFIC CONSULTANT'S DRAWINGS FOR MORE INFORMATION

read in conjunction with Landscape Architects
 details & Traffic Consultant information
 to apartment schedule for apartment parking provision within outline permission

DESCRIPTION	BY
...	...

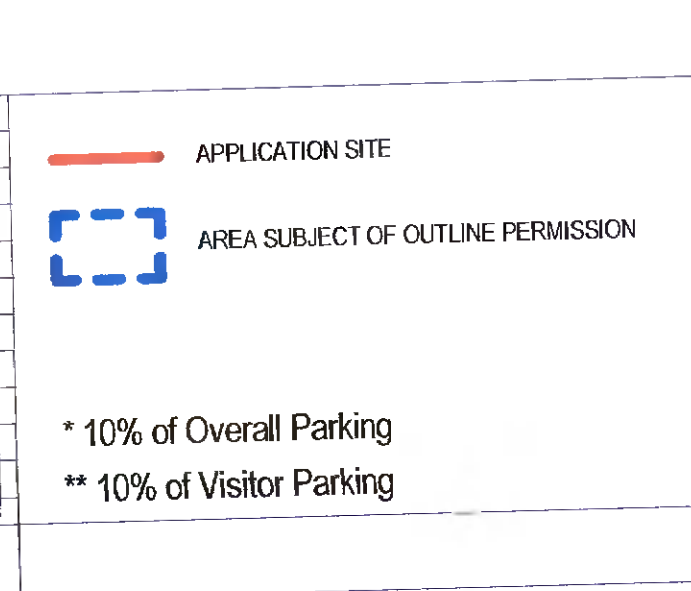

Off-Curtilage Parking		On-Curtilage Parking	
Off-Curtilage	180	On-Curtilage	206
Visitor	47*		
Accessible	5**		
E EV Charging	5**		
Off-Curtilage Parking: 227		On-Curtilage Parking: 206	
52.4%		47.6%	
Grand total: 433			

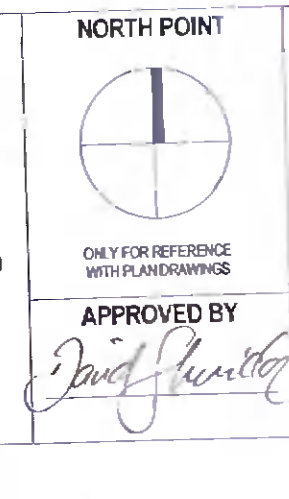

PLANNING
 Client: Adamstown Station & Boulevard Ltd.
 Project: ADAMSTOWN BOULEVARD - PHASE 1
 Title: PROPOSED SITE LAYOUT PLAN - PARKING
 Sheet No: 1238-MDO-ZZ-XX-DR-A-05006
 Scale as: As indicated @ A0 Current Rev: 1 Project No: 1238

MC CAULEY DAYE O'CONNELL ARCHITECTS
 11 Merrion Square, Dublin 2, Ireland
 Telephone: +353 (0)1 400 41
 info@mcd.ie | www.mcd.ie