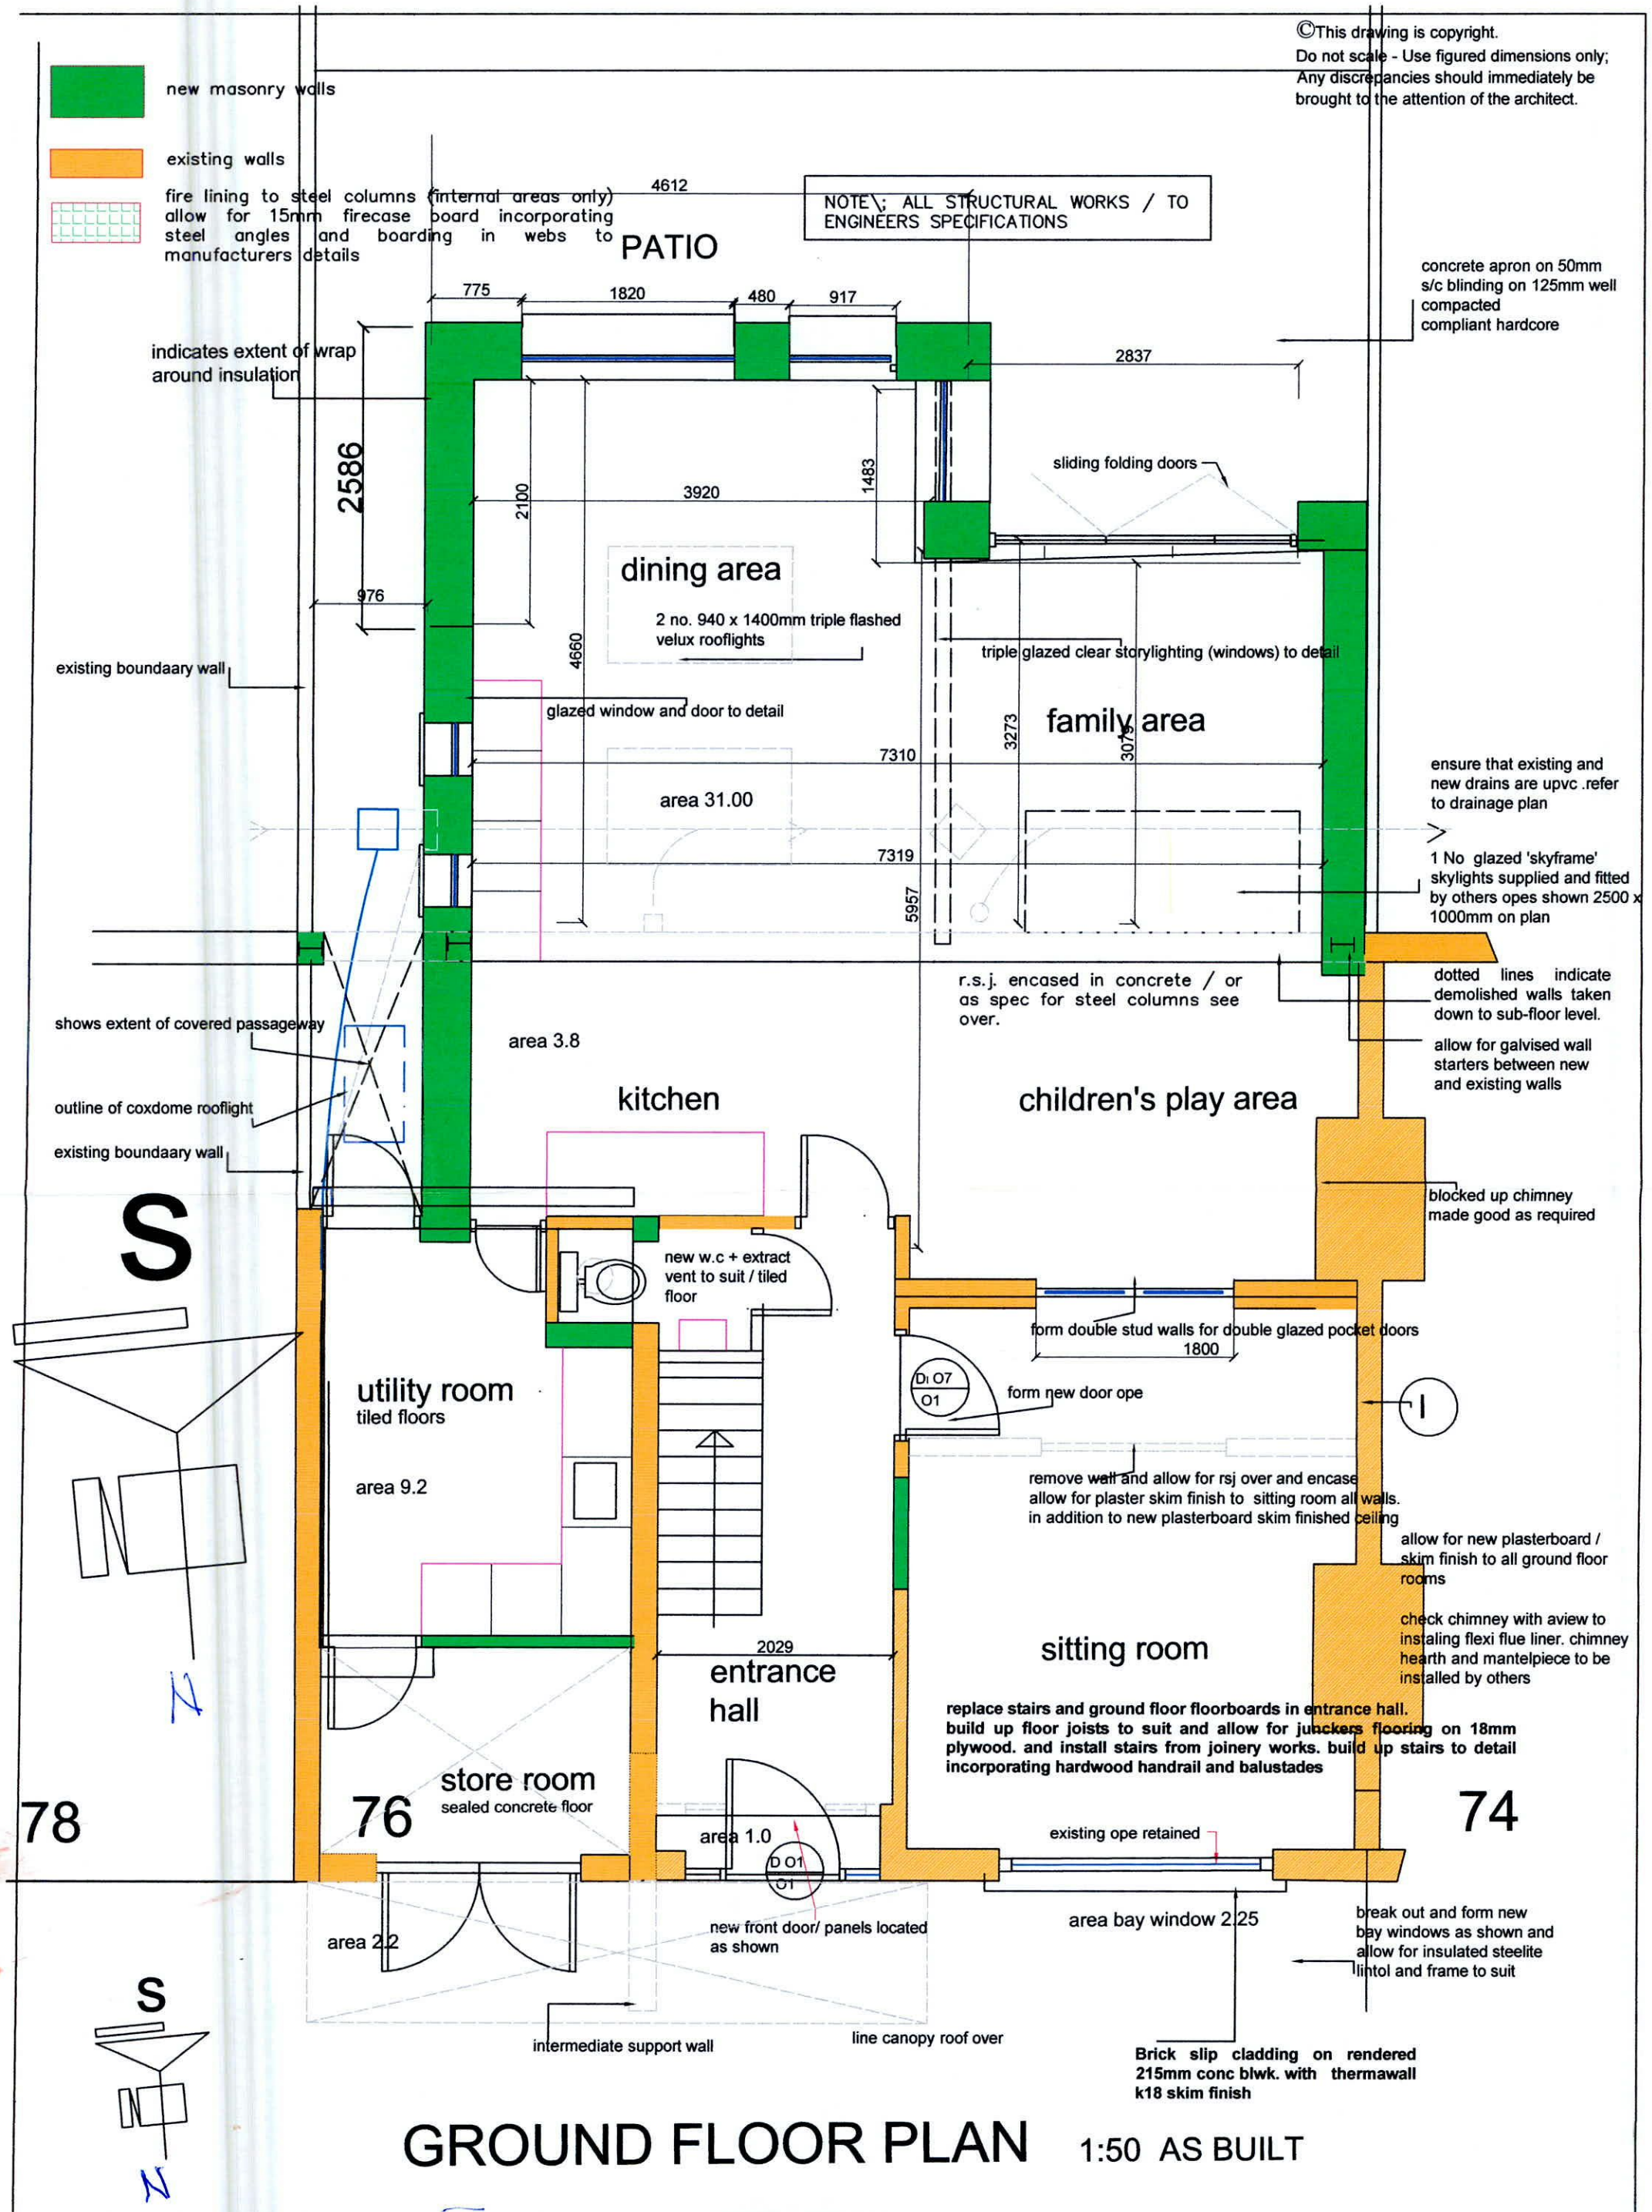

GROUND FLOOR PLAN 1:50 AS BUILT

DO NOT SCALE - USE FIGURED DIMENSIONS ONLY

REV.	DATE	DRAWN	DESCRIPTION

CORMAC MURPHY & ASSOCIATES | ARCHITECTS

PROJECT: 76 DODDER PARK ROAD RATHFARNHAM CO. DUBLIN	SCALE: 1:50	STATUS: PLANNING APPLICATION	
	DATE: JULY 2022	DRAWN: A.F. / CHECKED: C.M.	PASSED:
DRAWING: GROUND FLOOR PLAN As Built	JOB NO: CM.22.02	DRAWING NO: 05	REVISION:

cormac murphy + associates architects
ARCHITECTS - M.R.I.A.I T.01-8335734 M.0872847418
seaview studio, 162 hampton cove, skerries rd, balbriggan, co.dublin cormacmurphy8@gmail.com