©This drawing is copyright.
Do not scale - Use figured dimensions only;
Any discrepancies should immediately be brought to the attention of the architect.

contiguous elevation to the north 1: 100 ORIGINAL APPLICATION

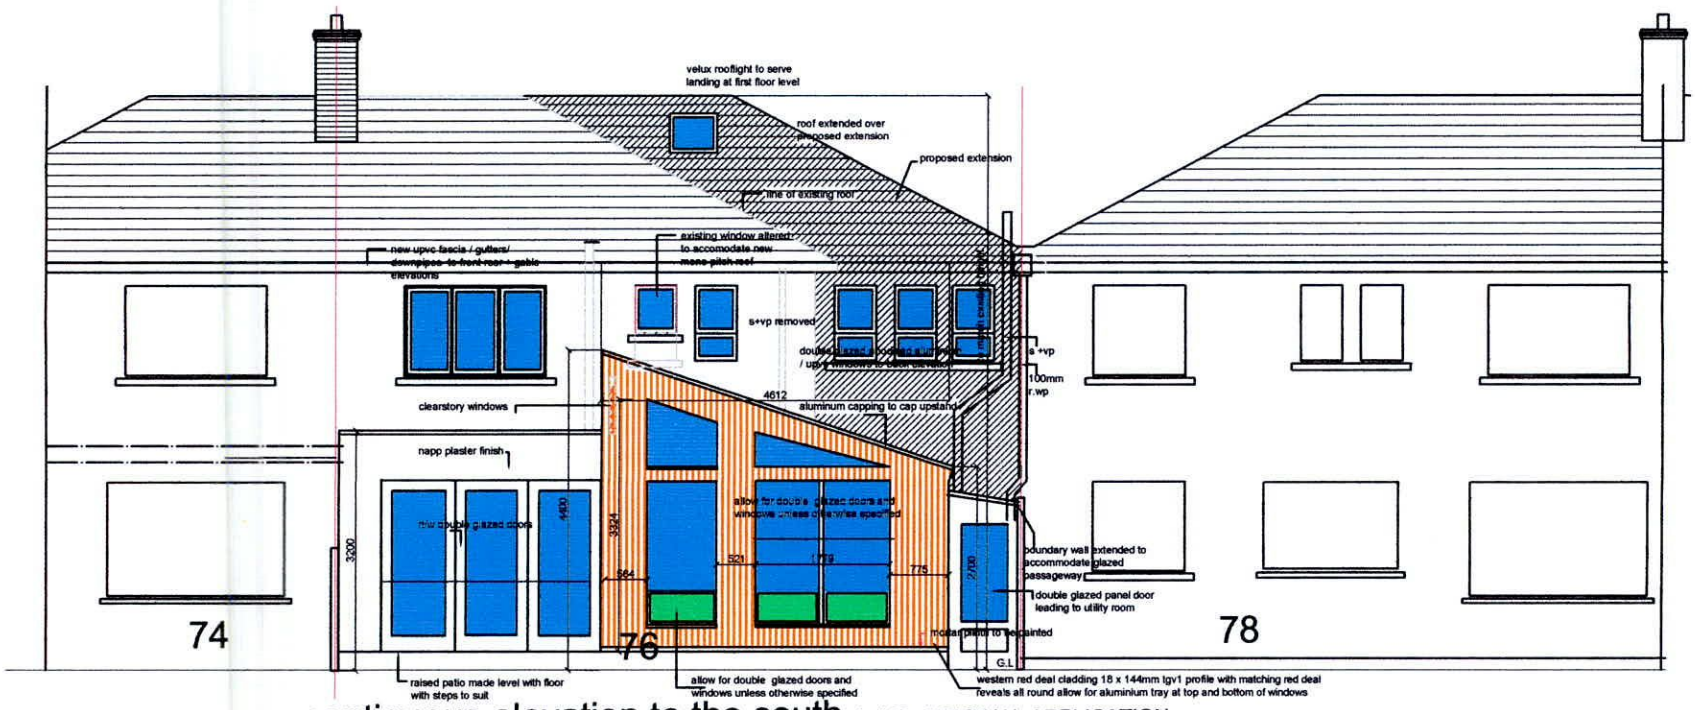

contiguous elevation to the south 1: 100 ORIGINAL APPLICATION

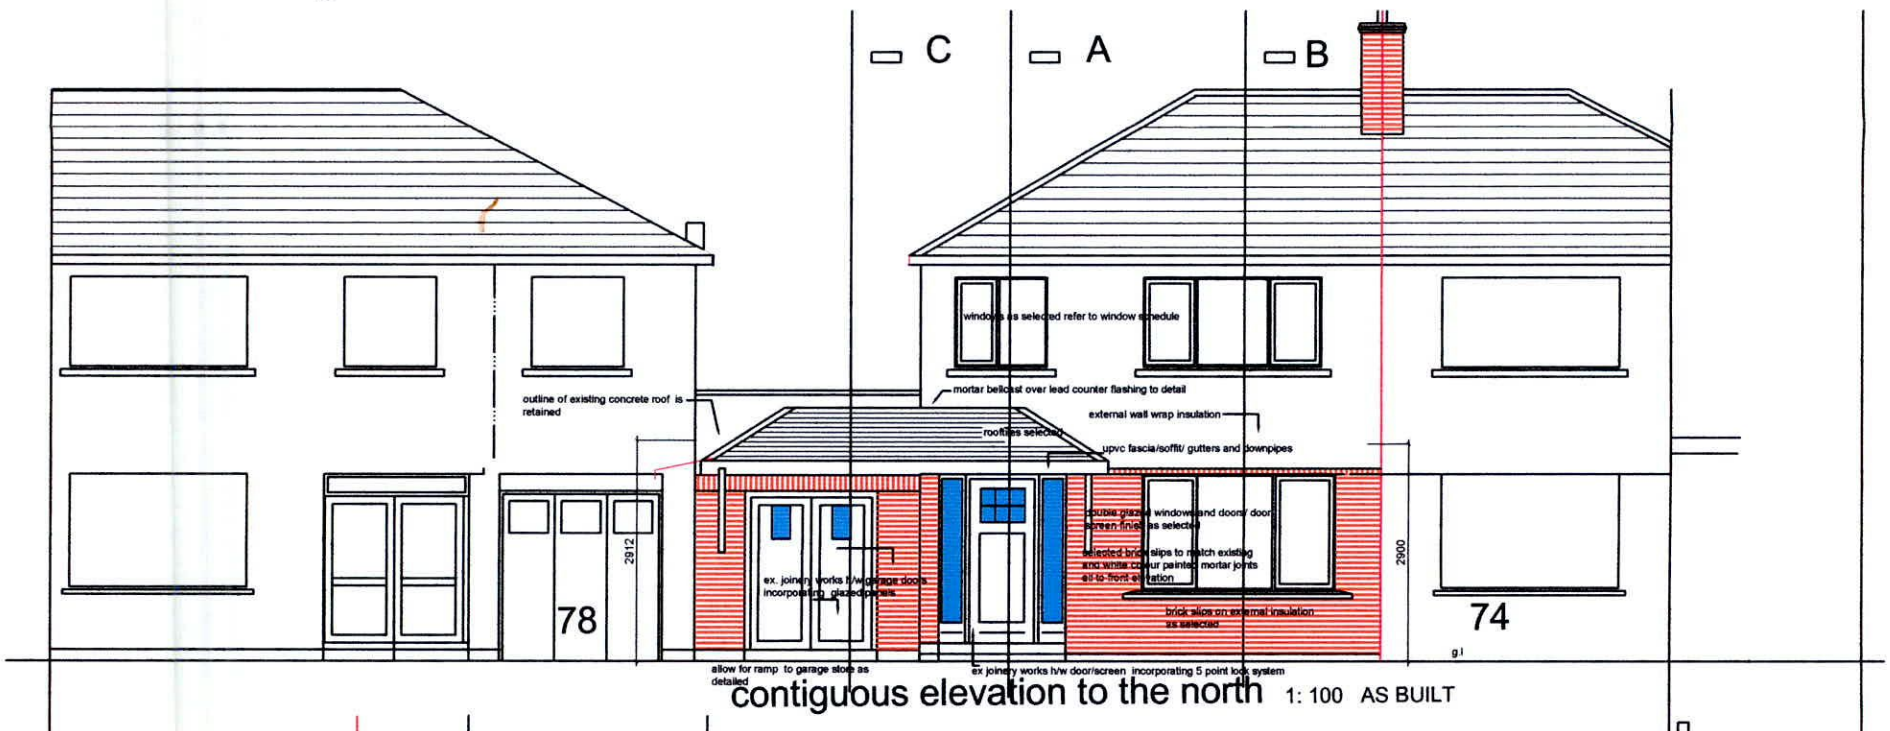

contiguous elevation to the north 1: 100 AS BUILT

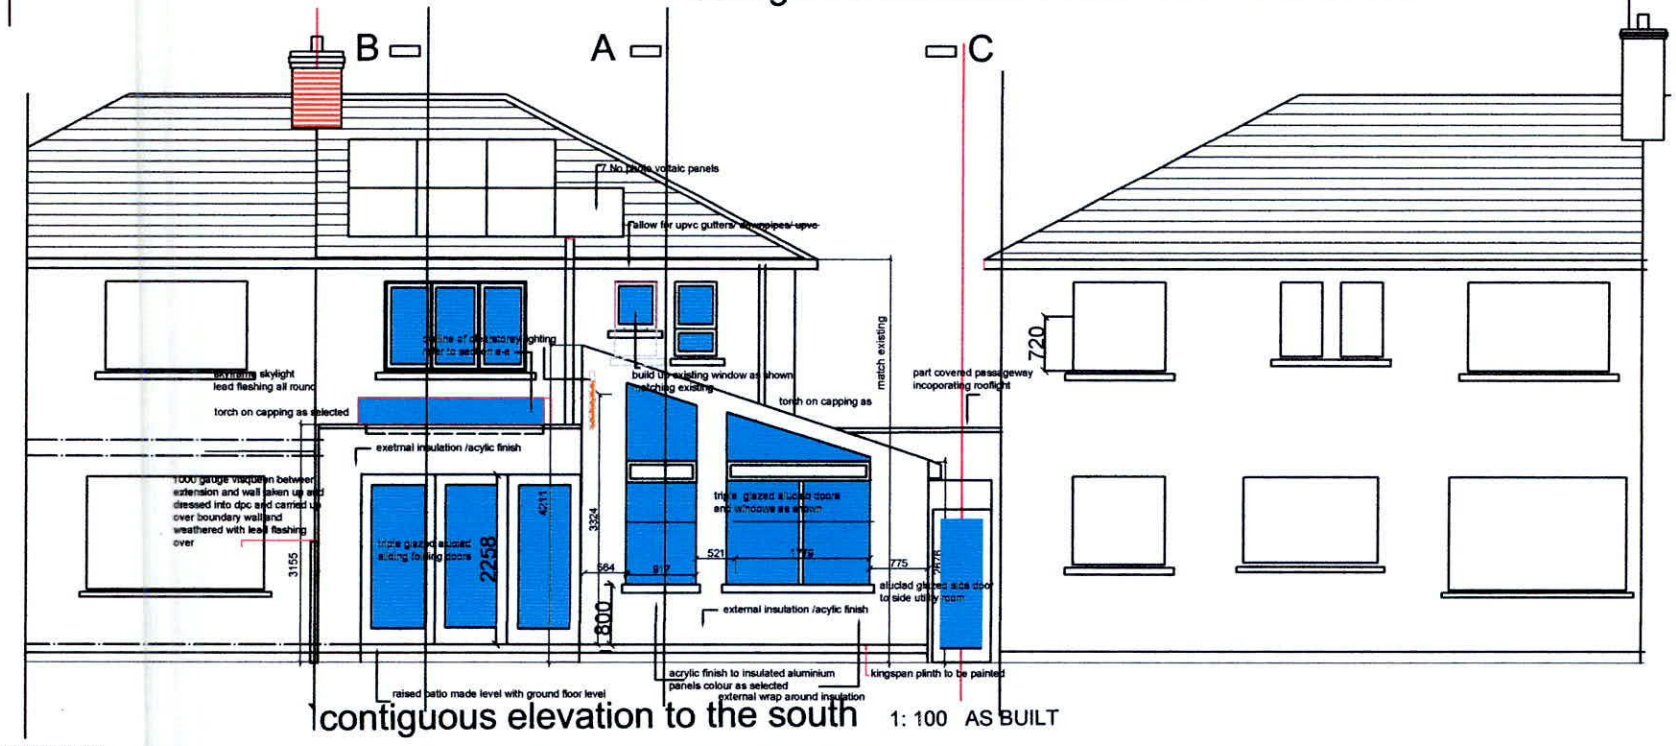

contiguous elevation to the south 1: 100 AS BUILT

DO NOT SCALE - USE FIGURED DIMENSIONS ONLY

REV.	DATE	DRAWN	DESCRIPTION

CORMAC MURPHY & ASSOCIATES | ARCHITECTS

PROJECT: 76 DODDER PARK ROAD RATHFARNHAM CO. DUBLIN		SCALE: 1:100	STATUS: PLANNING APPLICATION
		DATE: JULY 2022	DRAWN: A.F. CHECKED: C.M. PASSED:
DRAWING: CONTIGUOUS ELEVATIONS Original Application + As Built		JOB NO: CM.22.02	DRAWING NO: 08 REVISION:
cormac murphy + associates architects ARCHITECTS - M.R.I.A.I T.01-8335734 M.0872847418		seaview studio, 162 hampton cove, skerries rd, balbriggan, co.dublin cormacmurphy8@gmail.com	