




1 ZONE 2 CONTEXTUAL ELEVATION - LINEAR PARK (RFI)
Scale: 1:200

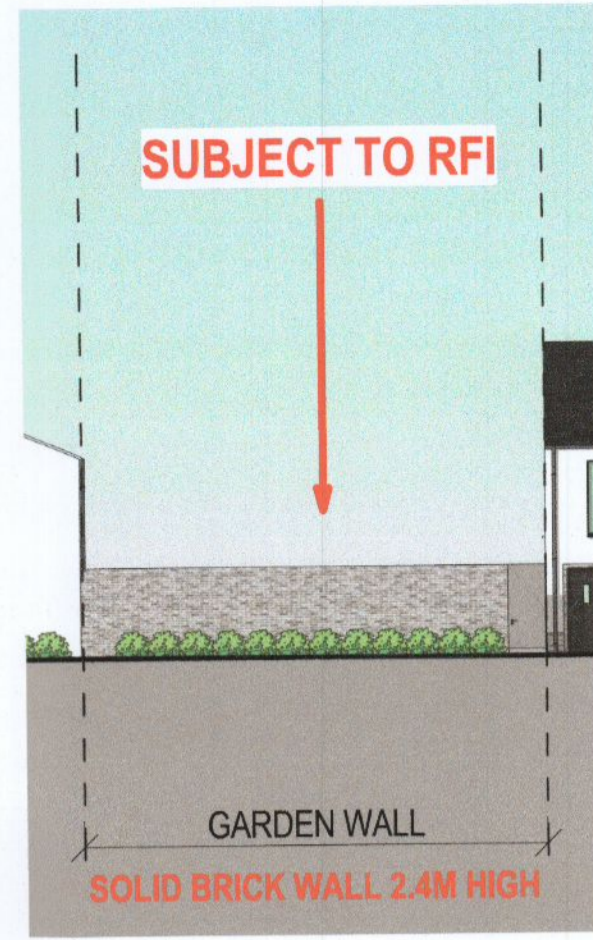


2 ZONE 2 CONTEXTUAL ELEVATION - NORTH-SOUTH AVENUE 01 (RFI)
Scale: 1:200

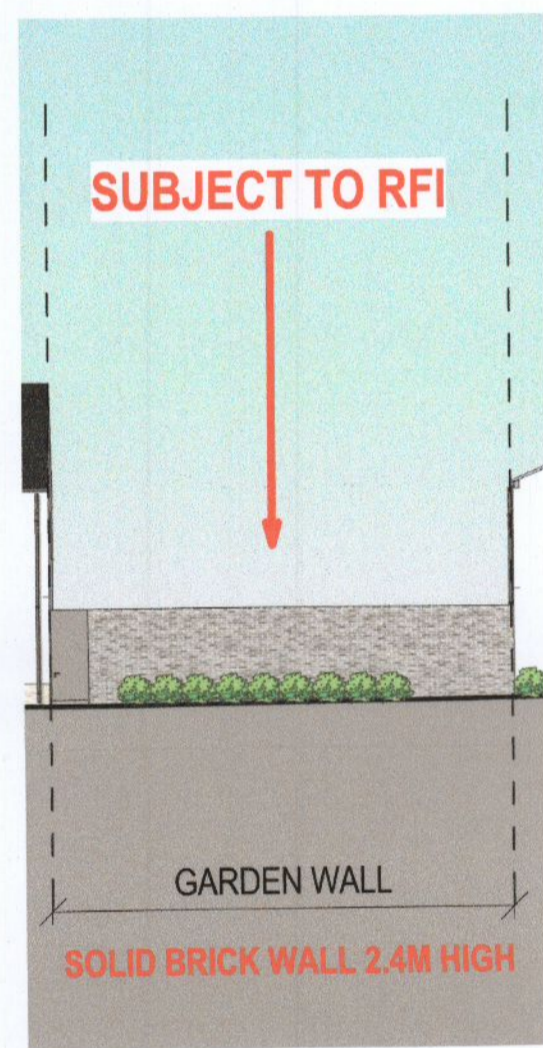

3 ZONE 2 CONTEXTUAL ELEVATION - NORTH-SOUTH AVENUE 03 (RFI)
Scale: 1:200

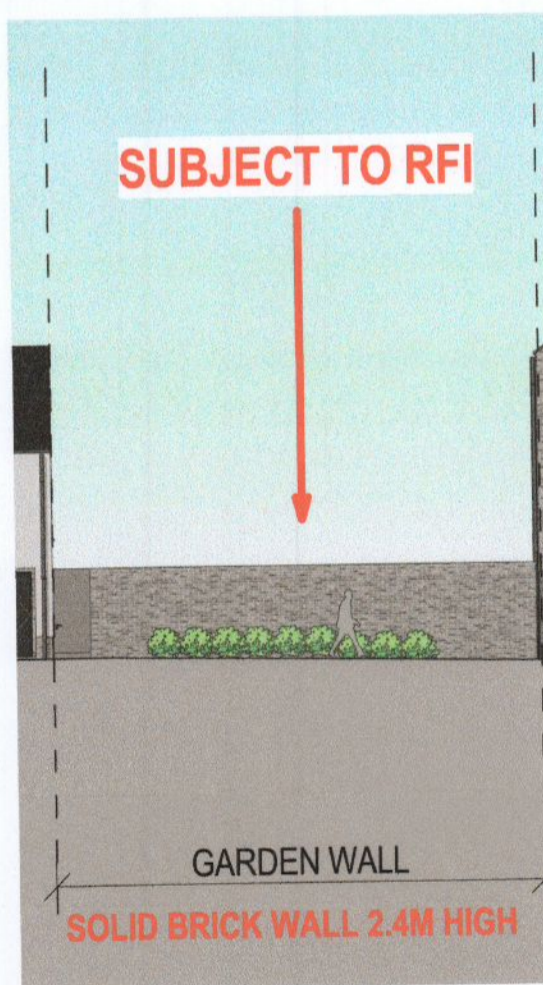

4 ZONE 2 CONTEXTUAL ELEVATION - STATION ROAD (RFI)
Scale: 1:200

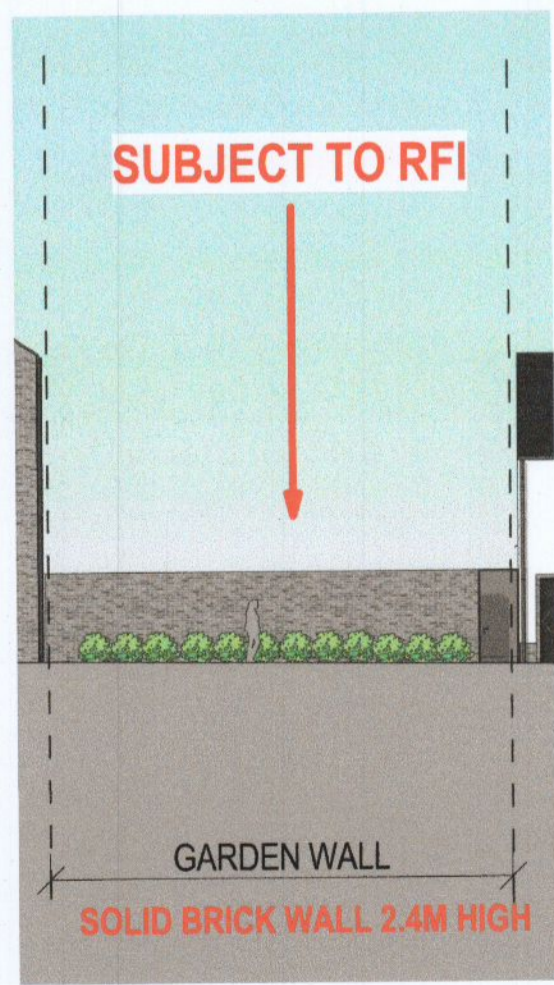

5 ZONE 2 CONTEXTUAL ELEVATION - STATION ROAD (RFI) - 2
Scale: 1:200



RESPONSE TO REQUEST FOR FURTHER INFORMATION

REV	DATE	DESCRIPTION	BY
1	02/09/2022	Issued for RFI	GC

— RED LINE (SITE AREA 9.97HA)

LEGEND
■ UNIT AFFECTED BY ACOUSTIC IMPACT
■ 2.4M BRICK WALL

NORTH POINT

ONLY FOR REFERENCE WITH PLAN DRAWINGS
APPROVED BY
Jarvis
26/08/2022 11:46:21

Client: Adamstown Station & Boulevard Ltd.
 Preced: ADAMSTOWN BOULEVARD - PHASE 1
 Title: CONTEXTUAL ELEVATIONS - ACOUSTIC TREATMENT
 Sheet No.: **1238-MDO-ZZ-XX-DR-A-08001**
 Scale: As Indicated @ A1 Current Rev.: 1 Project No.: 1238

MC CAULEY DAYE O'CONNELL
 ARCHITECTS
 11 Merrion Square, Dublin 2, Ireland
 Telephone: +353 (0)1 400 4171
 info@mco.ie | www.mco.ie