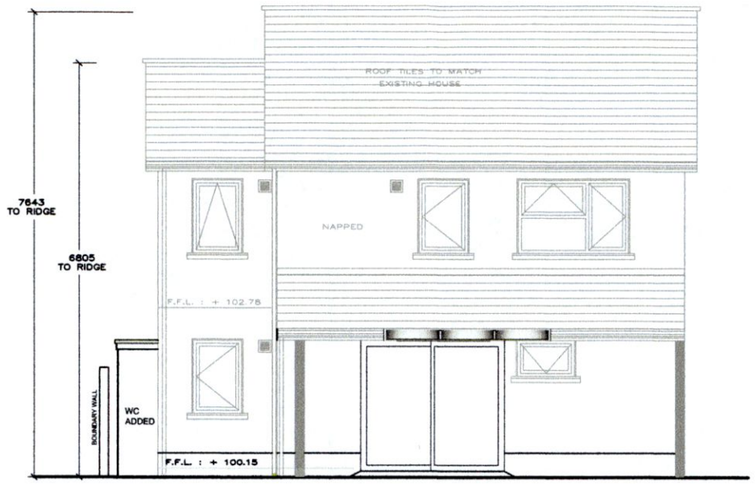

REVISED FRONT ELEVATION
GLAZED PORCH ADDED
(Class 7 Exempted Development)

REVISED REAR ELEVATION

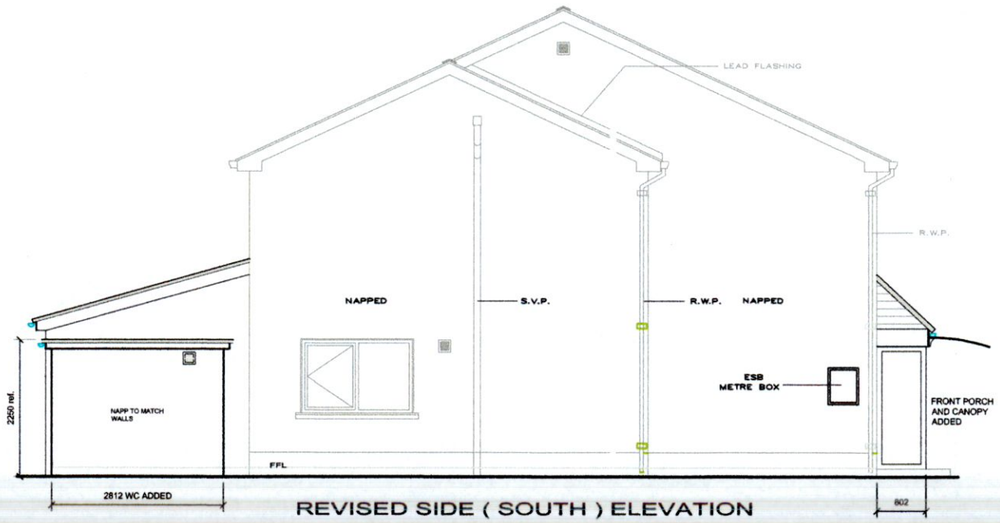

REVISED SIDE (SOUTH) ELEVATION

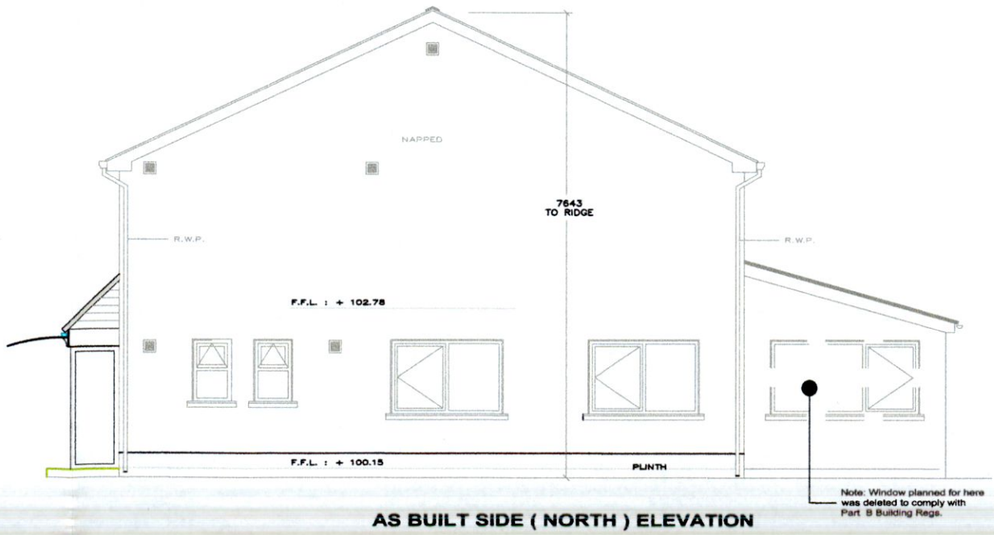

AS BUILT SIDE (NORTH) ELEVATION

No.	DESCRIPTION
	REVISIONS

EDA architecture

EASTON DESIGN ASSOCIATES

© COPYRIGHT
11 PRIORS POINT,
CARRICK on SHANNON,
CO. LEITRIM

TEL: 086 2525834
E - MAIL:
eastonarchitecture@gmail.com

Client
JOHN & URSULA KELLY

Project Name
36A HILLCREST GROVE,
LUCAN,
CO DUBLIN
K78 YY49

Title
ELEVATIONS

PREPARED BY :
BILL FLANAGAN

SCALE : 1:50 | SHEET :
DATE : 14/10/22

DWG NO:
PA104/0

THIS DRAWING IS SOLELY FOR USE WITHIN THIS PROPOSED DEVELOPMENT AND MAY NOT BE USED OTHERWISE WITHOUT THE DESIGNERS CONSENT .

NOT FOR CONSTRUCTION. PREPARED FOR PLANNING APPLICATION PURPOSES ONLY.

© COPYRIGHT