RFI ITEM 7:

Vehicular Access

Please refer to the following:

- ***2350_SJK_RFI_S2B_S_704** - Existing and Proposed Vehicular Entrances - Plan View*
- ***2350_SJK_RFI_S2B_S_705** - Existing and Proposed Vehicular Entrances - Elevations*
- ***Traffic and Transport Assessment Report** for visibility splay details*

RFI ITEM 6(b)(d):

Location of the proposed cycle parking area shown in dashed line, which accommodates 08 pre-fabricated cycle storage shelters; 107 cycle parking spaces in total.

Please refer to the following:

- ***2350_SJK_RFI_S2B_S_703** - Proposed Cycle Parking Area - Plans, Sections and Elevations*
- ***2350_SJK_RFI_S2B_RP_01** - Project Statistics - Car and Cycle Parking*

RFI ITEM 6(c):

Pedestrian connectivity

Please refer to the following:

- ***2350_SJK_RFI_S2B_S_008** - Site Plan - Connectivity Diagram*

RFI ITEM 6(a):

Footpaths min. 1.8m wide

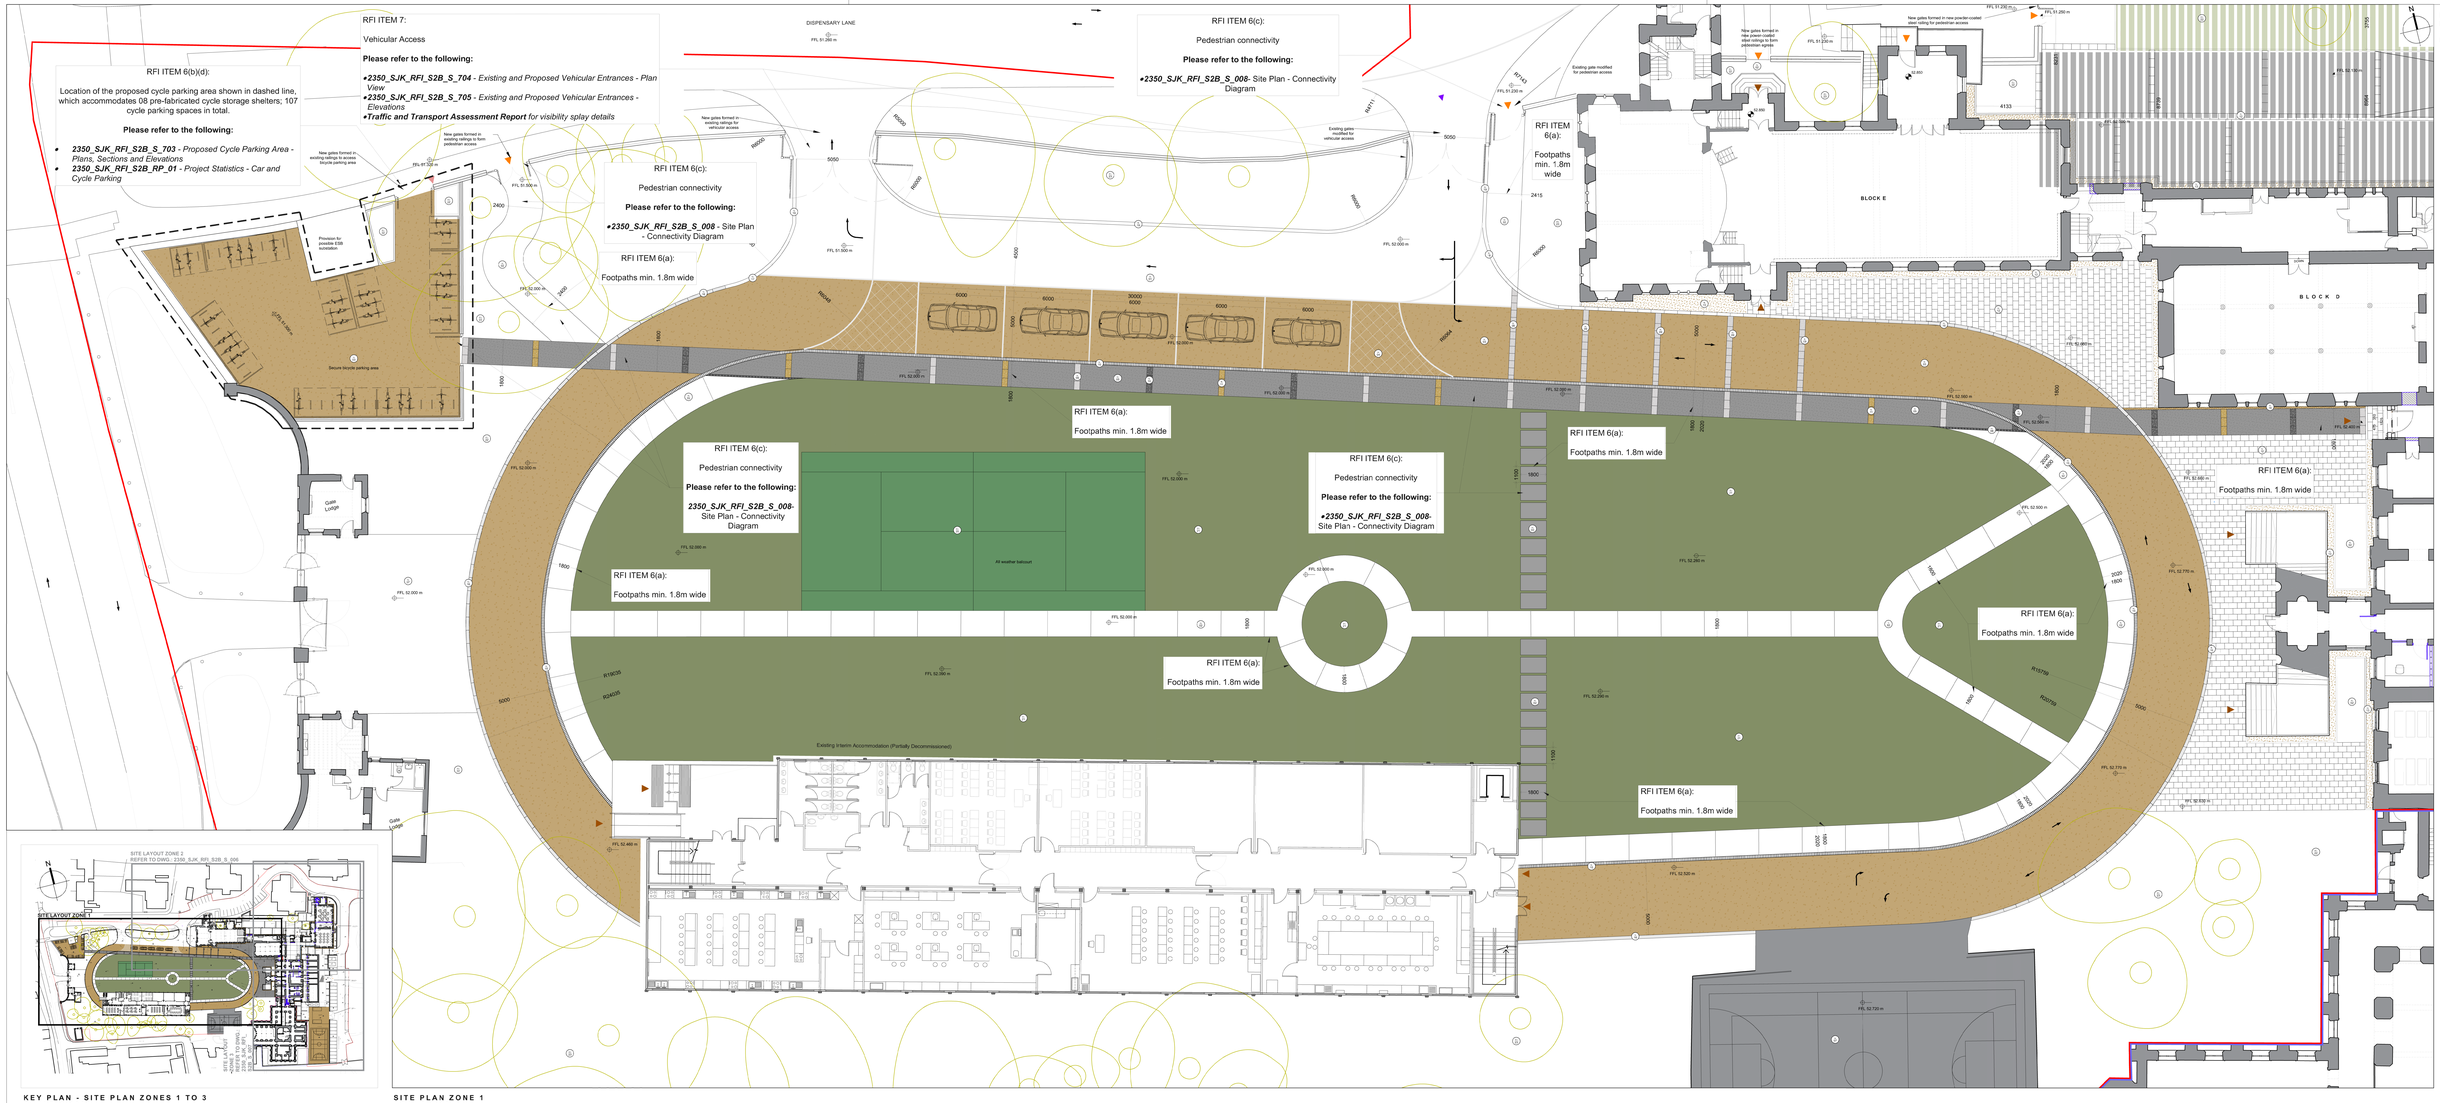

KEY PLAN - SITE PLAN ZONES 1 TO 3
SCALE 1:1000

SITE PLAN ZONE 1
SCALE 1:100

LEGEND- SURFACE FINISHES

HARD LANDSCAPE (HL)

1. COLOURED ASPHALT; COLOUR BLACK | SIZE N/A | PERMEABLE (or similar | to later detail and specifications)
2. IN-SITE BRUSHED CONCRETE; COLOUR; NATURAL GREY | SIZE N/A | NON-PERMEABLE (or similar | to later detail and specifications)
3. COLOURED ASPHALT; COLOUR; BEIGE | SIZE N/A | PERMEABLE (or similar | to later detail and specifications)
4. ROAD MARKING PAINT; COLOUR; WHITE | SIZE; N/A (or similar | to later detail and specifications)
5. COLOURED ASPHALT; COLOUR GREY | SIZE N/A | PERMEABLE (or similar | to later detail and specifications)
6. PERMEABLE PAVING BLOCKS; LEVEL FLUSHED | MANUFACTURER; AG (OR SIMILAR) | COLOUR AND FINISH; RECTANGULAR SLATE (OR SIMILAR) | SIZE; 589 X 295mm | PERMEABLE JOINTS
7. Existing Black Tarmac
8. Existing Concrete Paving
9. GRANITE FLAGSTONE; LEVEL FLUSHED | MANUFACTURER; AG (OR SIMILAR) | COLOUR; NATURAL | SIZE; 600 X 400mm GROUND (OR SIMILAR) | SIZE; 6 400mm | PERMEABLE JOINTS (or similar | to later detail and specifications)
10. GRANITE FLAGSTONE; LEVEL FLUSHED | MANUFACTURER; AG (OR SIMILAR) | COLOUR; TERRA PAVE | COLOUR; MILANO GROUND (OR SIMILAR) | SIZE 6 400mm | PERMEABLE JOINTS (or similar | to later detail and specifications)
11. GRANITE FLAGSTONE; LEVEL FLUSHED | MANUFACTURER; AG (OR SIMILAR) | COLOUR; NATURAL | SIZE; 600 X 400mm GROUND (OR SIMILAR) | SIZE; 6 400mm | PERMEABLE JOINTS (or similar | to later detail and specifications)
12. WICKLOW GRANITE STONE; LEVEL FLUSHED | COLOUR; NATURAL | SIZE; 600mm X 400mm | PERMEABLE JOINTS (or similar | to later detail and specifications)
13. WICKLOW GRANITE EDGING LEVEL FLUSHED | COLOUR; NATURAL | SIZE; 199 X 200mm | PERMEABLE JOINTS (or similar | to later detail and specifications)
14. WICKLOW GRAVEL PEBBLE; COLOUR; NATURAL | PEBBLE SIZE; 15-20mm | PERMEABLE (or similar | to later detail and specifications)
15. PERMEABLE PAVING BLOCKS; LEVEL FLUSHED | MANUFACTURER; AG | OR SIMILAR | COLOUR AND FINISH; RECTANGULAR GREY (OR SIMILAR) | SIZE; 199 X 200mm | PERMEABLE JOINTS (or similar | to later detail and specifications)
16. FLUSHED KERB; LEVEL FLUSHED | MANUFACTURER; ACO (OR SIMILAR) | COLOUR; NATURAL | KERB WIDTH; 125mm (or similar | to later detail and specifications)
17. RIGHT HAND DROPPER KERB; KERB WIDTH; 125mm | FINISH; SMOOTH | COLOUR; NATURAL GREY (or similar | to later detail and specifications)
18. LEFT HAND DROPPER KERB; KERB WIDTH; 125mm | FINISH; SMOOTH | COLOUR; NATURAL GREY (or similar | to later detail and specifications)
19. ROAD KERB; FULL; BATTER KERB | WIDTH; 125mm | FINISH; SMOOTH | COLOUR; NATURAL GREY (or similar | to later detail and specifications)

SOFT LANDSCAPE (Sf.L)

1. Artificial Grass (or similar) Colour Green | Size TBC | Permeable (to later detail and as per supplier's specifications)
2. Lawn Design purpose: to withstand foot traffic and seating (to later detail and specifications)
3. Reinstate Grass (to later detail and specifications)
4. Existing trees and landscape (to later detail and specifications)

GENERAL DRAWING LEGEND

- Planning Application Boundary Line shown in red
- Site Under Applicant's ownership shown in blue
- Existing Site Levels
- Proposed Site Levels
- Site Entrance - Bicycles
- Site Entrance(s) - Pedestrian
- Site Entrance(s) - Vehicles
- Building Main Entrance(s)
- Access to Cycle Storage Shelters
- Vehicular Route
- Cycle Shelters (CS) / Gates (GT) / Hard Landscape (HL) / Soft Landscape (SL) - (as per drawing)

Conditions of use of this drawing:

Note: If this AD size drawing is reproduced at a smaller size which makes these notes difficult to read, please contact the Architects office for a legible copy of these conditions.

1. The drawing the design and contents contained herein are copyright, all rights are reserved. No part hereof may be reproduced or transmitted in any form or by any means without the prior written consent of the Copyright owners Simon Clear Architects.
2. This drawing is prepared for the purpose of obtaining planning consent and for the specific purpose for which it has been prepared. This drawing is not to be relied upon for construction purposes, and no implied or expressed warranty is made as to the suitability of the information contained herein for any purpose other than that for which it was intended.
3. Do not scale this drawing. Figured dimensions only should be taken from this drawing and any discrepancies must be reported to the Architects office immediately.
4. The Employer is granted a copyright licence to use the drawing and its contents for the purpose for which the drawing has been prepared and for the purpose of marketing, letting, maintenance and alterations to the building or its curtilage. Such licence does not extend to the Employer or anyone in receipt of the drawing or any part thereof or its contents being able to reproduce, publish or transmit it to any third party for any other purpose without the prior written consent of the Copyright owners Simon Clear Architects.
5. Where the Architects conditions of engagement provide that the Employer obtains copyright (whether by transfer of ownership or expressed or implied licence for use on projects other than the project which the copyright licence was specifically adapted for) the Architect does not accept any liability whatsoever for any use of the drawing or any part thereof or its contents on any other project or for any use on this project by any party other than those for whom it was prepared and those to whom the Employer has given permission to view the drawing and to utilize its design in case it is necessary for any purpose relating to the building operation, letting, maintenance, alteration or repair of the building or its curtilage.
6. Do not scale this drawing. Figured dimensions only should be taken off the drawing. Report discrepancies in the drawing to the Architects office immediately.
7. All contractors, whether main or sub contractors, must visit the site and be responsible for taking what dimensions are necessary for the execution of their work and for the correct fitting of their work.
8. Where this drawing contains dimensions in relation to other relevant documents, such discrepancies shall be reported to the Architects office before any work is executed in the affected area. Do not scale this drawing for footprints and overall dimensions of buildings which are only approximate.
9. Dimensions are in millimetres unless otherwise specified.
10. References to National Standards, whether to Irish, EN British BSI or otherwise, or codes of practice CP3, CP110 etc. shall be taken to be the latest edition or revision thereof at the date of the Contract unless specifically stated otherwise.
11. Drawings are not to be used for construction purposes unless issued for such purpose.
12. Drawings are to be read in conjunction with the relevant specification and other contract documents.
13. All drawings are to be read in conjunction with the fire safety compliance report, all other contract documents, all relevant consultant and sub-consultant drawings.
14. Simon Clear Architects, Sole Agents, Architects, employees and or directors shall not be liable for any loss or damage consequential or otherwise which may be suffered by any party as a result of the contents of this document or any omissions therein.
15. Contractors must not take dimensions either scaled or figured off structural drawings but must refer to the appropriate architectural drawing for the most recent information, such as to the size and exactness of openings for doors, windows, fireplaces, etc. Structural openings are shown on structural drawings for detail & wall ties.

RFI Response

PROJECT:	Gaelcholáiste an Phiarsaigh - Lonsto Abbey, Rathfarnham
CLIENT:	Department of Education / Board of Management
TITLE:	Site Plan - Proposed Phase 1 Site Layout - Zone 1
DRAWING STATUS:	RFI Response
DRAWN BY:	MS/SR
CHECKED BY:	SR
DATE:	April 2023
DRAWING NUMBER:	2350_SJK_RFI_S2B_S_100
SCALE:	Extended A0 1:100
REV NO:	

RIAI Registered Architects

7 Fitzpatrick Sandyhill + Partners
2 Mount Street Crescent, Dublin, D02 W212
Sandyhill Village Wicklow
+353 1 676 4128
info@fsp.ie
www.fsp.ie

Simon Clear & Associates
20 Matilda Street, Dublin, D02 XK09
+353 01 00 2849
info@scarch.ie
Sandyhill Village Wicklow
+353 (0)4 04 4191
mail@sca.ie
www.sca.ie

rev.	date	description	by