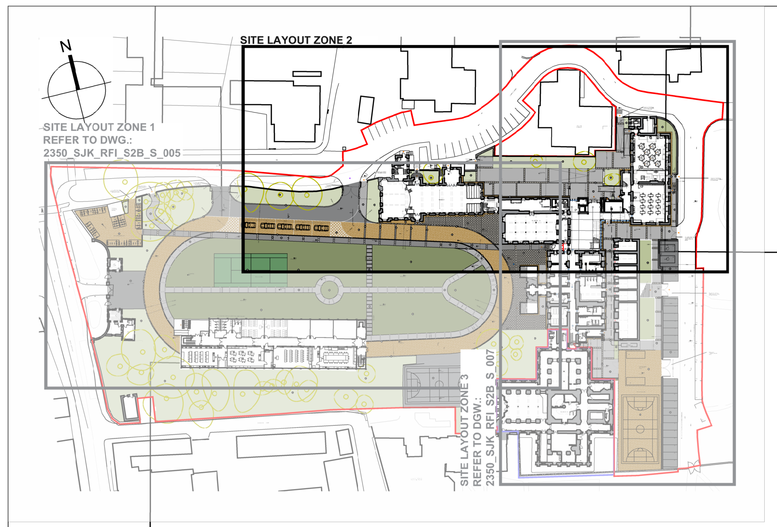

KEY PLAN - SITE PLAN ZONES 1 TO 3
SCALE 1:1000

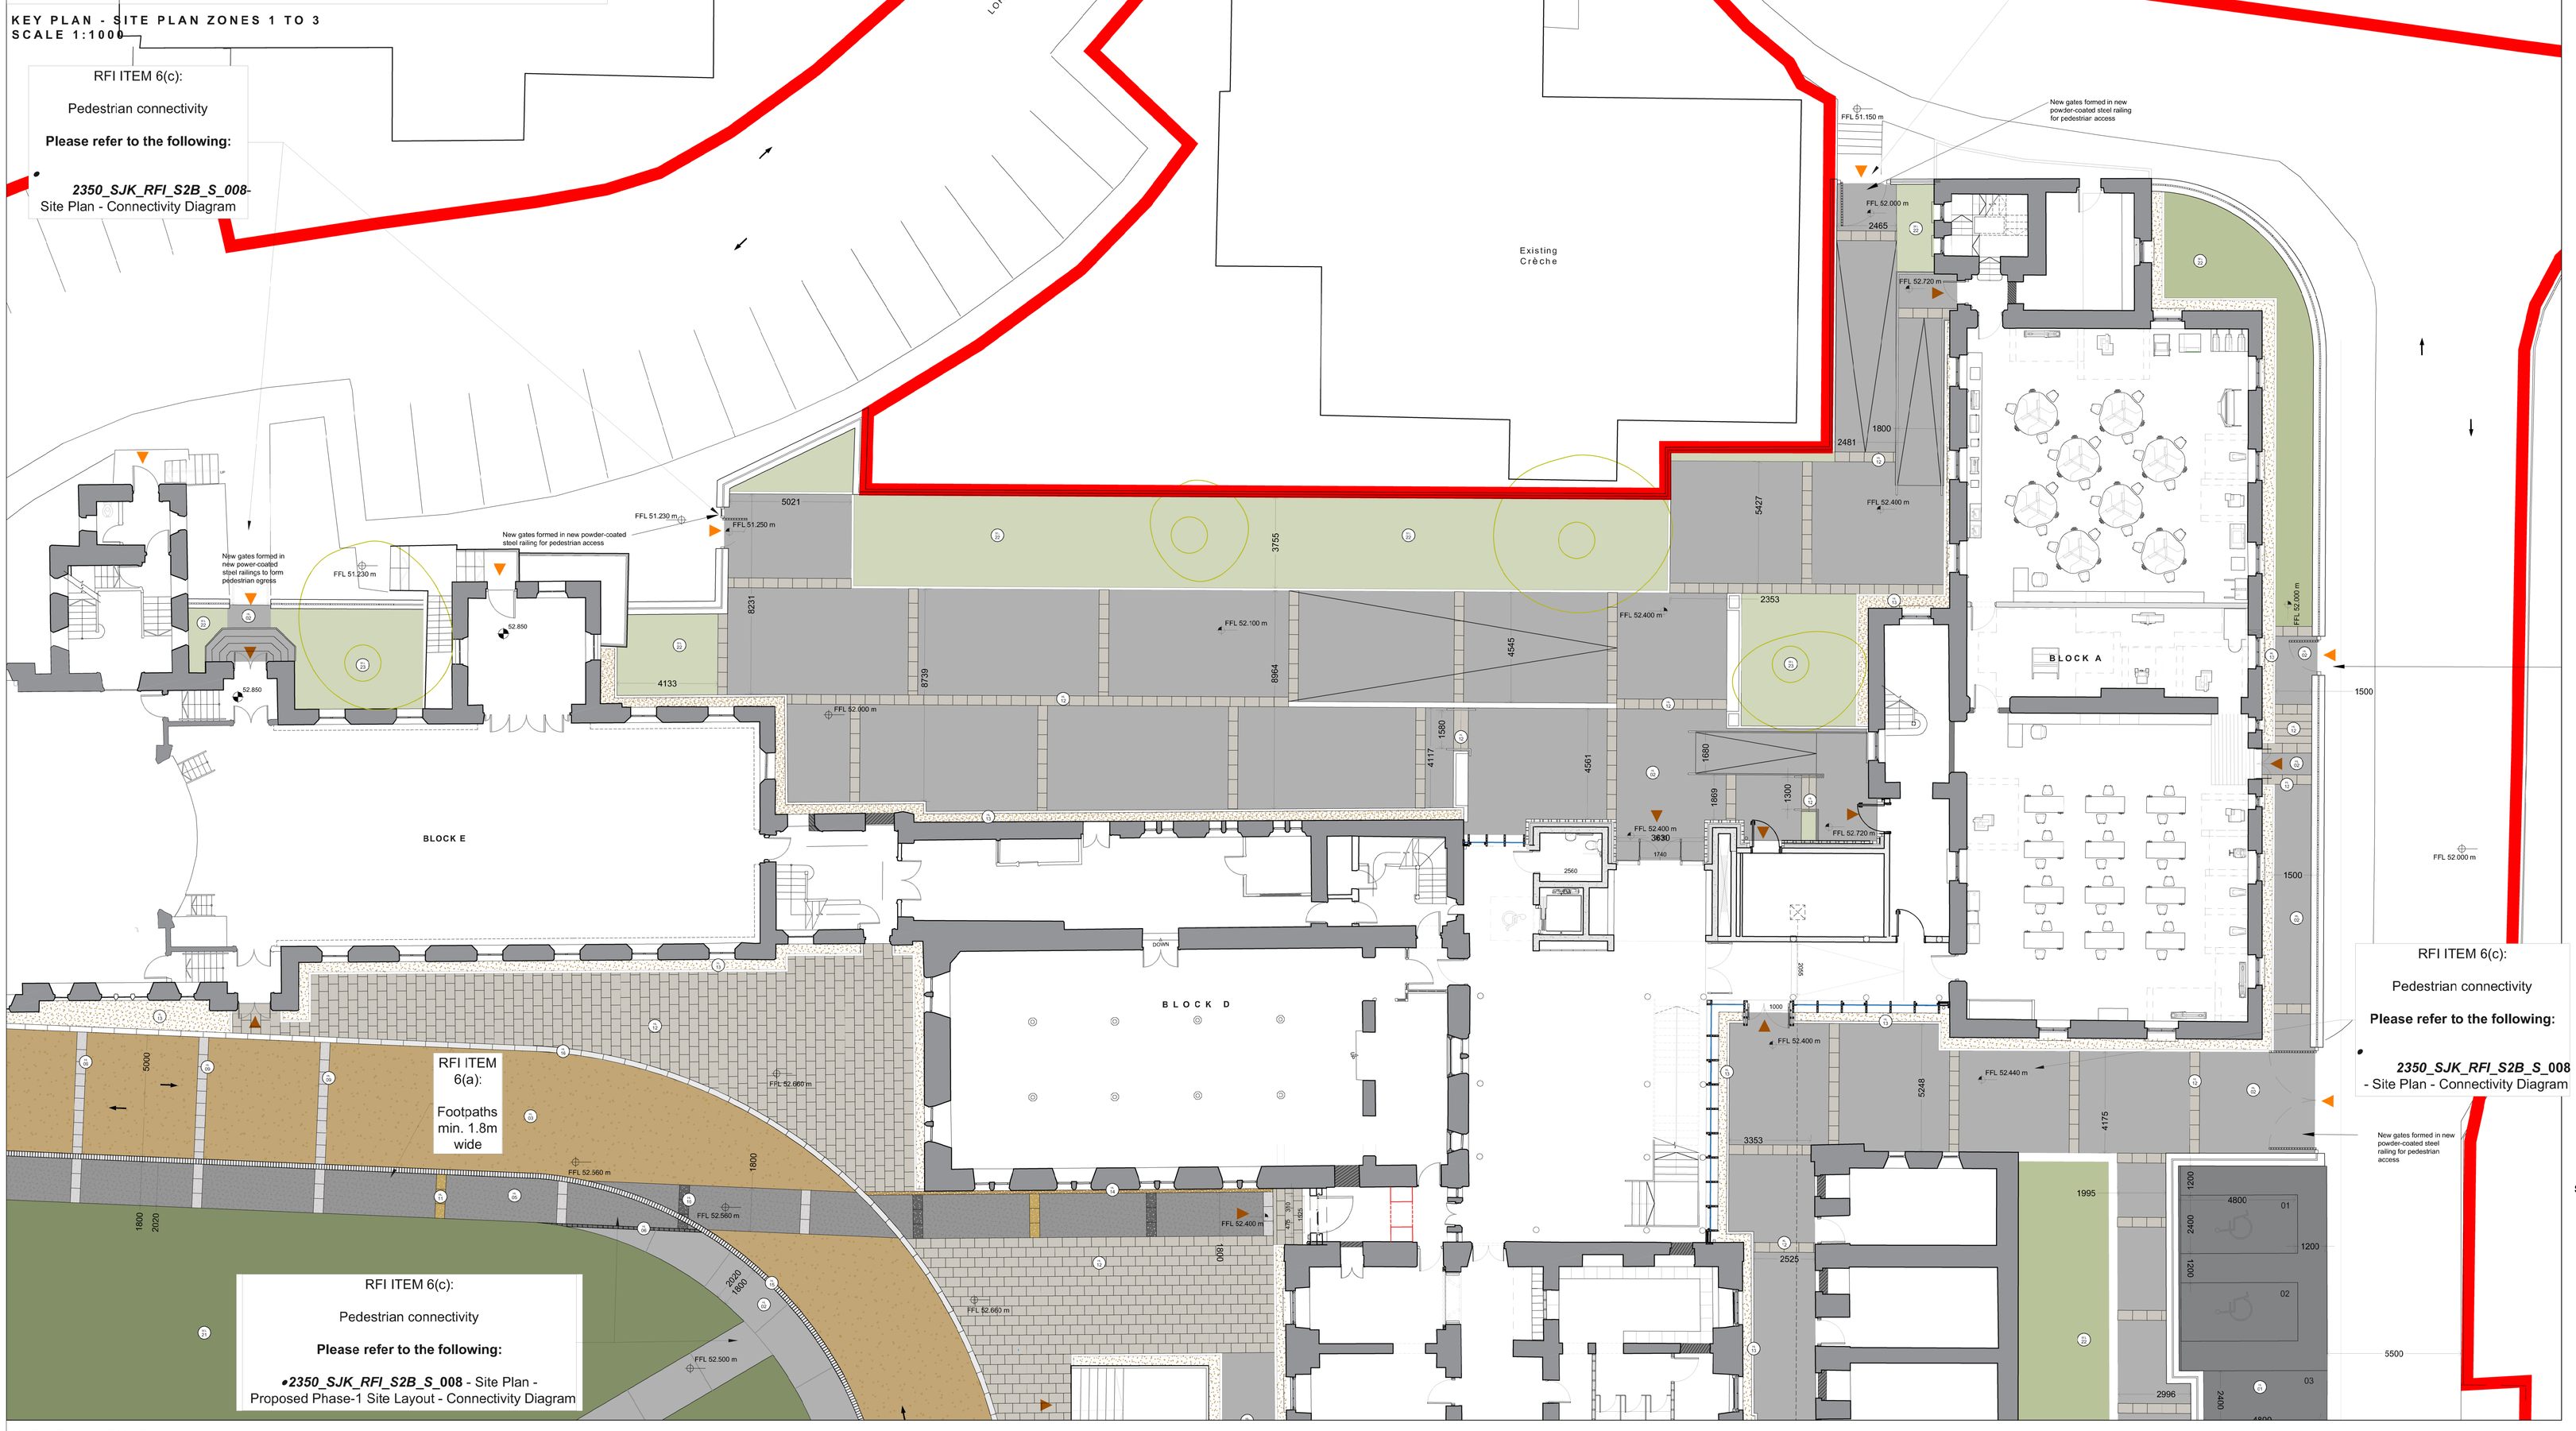

SITE PLAN ZONE 2
SCALE 1:100

LEGEND- SURFACE FINISHES

HARD LANDSCAPE (HL)

- (1) COLOURED ASPHALT: COLOUR BLACK | SIZE N/A | PERMEABLE (or similar | to later detail and specifications)
- (2) IN-SITE BRUSHED CONCRETE: COLOUR: NATURAL GREY | SIZE N/A | NON-PERMEABLE (or similar | to later detail and specifications)
- (3) COLOURED ASPHALT: COLOUR: BEIGE | SIZE N/A | PERMEABLE (or similar | to later detail and specifications)
- (4) ROAD MARKING PAINT: COLOUR: WHITE | SIZE: N/A (or similar | to later detail and specifications)
- (5) COLOURED ASPHALT: COLOUR GREY | SIZE N/A | PERMEABLE (or similar | to later detail and specifications)
- (6) PERMEABLE PAVING BLOCKS: LEVEL FLUSHED | MANUFACTURER: AG (OR SIMILAR) | COLOUR AND FINISH: RECTANGULAR SLATE (OR SIMILAR) | SIZE: 100 X 200mm | PERMEABLE JOINTS
- (7) Existing Black Tarmac
- (8) Existing Concrete Paving
- (9) GRANITE FLAGSTONE: LEVEL FLUSHED | MANUFACTURER: AG (OR SIMILAR) | LINE: TERRA PAVE | COLOUR: COMO GROUND (OR SIMILAR) | 600 X 400mm | PERMEABLE JOINTS (or similar | to later detail and specifications)
- (10) GRANITE FLAGSTONE: LEVEL FLUSHED | MANUFACTURER: AG (OR SIMILAR) | LINE: TERRA PAVE | COLOUR: MILANO GROUND (OR SIMILAR) | 600 X 400mm | PERMEABLE JOINTS (or similar | to later detail and specifications)
- (11) GRANITE FLAGSTONE: LEVEL FLUSHED | MANUFACTURER: AG (OR SIMILAR) | LINE: TERRA PAVE | COLOUR: VERONA GROUND (OR SIMILAR) | 600 X 400mm | PERMEABLE JOINTS (or similar | to later detail and specifications)
- (12) WICKLOW GRANITE STONE: LEVEL FLUSHED | COLOUR: NATURAL | SIZE: 600 X 400mm | PERMEABLE JOINTS (or similar | to later detail and specifications)
- (13) WICKLOW GRANITE EDGING LEVEL FLUSHED | COLOUR: NATURAL | SIZE: 100 X 200mm | PERMEABLE JOINTS (or similar | to later detail and specifications)
- (14) WICKLOW GRAVEL PEBBLE: COLOUR: NATURAL | PEBBLE SIZE: 10-20mm | PERMEABLE (or similar | to later detail and specifications)
- (15) PERMEABLE PAVING BLOCKS: LEVEL FLUSHED | MANUFACTURER: AG (OR SIMILAR) | COLOUR AND FINISH: RECTANGULAR GREY (OR SIMILAR) | SIZE: 100 X 200mm | PERMEABLE JOINTS (or similar | to later detail and specifications)
- (16) FLUSHED KERB: LEVEL FLUSHED | MANUFACTURER: AG (OR SIMILAR) | COLOUR: NATURAL | KERB WIDTH: 125mm (or similar | to later detail and specifications)
- (17) RIGHT HAND DROPPER KERB: KERB WIDTH: 125mm | FINISH: SMOOTH | COLOUR: NATURAL GREY (or similar | to later detail and specifications)
- (18) LEFT HAND DROPPER KERB: KERB WIDTH: 125mm | FINISH: SMOOTH | COLOUR: NATURAL GREY (or similar | to later detail and specifications)
- (19) ROAD KERB: FULL BATTER KERB | WIDTH: 125mm | FINISH: SMOOTH | COLOUR: NATURAL GREY (or similar | to later detail and specifications)

SOFT LANDSCAPE (Sf.L)

- (S1) **Artificial Grass** (or similar) Colour: Green | Size: TBC | Permeable (to later detail and as per supplier's specifications)
- (S2) **Lawn** Design purpose: to withstand foot traffic and seating (to later detail and specifications)
- (S3) **Reinstate Grass** (to later detail and specifications)
- (S4) **Existing trees and landscape** (to later detail and specifications)

Conditions of use of this drawing

note: if this A1 size drawing is reproduced at a smaller size which makes these conditions difficult to read, please contact the Architects office for a legible copy of these conditions.

1. This drawing the design and contents contained herein are copyright, all rights are reserved. No part hereof may be copied or reproduced partially or wholly in any form whatsoever without the prior written consent of the copyright owners Simon J Kelly Architects.
2. Dimensions are to be taken from the drawing and not scaled off the drawing. Figured dimensions only should be taken off this drawing. This drawing is not to be relied upon for construction purposes, and no implied or expressed warranty is given as to the suitability for construction purposes, unless the purpose of this drawing is stated to be "construction" or "contract". If the purpose is stated to be "contract" this drawing is not to be used for construction purposes unless specifically authorised.
3. The Employer is granted a non-exclusive right licence to use this drawing and its contents for the purposes for which the drawing has been prepared. If this drawing has been prepared for construction purposes the licence will only be valid for a single constructed reproduction and shall expire once a single reproduction has occurred. Any such licence only passes to the Employer on payment of Architects fees in full and in any event the licence cannot be assigned without prior written consent of Simon J Kelly Architects.
4. Simon J Kelly Architects and its consultants retain ownership and all other rights including copyright (whether by transfer of ownership or expressed or implied licence) for use on projects other than the project which the copyright material was specifically prepared for, the Architect does not accept any liability whatsoever howsoever arising for use of this drawing and or its contents (in whole or in part) in relation to any project and or purpose other than that for which it was specifically prepared. A copyright entitlement to use this drawing and or its contents (in whole or in part) is not a warranty that use of this drawing and or its contents (in whole or in part) is appropriate in circumstances other than the purpose and project for which it has been prepared.
5. Do not scale off this drawing. Figured metric dimensions only should be taken off this drawing. Imperial dimensions, if any, contained on this drawing are given for illustrative purposes only.
6. All dimensions are to be checked by the contractors, must visit the site and are responsible for taking and checking any and all dimensions levels and the like that relate to the works.
7. Where this drawing contains discrepancies in relation to other relevant documents, such discrepancies shall be brought to the attention of the Director of Simon J Kelly Architects who has been nominated as the partner in charge but only while such Architect remains in the employment of Simon J Kelly Architects.
8. References to National Standards, whether to Irish (IS) British (BS) or otherwise, or codes of practice (CP) shall be deemed to refer to the versions current at the date of the contract for the relevant works.
9. Any reference to the "Architect" or "Architects" on this or any other relevant document shall mean the nominated project Architect and or a Director of Simon J Kelly Architects who has been nominated as the partner in charge but only while such Architect remains in the employment of Simon J Kelly Architects.
10. Any questions as to the meaning or application of these conditions shall be submitted in writing to the Architect for his/her ruling and such a ruling shall be binding on the parties to the contract for the relevant works.
11. Simon J Kelly Architects, their Agents, Architects, employees and or directors shall not be liable for any loss damage or injury consequential or otherwise howsoever arising for failure to comply with any or all of these conditions.
12. Should anyone copy this drawing in whole or in part with or without consent and use the copy in relation to a purpose and or project for which the drawing has not been prepared for, such use is at the sole and exclusive 'risk of the copier and Simon J Kelly Architects do not accept any liability whatsoever howsoever arising in relation to such use.
13. Should anyone copy this drawing in whole or in part with or without consent they should also copy these conditions of use in full and reproduce them with the copy. These conditions of use are to be read in conjunction with the drawing and its contents, these conditions of use form part of the drawing and its contents and are binding on the parties to the contract for the relevant works.
14. The use of or reliance upon this drawing and or its contents shall be deemed to be acceptance of these conditions of use unless otherwise agreed in writing, such written agreement to be sought from and issued by the Architects prior to the use or reliance upon this drawing and or its contents.
15. All drawings are to be read in conjunction with the fire safety compliance report, all other contract documents, all statutory comments and or requirements and all statutory obligations.

RFI Response

GENERAL DRAWING LEGEND

- **Planning Application Boundary Line** shown in red
- **Site Under Applicant's ownership** shown in blue
- **Existing Site Levels**
- **Proposed Site Levels**
- **Site Entrance** - Bicycles
- **Site Entrance(s)** - Pedestrian
- **Site Entrance(s)** - Vehicles
- **Building Main Entrance(s)**
- **Access to Cycle Storage Shelters**
- **Vehicular Route**
- (SS) **Cycle Shelters (CS) / Gates (GT) / Hard Landscape (HL) / Soft Landscape (SL) - (as per drawing)**

PROJECT: Gaelcholáiste an Phiarsaigh - Loreto Abbey, Rathfarnham			
CLIENT: Department of Education / Board of Management			
DRAWING: Site Plan - Proposed Phase-1 Site Layout - Zone 2			
DRAWING PURPOSE: RFI Response	DRAWN BY: MS/SR	APPROVED: SR	DATE: April 2023
DRAWING SIZE: A0	SCALE: 1 : 100	DRAWING REFERENCE: 2350_SJK_RFI_S2B_S_006	REV. NO.

rev. | date | description | by

Fitzgerald Kavanagh + Partners
1 Mount Street Crescent, Dublin 2, D02 W57
+353 1 676 4128
info@fkp.ie
www.fkp.ie

Simon J Kelly Architects
21 Middle Street, Galway
+353 91 56 2949
Cox's Yard, Westport, Mayo
+353 98 24 414
mail@sjk.ie
www.sjk.ie